

Contact:
Email: rabinkhadka@hotmail.co.uk,
Cell: 044 + 078 3293 8374
Web site: www.bluearcdesign.co.uk

Notes:
© 2023 Blue Architecture Limited.
All rights reserved.
All drawings are for the purpose of gaining
Planning Permission approval only.
All written dimensions to be taken in
preferences to scaled dimensions.

Rev.	Description	By	Ckd	Date

Rev.	Description	By	Ckd	Date

Client:
Mr. Sanjib Sharma.

Project:
Retrospective planning approval for as build
Front porch Extension.

Location:
10 Thornhill Road, Ickenham,
Middlesex, UB10 8SF .



Status:
PLANNING

Title:
Existing First floor Plan.

Drawn by:	Str. Ert.	Checked by:
L.p	---	R.k

Project no:	Sheet Size	Sheet no.
BAL-1664	A3	

Date:	Scale:
09/03/2023	1:100

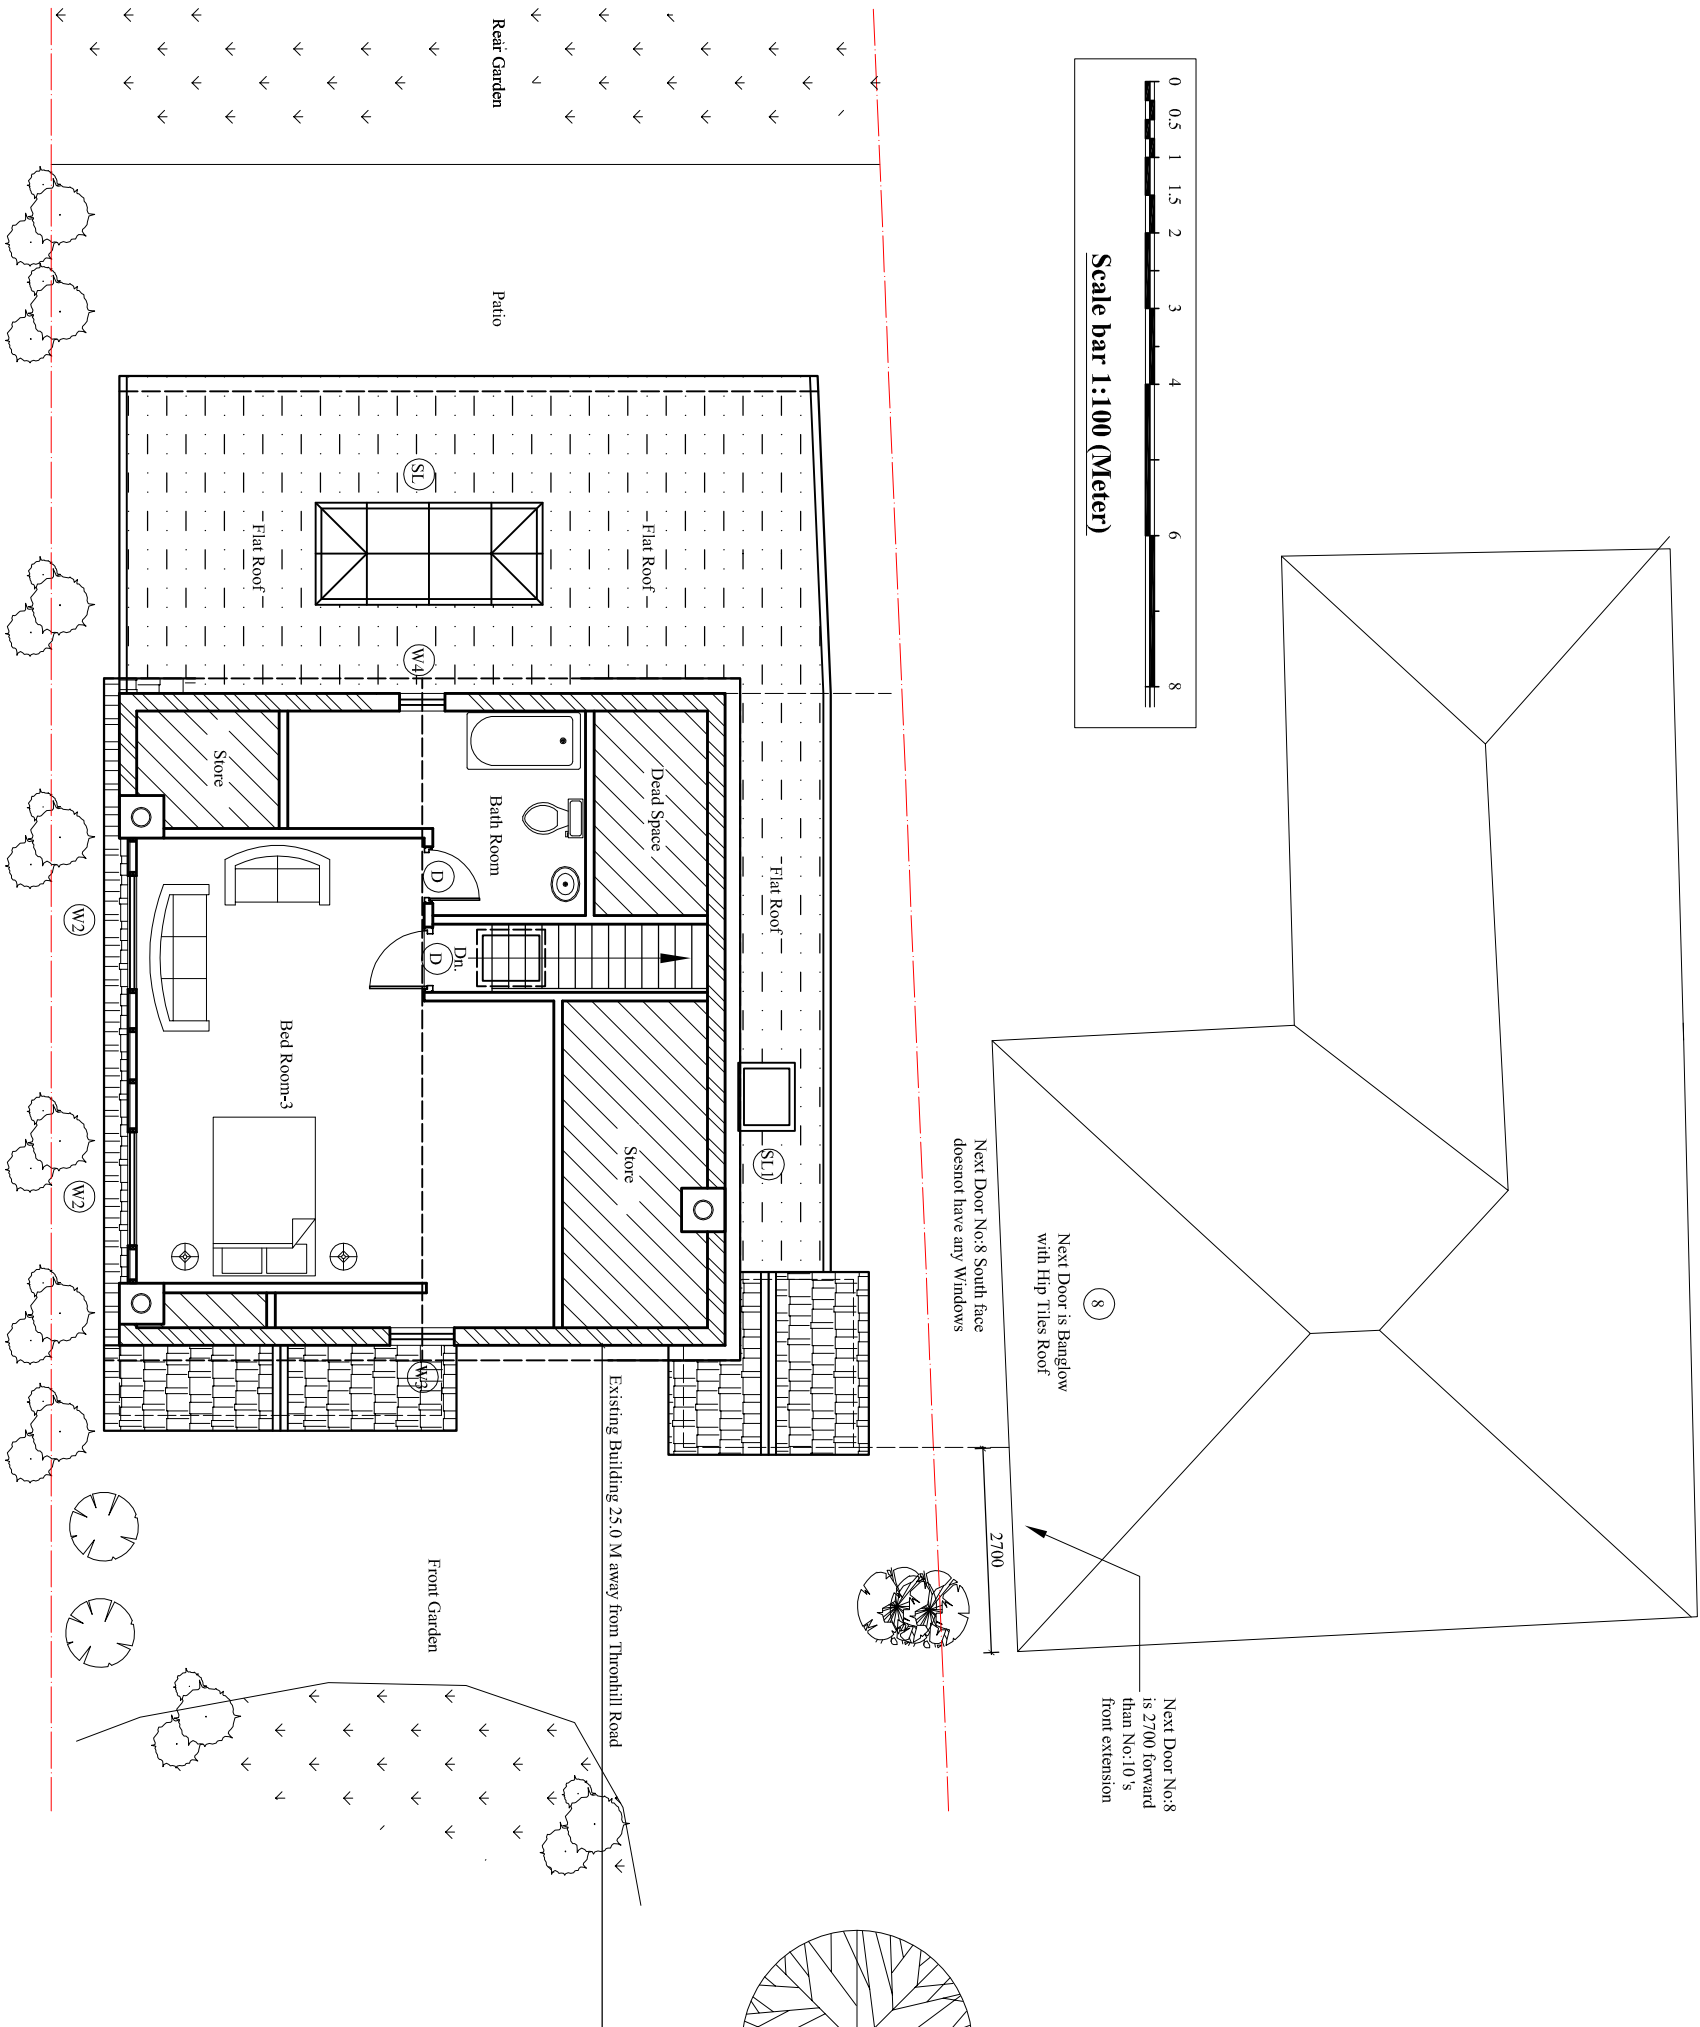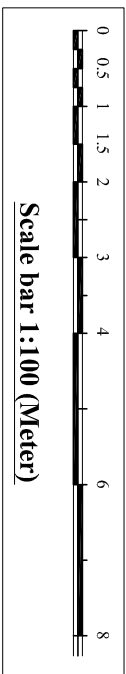

Proposed First Floor Plan
Scale:1:100