



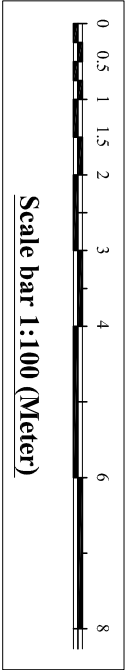

BLUE ARCHITECTURE LIMITED
Consulting Architects, Engineers and Interiors.
102 Dorchester Waye, Hayes, Middlesex,
UB4 0HY, London.

Contact:
Email: rabinkhadka@hotmail.co.uk,
Cell: 044 + 078 3293 8374
Web site: www.bluearchdesign.co.uk


Notes:
© 2023 Blue Architecture Limited.
All rights reserved.
All drawings are for the purpose of gaining
Planning Permission approval only.
All written dimensions to be taken in
preferences to scaled dimensions.

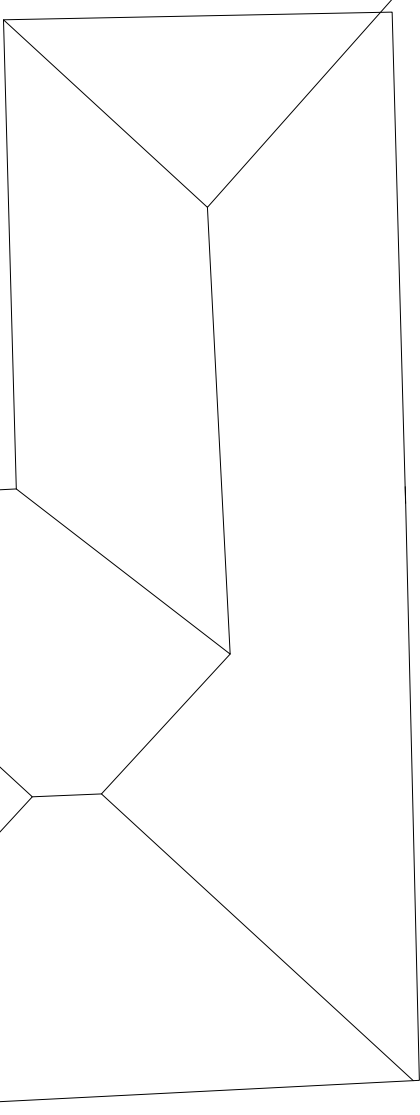

Next Door No:8
is 2700 forward
than No:10's
front extension

Next Door No:8 South face
doesnot have any Windows

2700

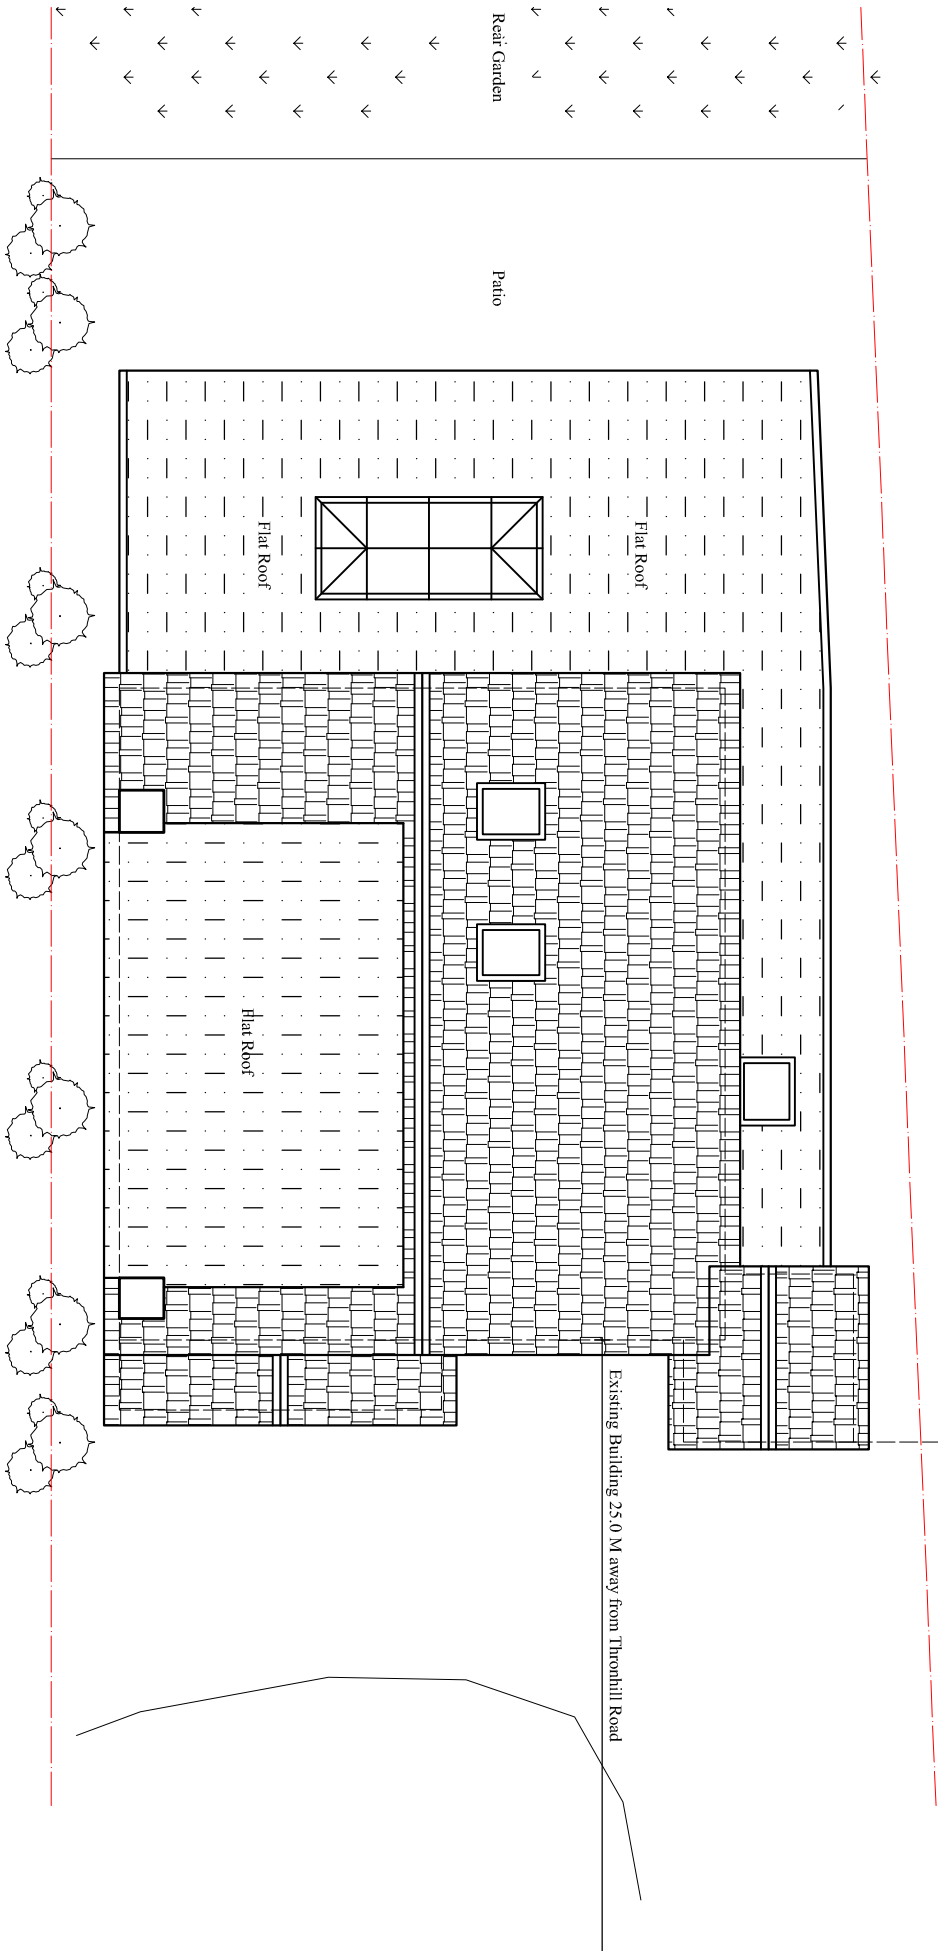

Proposed Roof Plan
Scale:1:100

Rev.	Description	By	Ckd	Date

Client:
Mr. Sanjib Sharma.

Project:
Retrospective planning approval for as build
Front porch Extension.

Location:
10 Thornhill Road, Ickenham,
Middlesex, UB10 8SF .

Status:
PLANNING

Title:
Existing Roof plan.

Drawn by: L.p	Str. Ert. ---	Checked by: R.k	Sheet no. BAL-1664
Project no: BAL-1664	Sheet Size A3		
Date: 09/03/2023	Scale: 1:100		