


Scale bar 1:500 (Meter)



Notes:  
 © 2023 Blue Architecture Limited.  
 All rights reserved.  
 All drawings are for the purpose of gaining  
 Planning Permission approval only.  
 All written dimensions to be taken in  
 preferences to scaled dimensions.

Contact:  
 Email: rabinkhadka@hotmail.co.uk,  
 Cell: 044 + 078 3293 8374  
 Web site: www.bluearcdesign.co.uk

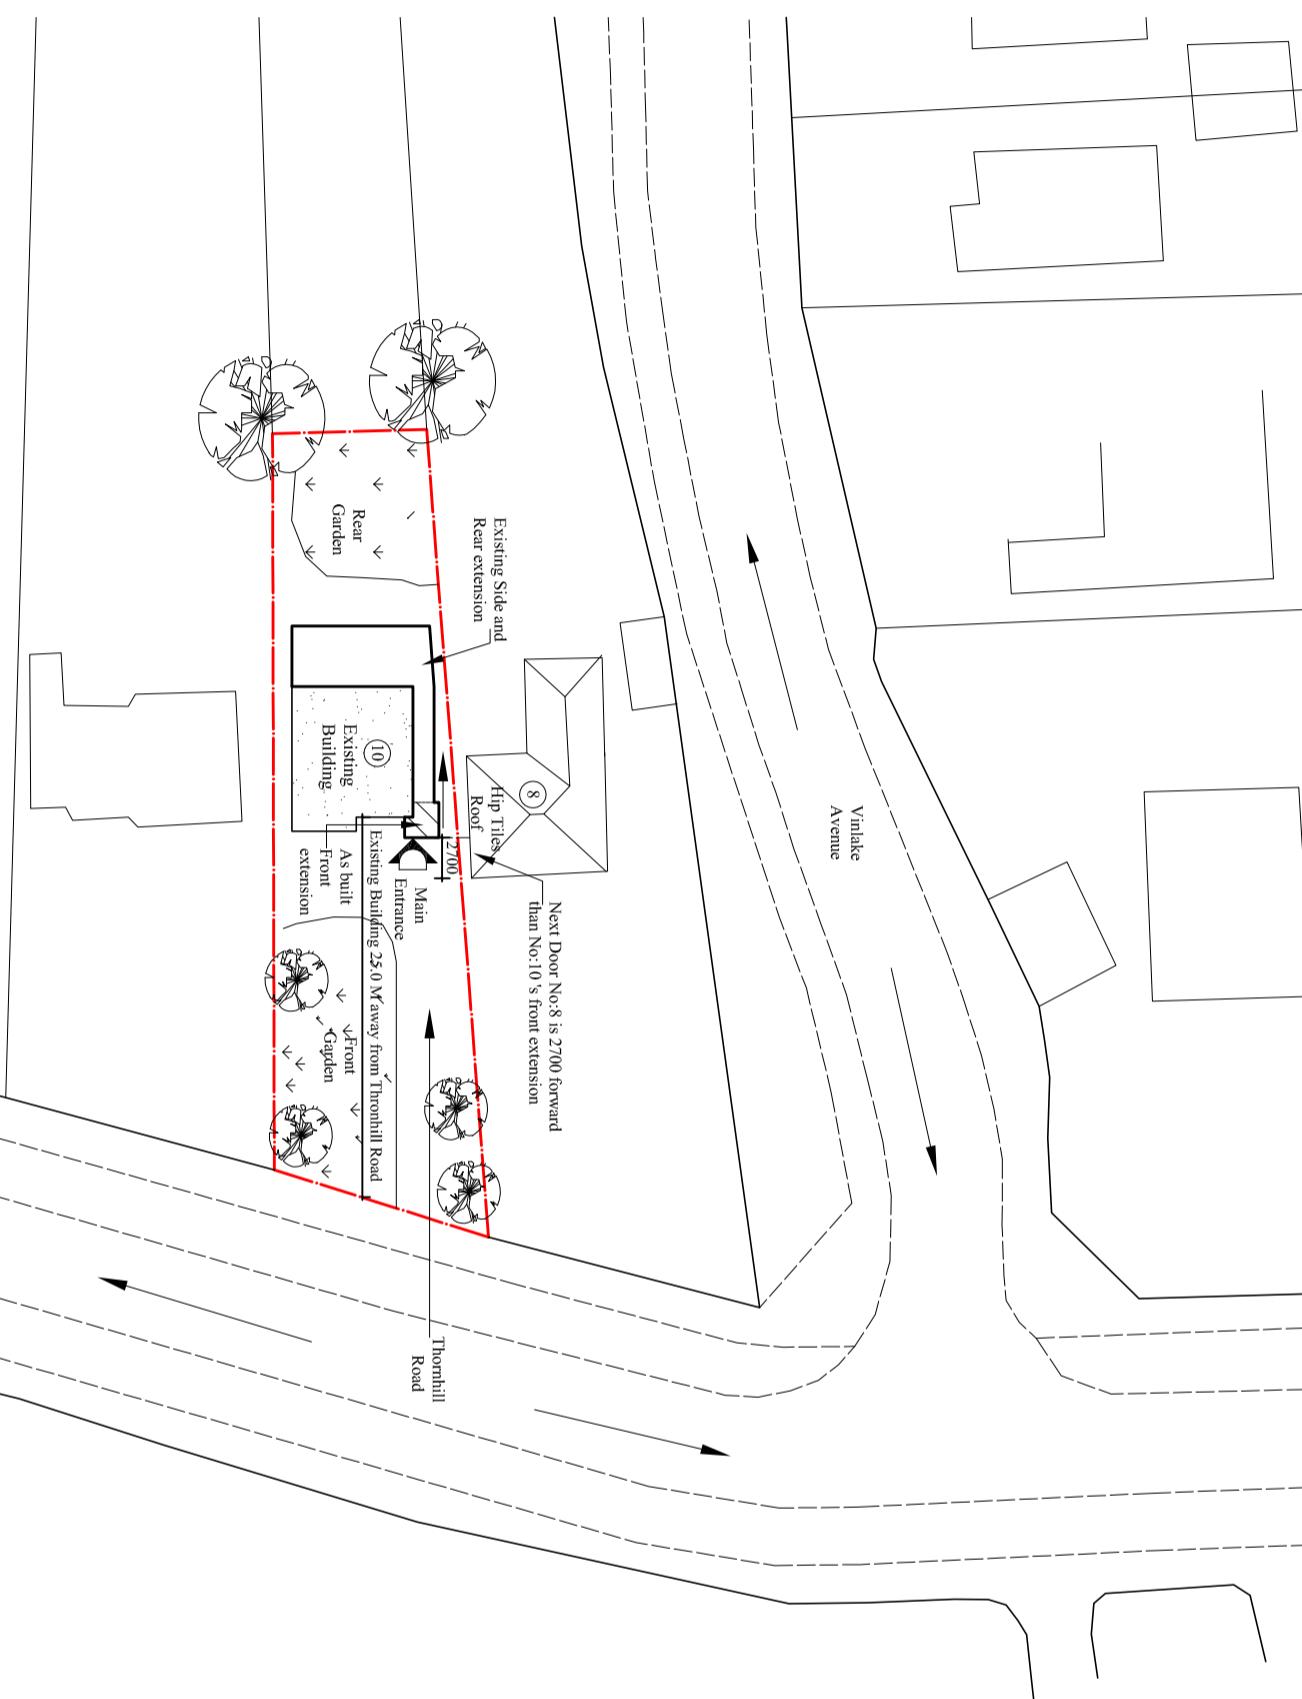

**Block Plan**

Scale:1:500

○ = Trees

**Client:**  
**Mr. Sanjib Sharma.**

**Project:**  
 Retrospective planning approval for as build  
 Front porch Extension.

**Location:**  
 10 Thornhill Road, Ickenham,  
 Middlesex, UB10 8SF.

**Status:**

PLANNING

**Title:**  
 Existing Block Plan.

Drawn by: **L.P** Str. Er. **R.K** Checked by:

Project no: **BAL-1664** Sheet Size **A3** Sheet no.

Date: **09/03/2023** Scale: **1:500**