
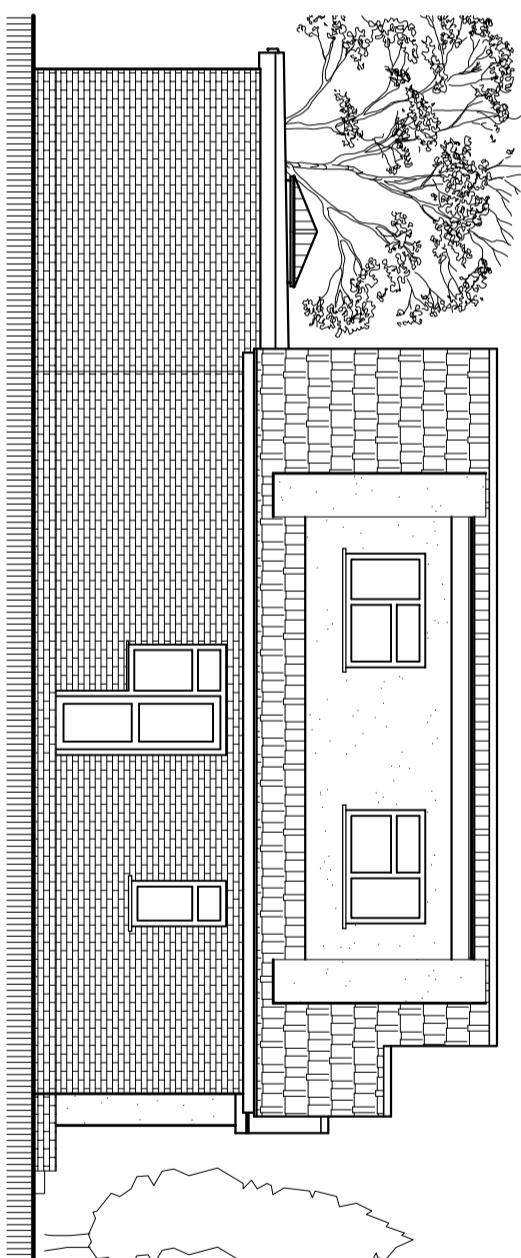


**Proposed West Elevation**

Scale: 1:100

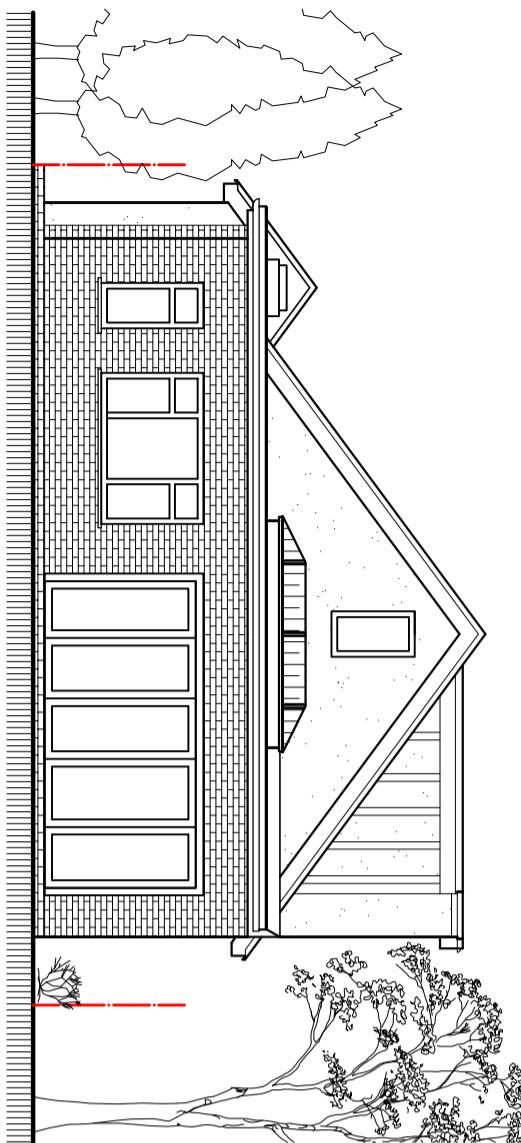

**Proposed South Elevation**

Scale: 1:100

Notes:  
 © 2023 Blue Architecture Limited.  
 All rights reserved.  
 All drawings are for the purpose of gaining  
 Planning Permission approval only.  
 All written dimensions to be taken in  
 preferences to scaled dimensions.

<b>Title:</b>	Existing Elevations			
Drawn by:	Str. Er.	Checked by:		
<b>L.P</b>	---	<b>R.K</b>		
Project no:	Sheet Size			
<b>BAL-1664</b>	<b>A3</b>			
Date:	Scale:			
09/03/2023	1:100			
<b>04</b>				