
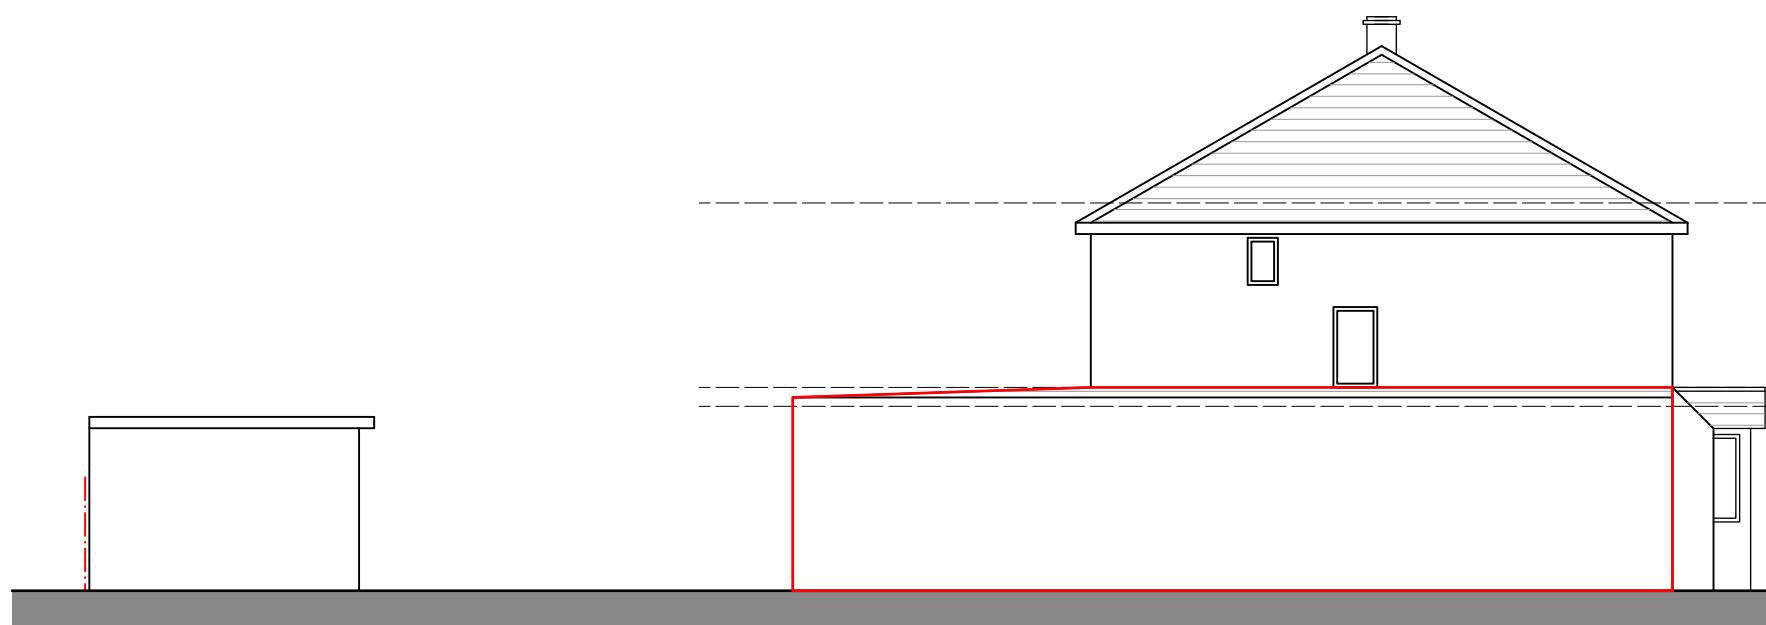


General Notes

1. Red indicates extensions that are subject to application
52893/APP/2023/23 (to which this drawing relates to)

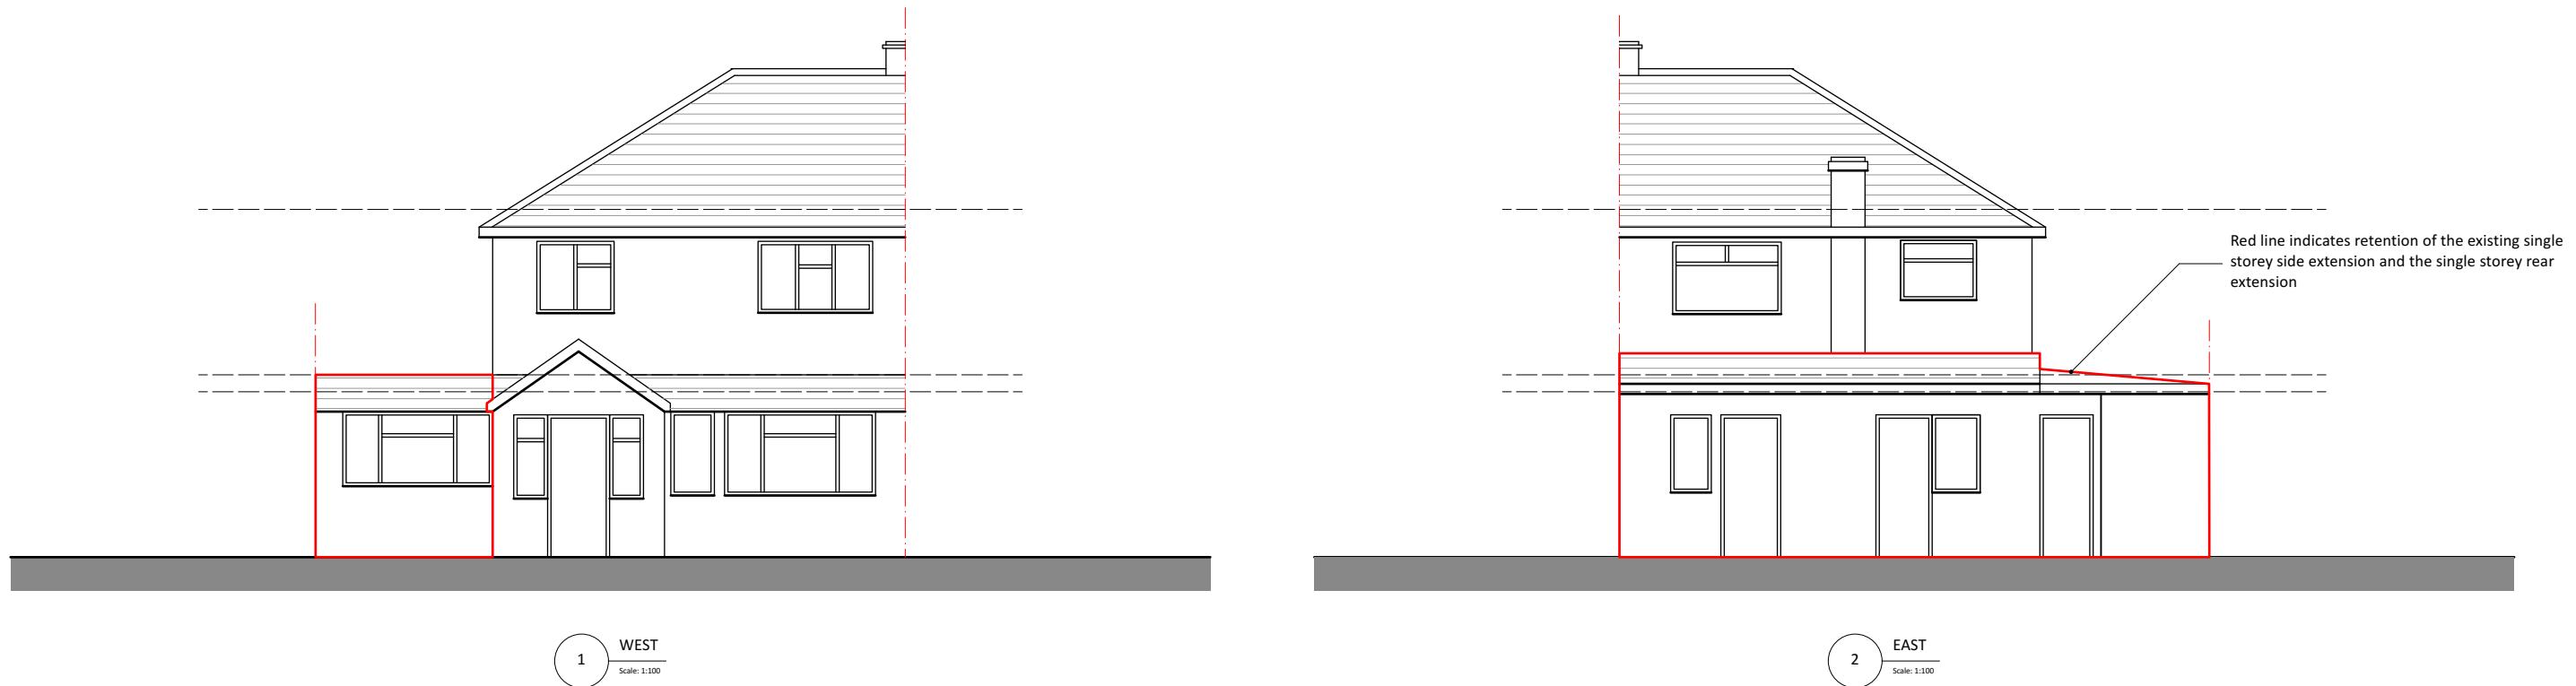

0 1 2 3 4 5 M

A 04/03/2023 Red line added as per email from LBH dated 02/03/23
ISSUE DATE REVISION

PROJECT
23 Harmondsworth Road, UB7 9JP

CLIENT
Mr + Mrs Singh

DRAWING
EXISTING ELEVATIONS



All rights described in chapter IV of the
copyright designs & patents act 1988
have been asserted. This drawing must
not be scaled; only figured dimensions
should be used. Check and verify all
dimensions on site prior to commencing
any work. Any discrepancies should be
reported to the Architects immediately.

PROJECT # 2022.021 DWG # REV
DATE 02/11/2022
SCALE 1:100
DRAWN CHKD
PB JC

S04 - A

Akaal Associates Ltd trading as aa+ architects
Moor House Farm Lower Road Denham Uxbridge UB9 5EN
t 01895 834961 e info@aa-plus.uk w aa-plus.uk