


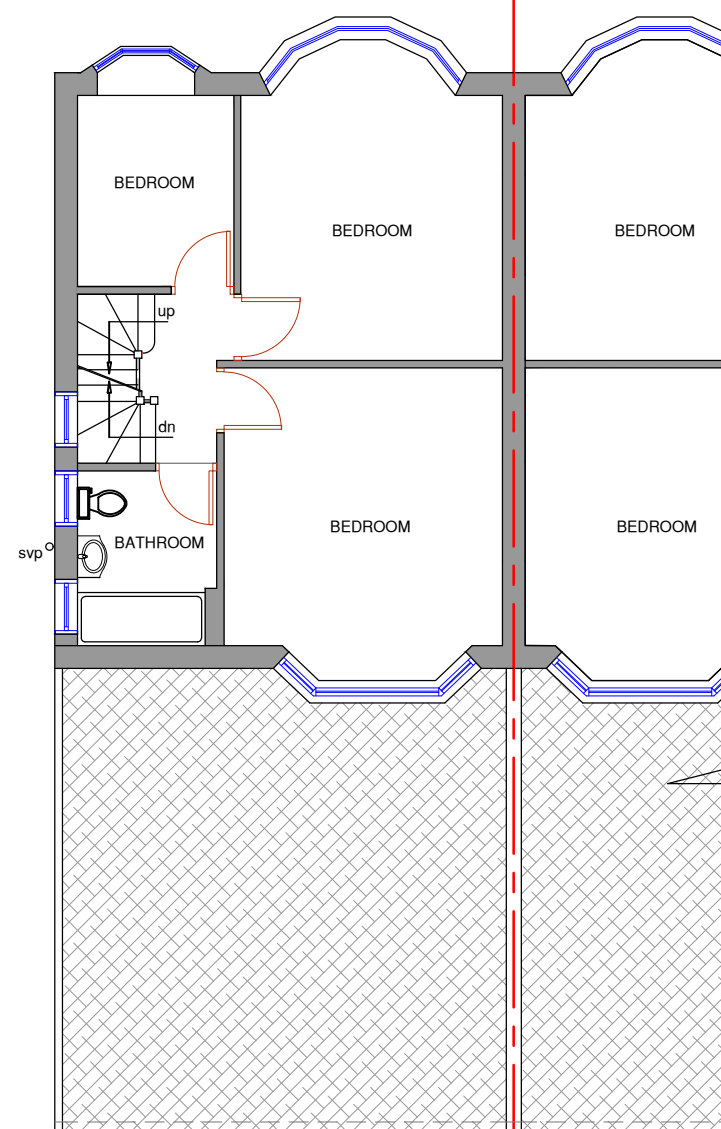

NO.2 NO.

AS BUILT FIRST FLOOR PLAN


VOLUME CALCULATION

REAR DORMER :
 $(5.745 \times 2.52 \times 3.47) / 2$
 $= 25.11\text{m}^3$

HIP TO GABLE :
 $(7.875 \times 3.112 \times 4.016) / 6 = 16.4\text{m}^3$


TOTAL = 41.51m^3

PERMITTED DEVELOPMENT
AS TOTAL VOLUME < 50 m³

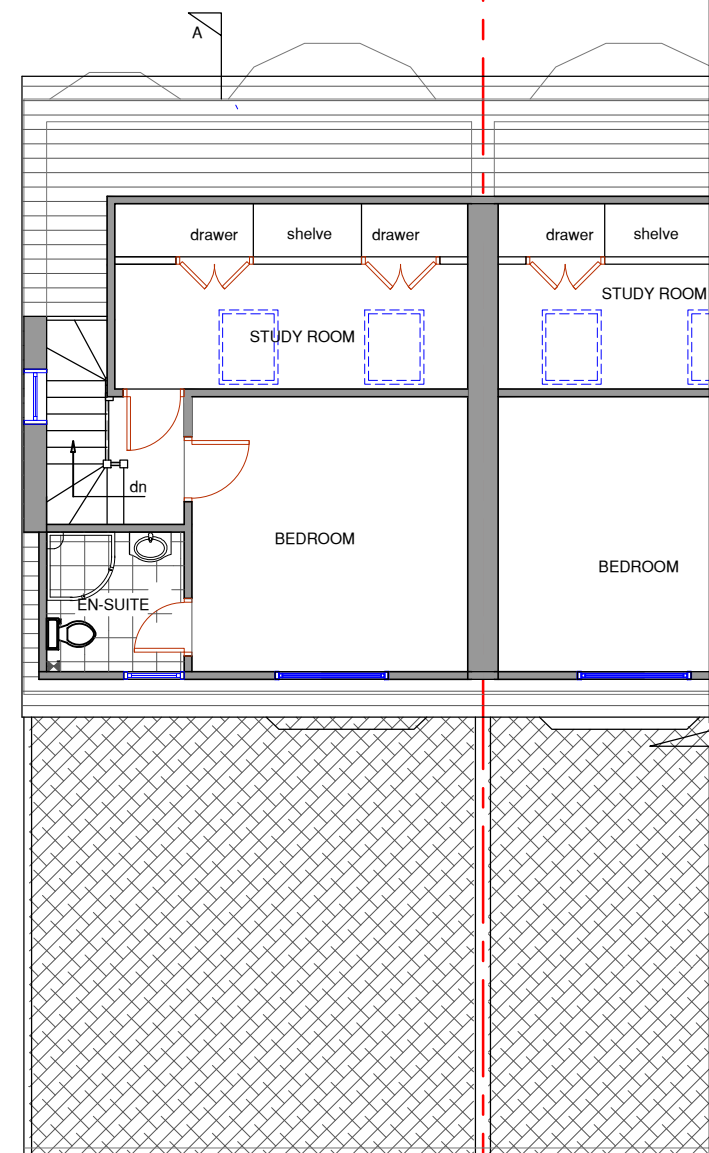

NO.2 NO.4


AS BUILT LOFT PLAN

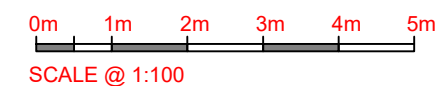

NOTES :

PLANNING PERMISSION GRANTED UNDER CERTIFICATE
OF LAWFUL USE OR DEVELOPMENT :

Ref: 52974/APP/2021/1452 (No. 2)
Ref: 52974/APP/2021/1427 (No. 4)

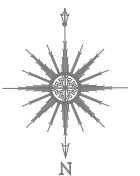[illegible]

Client: MR. JAGTAR SINGH

Job Title

2 COLBROOK AVENUE
HAYES
UB3 1TG

Drawing Title
FIRST FLOOR AND LOFT
PLANS (AS BUILT)

Scale: 1 : 100 (A3)

Date: FEBRUARY 2022

Date: FEBRUARY 2022	
Checked by:	Drawn by: RS H

Drg No.
TP/466/L02

Rev.