
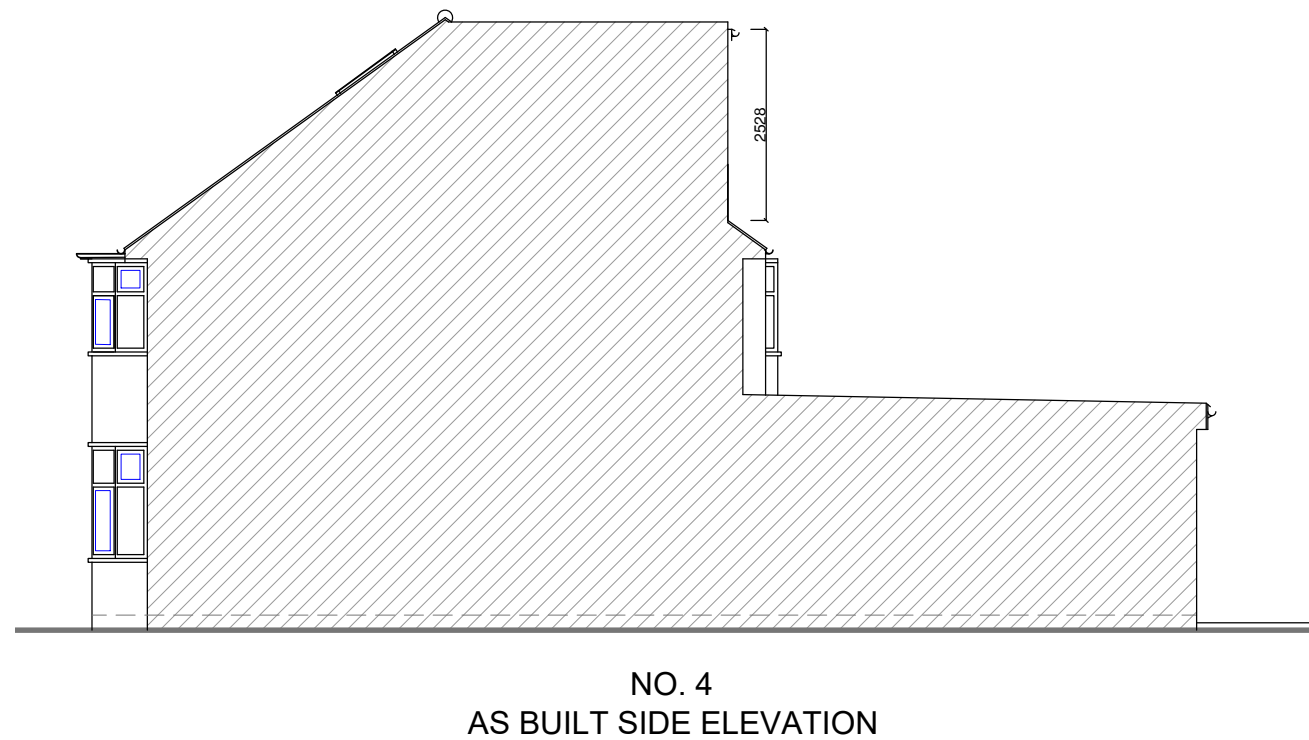


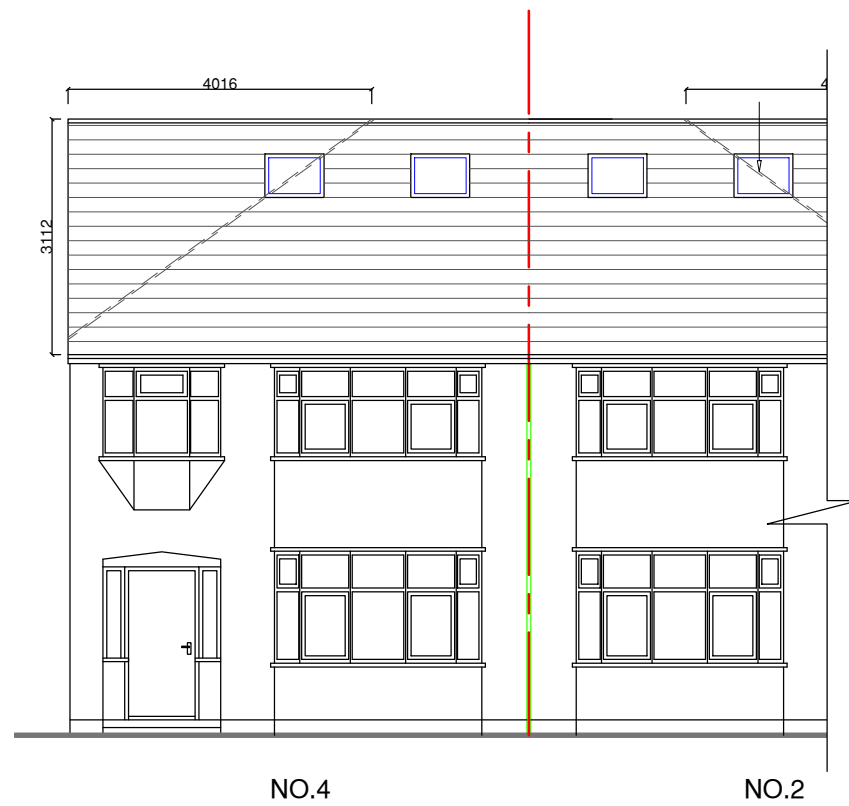

NOTES :

PLANNING PERMISSION GRANTED UNDER CERTIFICATE
OF LAWFUL USE OR DEVELOPMENT :

Ref: 52974/APP/2021/1452 (No. 2)
Ref: 52974/APP/2021/1427 (No. 4)

	Date	Revisions
--	------	-----------

Client: HJ PROPERTY UK LTD.

Job Title

4 COLBROOK AVENUE
HAYES
UB3 1TG

Drawing Title
AS BUILT ELEVATIONS

Scale: 1 : 100 (A3)

Date: FEBRUARY 2022

Checked by:	Drawn by: RS	H
-------------	--------------	---

Drg No. TP/466/L03	Rev.
-----------------------	------

