



NO.15

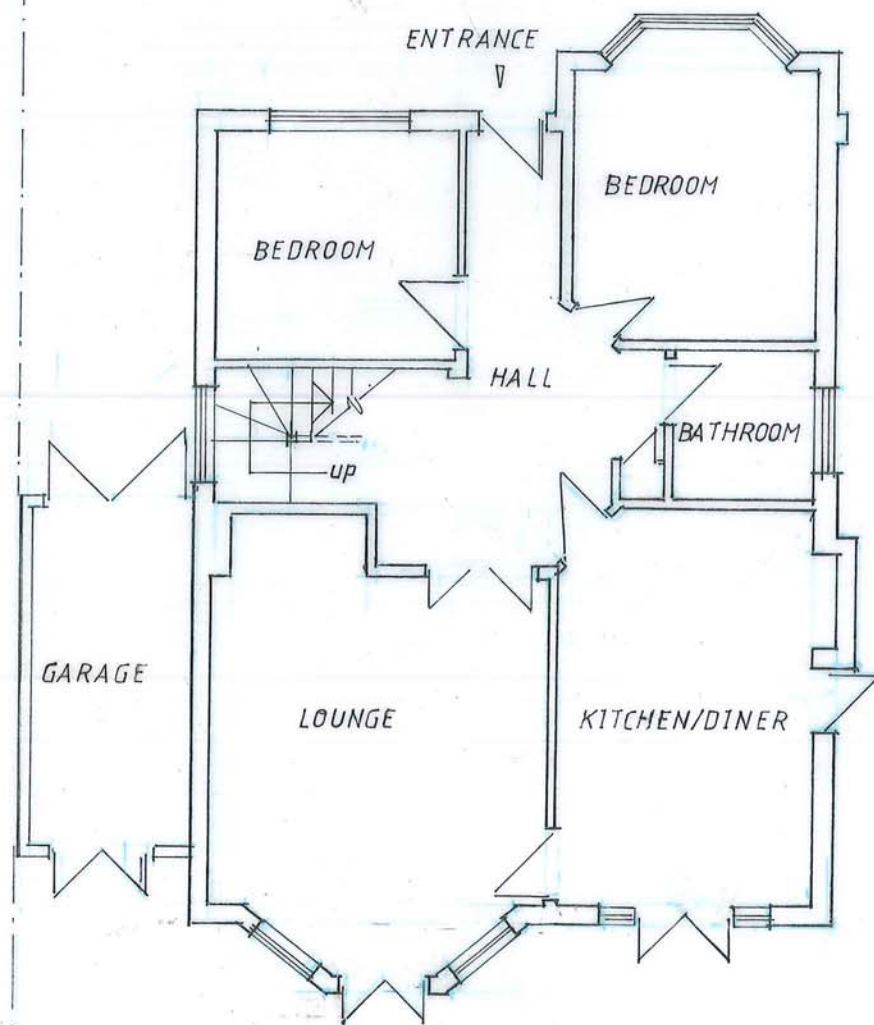


REAR GARDEN/PATIO

EXISTING GROUND FLOOR

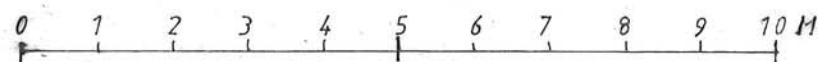

SCALE BAR = 1:100

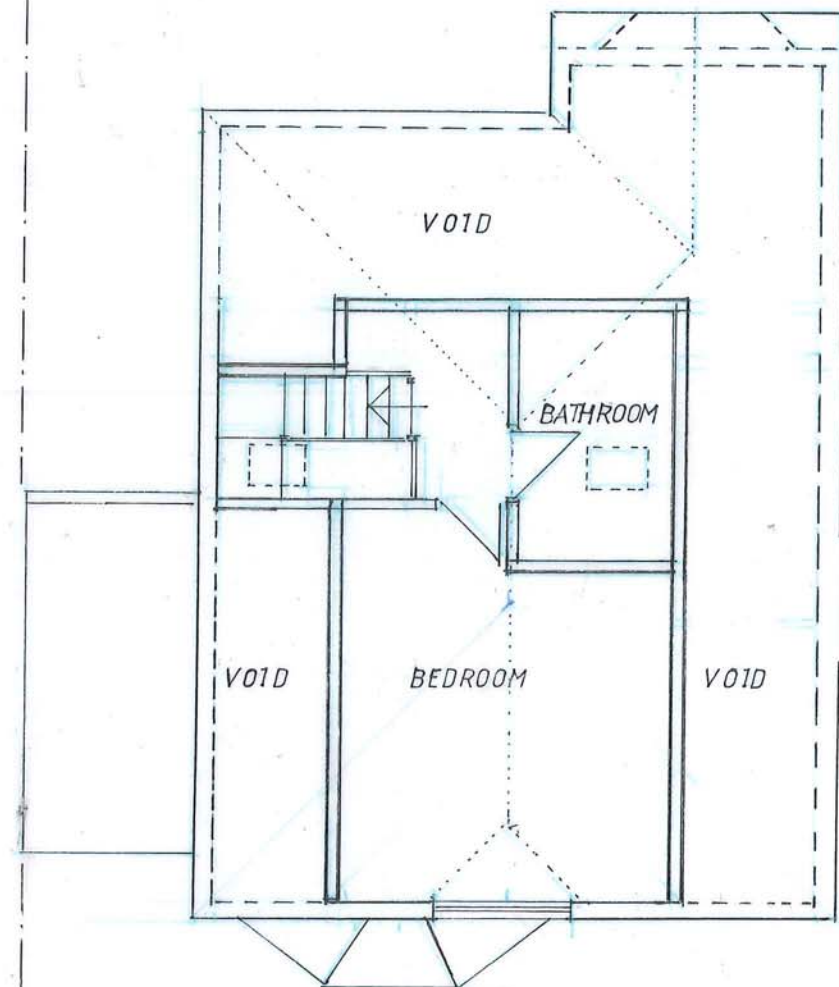

EXISTING FIRST [LOFT] FLOOR

EXISTING FLOOR PLANS


14 HIGHFIELD CRESCENT
NORTHWOOD , HA6 1EZ

SCALE = 1:100



DATE = MAY. 2024

Drg.No.=KS/2024/01

Rev.= A

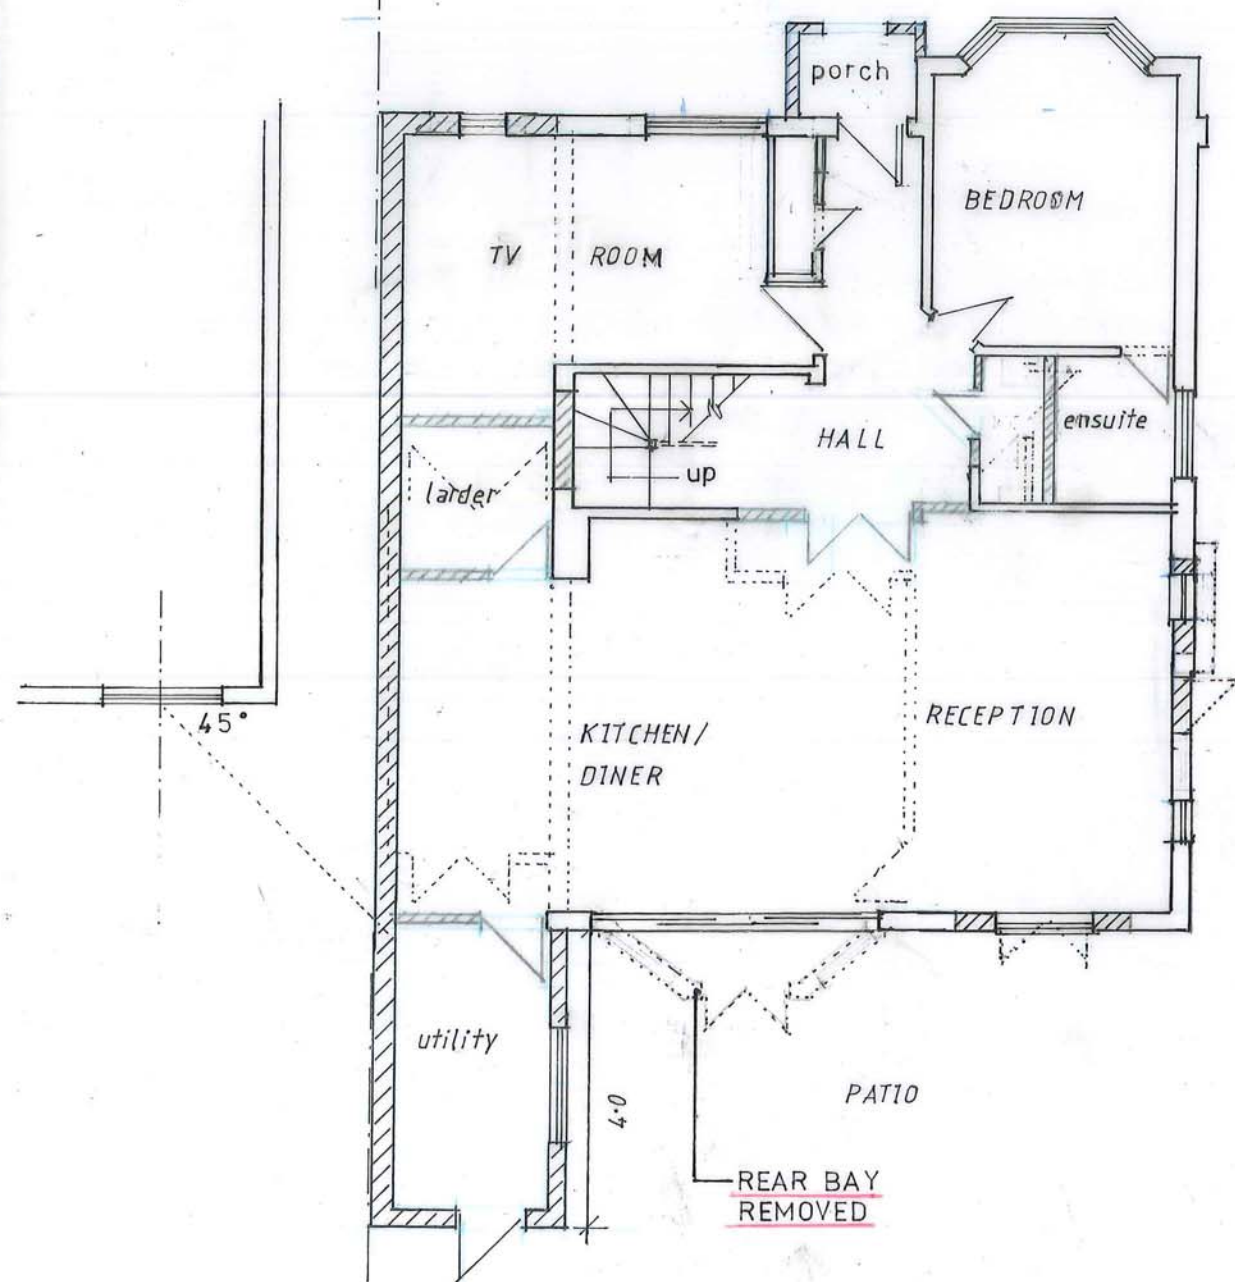

PROPOSED GROUND FLOOR

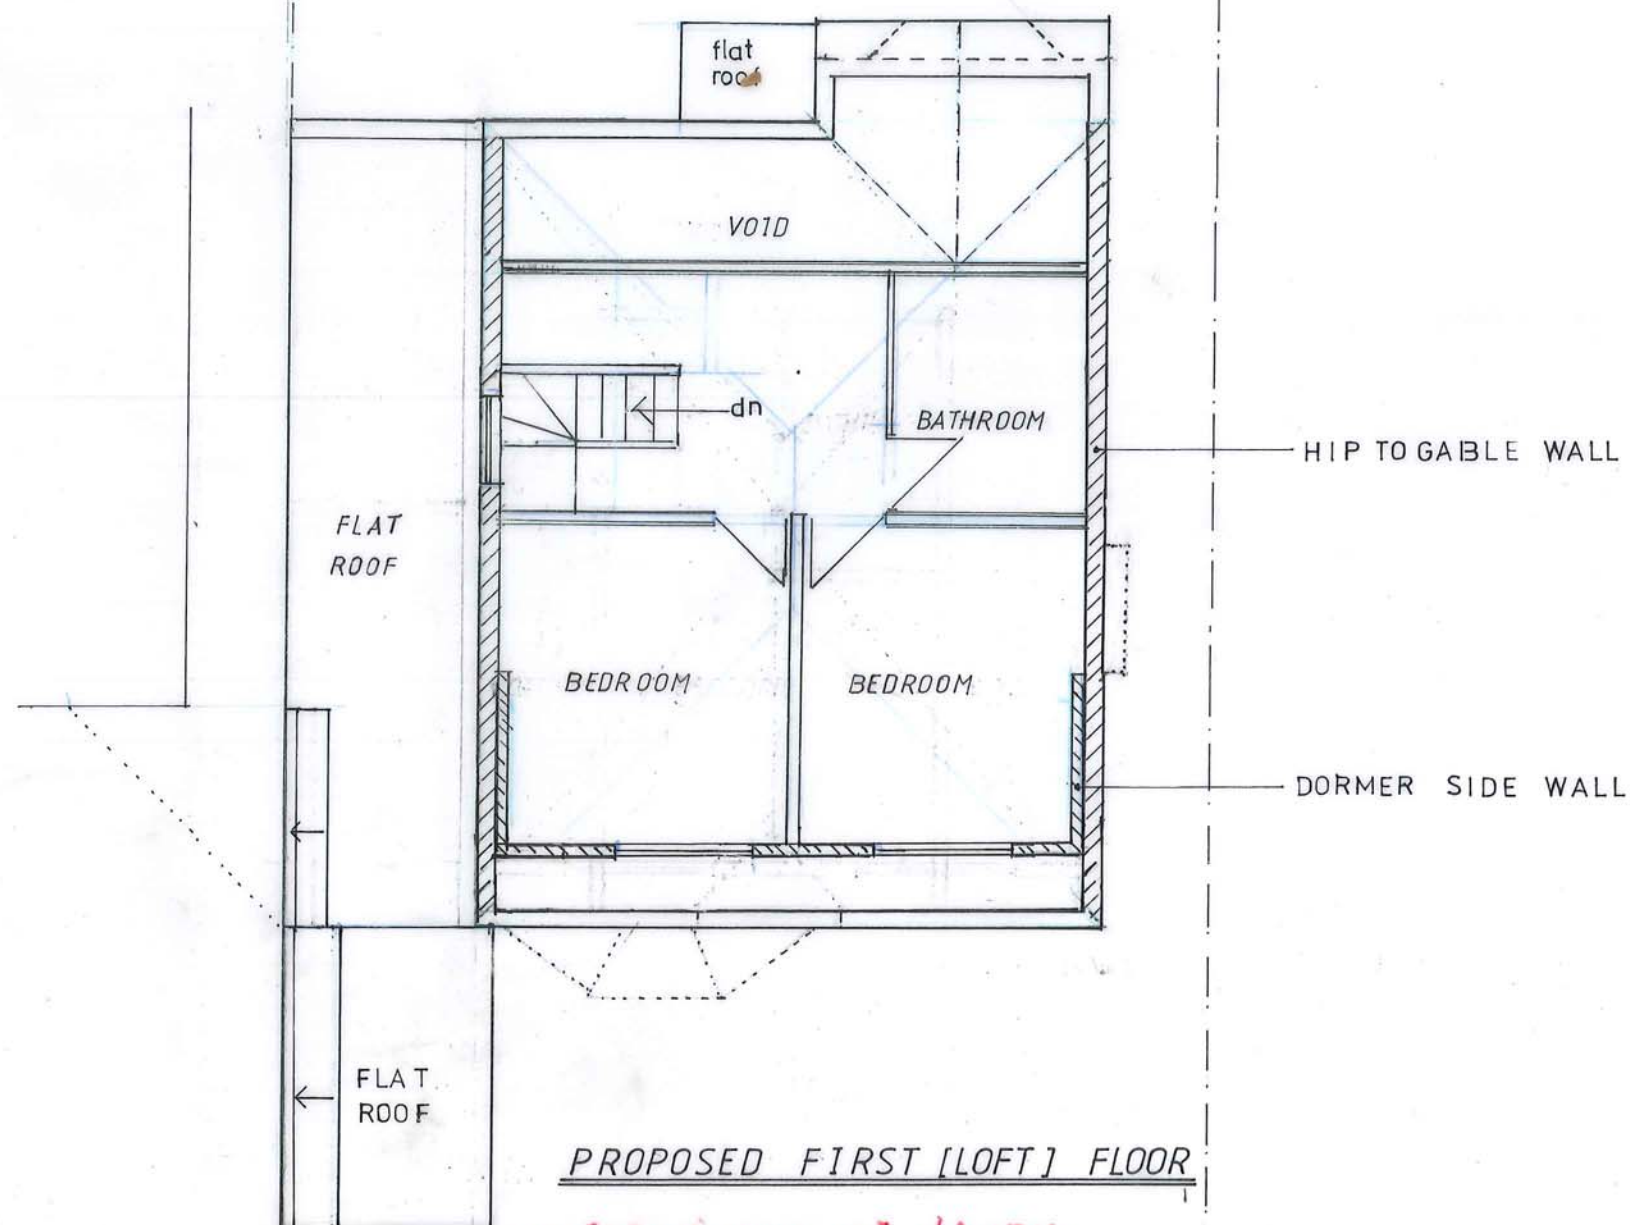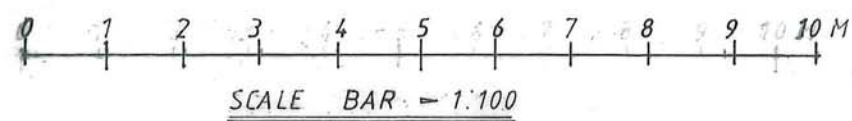

PROPOSED FIRST [LOFT] FLOOR

*** CERTIFICATE OF LAWFUL
PREVIOUSLY GRANTED
LOFT CONVERSION

PROPOSED FLOOR PLANS


14 HIGHFIELD CRESCENT
NORTHWOOD, HA6 1EZ

SCALE = 1:100

DATE = MAY 2024

Drg.No. = KS/2024/02


Rev. = * BC

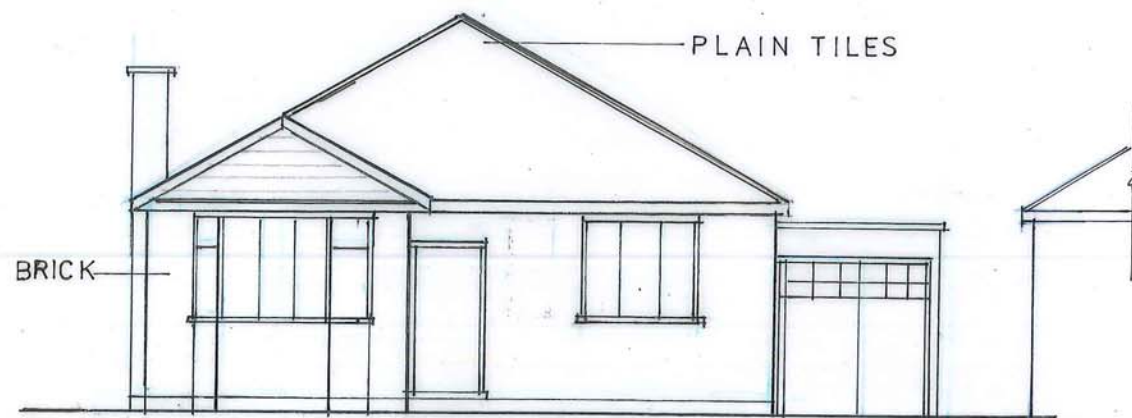

EXISTING FRONT



EXISTING REAR

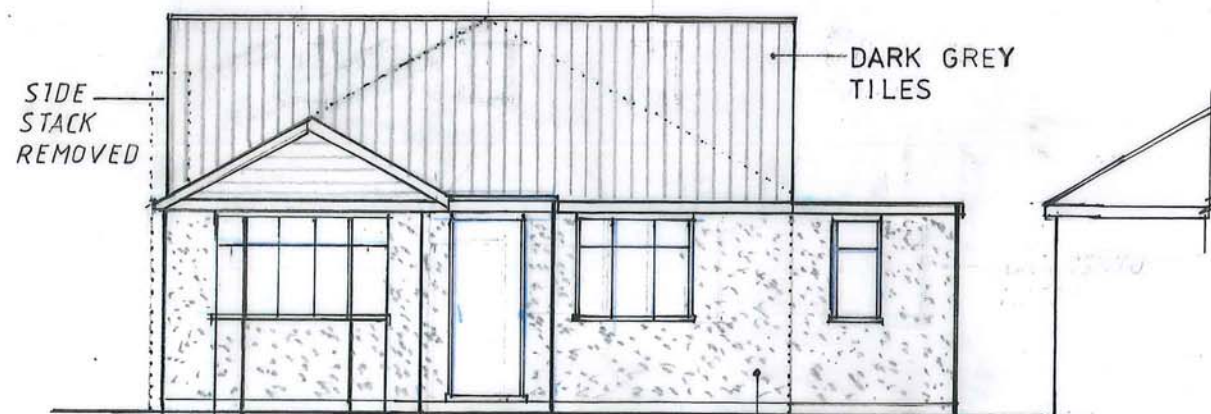


PROPOSED FRONT



PROPOSED REAR

BOUNDARY
LINE

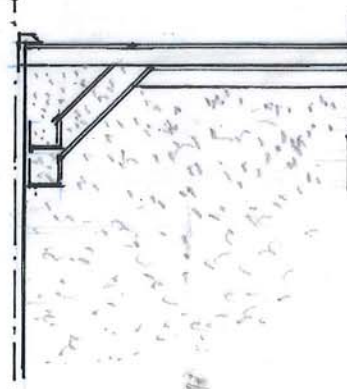

BOX GUTTER DETAIL

0 1 2 3 4 5 6 7 8 9 10 M

SCALE BAR = 1:100

EXISTING & PROPOSED FRONT
AND REAR ELEVATIONS


14 HIGHFIELD CRESCENT
NORTHWOOD, HA6 1EZ

SCALE = 1:100


DATE = MAY. 2024

Drg.No. = KS/2024/03


Rev. ~~A~~ ~~B~~ ~~C~~ D

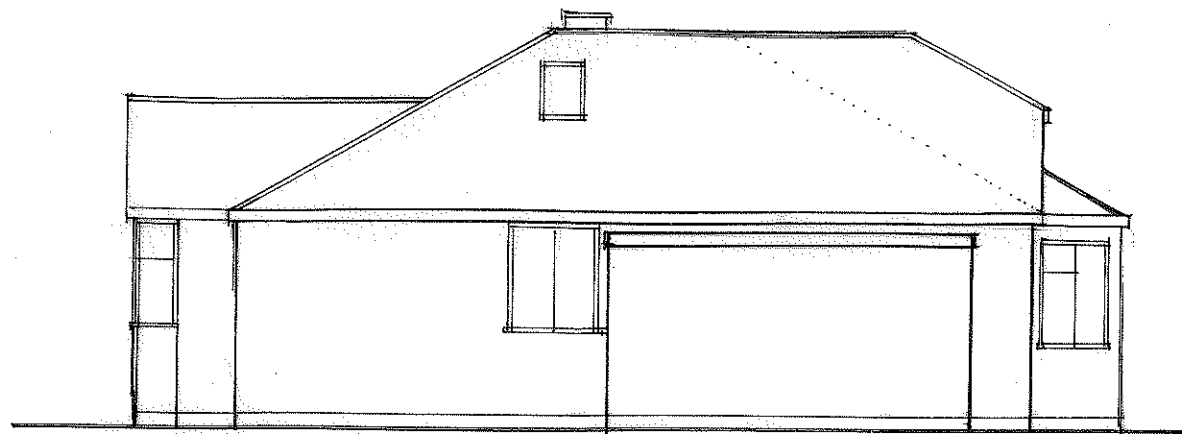


EXISTING SIDE

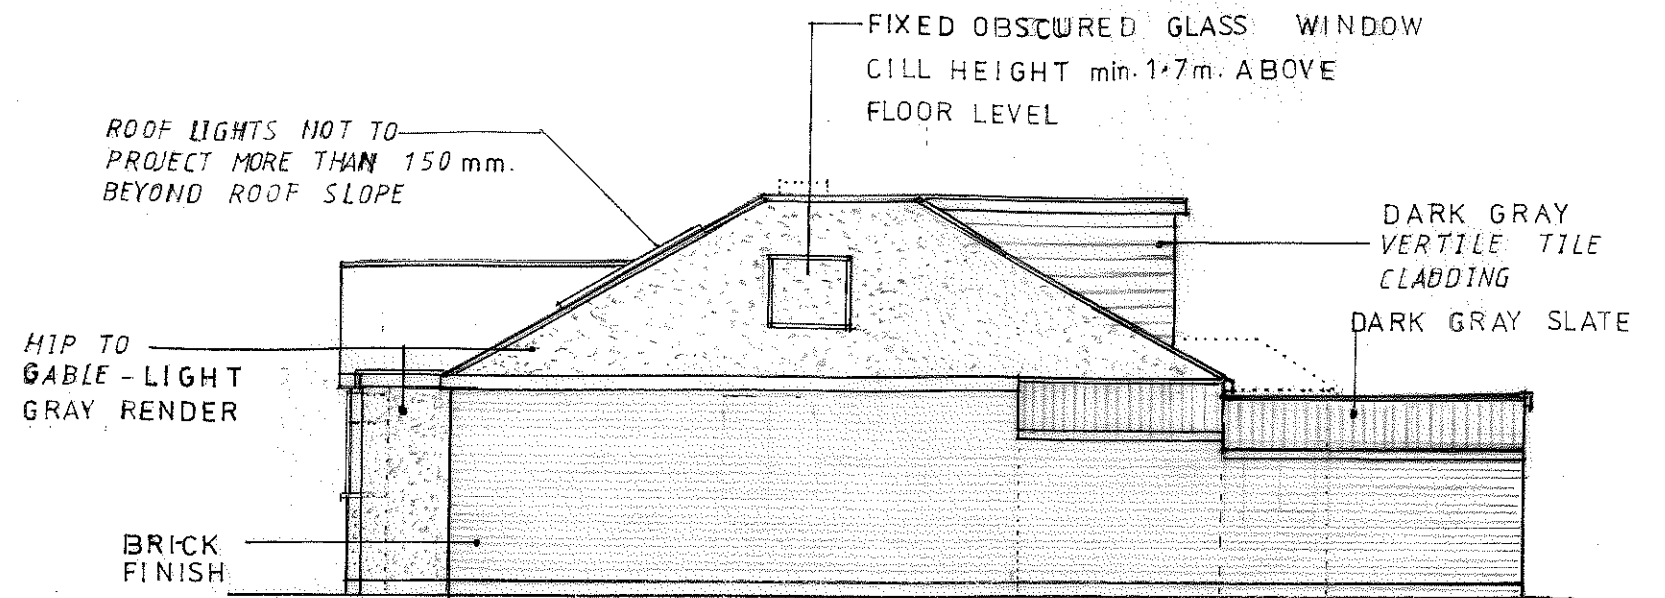


PROPOSED SIDE
VIEWED FROM No.15

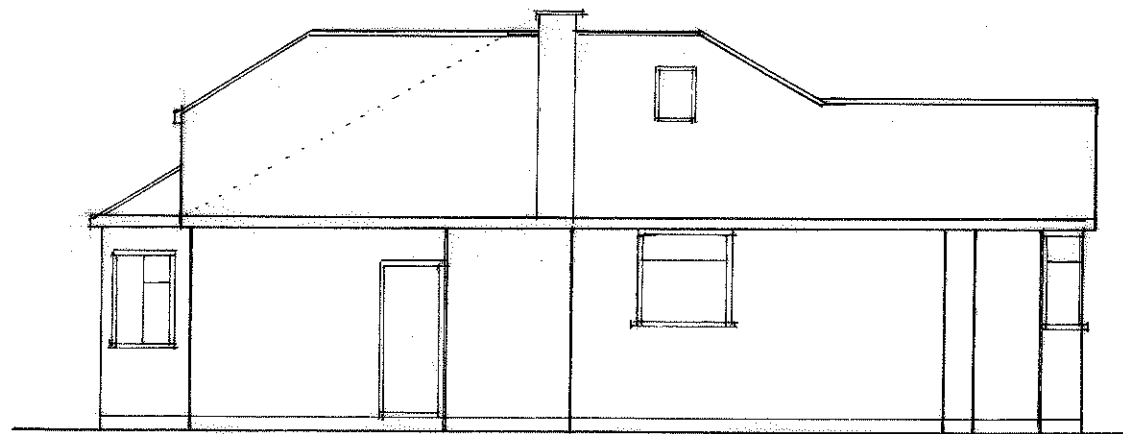

EXISTING SIDE

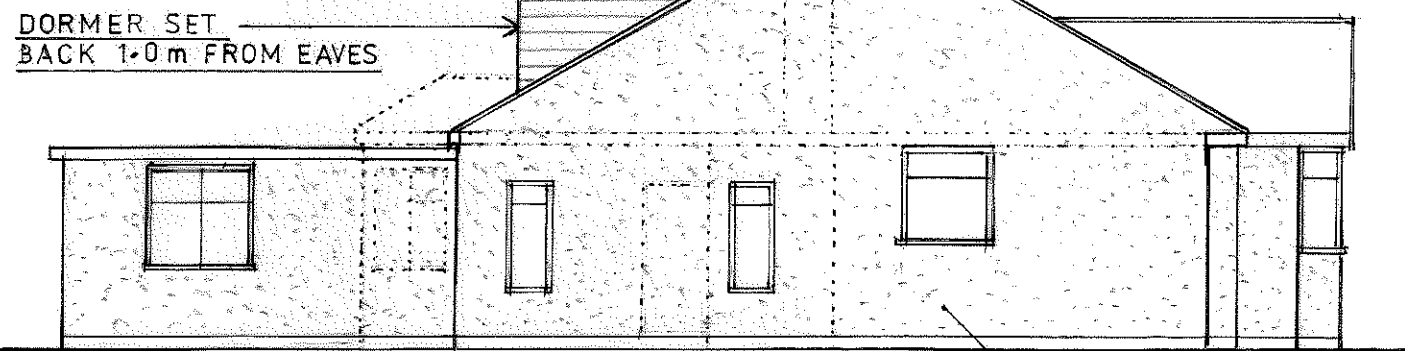

PROPOSED SIDE
VIEWED FROM NO.13

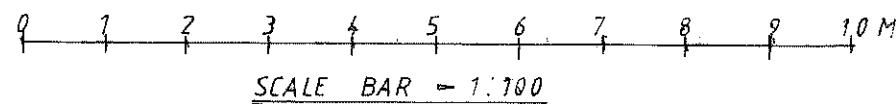

EXISTING & PROPOSED SIDES


14 HIGHFIELD CRESCENT
NORTHWOOD, HA6 1EZ

SCALE = 1:100

DATE = MAY. 2024

Dwg.No. = KS/2024/04


Rev. ~~A~~ B C

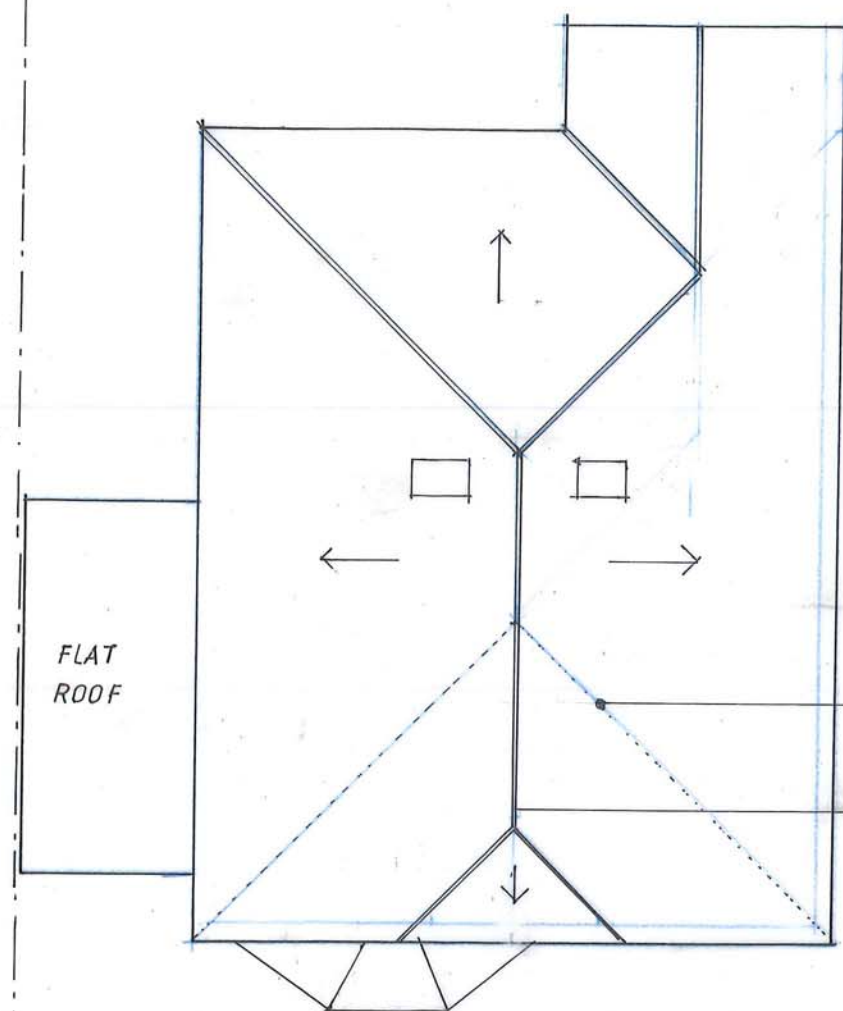


EXISTING ROOF PLAN

LINE OF ORIGINAL HIP

EXTENDED ROOF

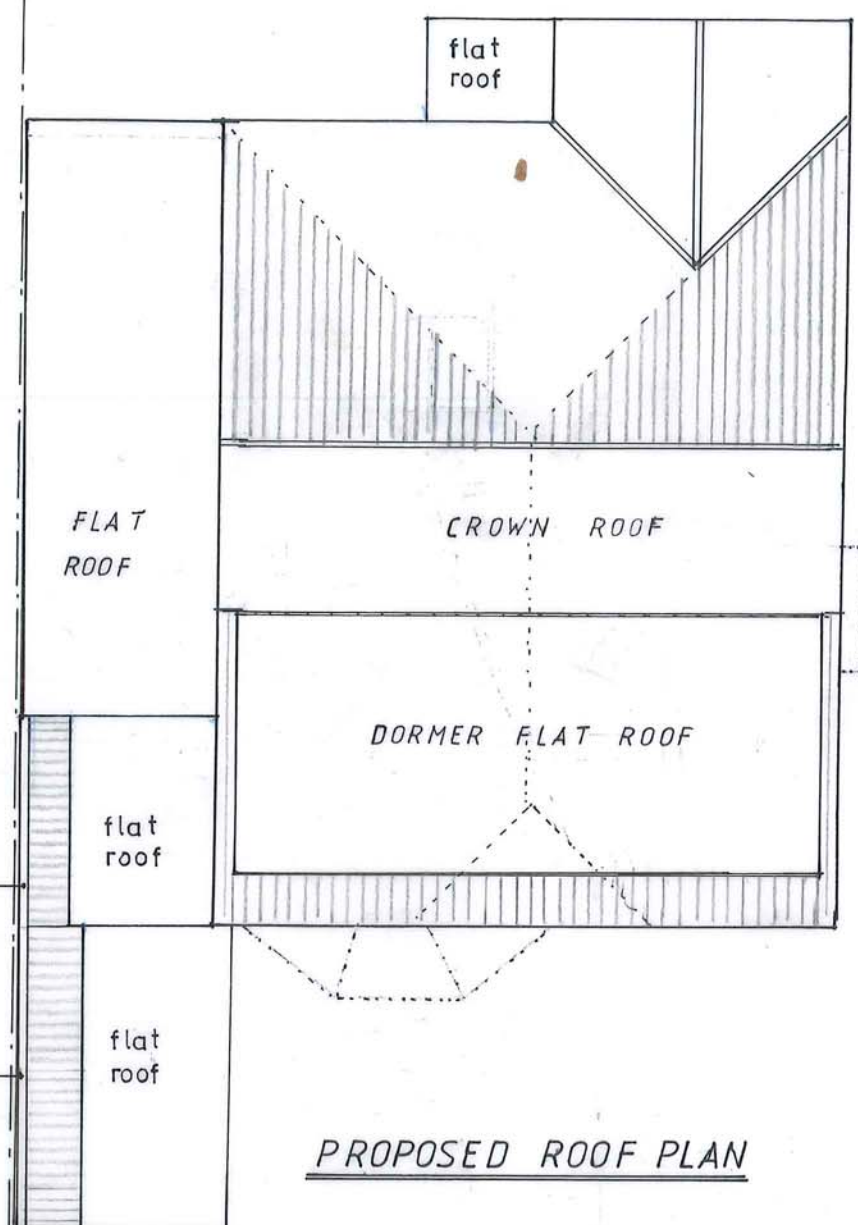

PROPOSED ROOF PLAN

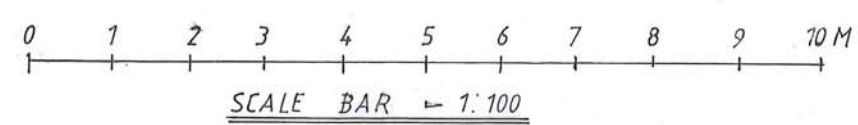


EXISTING & PROPOSED ROOF PLAN

14 HIGHFIELD CRESCENT
NORTHWOOD, HA6 1EZ

SCALE = 1:100 DATE = MAY. 2024

Dwg. No = KS/2024/05 Rev = ~~A~~ B

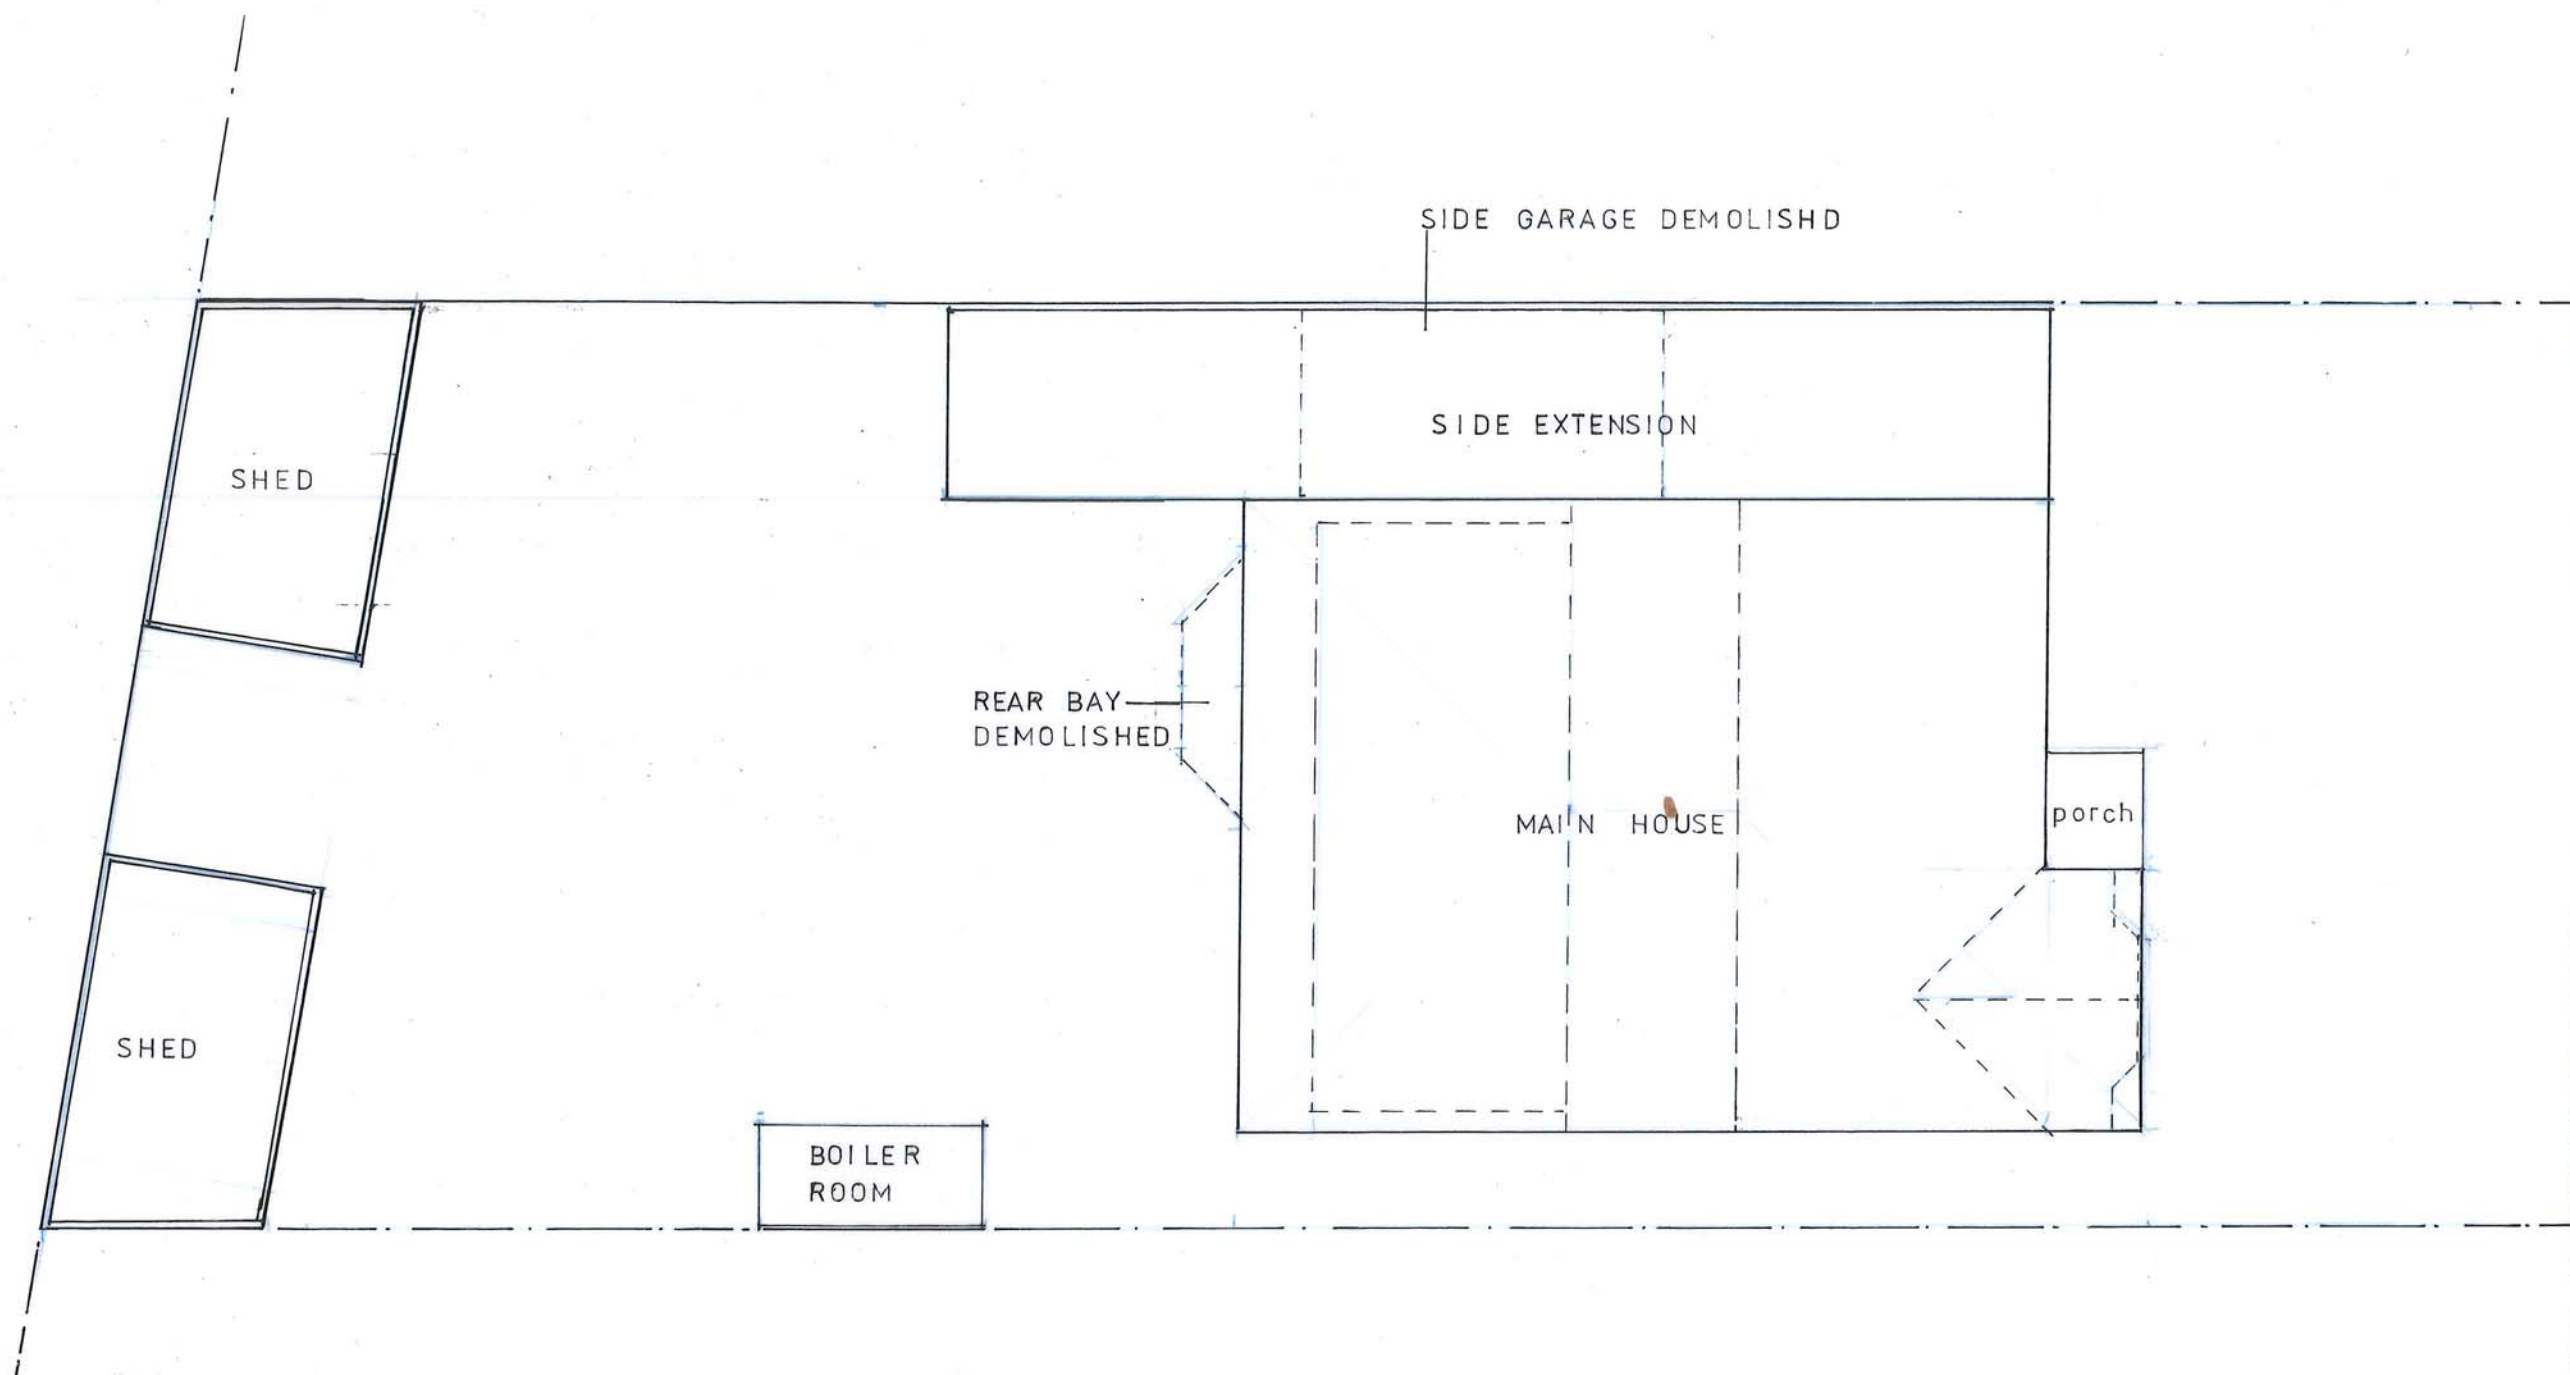

0 1 2 3 4 5 6 7 8 9 10 m
SCALE 1:100

SITE BLOCK PLAN

14 HIGHFIELD CRESCENT
NORTHWOOD , HA6 1EZ

SCALE ▶ 1:100

DATE ▶ MAR. 2025

DRG.No. KS/2024/06

REV ▶