



Ground Floor 235sqm GEA (211sqm GIA)

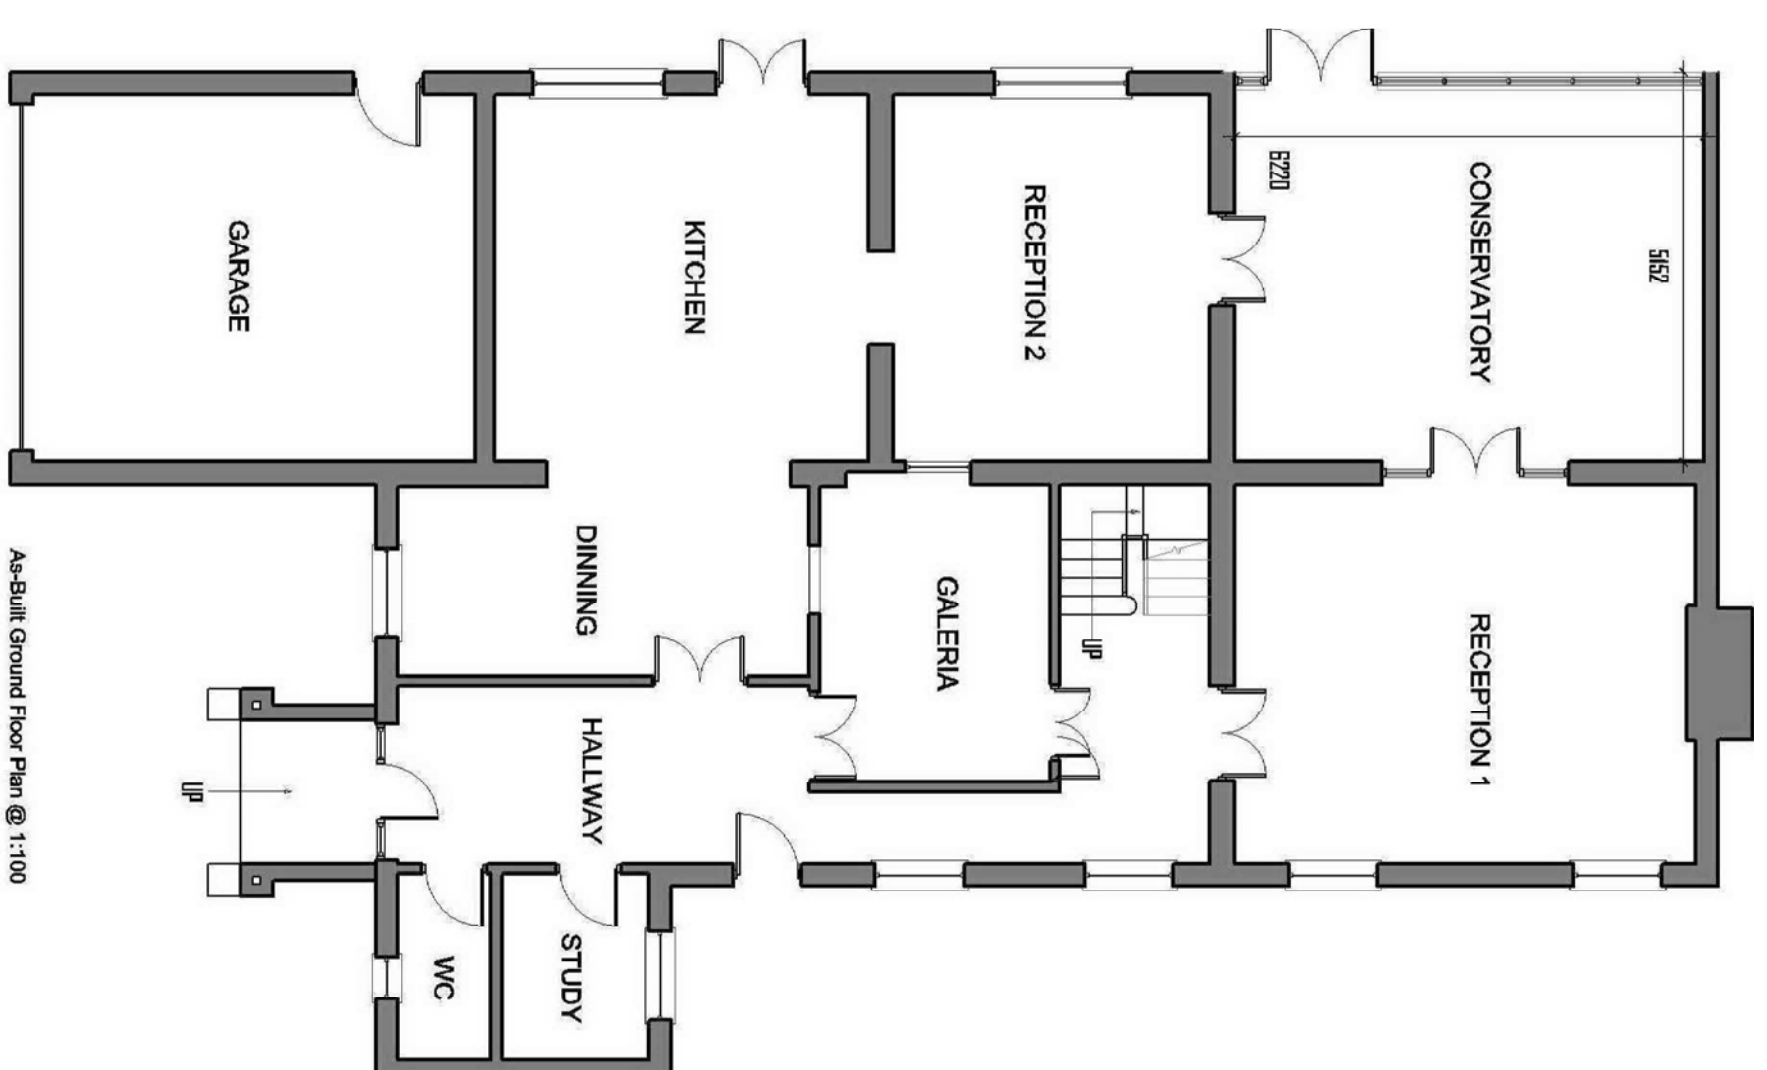


As-Built Ground Floor Plan @ 1:100


First Floor 167sqm GEA (145sqm GIA)

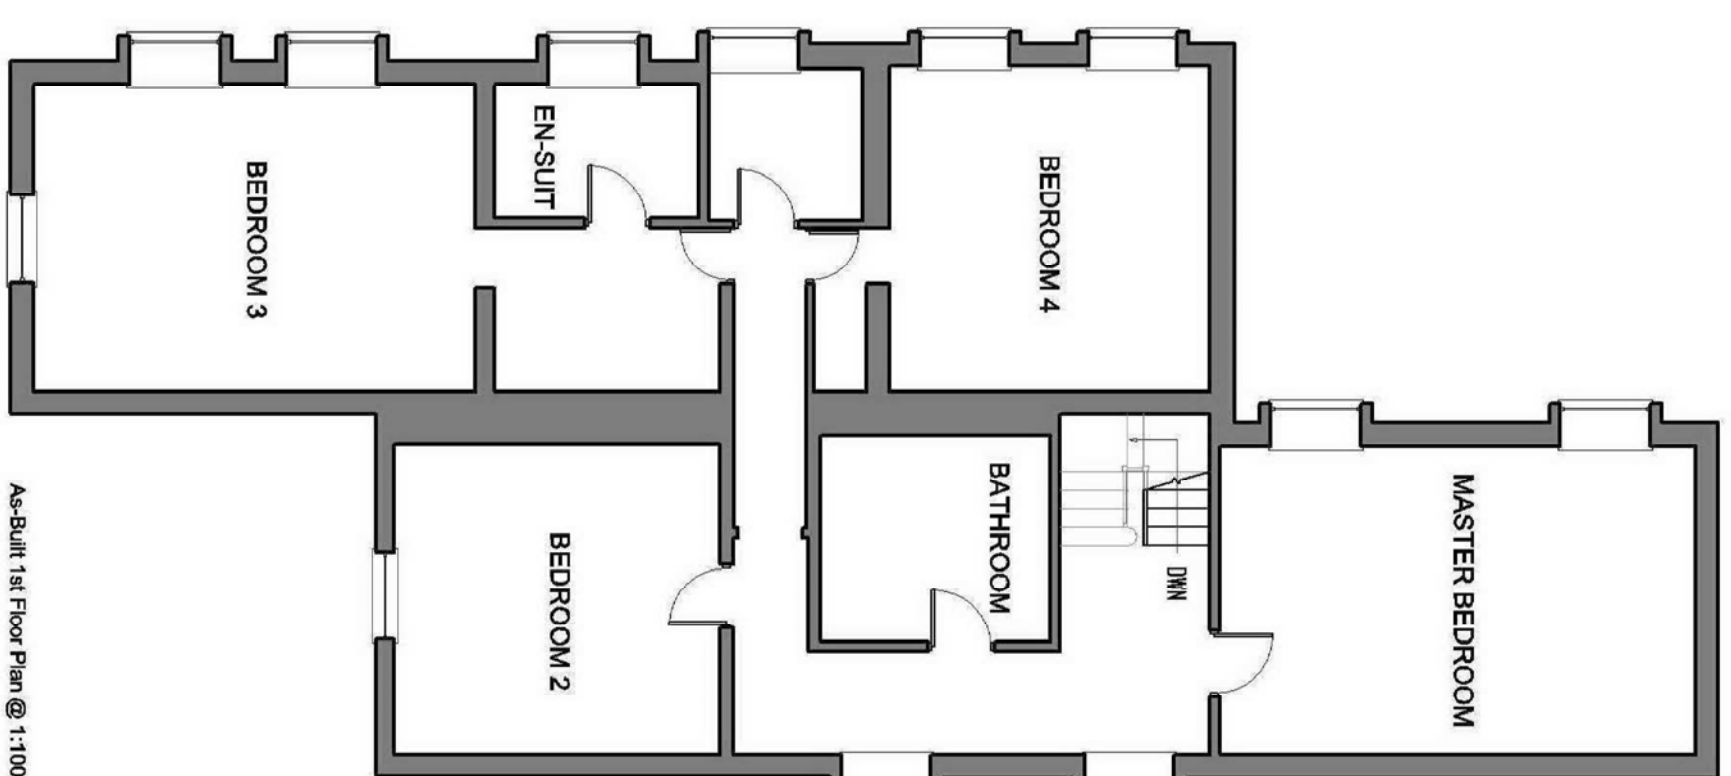


As-Built 1st Floor Plan @ 1:10

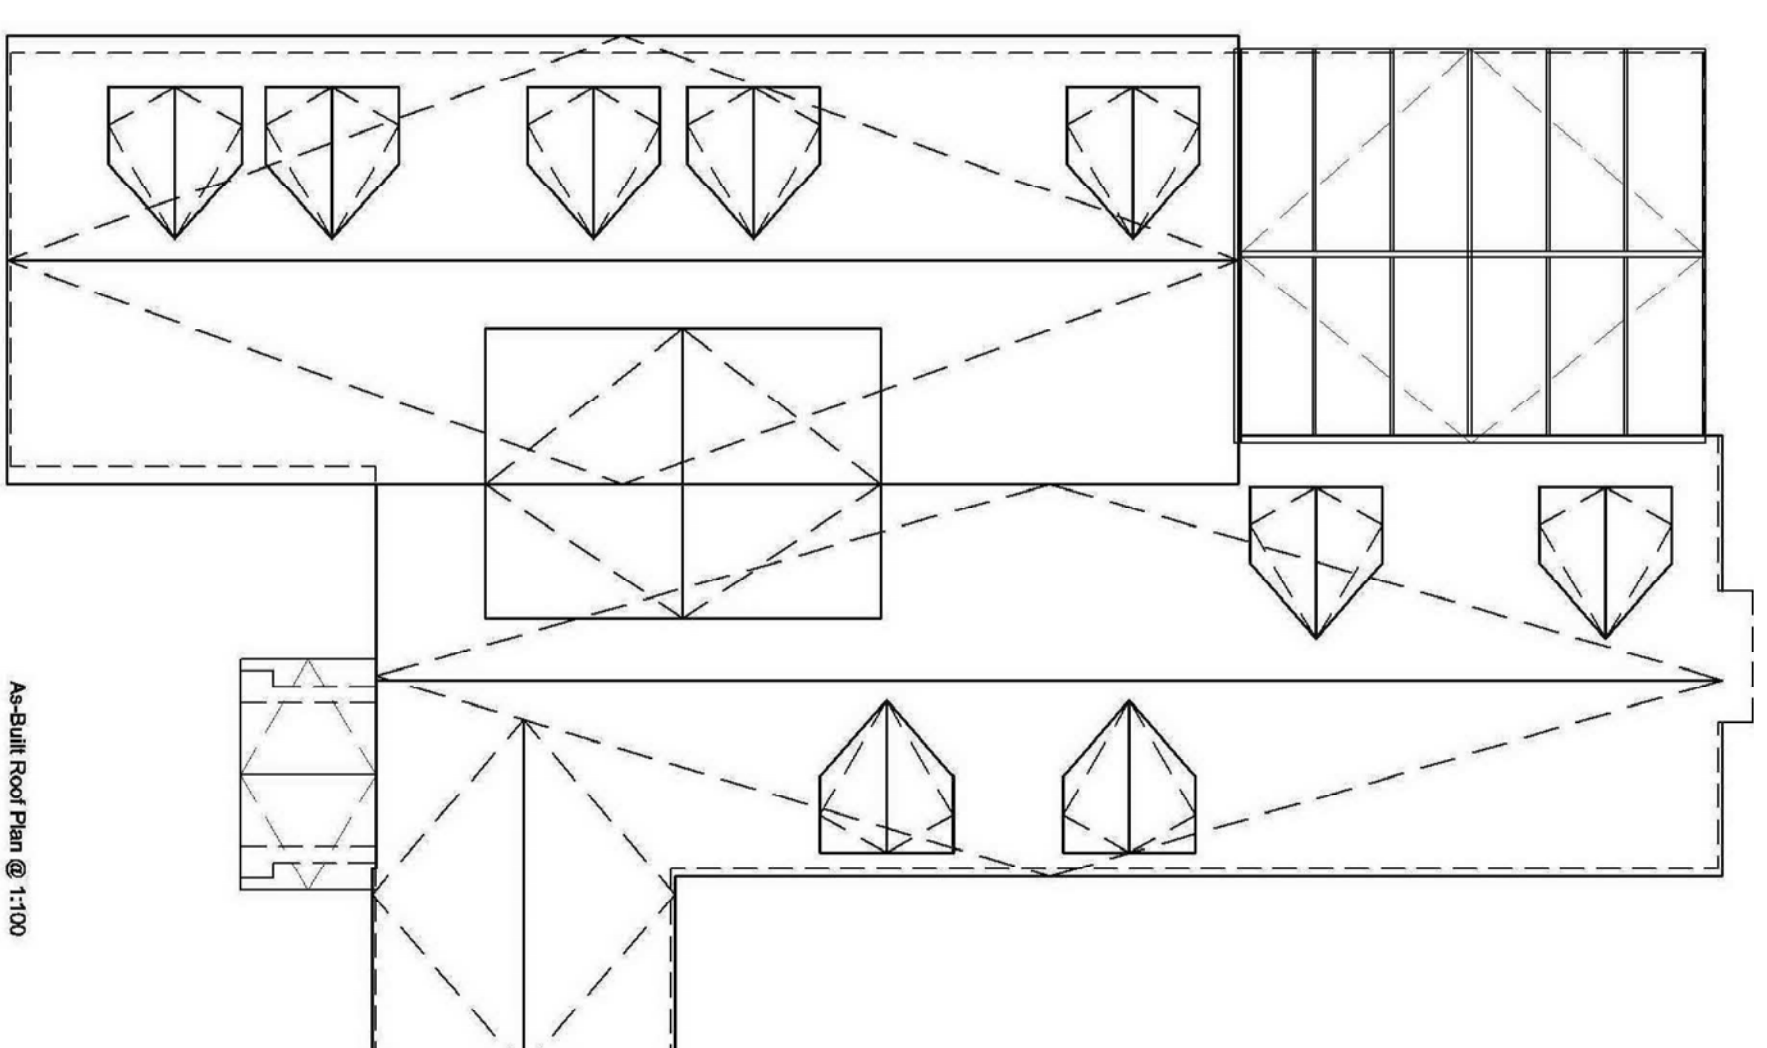


As-Built Roof Plan @ 1:10

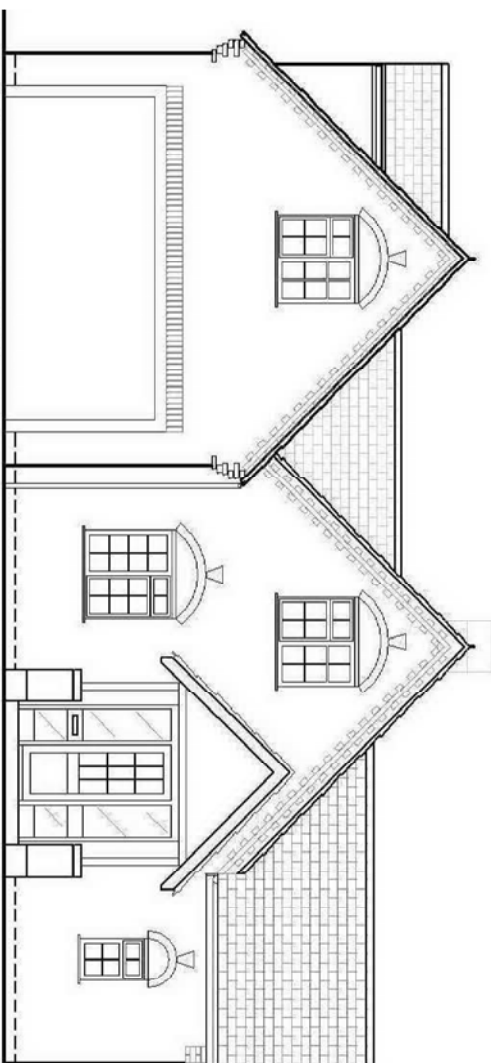


As-Built Front Elevation @ 1:100

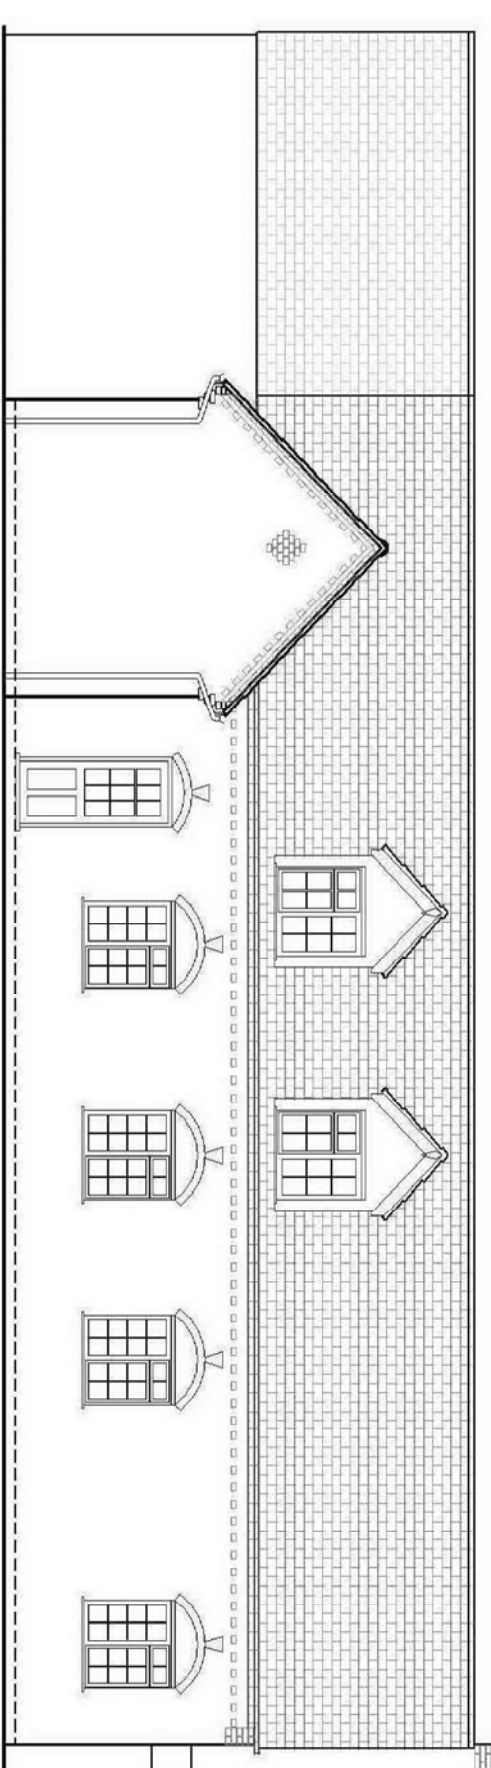

As-Built Side Elevation @ 1:100

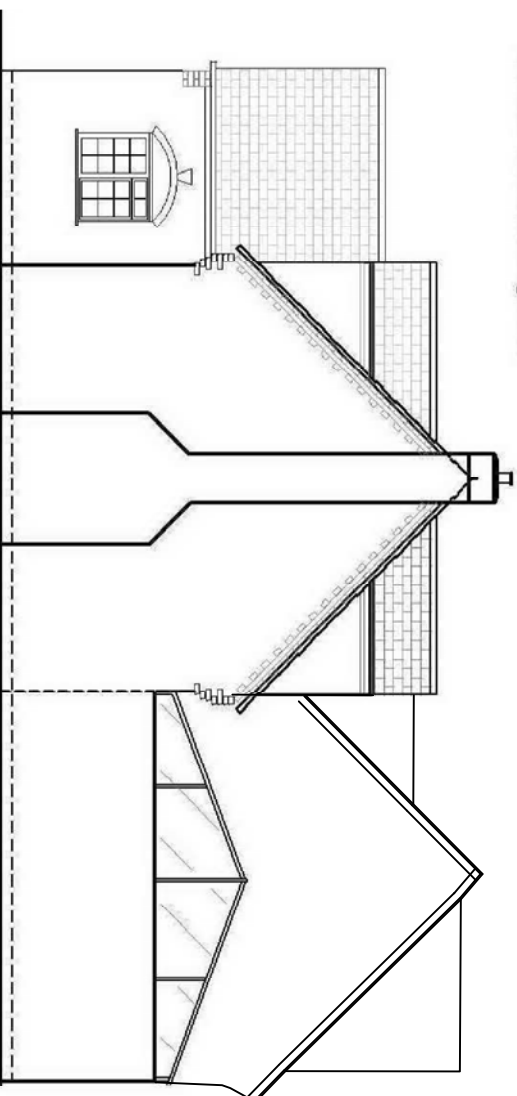

As-Built Rear Elevation @ 1:10

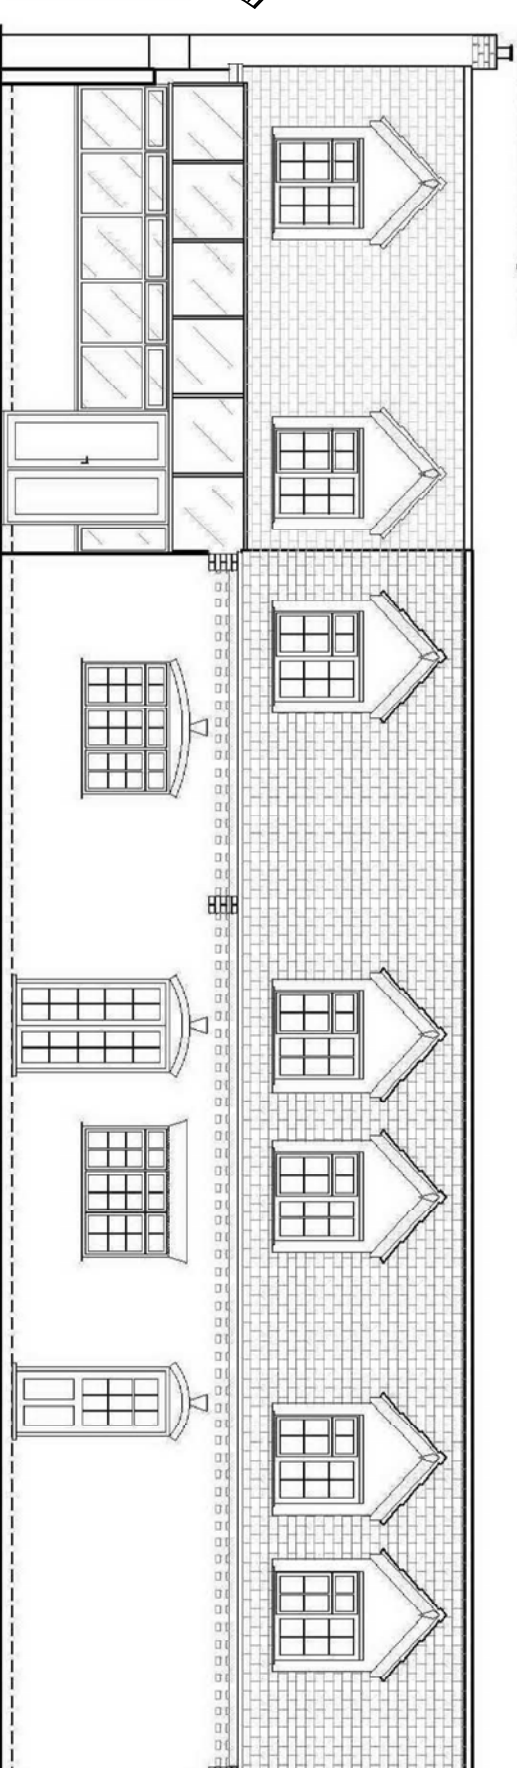

As-Built Side Elevation @ 1:100

WC 11/a	A1
1:100	

Scaling from a print of the drawing will only give approximate dimensions due to inherent inaccuracies in printed media. Where accurate dimensions are required, please refer to the R-Curve Planning Ltd. 2. Proposed works are based upon survey information provided by others. R-Curve Planning Ltd. does not accept responsibility for discrepancies in survey information.

3. All dimensions to be checked on site prior to commencement of any works, and/or preparation of drawings.
4. All co-ordinates, levels, dimensions and discrepancies are to be reported to R-Curve Planning Ltd.

5. Nothing Ltd. is to be relied in conjunction with all relevant drawings, specifications and other. Consultant's information.

DRAWING TITLE: Existing House Plan	SITE ADDRESS: Woodlands 700 Drive Ickenharn	<i>R Clark Planning</i> 4699 WEST PARK DR. SUITE 200 NORTH WOOD, INDIAN TEL: 317-834-1100 FAX: 317-834-1000 Mobile number: 317-906	R Clark Planning Ltd
--	---	---	-----------------------------