


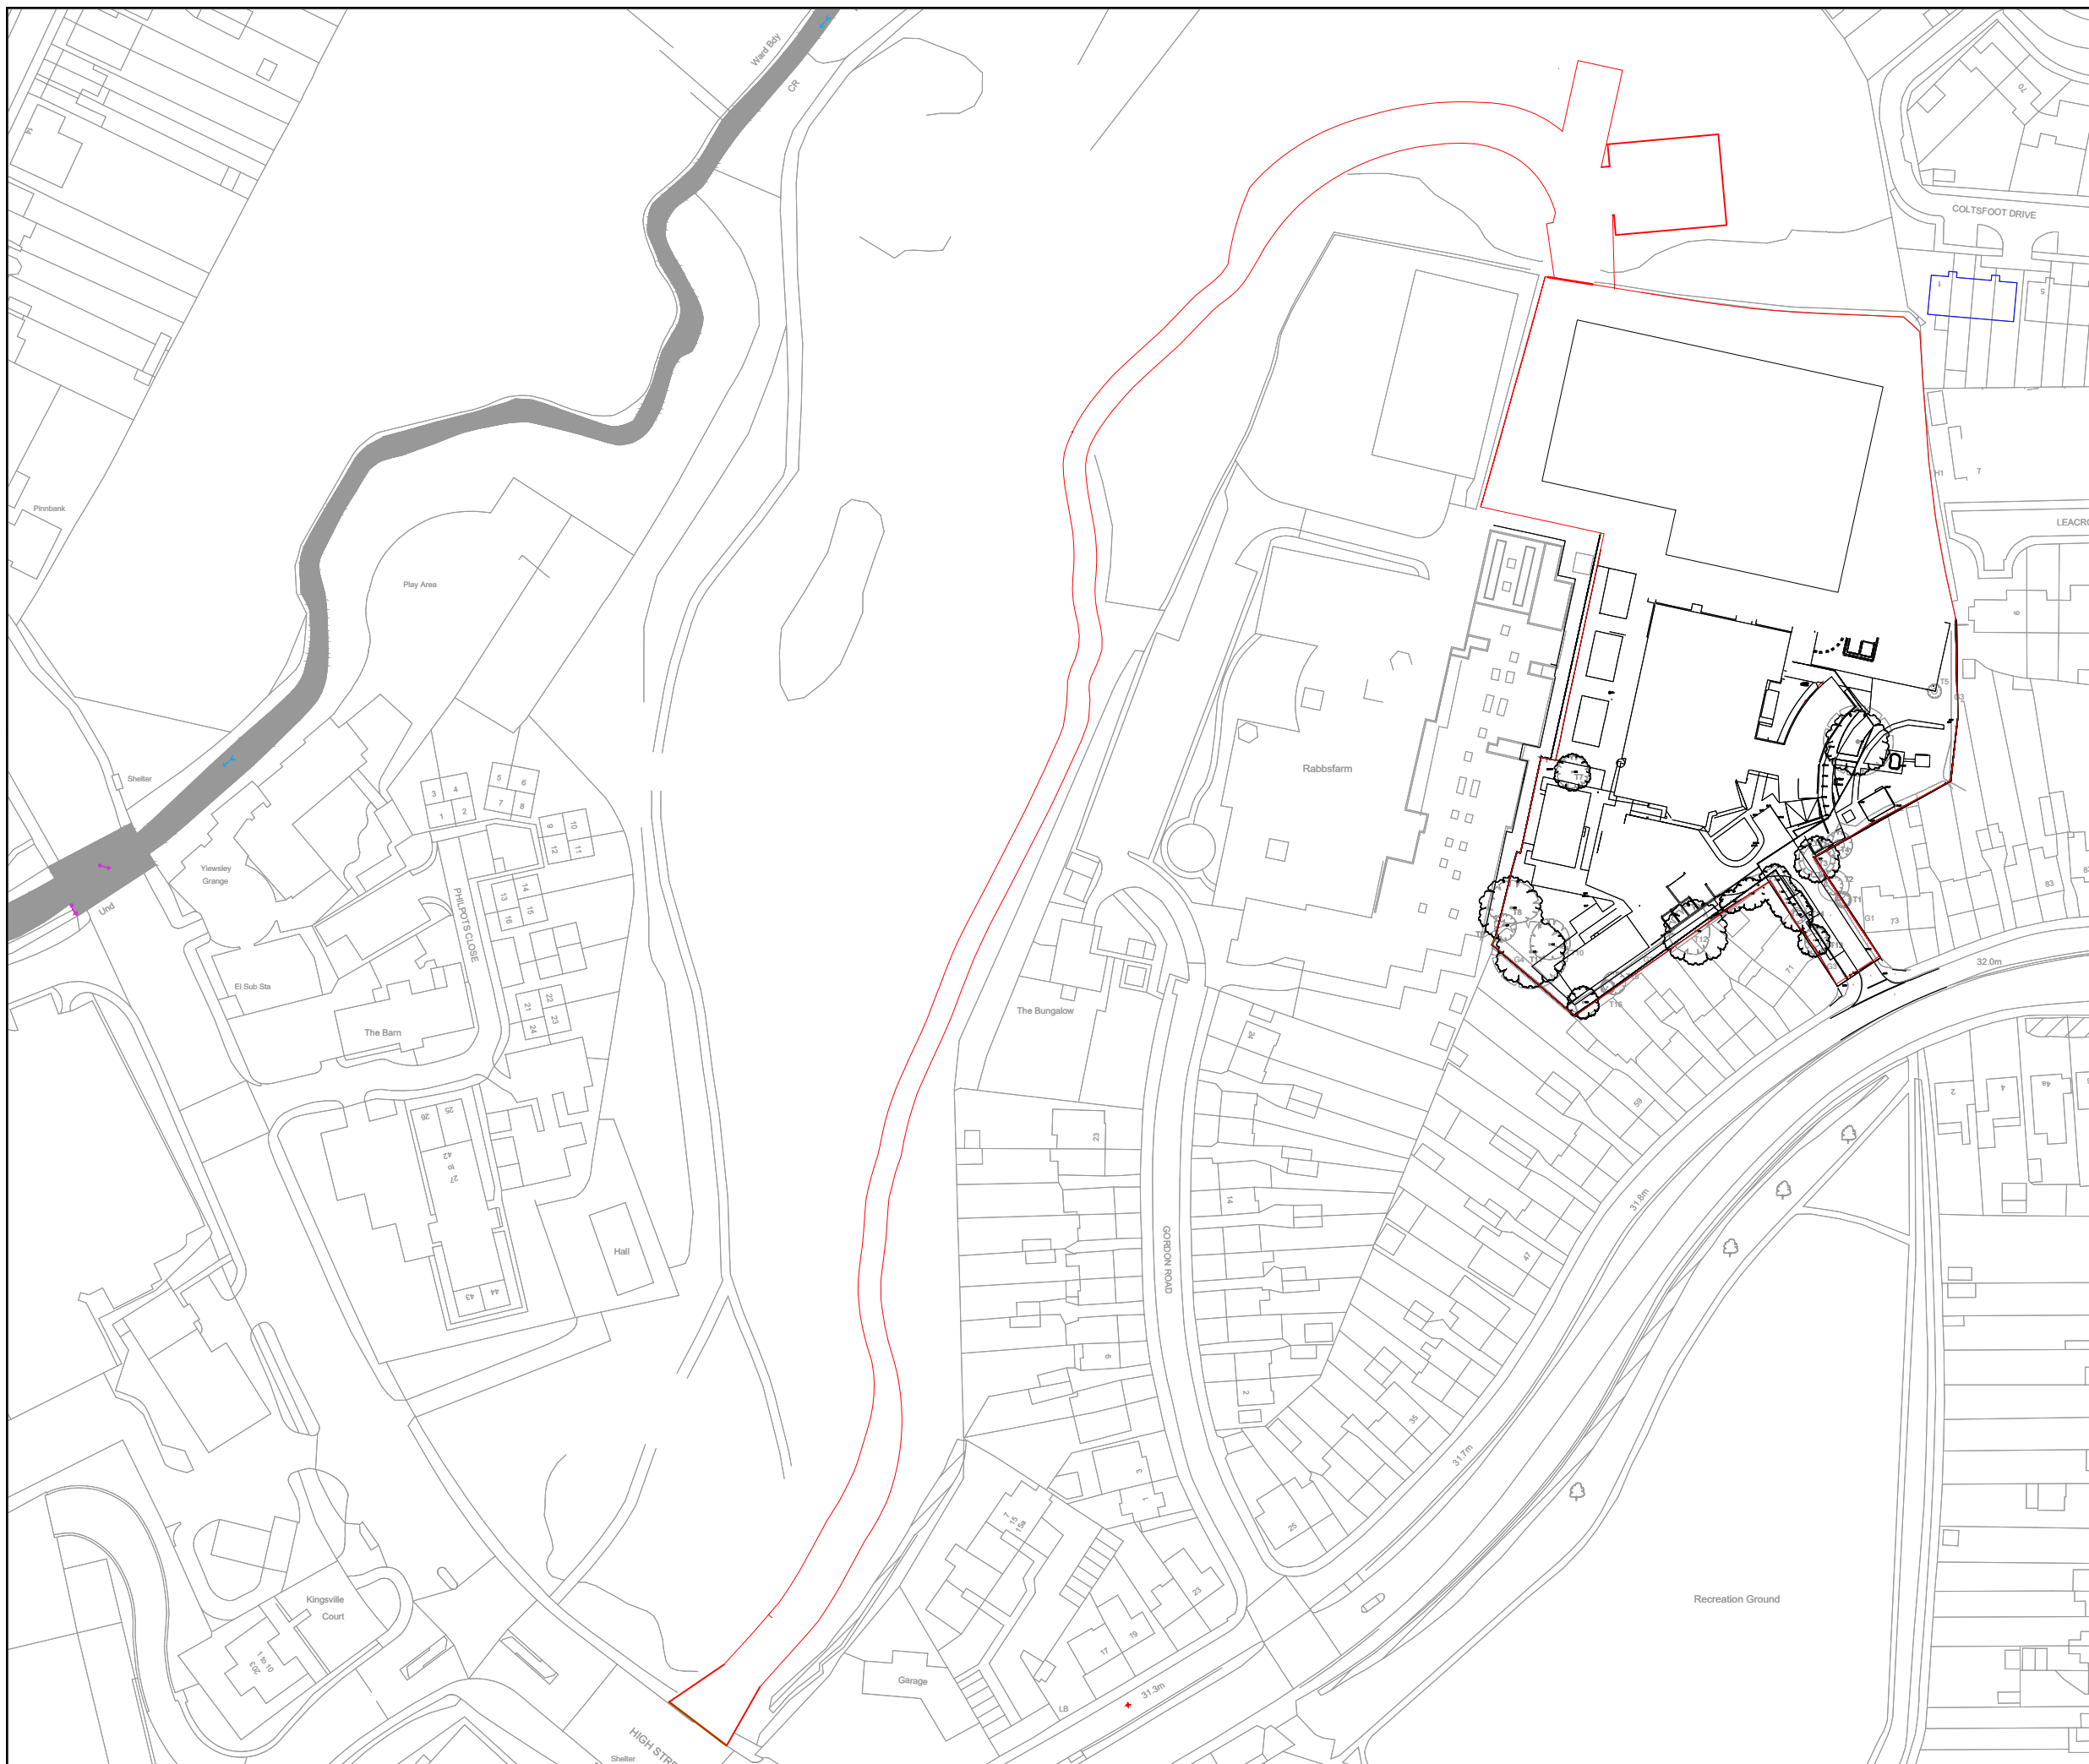

General Notes

- 1). Under no circumstances should dimensions be scaled from this drawing "if in doubt ask".

Previous red line boundary

Proposed red line boundary

Note - change is only to haul road boundary, not school site.

Rev	Date	By	Comment
P01	13/08/20	CM	First Issue

Project name	Orchard Hill School
--------------	---------------------

Drawing title

New Red Line Boundary for
Haul Road



Purpose of issue
For information

Drawn by C Murphy	Scale Not to scale
Job Number N/A	Date 13/08/20
Drawing Number TBC	Rev P01