


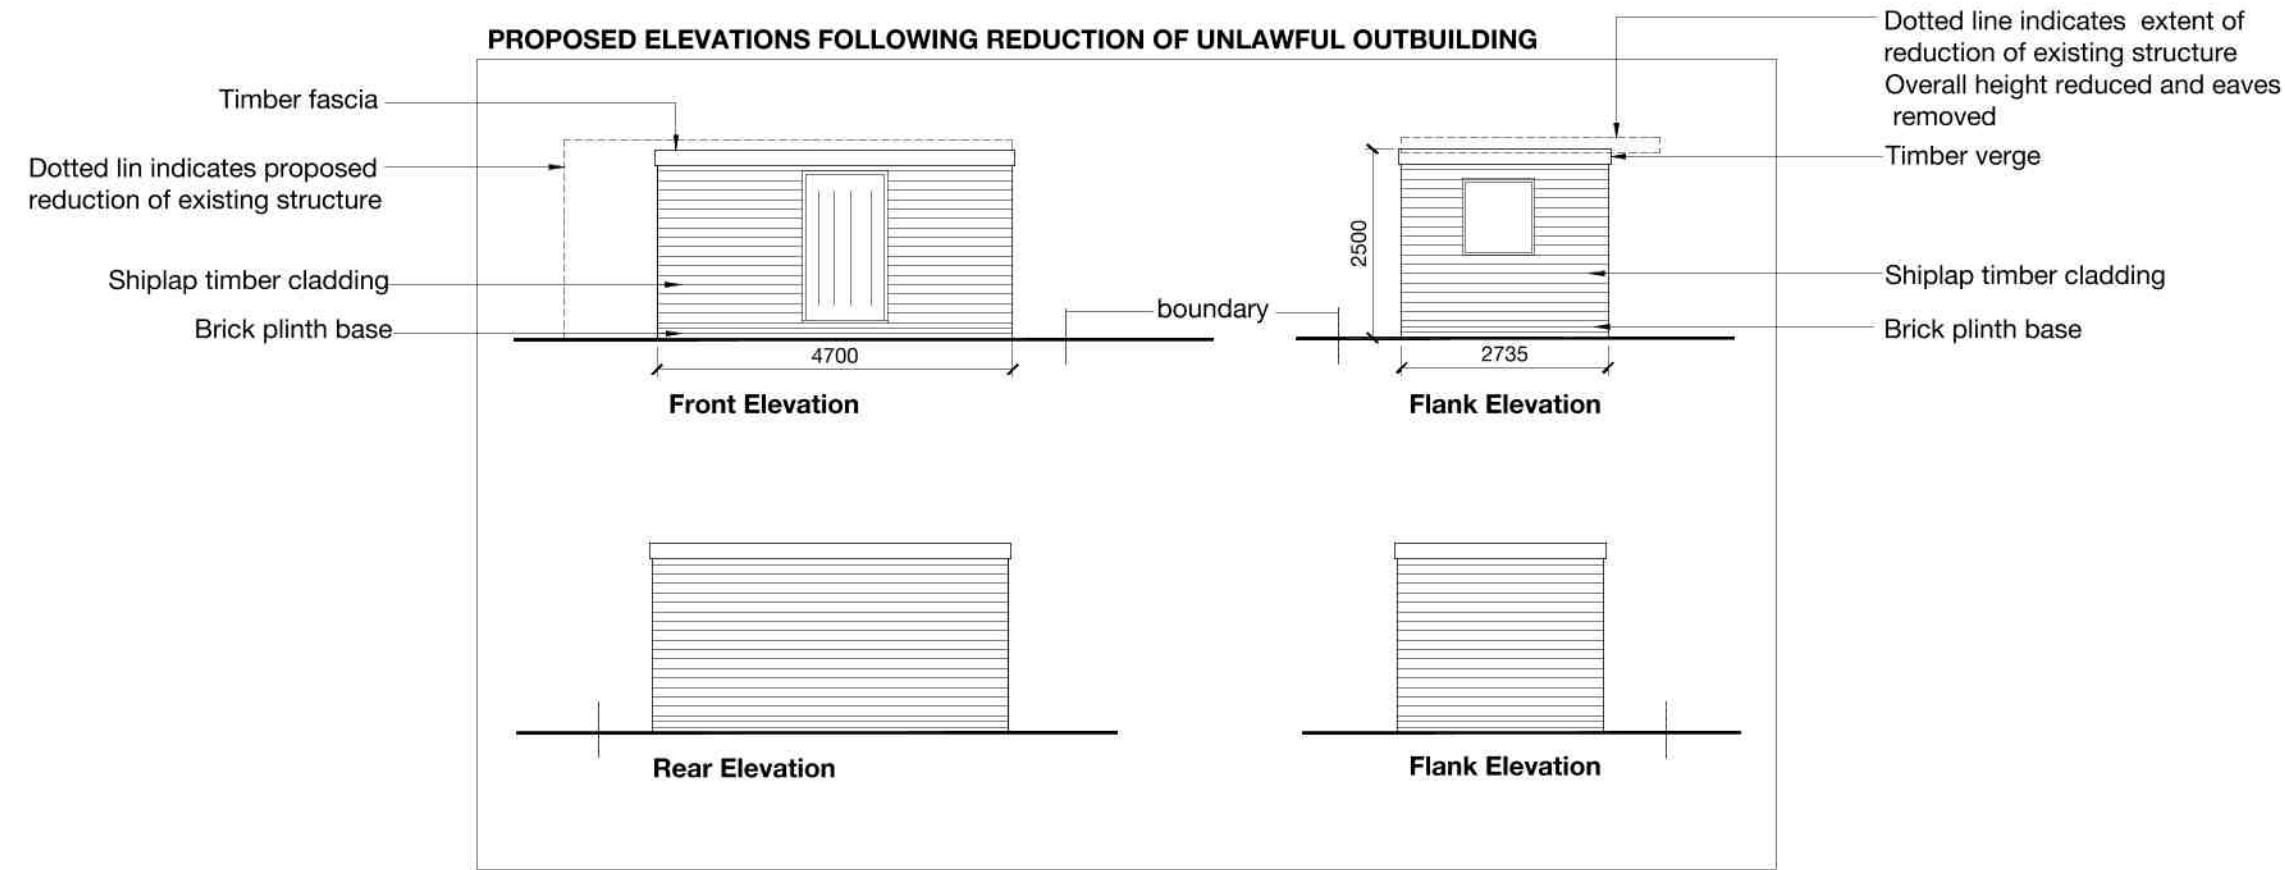
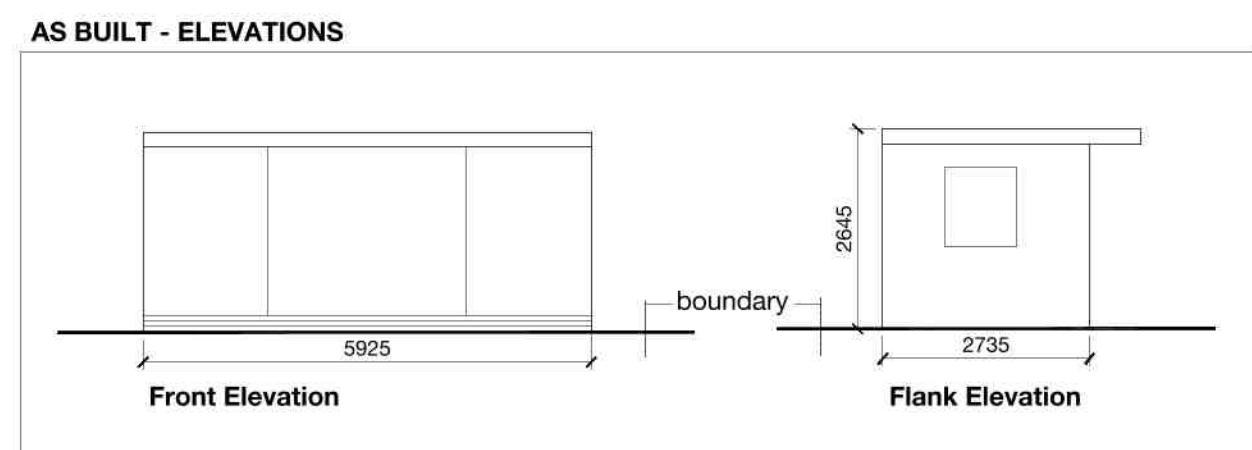


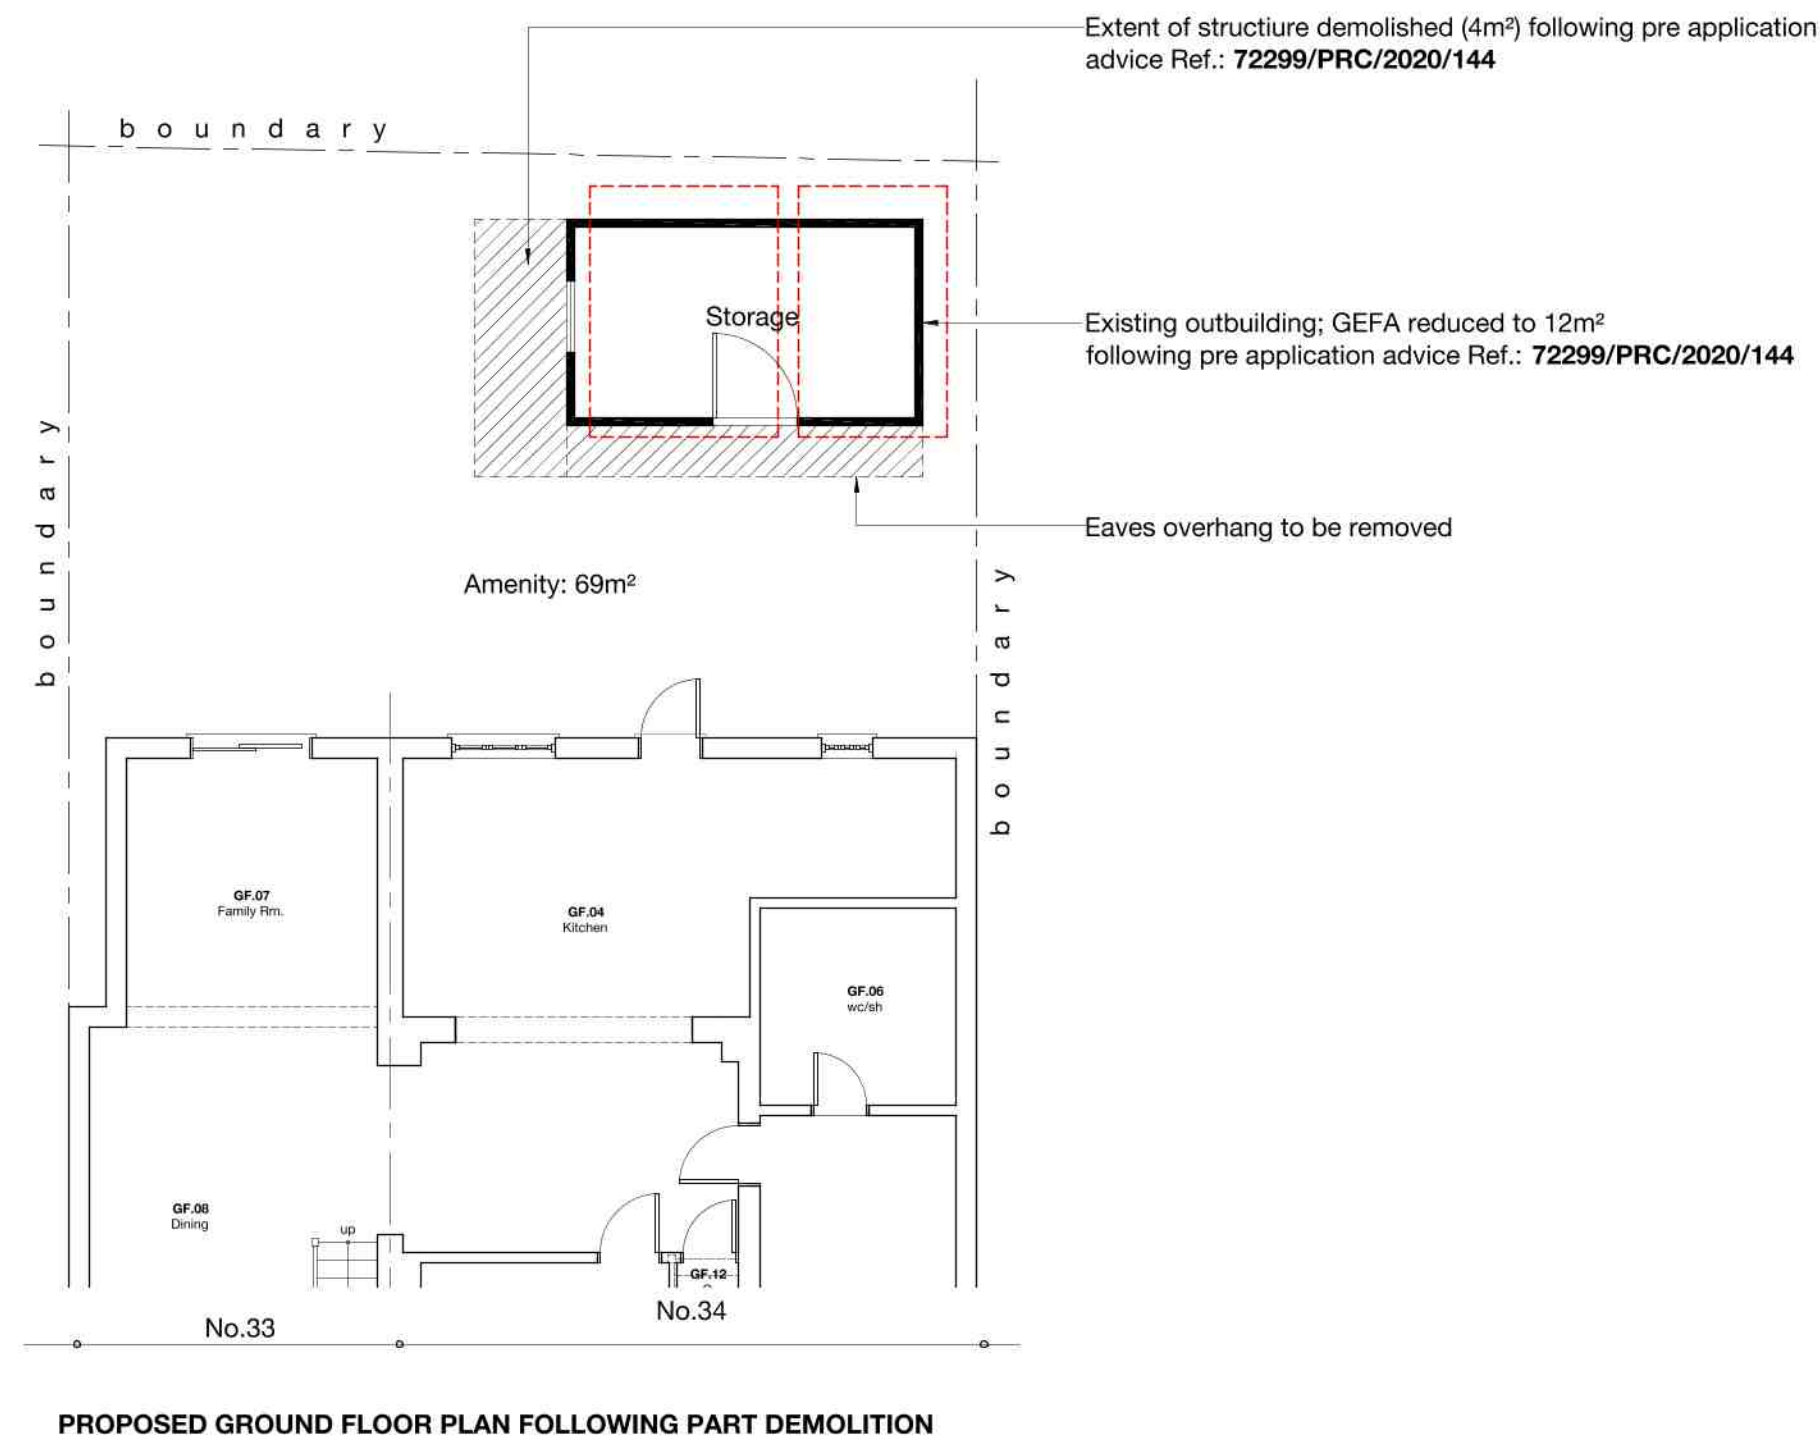

Existing outbuilding; GEFA: 16m²
Works suspended due to Enforcement notice ENF/346/20

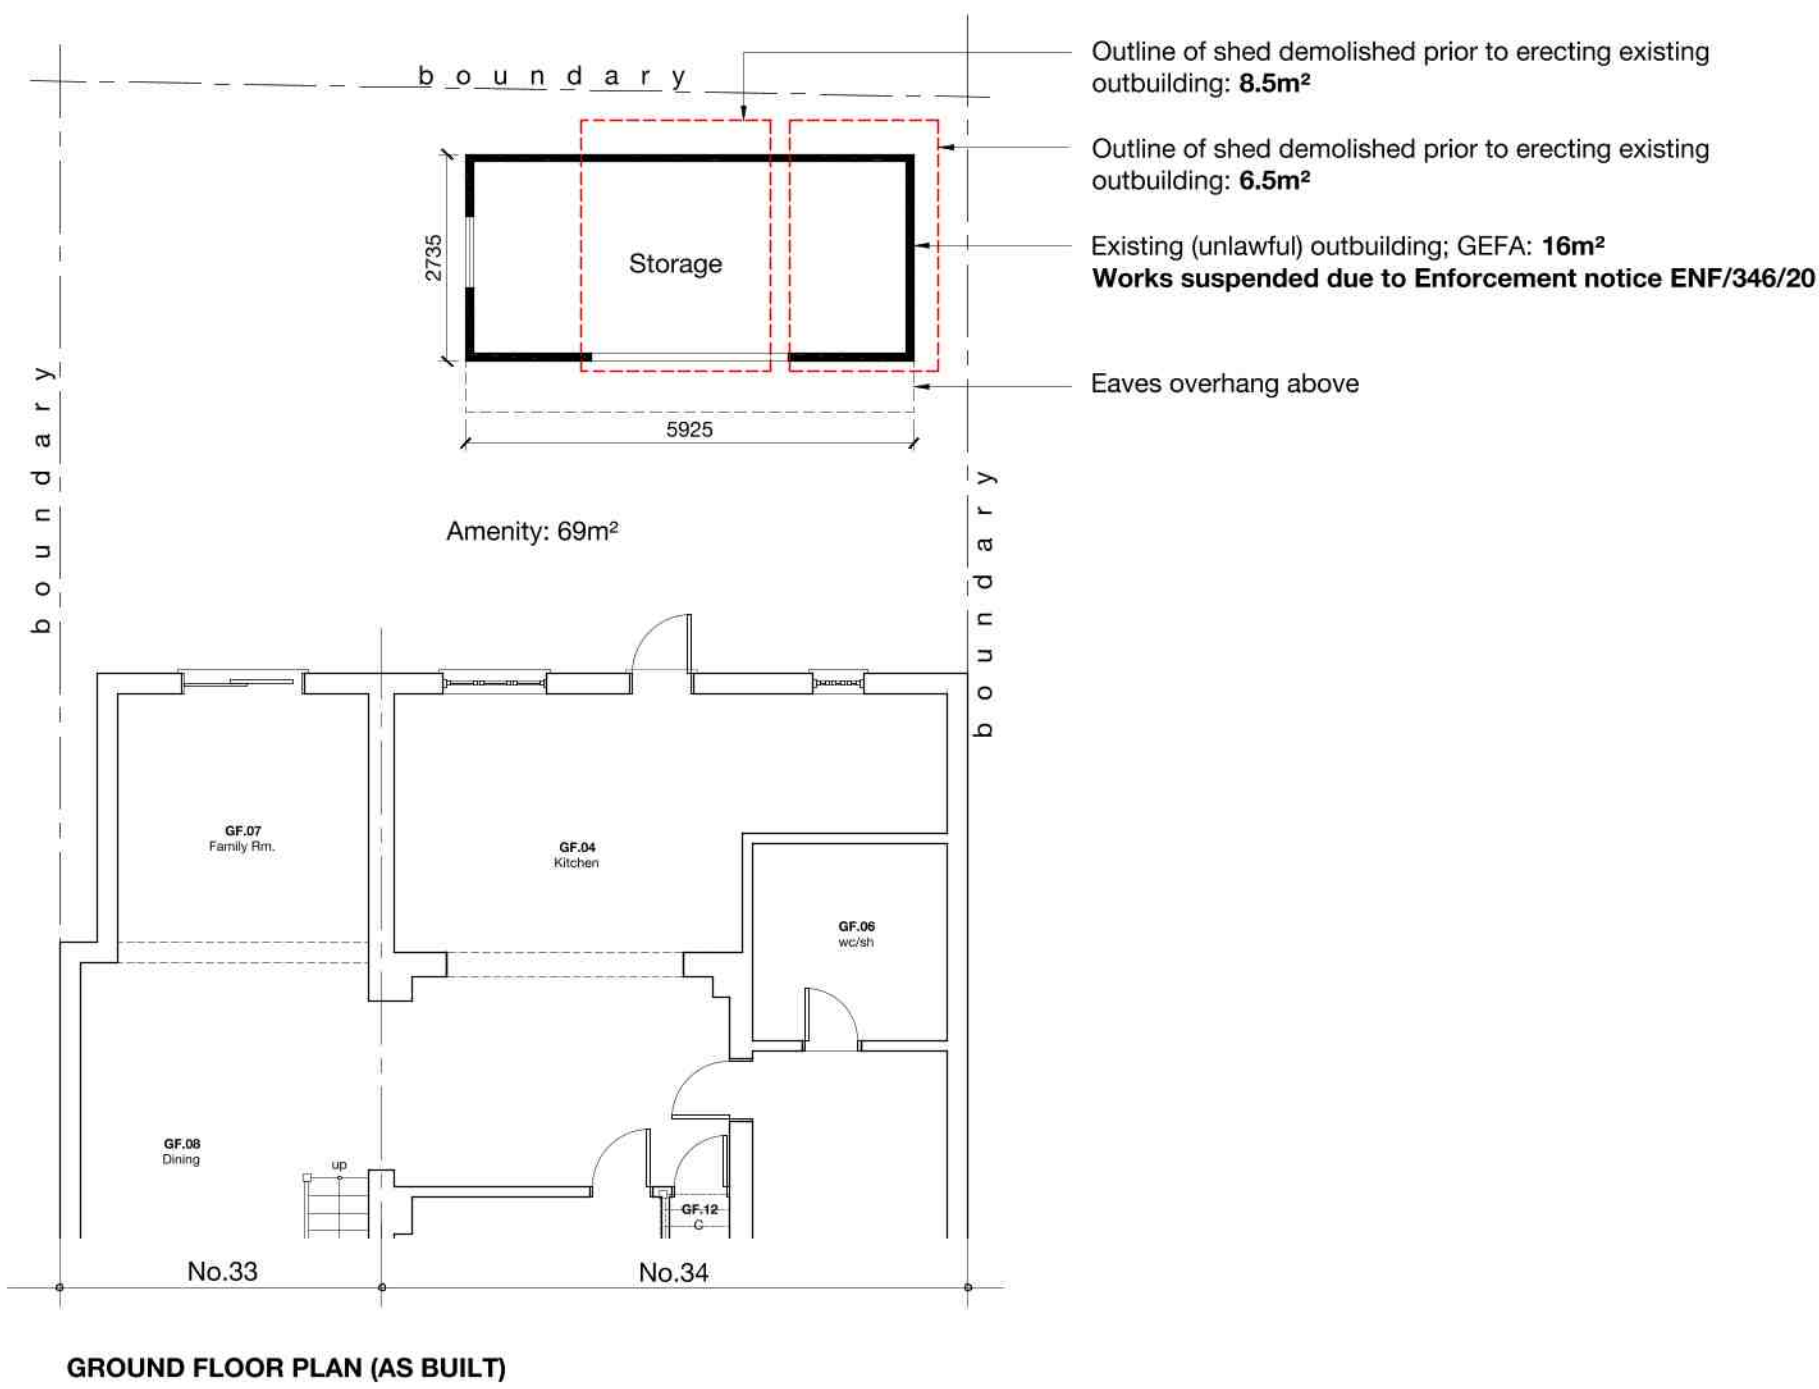

A	11.11.20	KSP	Door opening amended on plan
A	11.11.20	KSP	Room labels and elevations added
Revision			

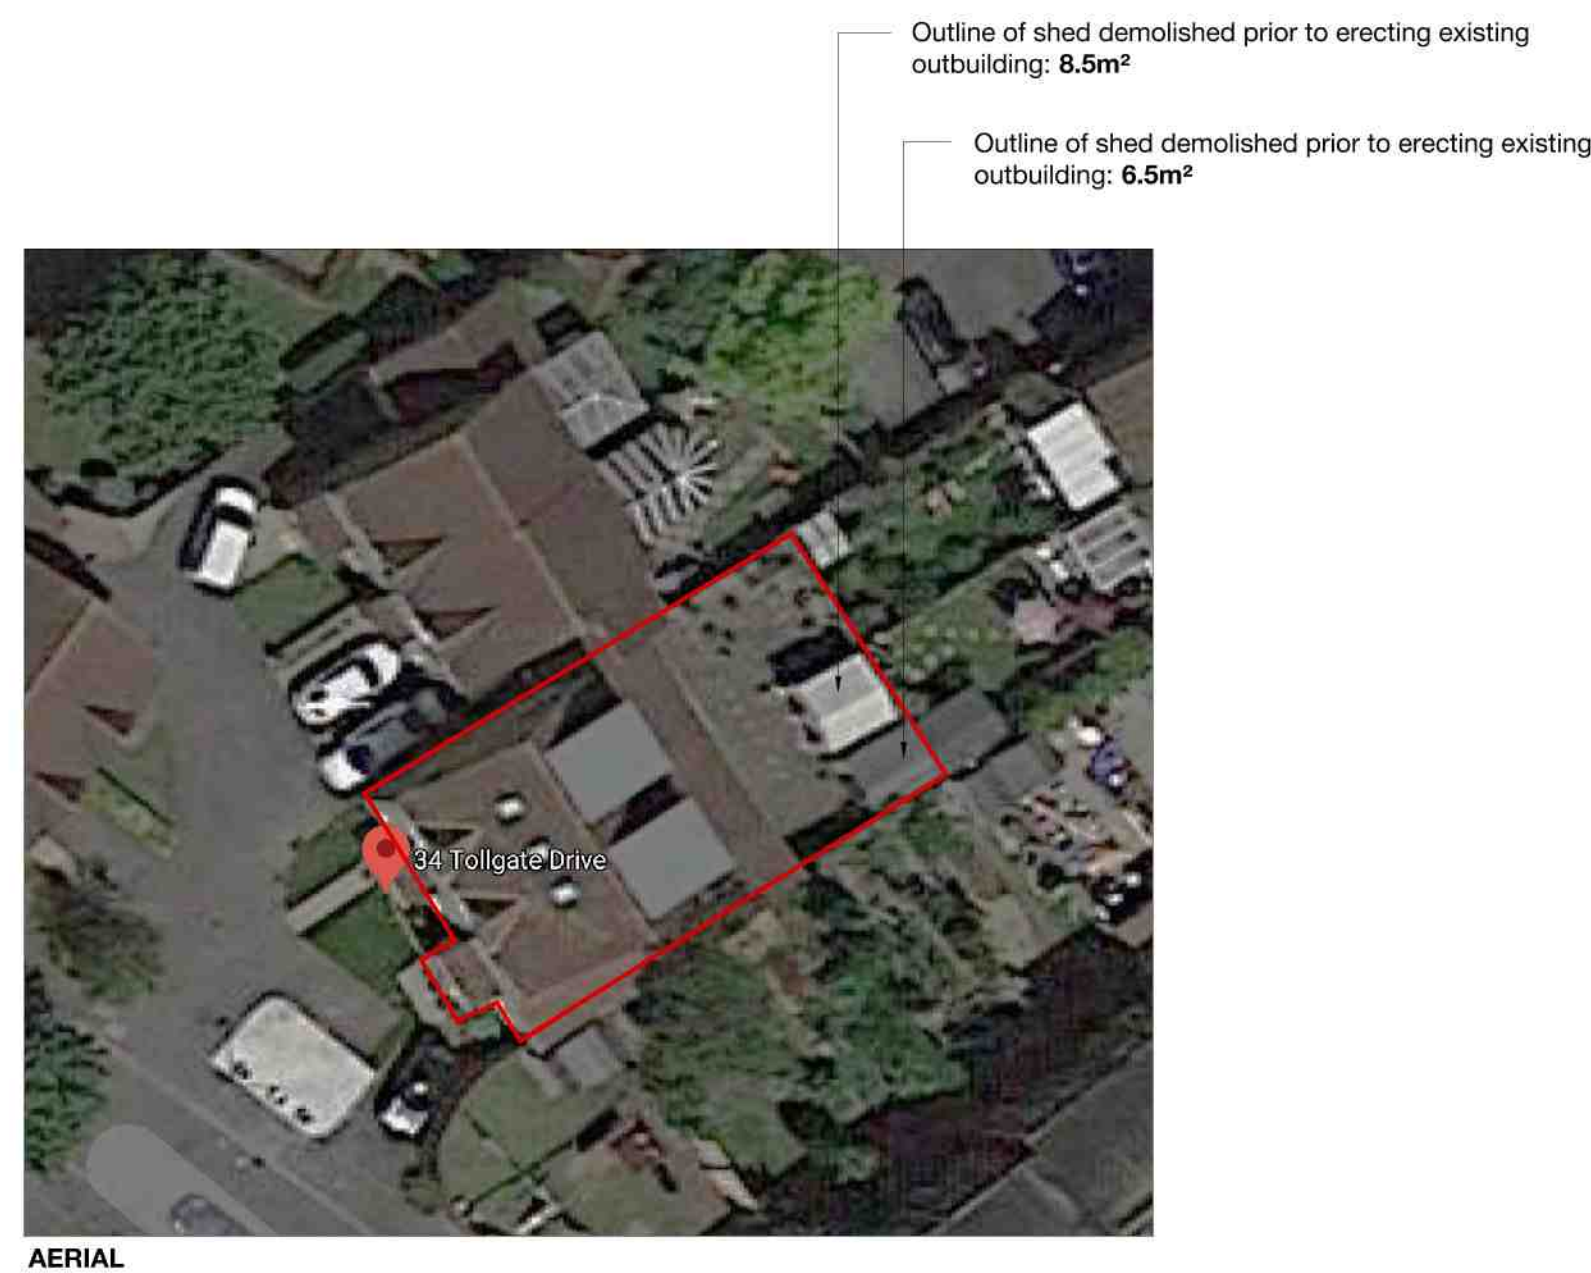

drawing notes

© Aksoi Architecture Ltd 2020

All rights described in chapter IV of the Copyright Designs & Patents Act 1988 have been generally asserted. This Drawing must not be scaled; only figured dimensions should be used. If there are any discrepancies, or contradictions between this and other information, it should be brought to the Architect's attention.

client:

project:

33 & 34 Tollgate Drive, Hayes UB4

drawing title:

AS BUILT & PROPOSED PLANS & ELEVATIONS

date:

scale:

project no.:

drawing no.:

Oct. 2020

1:100 @A1
1:200 @A3

2020.009

C01

B