


SCALE BAR 1:100




# LOCATION PLAN

SCALE 1:1250

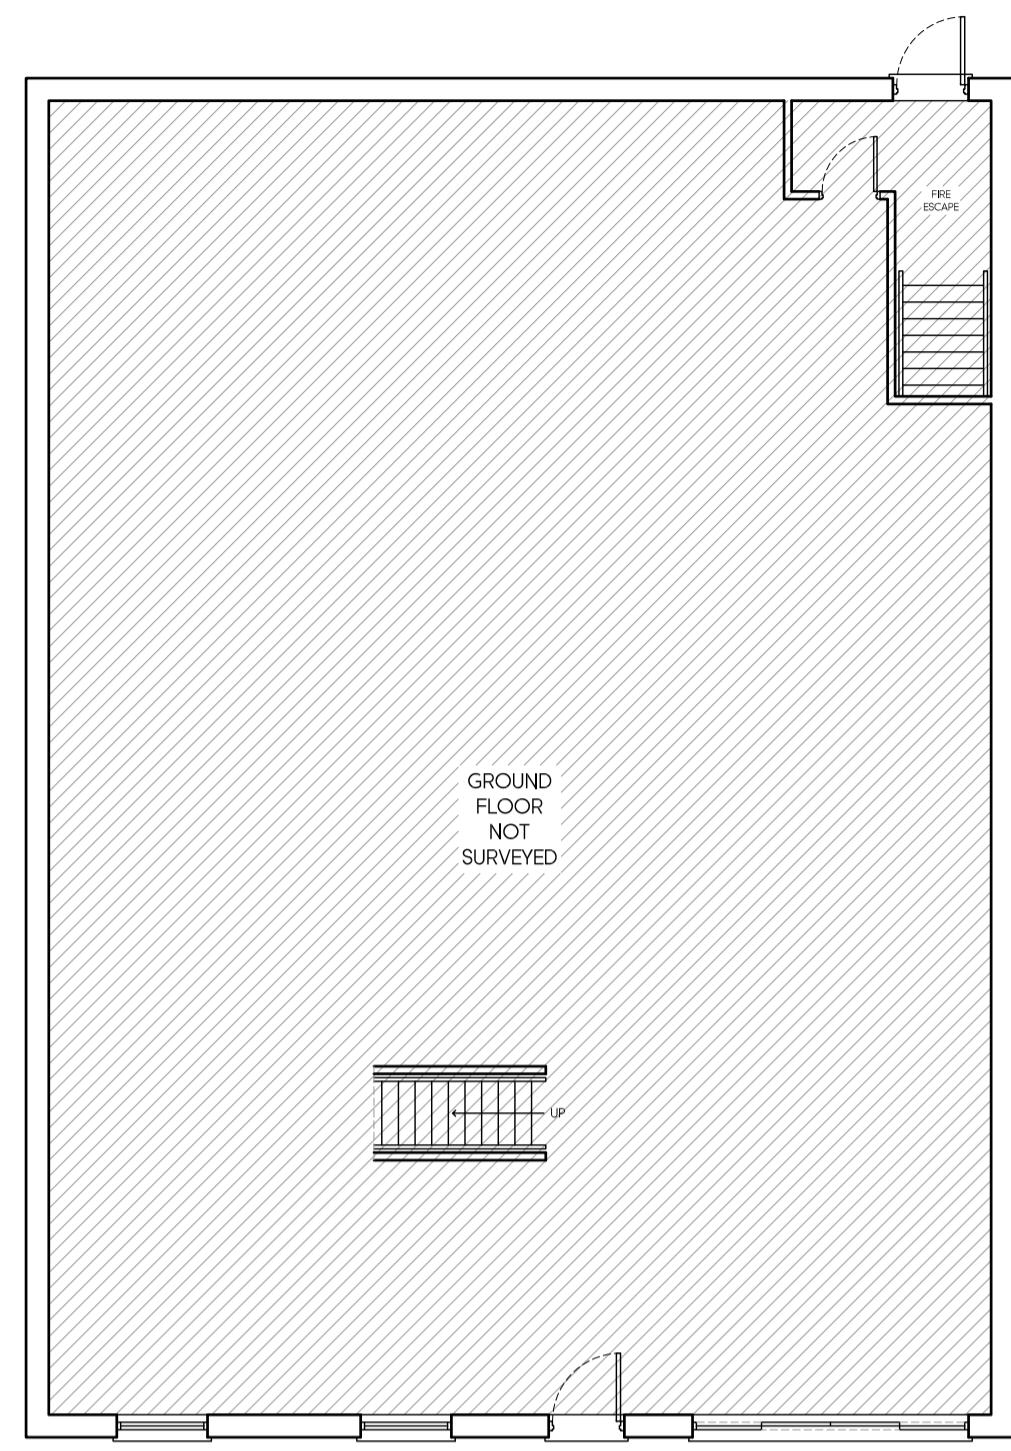


AS BUILT GROUND FLOOR PLAN

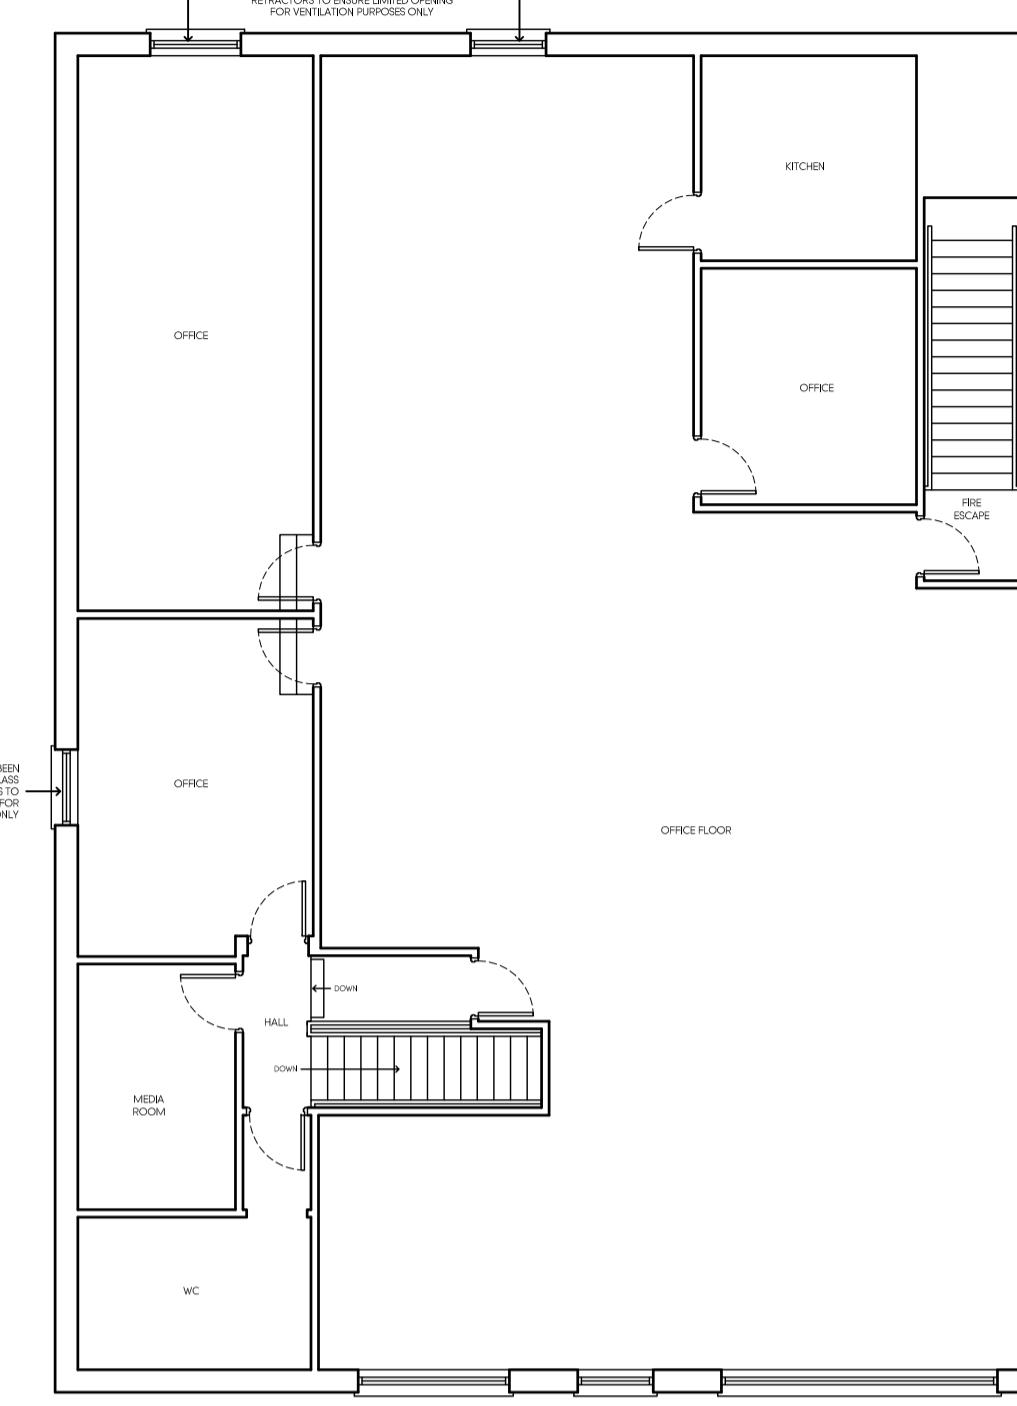


AS BUILT FIRST FLOOR PLAN




AS BUILT ROOF PLAN

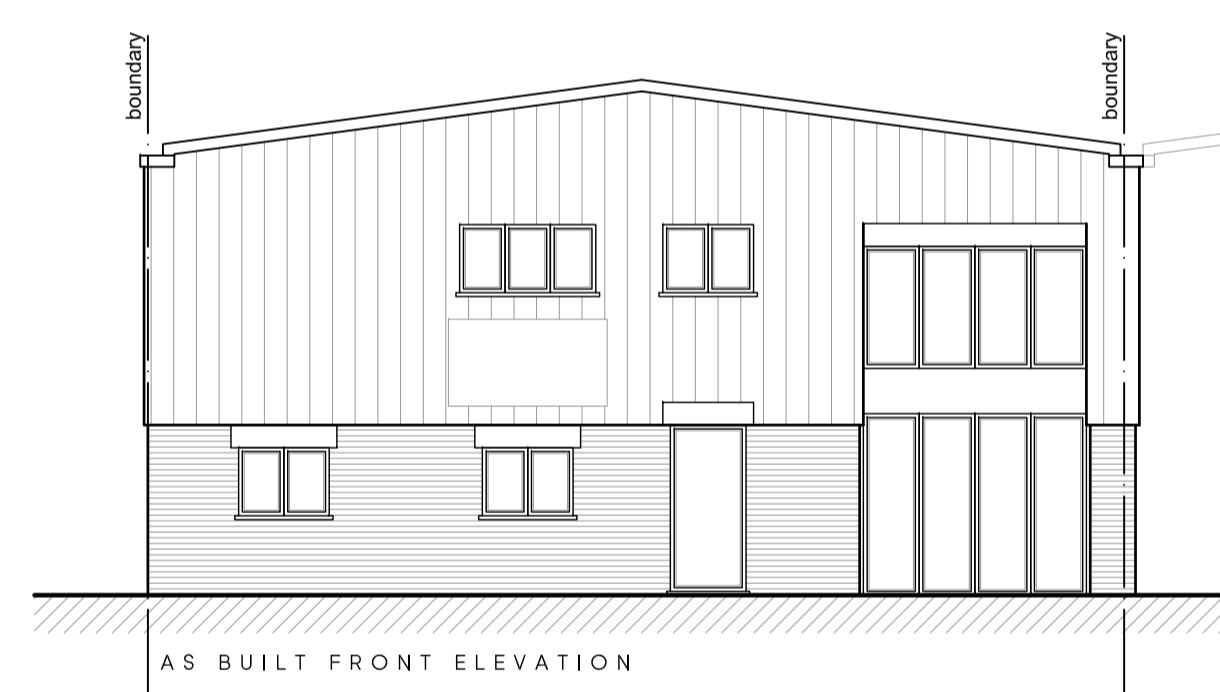


AS BUILT FRONT ELEVATION

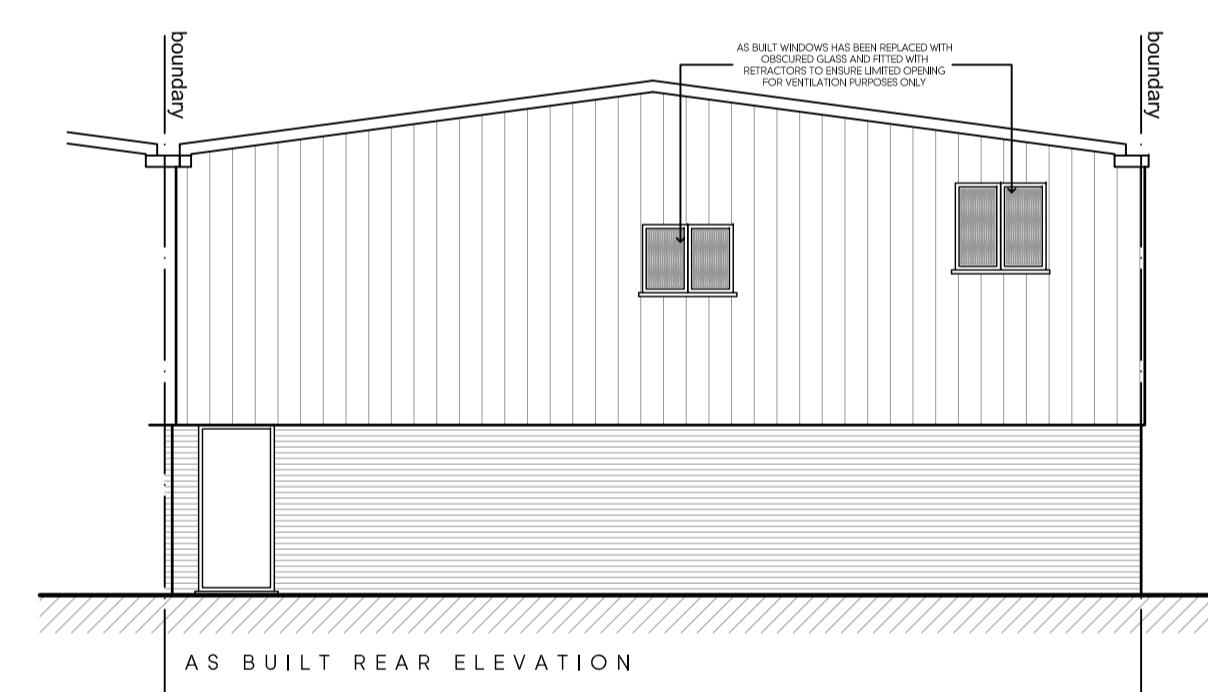

AS BUILT REAR ELEVATION

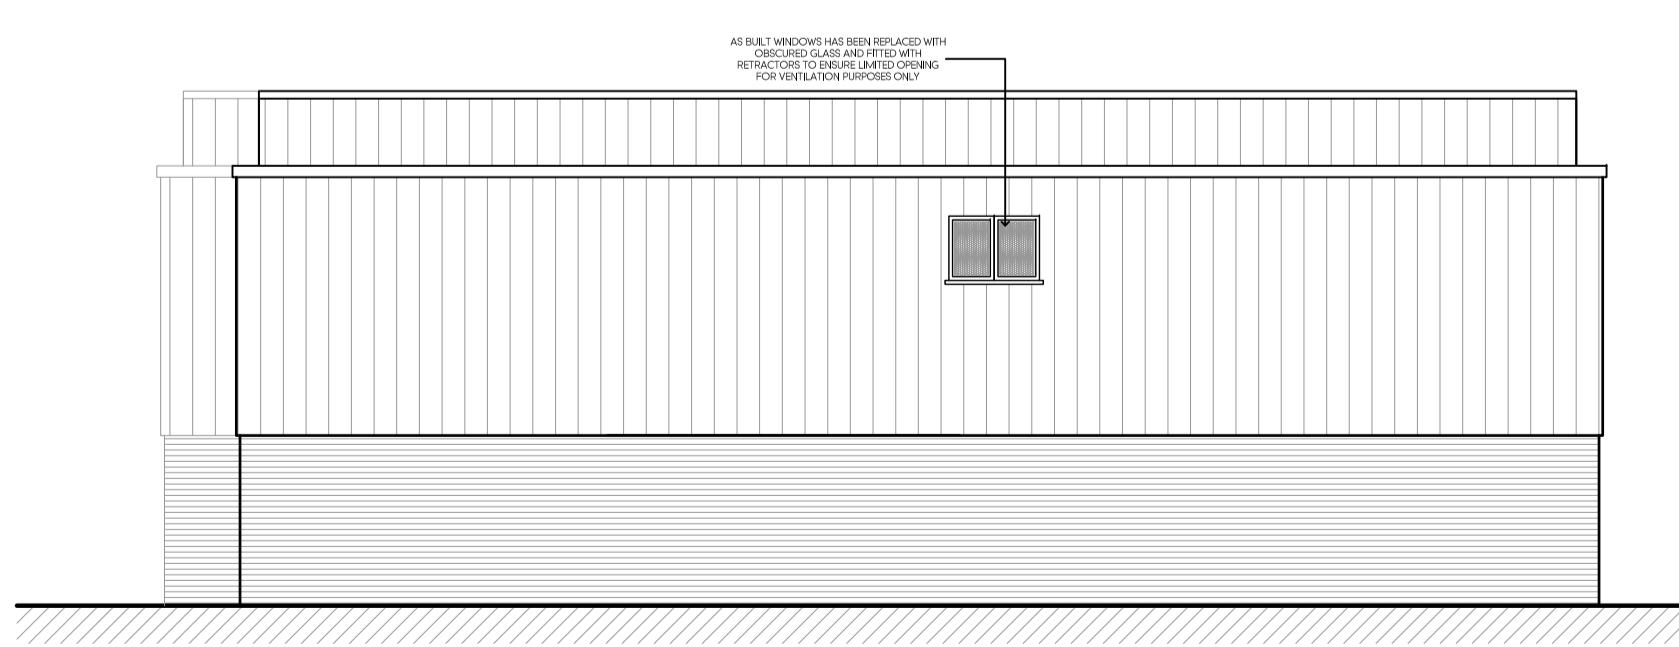

AS BUILT SIDE ELEVATION

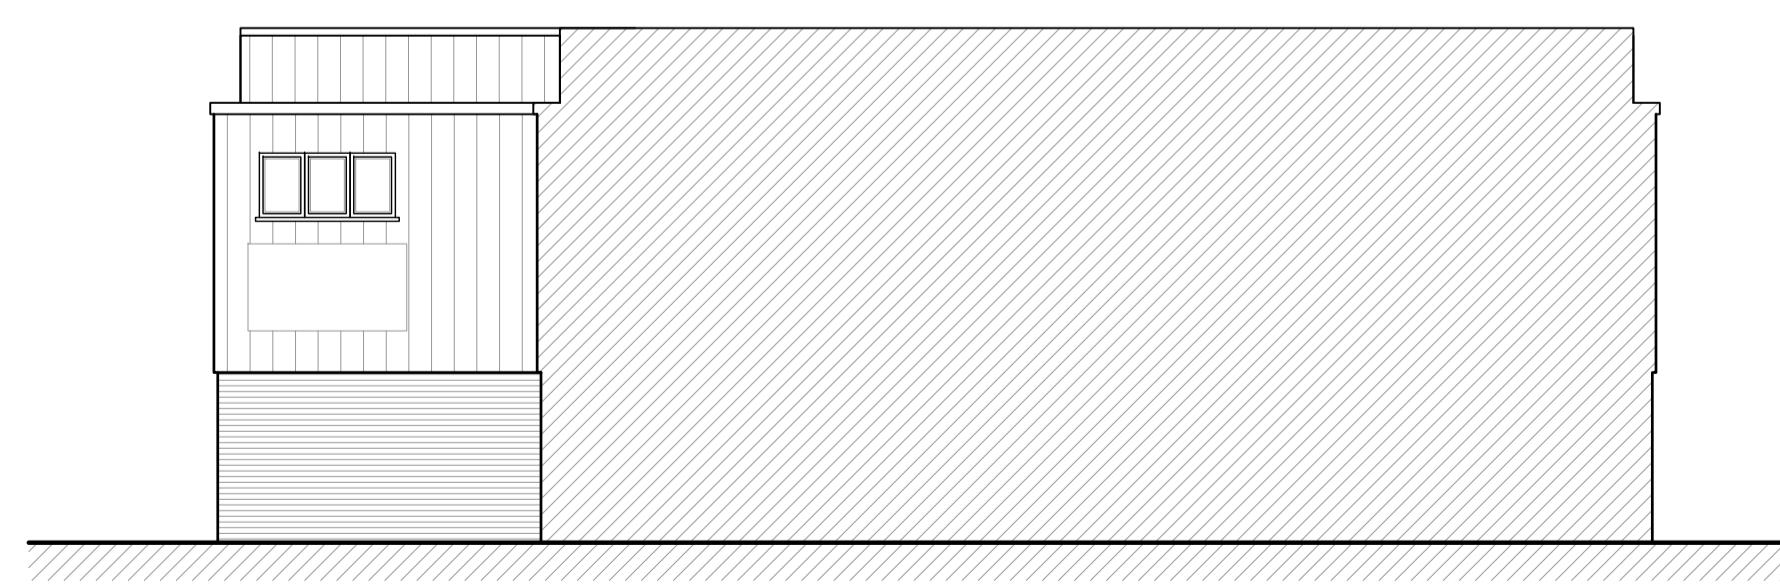

AS BUILT SIDE ELEVATION

Rev	Date	Description	Init.
-	-	-	-

J & L CLEANING

---

**Project Title**  
**PROPOSED WINDOWS TO BE REATTINED**

UNIT 4, EASTCOTE INDUSTRIAL ESTATE, HA4 9X  
Drawing Title

## AS BUILT PLANS AND ELEVATIONS

Cad File	Sheet Size	Scale
S001	A1	1:100
Drawn by	Drawing Date	Approved by
KP	JULY 2023	NJ
Project No.	Drawing No.	Revision
1974	P202	-

Middlesex HA4 7AR  
t 01923 840077 f 01923 840078  
[info@juttlarchs.com](mailto:info@juttlarchs.com)  
[juttlarchs.com](http://juttlarchs.com)

---

This drawing is property of Juttl Architects Ltd  
copied or otherwise reproduced. A

This drawing is property of Jutlla Architects Ltd © and must not be copied or otherwise reproduced. All dimensions must be checked on site before commencing work. No dimensions to be scaled from this drawing. This drawing was produced using AutoCad 2016.

## PLANNING ISSUE