


AS BUILT GROUND FLOOR PLAN (BOUNDARY WALL AND FRONT GATE)


RECTORY ROAD

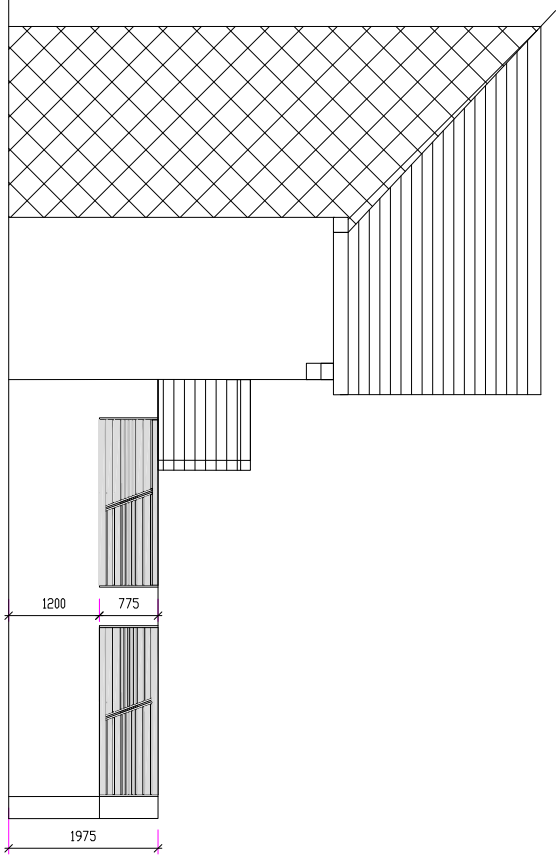

SIDE ELEVATION

BOUNDARY WALL

20 RECTORY ROAD

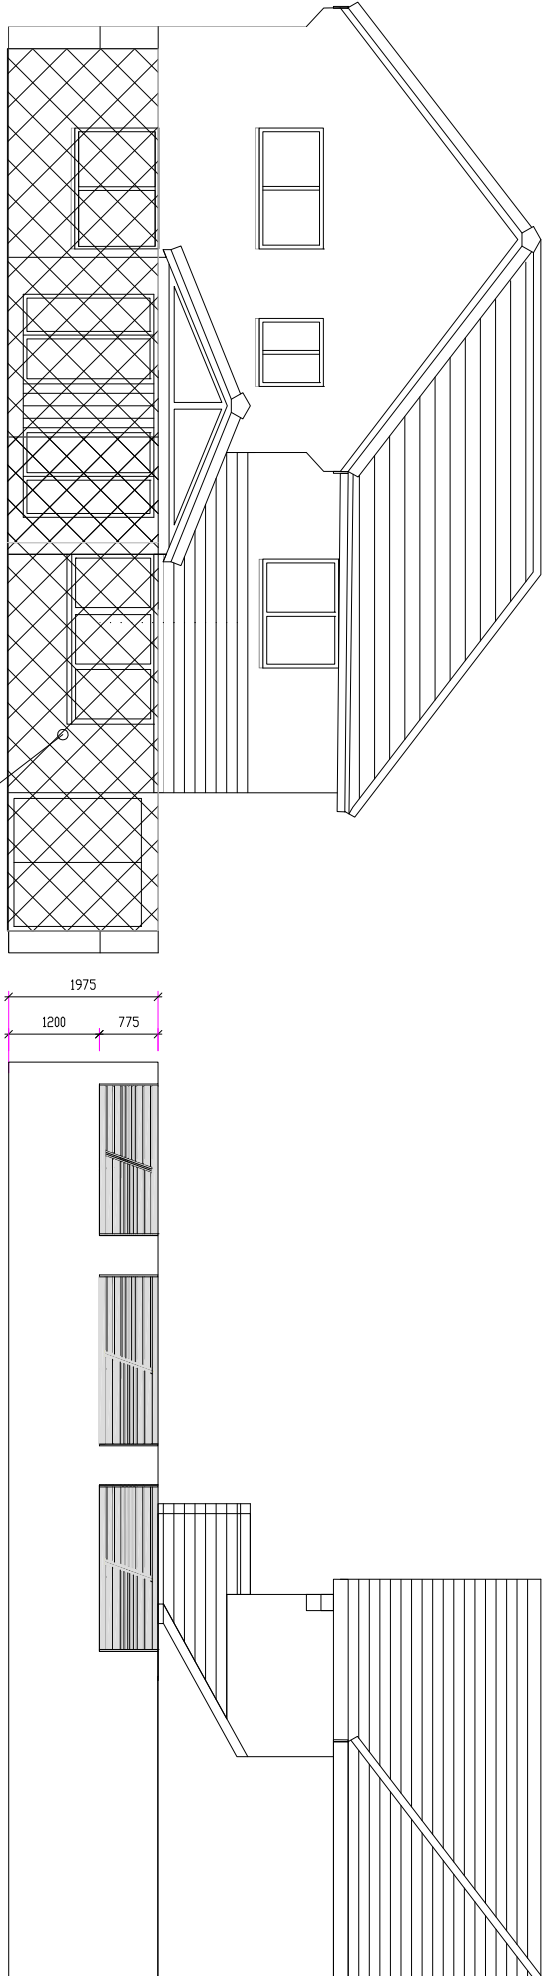

SIDE ELEVATION

BOUNDARY WALL

16 RECTORY ROAD

HAR - GUNN Associates Ltd		Drawing Name		Location		Scale	
Tel : 020 917 9296		Retrospective Planning		18 RECTORY ROAD		@A3	
Mob: 07803 619161		Retention of front gate height		HAYES UB3 2JL		Date	
Email: hargunn@aol.com		Rev		Dwg No		Rev	
		Revision Note		1804/ 2024 / RP -02		Sept 2024	
		Date					

This drawing remains the property of HAR - Gunn Associates and shall not be reproduced or altered without prior written permission.

Do not scale off drawings. Check all dimensions on site and report any discrepancies before commencing work. All figured dimensions are millimeters unless noted otherwise.