



FRONT ELEVATION GATE

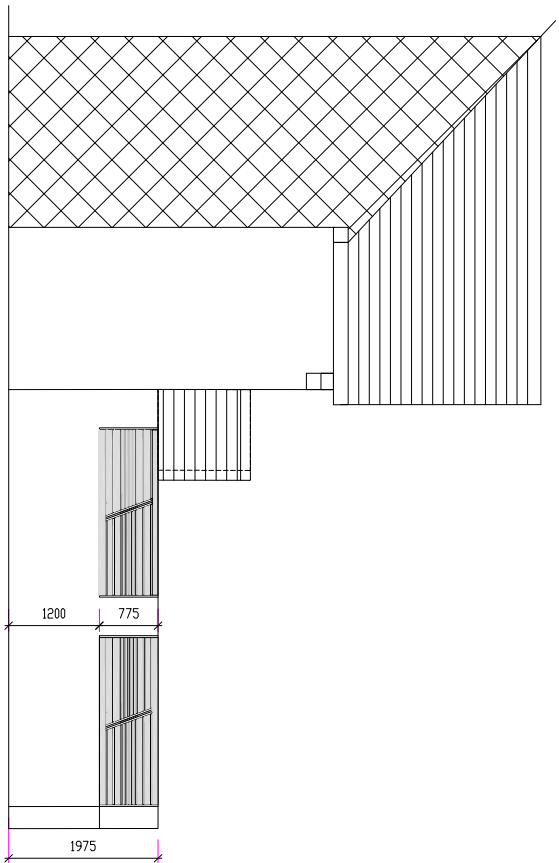

SIDE ELEVATION  
BOUNDARY WALL  
20 RECTORY ROAD

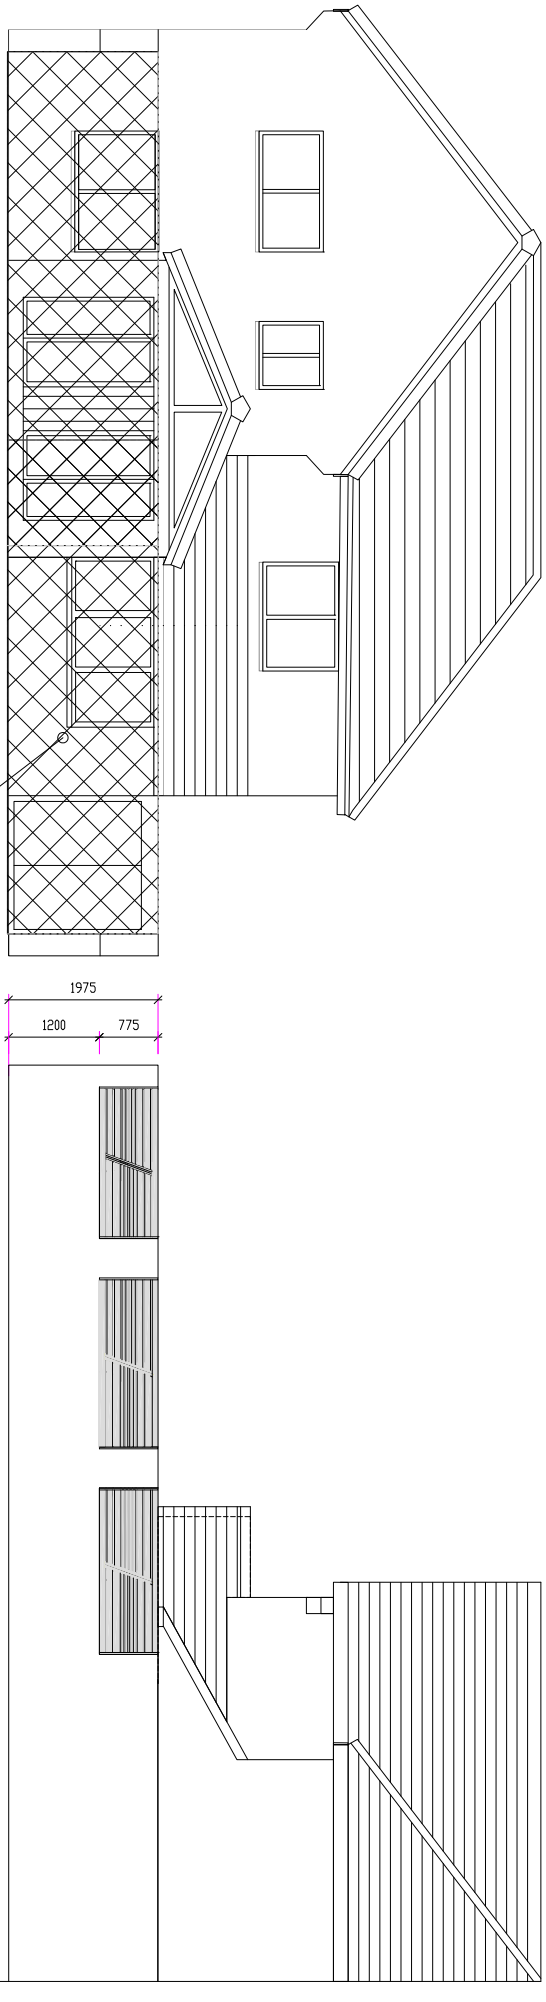

HAR - GUNN Associates Ltd					Drawing Name  AS BUILT  Retrospective Planning Retention of front gate height	Location  18 RECTORY ROAD HAYES UB3 2UL Drg No 1804/ 2024 / RP -O3	Scale @A3	1 : 100
Tel : 020 917 9296 Mob: 07803 619161	Email: hargunn@aol.com						Date	Sept 2024
Rev	Revision Note							

This drawing remains the property of HAR - Gunn Associates and shall not be reproduced or altered without prior written permission.

Do not scale off drawings. Check all dimensions on site and report any discrepancies before commencing work. All figured dimensions are millimeters unless noted otherwise.