




## APPENDIX A MARK-UP

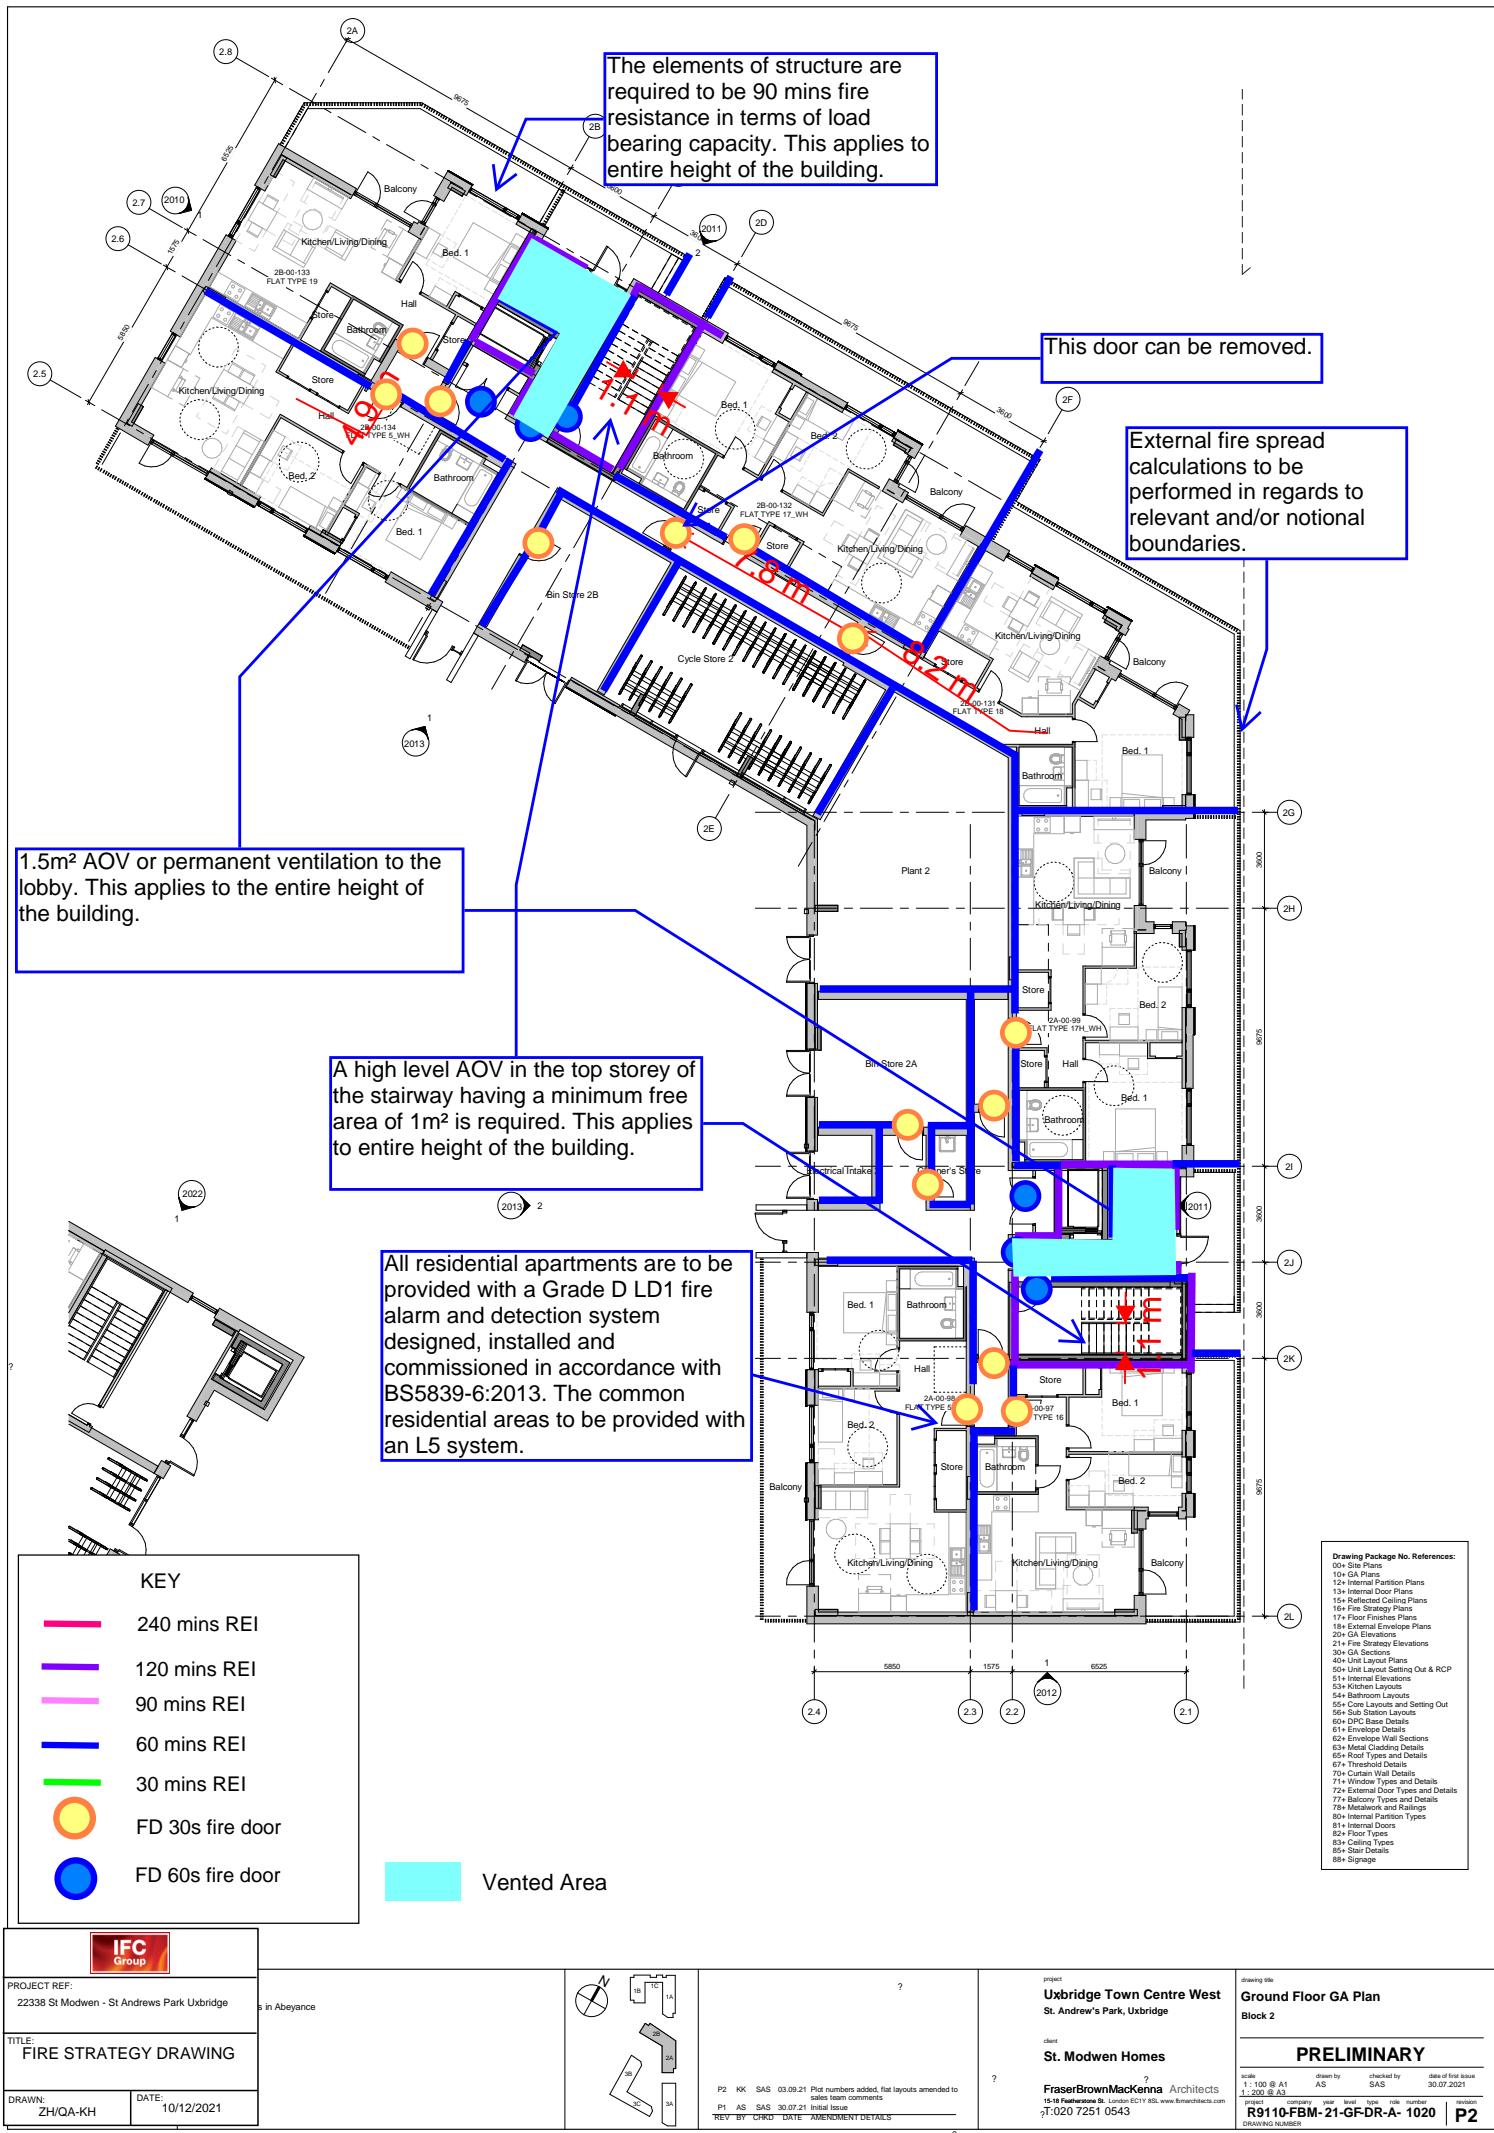

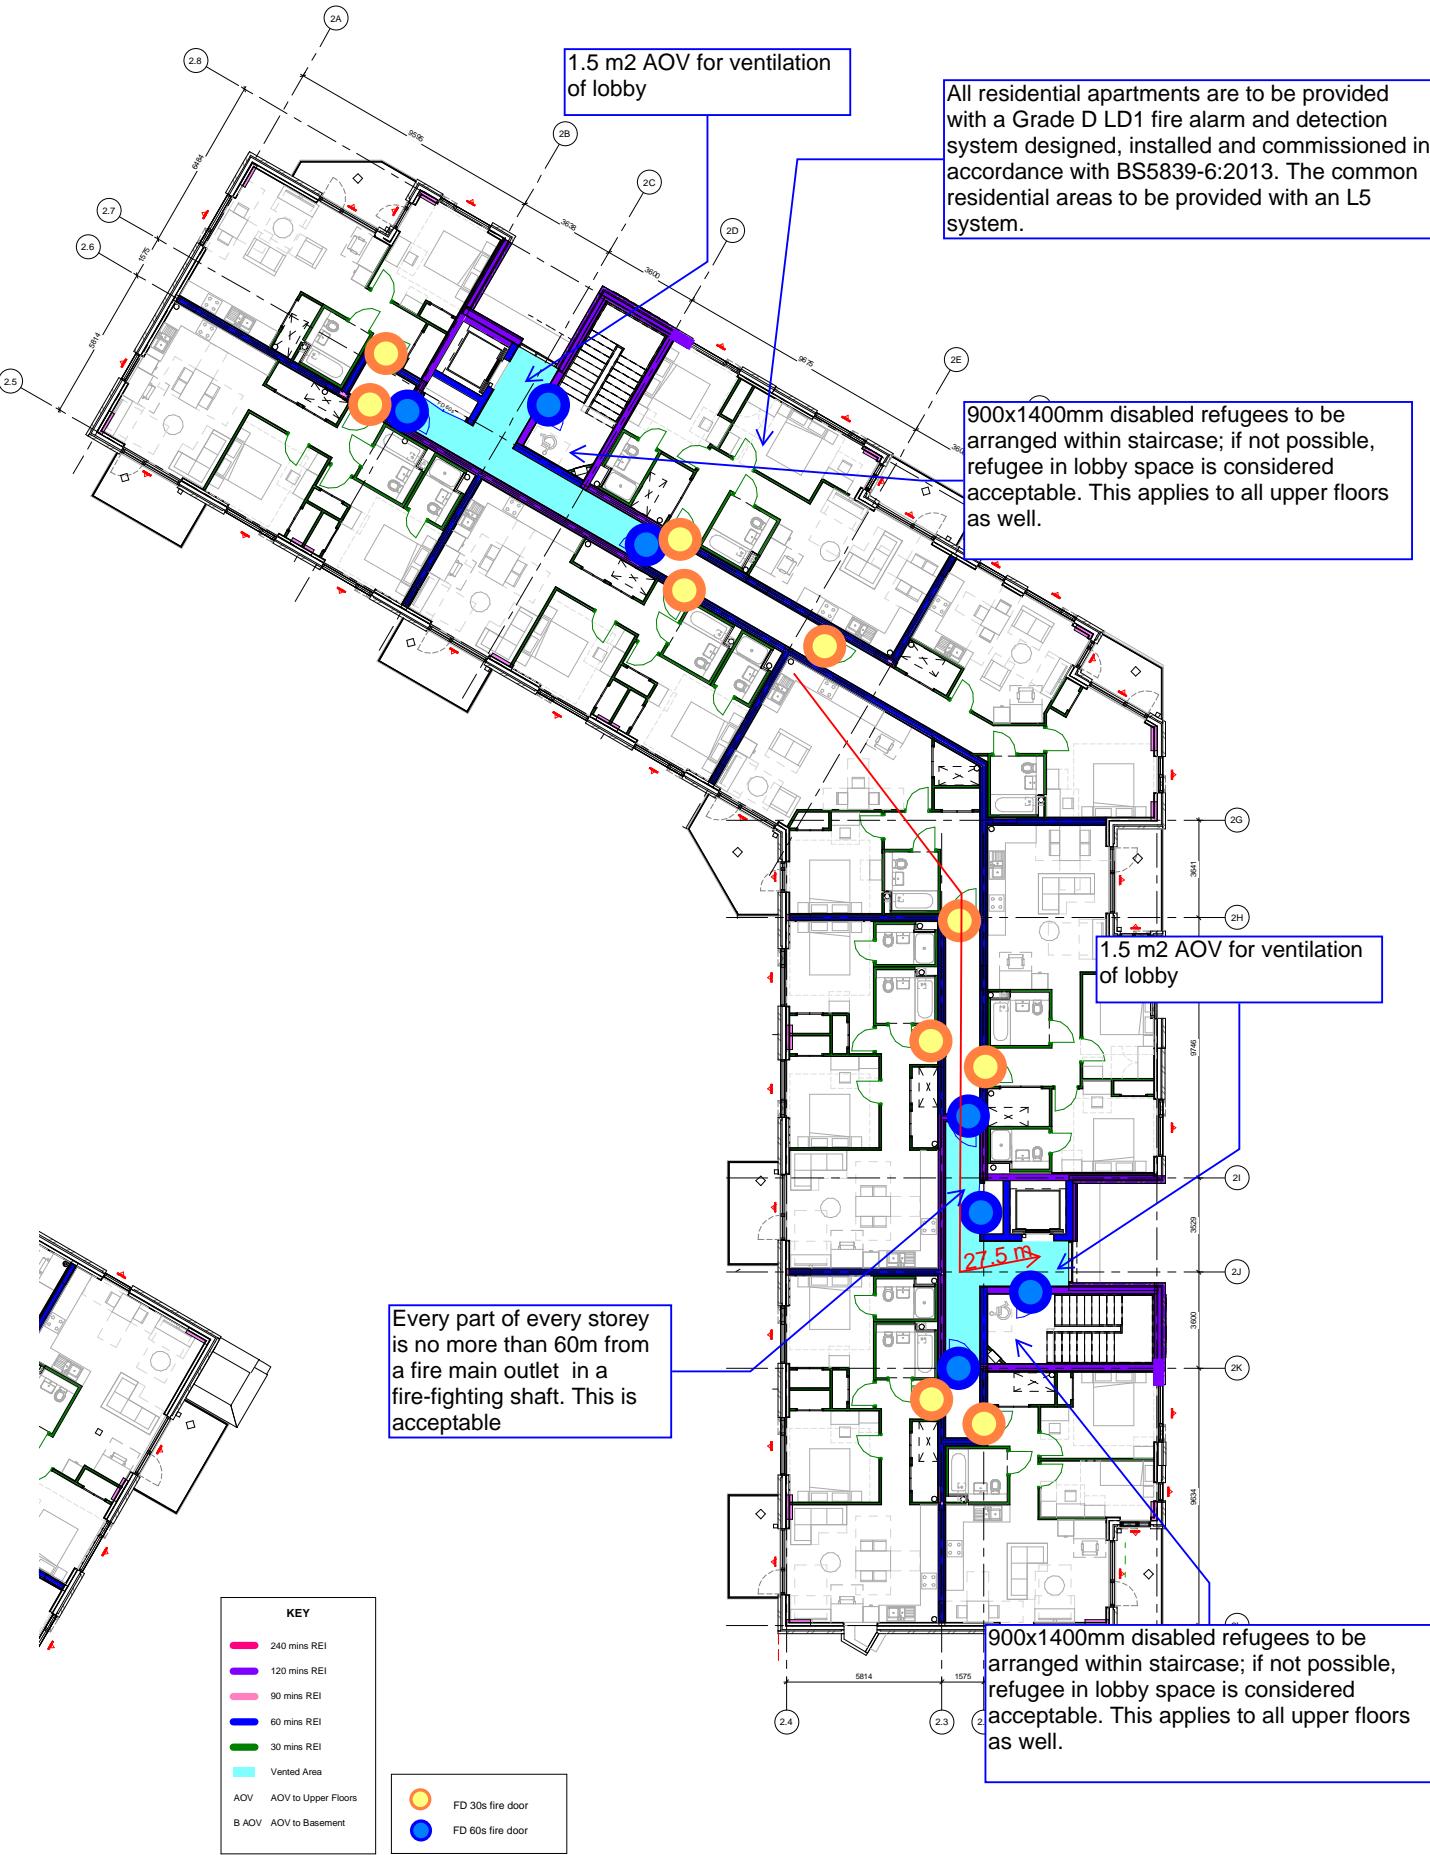

PROJECT REF:	22338 St Modwen - St Andrews Park Uxbridge
TITLE:	FIRE STRATEGY DRAWING
DRAWN:	ZH/QA-KH
DATE:	10/12/2021

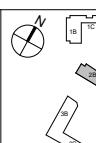

P1 RET SAS 24.11.21 Preliminary Fire Strategy Drawings  
REV BY CHRO DATE AMENDMENT DETAILS

project Uxbridge Town Centre West

St. Andrew's Park, Uxbridge

drawing title

Block 2 Level 01

Fire Strategy Plan

client

St. Modwen Homes

FraserBrownMacKenna Architects

15-16 Fulhamstone St, London EC1Y 8SL, www.fbmarchitects.com  
T: 020 7251 0543

PRELIMINARY

scale 1: 100 @ A1

drawn by KK checked by SAS


date of first issue 24.11.21

company level type role number


R9110-FBM-21-01-DR-A- 1621

DRAWING NUMBER


P1

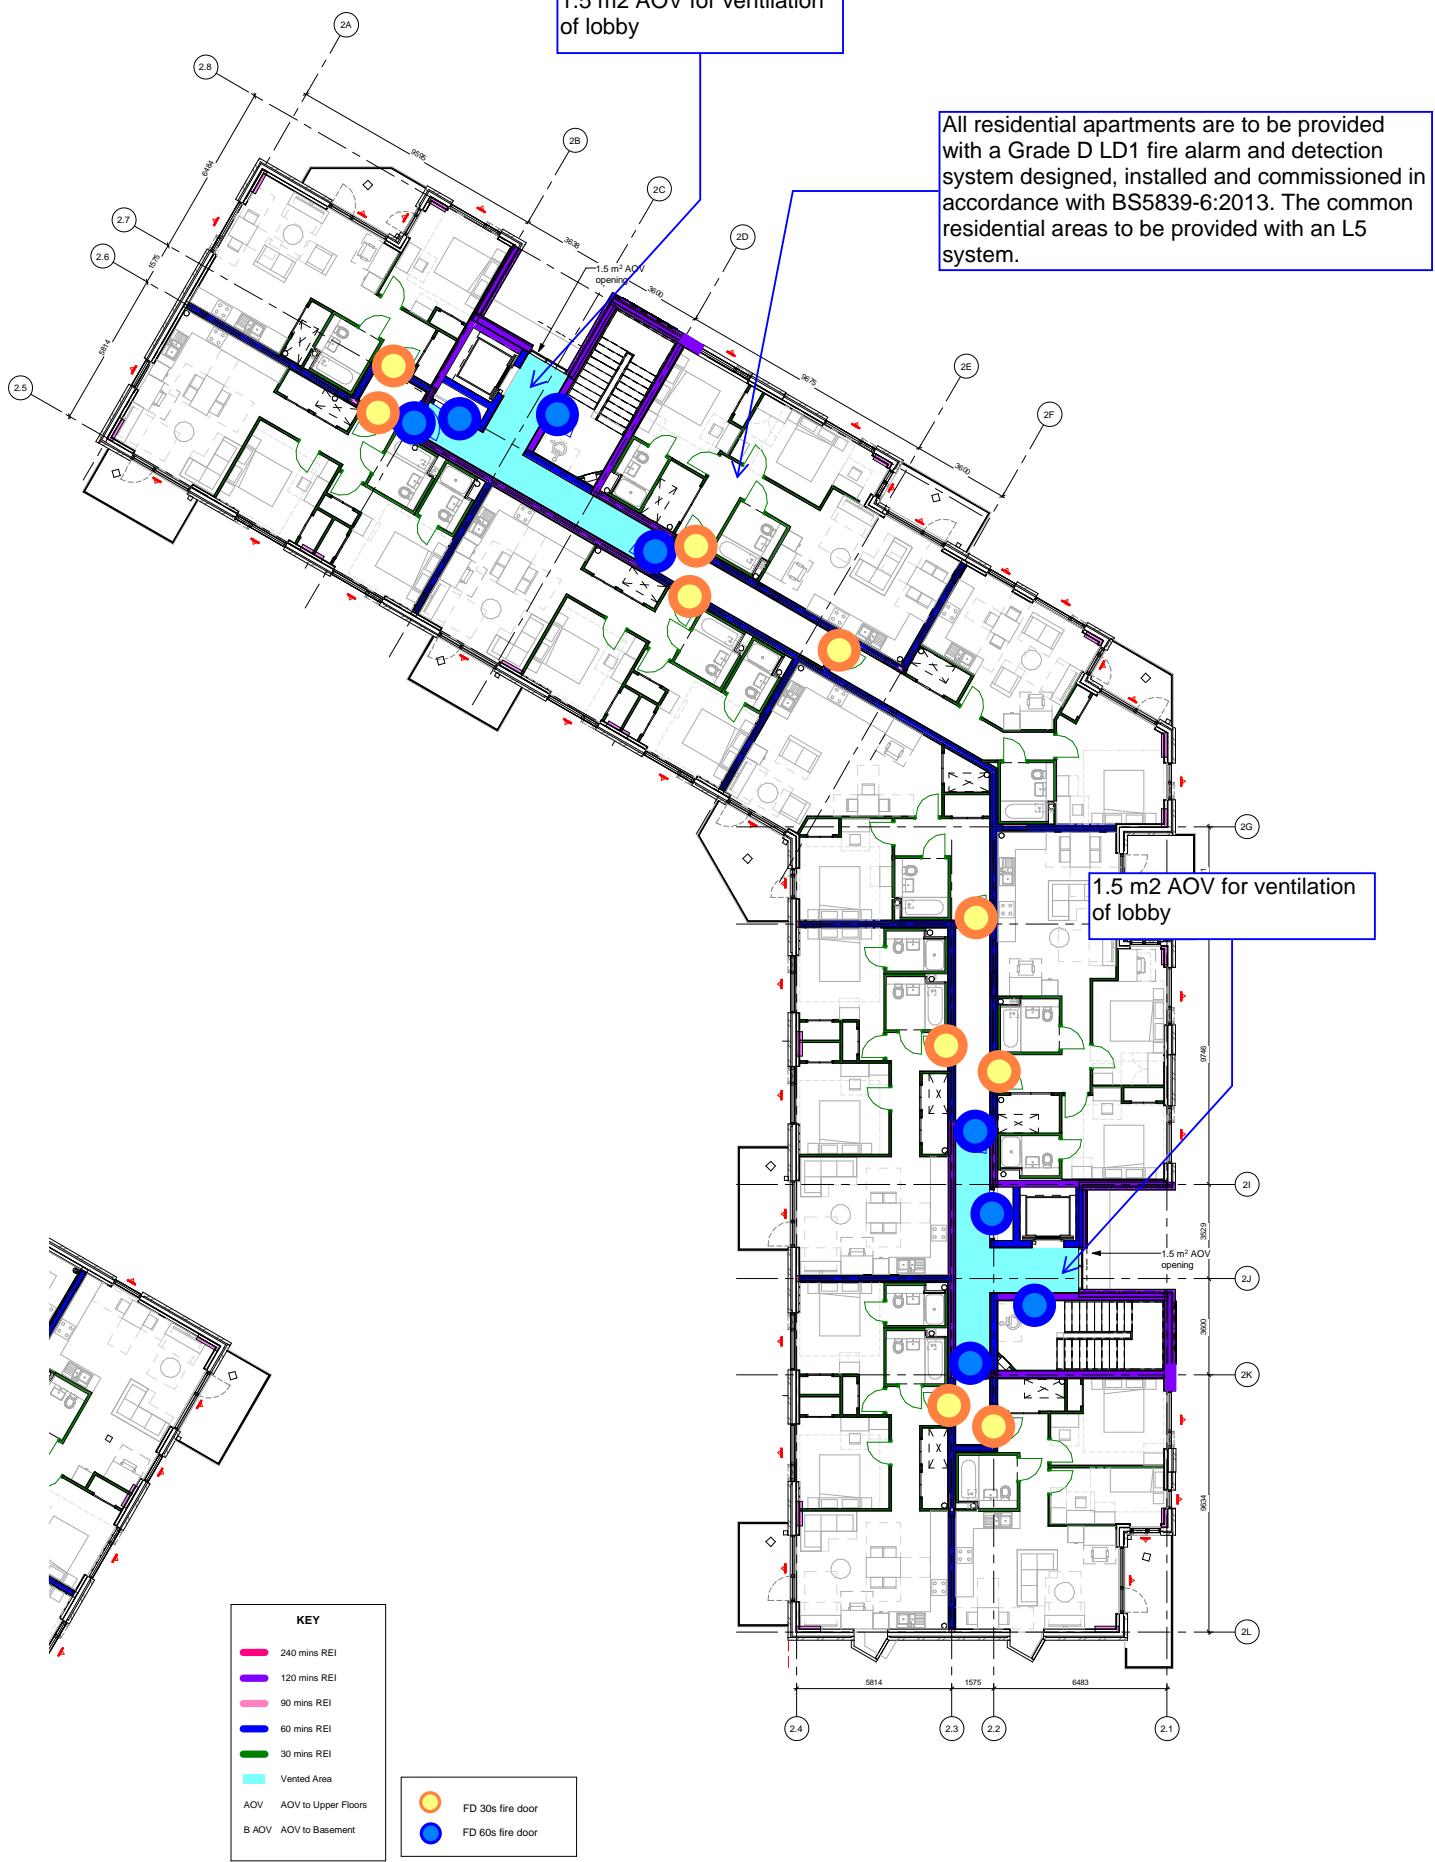

 <b>PROJECT REF:</b> 22338 St Modwen - St Andrews Park Uxbridge	
<b>TITLE:</b> <b>FIRE STRATEGY DRAWING</b>	
<b>DRAWN:</b> ZH/QA-KH	<b>DATE:</b> 10/12/2021

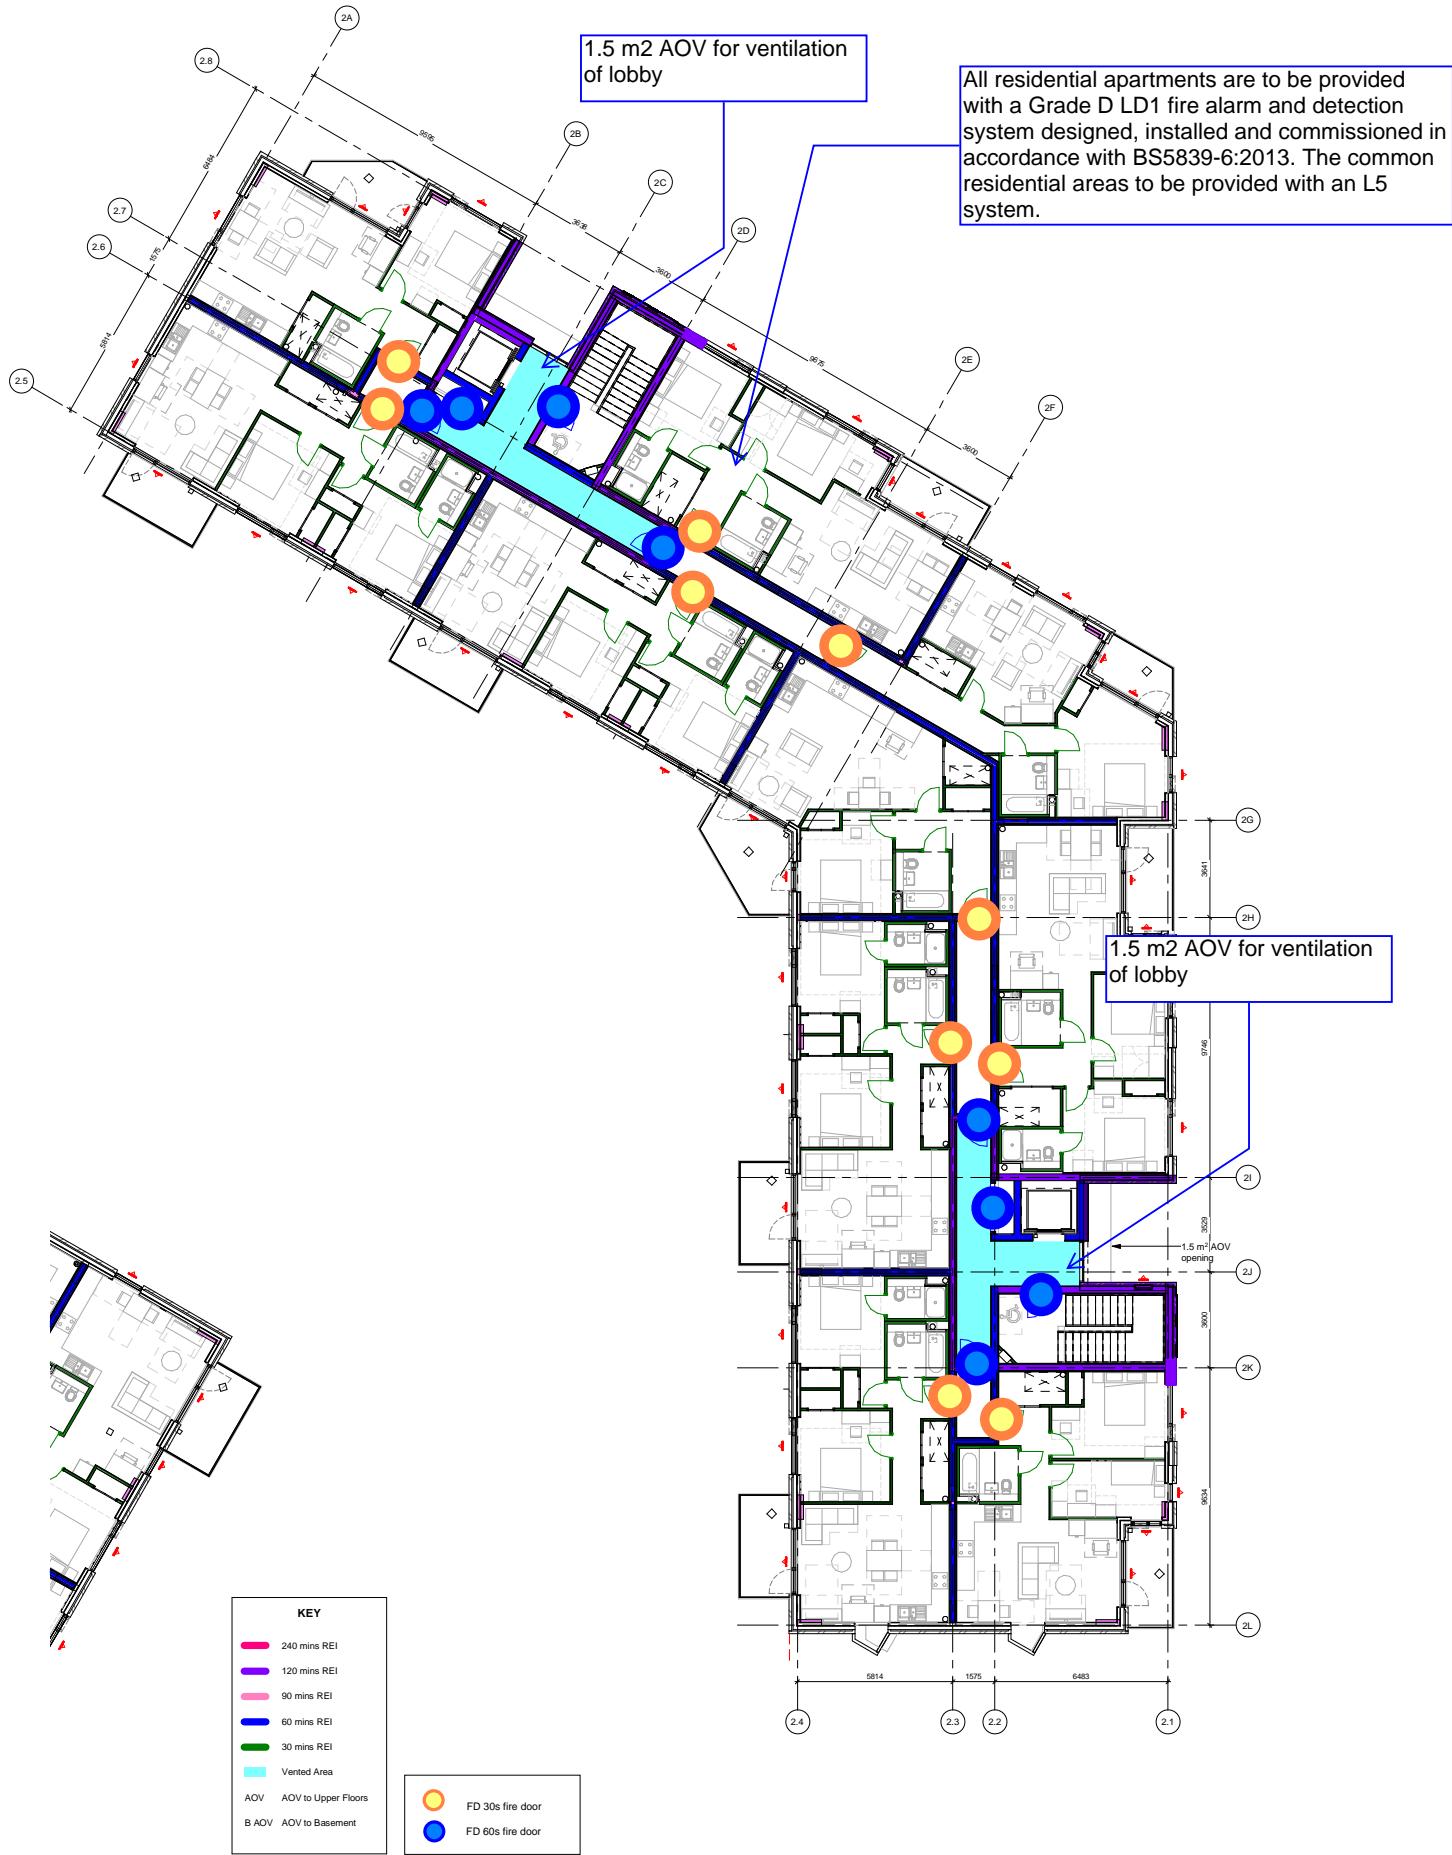

<b>IFC Group</b> <b>PROJECT REF:</b> 22338 St Modwen - St Andrews Park Uxbridge	
<b>TITLE:</b> <b>FIRE STRATEGY DRAWING</b>	
DRAWN: ZH/QA-KH	DATE: 10/12/2021

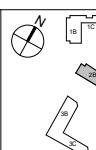

P1 RET SAS 24.11.21 Preliminary Fire Strategy Drawings  
REV BY CHRO DATE AMENDMENT DETAILS

project  
**Uxbridge Town Centre West**  
St. Andrew's Park, Uxbridge

drawing title  
**Block 2 Level 03**  
Fire Strategy Plan

client  
**St. Modwen Homes**

FraserBrownMacKenna Architects  
15-16 Finsbury Square, London EC2Y 8SF, www.fbmarchitects.com  
T: 020 7251 0543

PRELIMINARY

scale: 1:100 @ A1 drawn by KK checked by SAS date of first issue 24.11.21  
1:200 @ A1  
company: year: level: type: role: number: R9110-FBM-21-03-DR-A-1623 revision: P1  
DRAWING NUMBER