




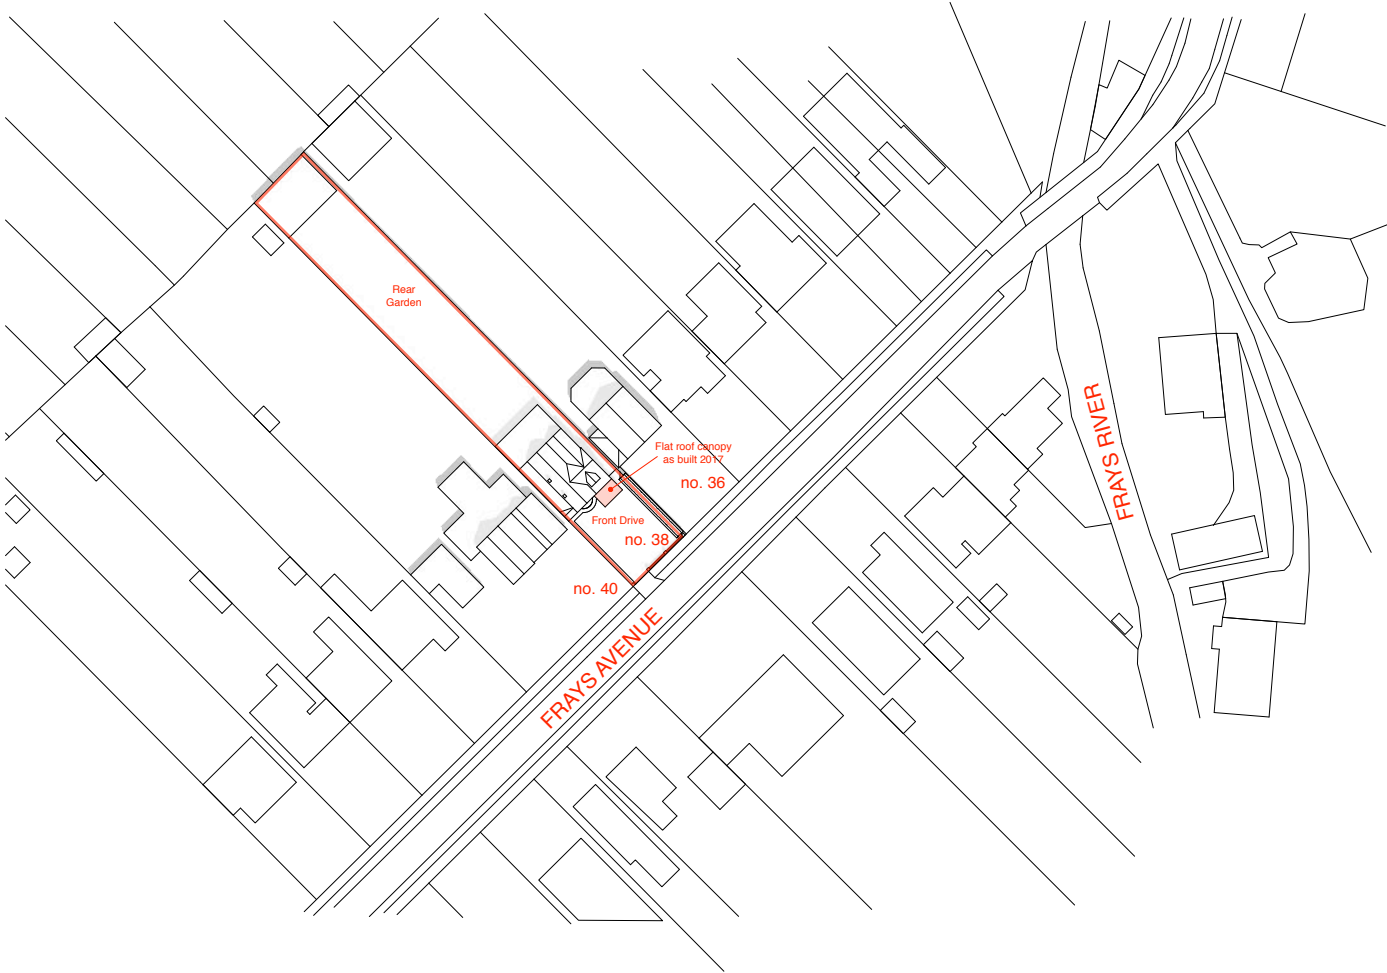

Site Location Plan

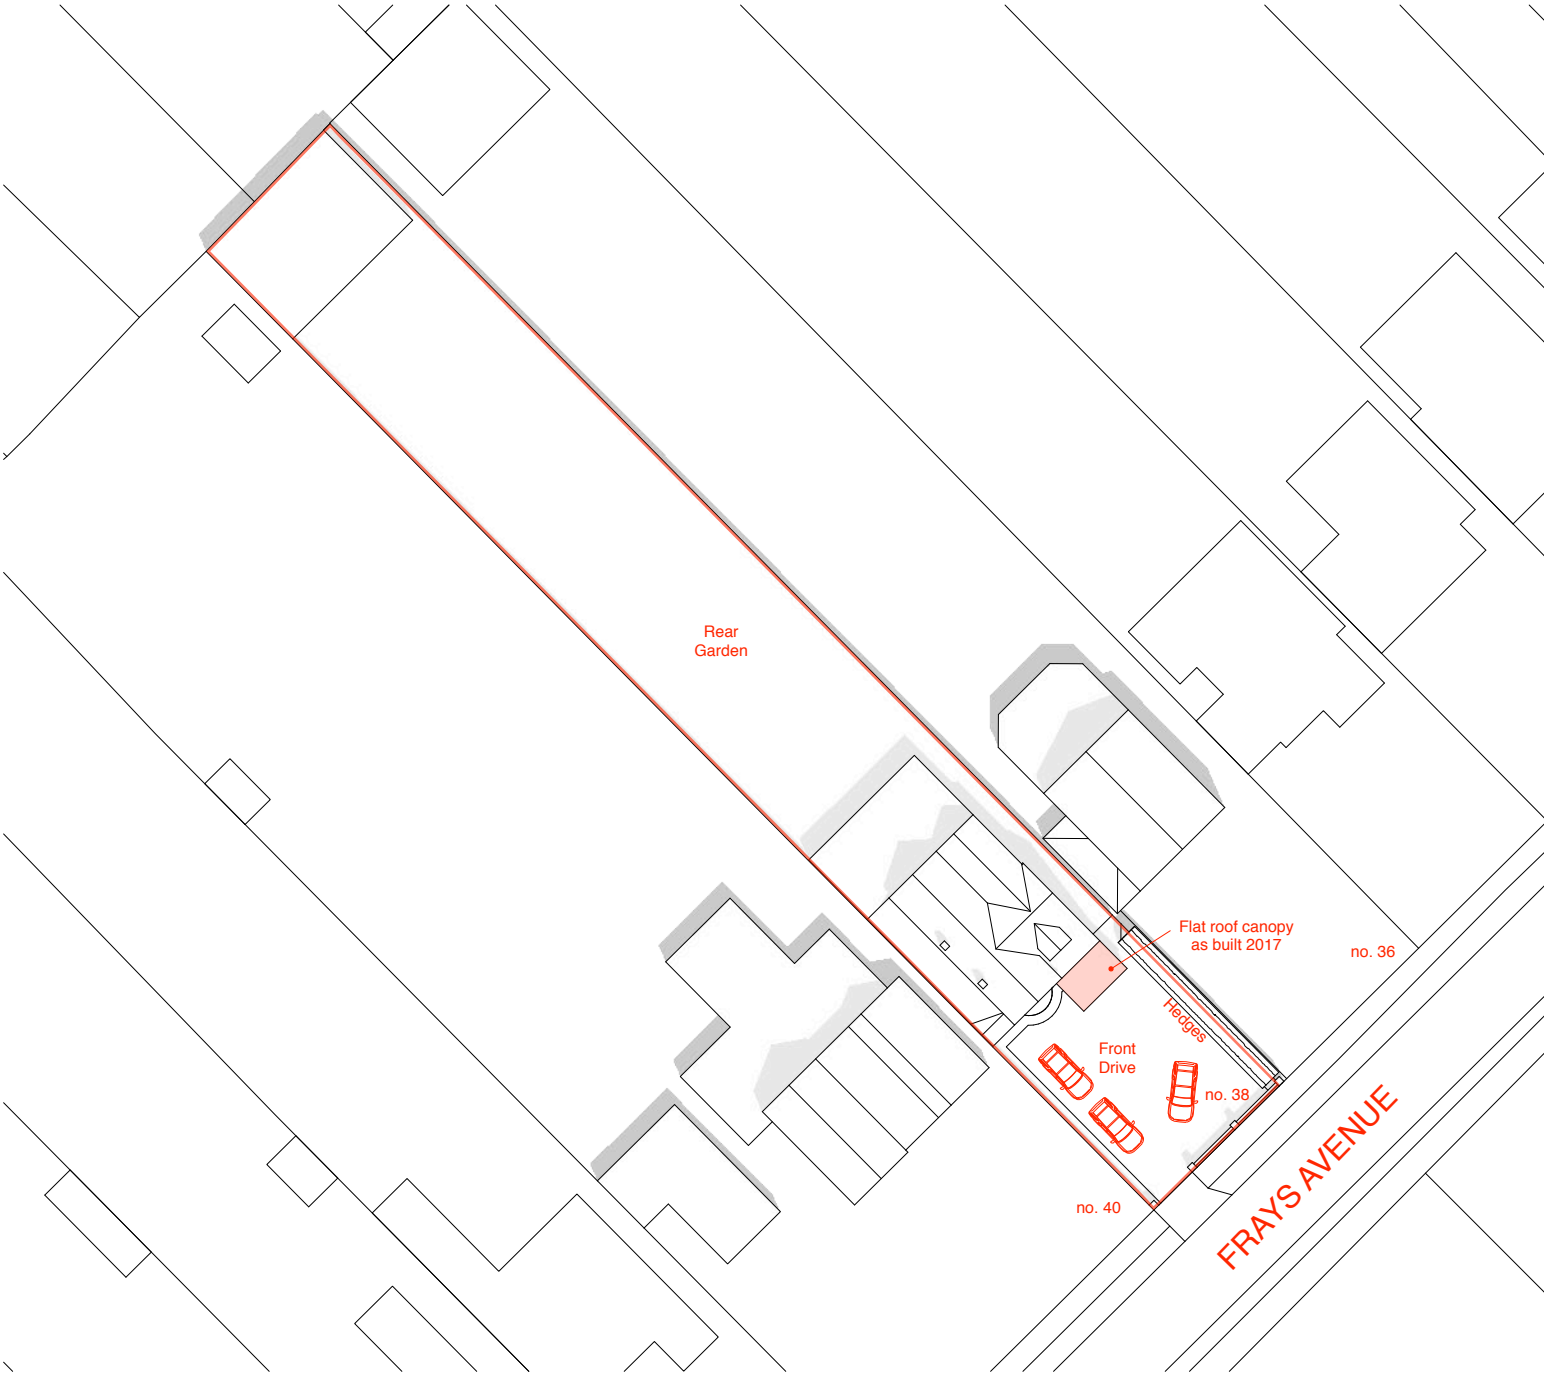

Block Plan

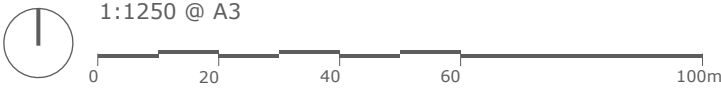

Address	Client	Date
38 Frays Avenue, West Drayton, UB7 7AG	Mr. Reza	Nov. 2017

Email: michaeloakesarchitect@googlemail.com Phone: 01895 235089
M.Oakes. Registered Architect. 10 Parkfield Avenue, Hillingdon, Middlesex, UB10 0DF, Great Britain

Drawing Title
Location + Block Plan
Retrospective Planning Application for a Front Canopy to a Detached Dwelling

Project no. / Stage /	Drawing no. / Revision
0161- PLA-	01_A
Revision notes:	Drawn by: LW
A - First Issue	

MICHAEL OAKES
B.A.Hons, Dipl. Architecture



View of the as built canopy from the front



View of the as built canopy from the side



View of the underside of the as built canopy



View from Frays Avenue of as built canopy



View from driveway of as built canopy



View from driveway of as built canopy



View from side alley of as built canopy

Address	Client	Date
38 Frays Avenue, West Drayton, UB7 7AG	Mr. Reza	Nov. 2017

Email: michaeloakesarchitect@googlemail.com Phone: 01895 235089
M.Oakes. Registered Architect. 10 Parkfield Avenue, Hillingdon, Middlesex, UB10 0DF, Great Britain

Drawing Title
Site Photos Photos Taken 15.11.17

Project no. / Stage /	Drawing no. / Revision
0161- PLA-	02_A
Revision notes:	Drawn by: LW
A - First Issue	

Retrospective Planning Application for a Front Canopy to a Detached Dwelling

Copyright
Michael Oakes Architect © 2017
Print all drawings in full colour at A3 size
Do not scale drawings

MICHAEL OAKES



B.A.Hons, Dipl. Architecture

REGISTERED ARCHITECT
DESIGNER and ILLUSTRATOR

Email: michaeloakesarchitect@googlemail.com
Phone: 01895 235089



Views from Frays Avenue

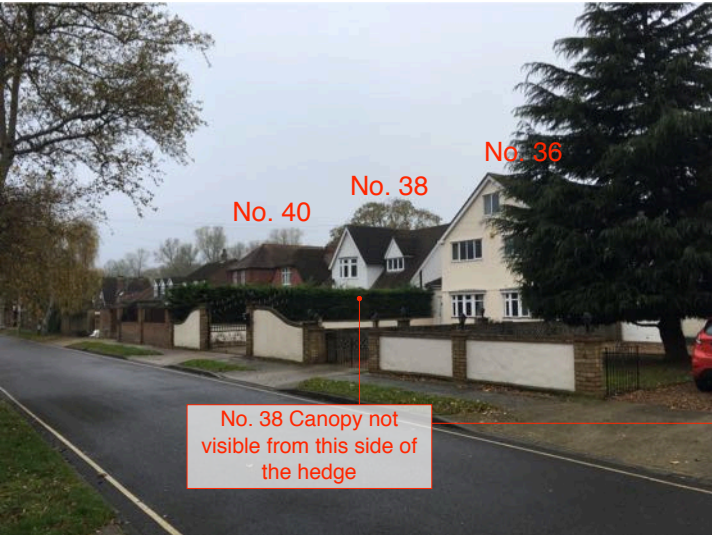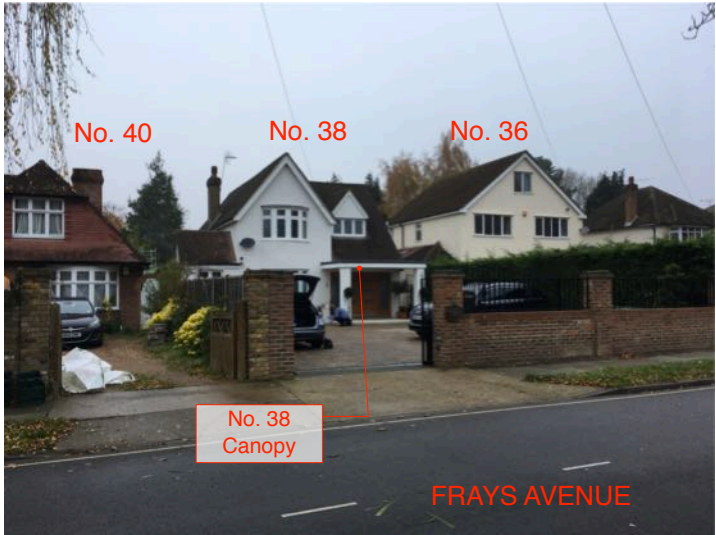

Google street view from 2014 of no 34



Address	Client	Date
38 Frays Avenue, West Drayton, UB7 7AG	Mr. Reza	Nov. 2017

Email: michaeloakesarchitect@googlemail.com Phone: 01895 235089
M.Oakes. Registered Architect. 10 Parkfield Avenue, Hillingdon, Middlesex, UB10 0DF, Great Britain

Drawing Title
Site Photos Photos Taken 15.11.17

Retrospective Planning Application for a Front
Canopy to a Detached Dwelling

Project no. / Stage /	Drawing no. / Revision
0161- PLA-	03_A
Revision notes:	Drawn by: LW
A - First Issue	

Copyright
Michael Oakes Architect © 2017
Print all drawings in full colour at A3 size
Do not scale drawings

MICHAEL OAKES

B.A.Hons, Dipl. Architecture

REGISTERED ARCHITECT
DESIGNER and ILLUSTRATOR

Email: michaeloakesarchitect@googlemail.com
Phone: 01895 235089



Historic view of the front elevation in 2008



Historic view of the front elevation in 2014



View of the front elevation in 2017 (Photo taken 15.11.17)

Address	Client	Date
38 Frays Avenue, West Drayton, UB7 7AG	Mr. Reza	Nov. 2017

Email: michaeloakesarchitect@googlemail.com Phone: 01895 235089
M.Oakes. Registered Architect. 10 Parkfield Avenue, Hillingdon, Middlesex, UB10 0DF, Great Britain

Drawing Title
Site Photos Historic Google Street View Images 2008 and 2014

Retrospective Planning Application for a Front
Canopy to a Detached Dwelling

Project no. / Stage /	Drawing no. / Revision
0161- PLA-	04_A
Revision notes:	Drawn by: LW
A - First Issue	

Copyright
Michael Oakes Architect © 2017
Print all drawings in full colour at A3 size
Do not scale drawings

MICHAEL OAKES

B.A.Hons, Dipl. Architecture

REGISTERED ARCHITECT
DESIGNER and ILLUSTRATOR

Email: michaeloakesarchitect@googlemail.com
Phone: 01895 235089

Google satellite image view
of Frays Avenue 2017

NOTE: Diagrammatic
Representation
(Not to Scale)



Address	Client	Date
38 Frays Avenue, West Drayton, UB7 7AG	Mr. Reza	Nov. 2017

Email: michaeloakesarchitect@googlemail.com Phone: 01895 235089
M.Oakes. Registered Architect. 10 Parkfield Avenue, Hillingdon, Middlesex, UB10 0DF, Great Britain


Drawing Title
Site Analysis Google Satellite Image

Retrospective Planning Application for a Front
Canopy to a Detached Dwelling


Project no. / Stage /	Drawing no. / Revision
0161- PLA-	05_A
Revision notes:	Drawn by: LW
A - First Issue	

Copyright
Michael Oakes Architect © 2017
Print all drawings in full colour at A3 size
Do not scale drawings


MICHAEL OAKES
B.A.Hons, Dipl. Architecture

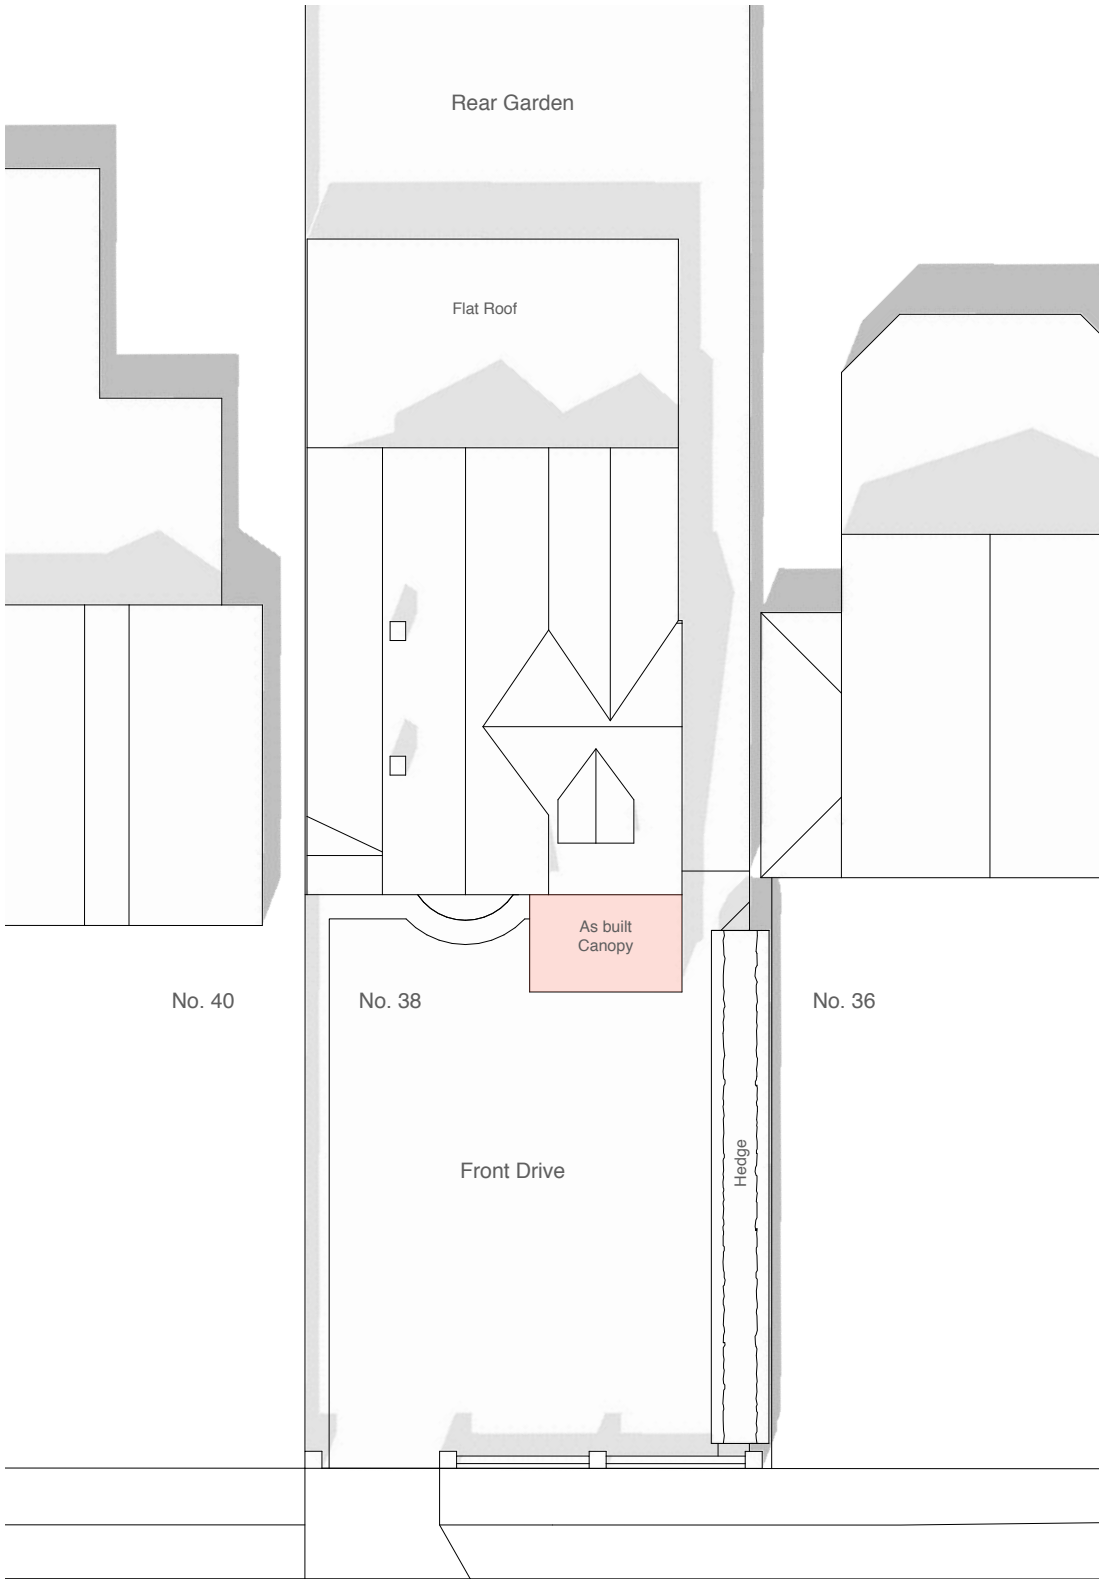


Existing Roof Plan
1:200

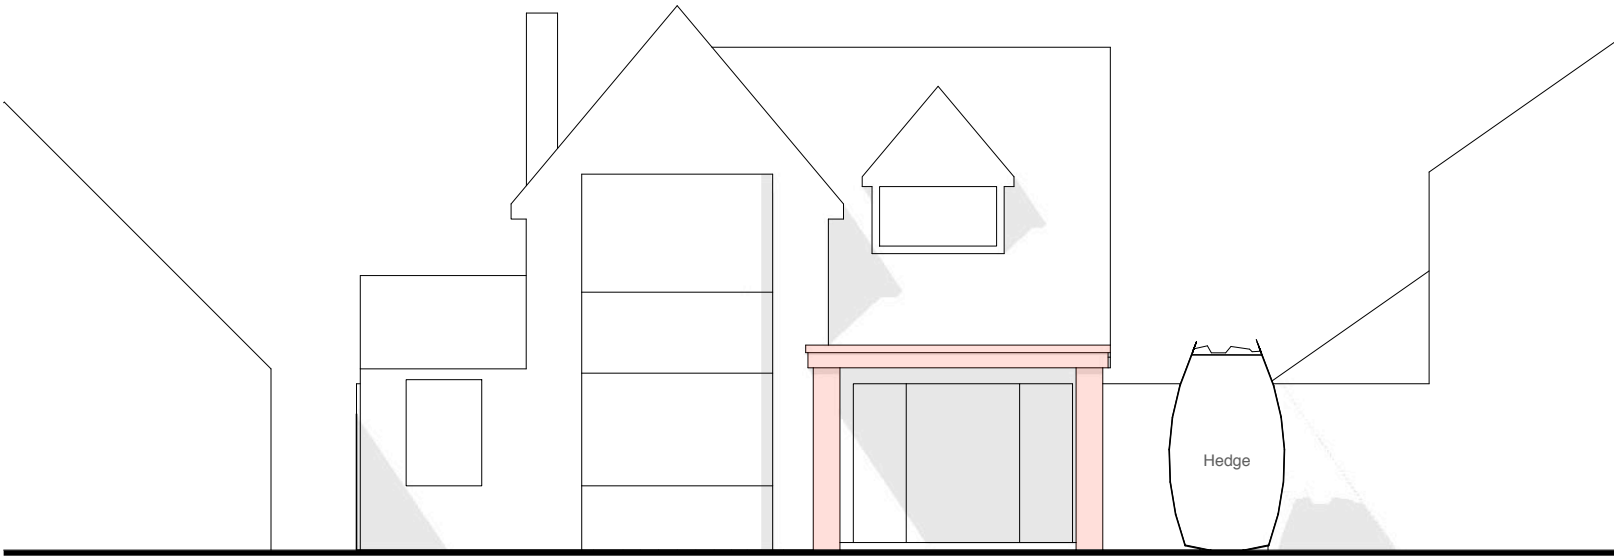

Existing Front Elevation
1:100

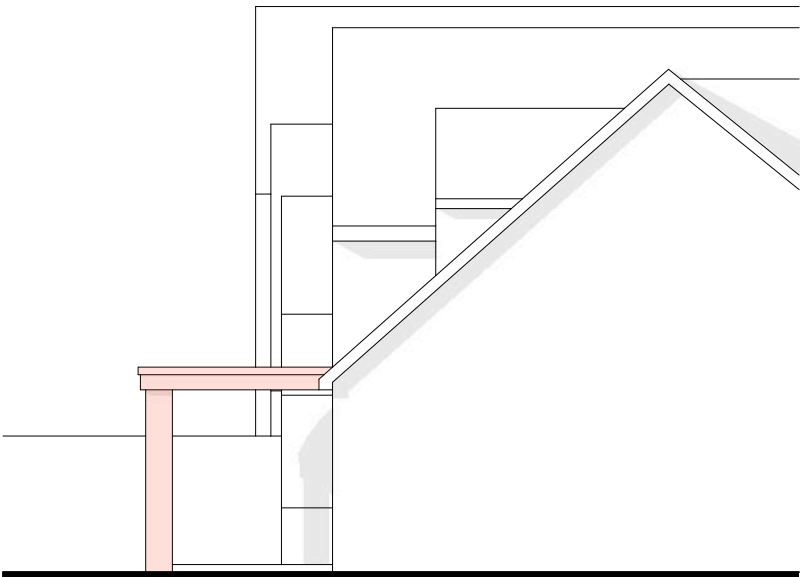


Existing Side Elevation
1:100

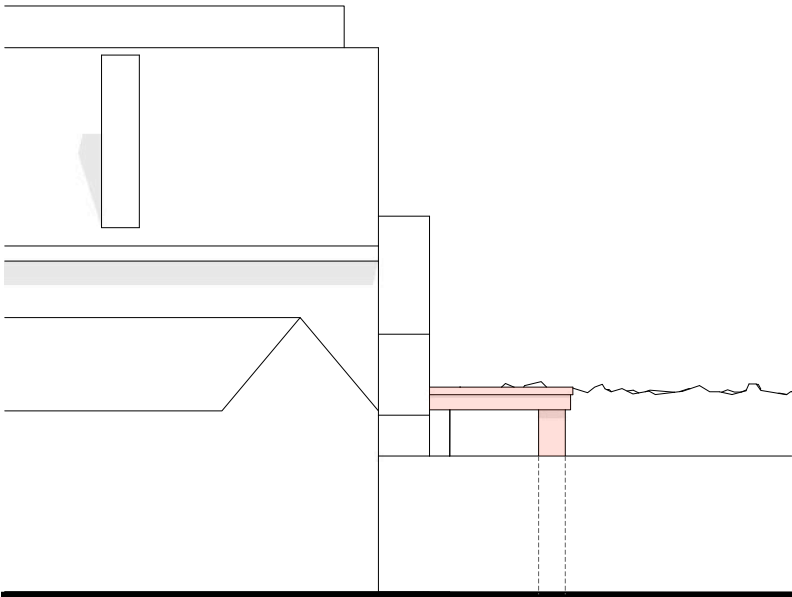

Existing Side Elevation
1:100

Address: 38 Frays Avenue, West Drayton, UB7 7AG
Client: Mr. Reza
Date: Nov. 2017

Email: michaeloakesarchitect@googlemail.com
Phone: 01895 235089
M.Oakes. Registered Architect. 10 Parkfield Avenue, Hillingdon, Middlesex, UB10 0DF, Great Britain

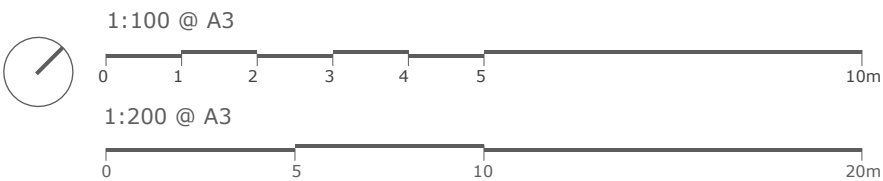

Drawing Title: Existing Floor Plans

Retrospective Planning Application for a Front Canopy to a Detached Dwelling

Project no. / Stage / Drawing no. / Revision: 0161- PLA- 10_B
Revision notes: A - First Issue
B - 01.12.17 - Scale bars added
Drawn by: LW


Copyright Michael Oakes Architect © 2017
Print all drawings in full colour at A3 size
Do not scale drawings

MICHAEL OAKES


B.A.Hons, Dipl. Architecture

REGISTERED ARCHITECT
DESIGNER and ILLUSTRATOR

Email: michaeloakesarchitect@gmail.com
Phone: 01895 235089

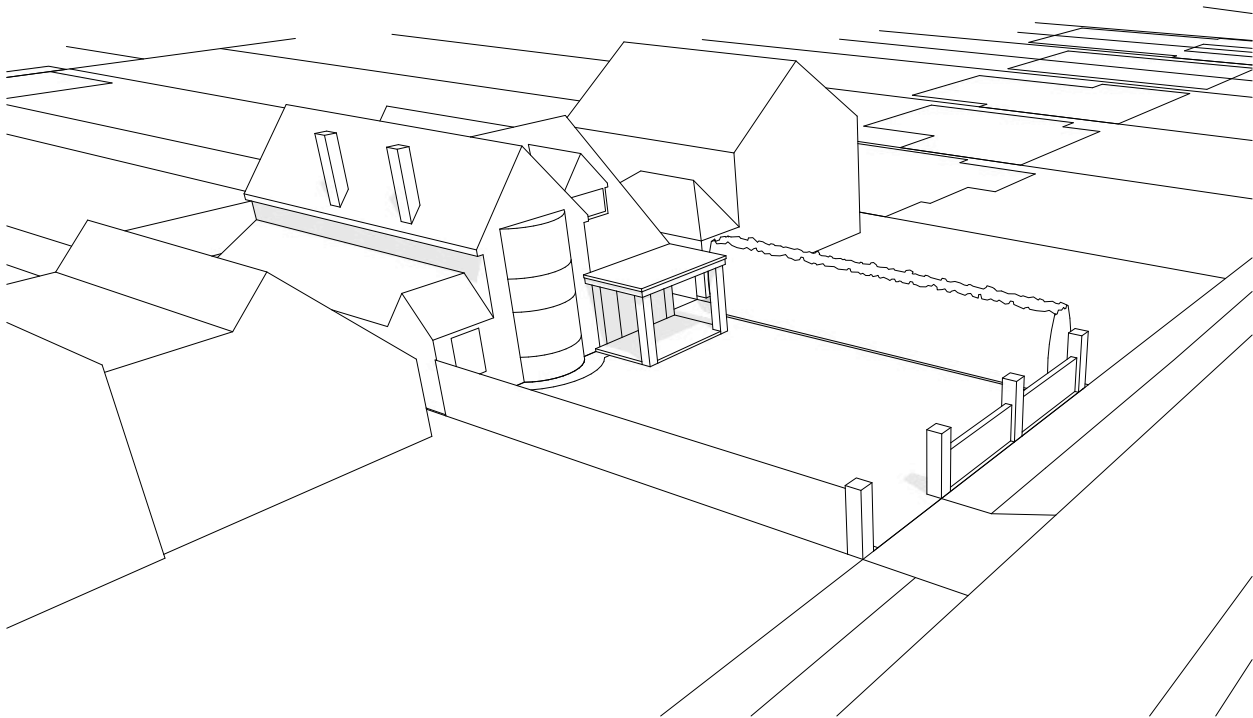

Existing 3D birds eye views

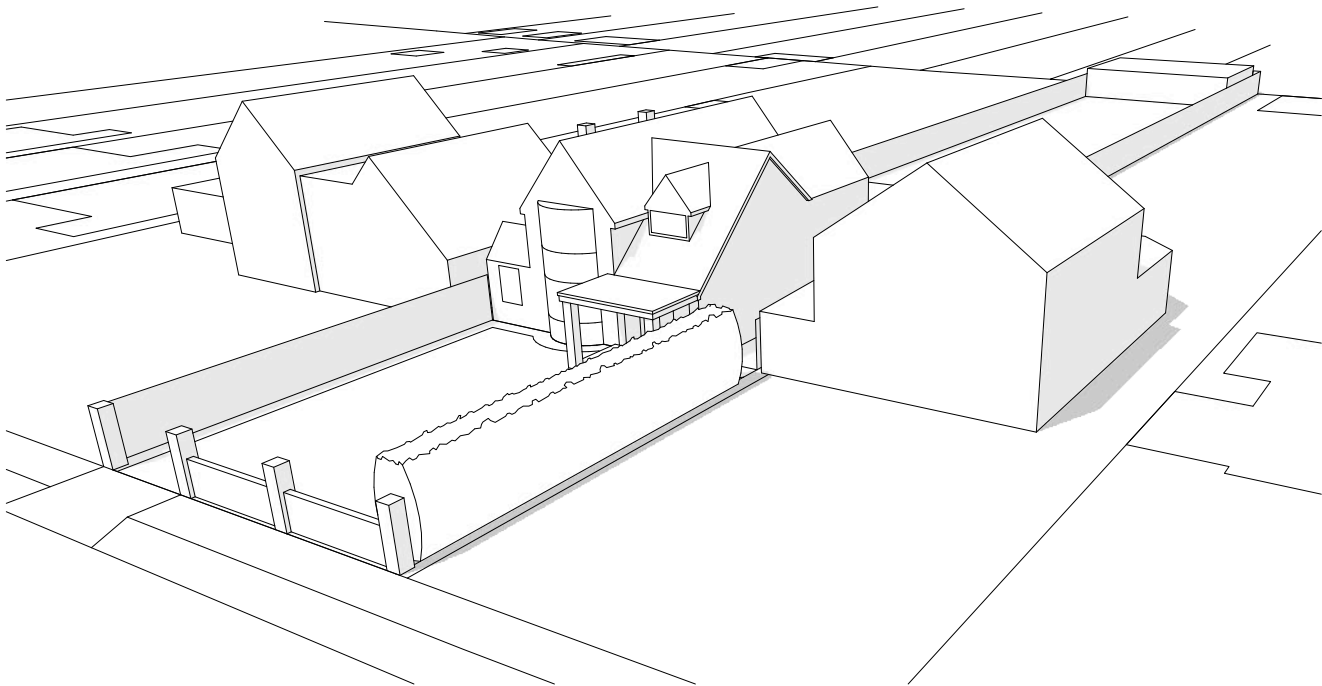

Address	Client	Date
38 Frays Avenue, West Drayton, UB7 7AG	Mr. Reza	Nov. 2017

Email: michaeloakesarchitect@gmail.com Phone: 01895 235089
M.Oakes. Registered Architect. 10 Parkfield Avenue, Hillingdon, Middlesex, UB10 0DF, Great Britain

Drawing Title
Existing 3D Birds Eye Views

Retrospective Planning Application for a Front
Canopy to a Detached Dwelling

Project no. / Stage /	Drawing no. / Revision
0161- PLA-	11_A
Revision notes:	Drawn by: LW
A - First Issue	

Copyright
Michael Oakes Architect © 2017
Print all drawings in full colour at A3 size
Do not scale drawings