
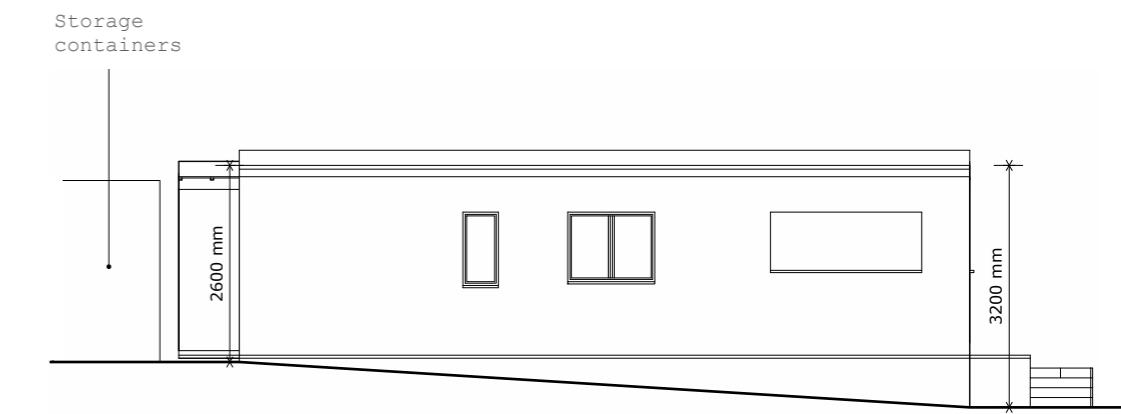
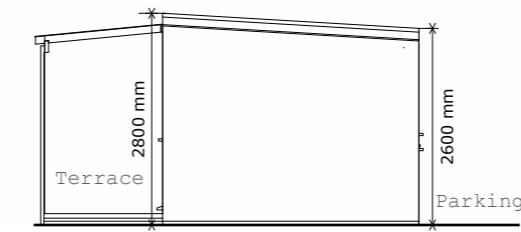
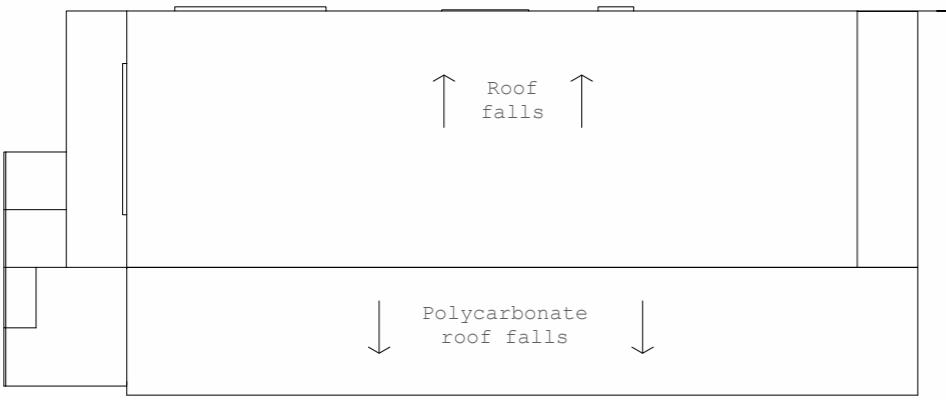
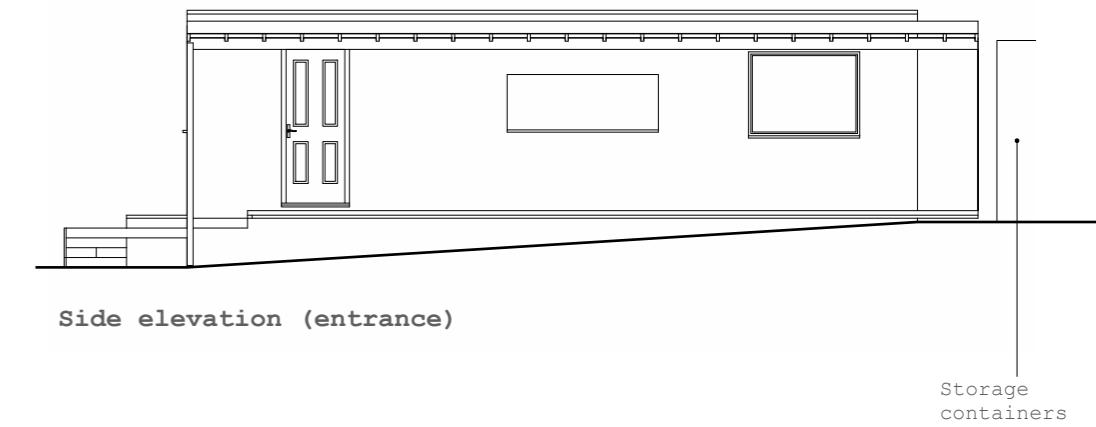
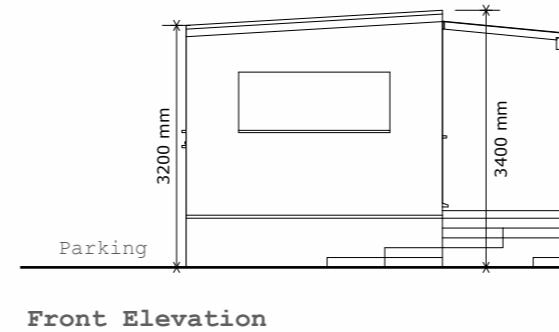


Parking

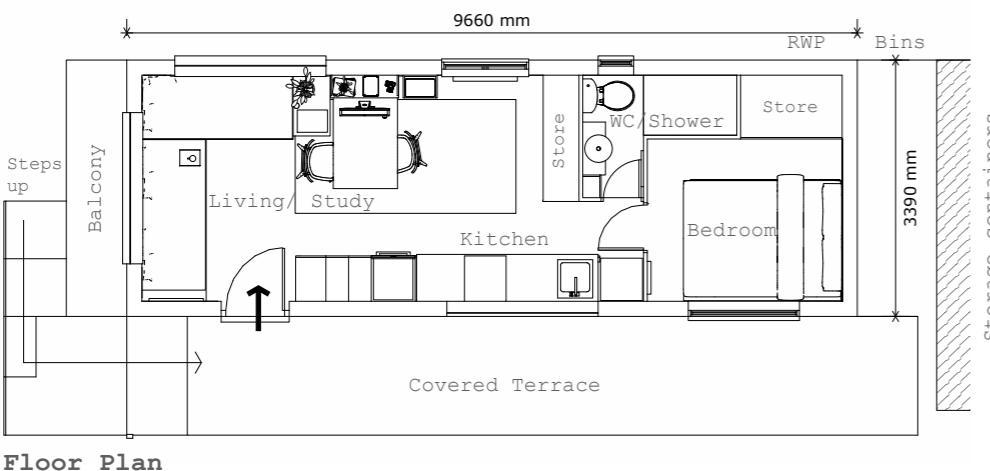

1:100 @ A3

0 1 2 3 4 5 10m

All dimensions to be checked on site