




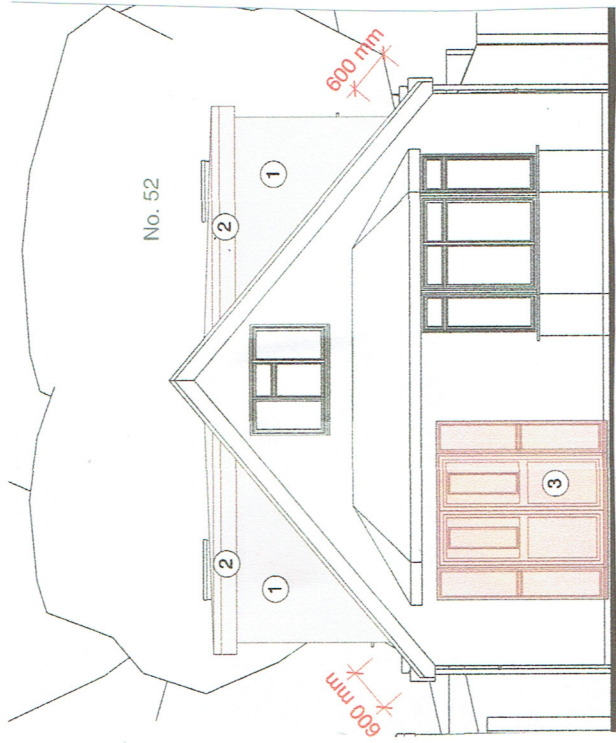


AS PROPOSED

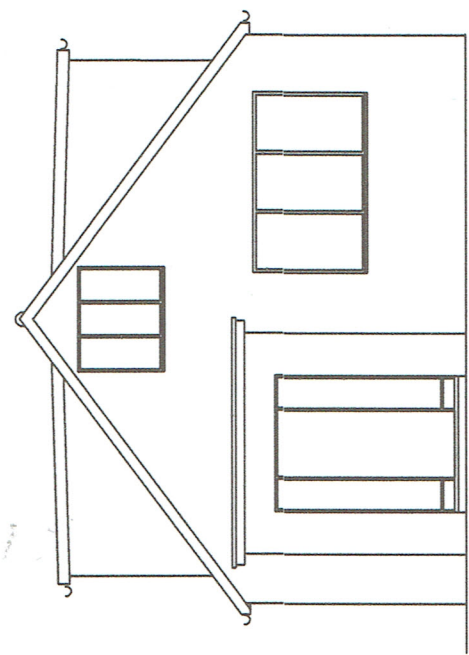

FRONT AS BUILT
April 2025

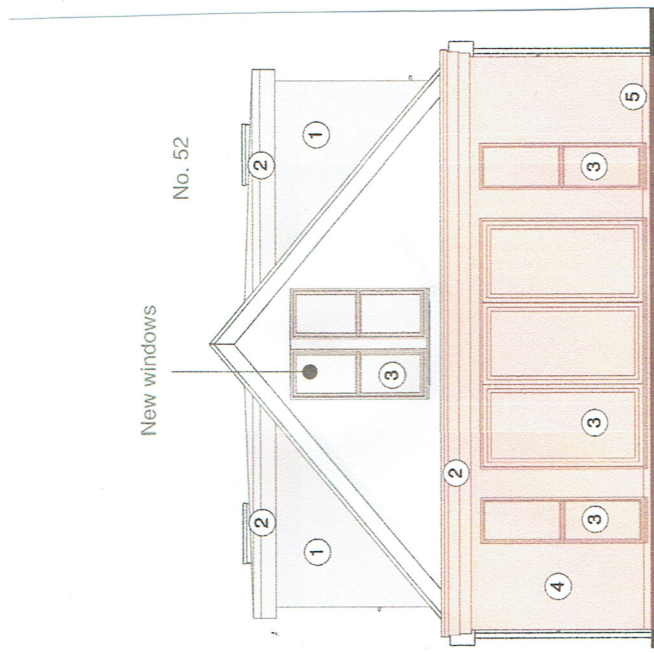

AS PROPOSED

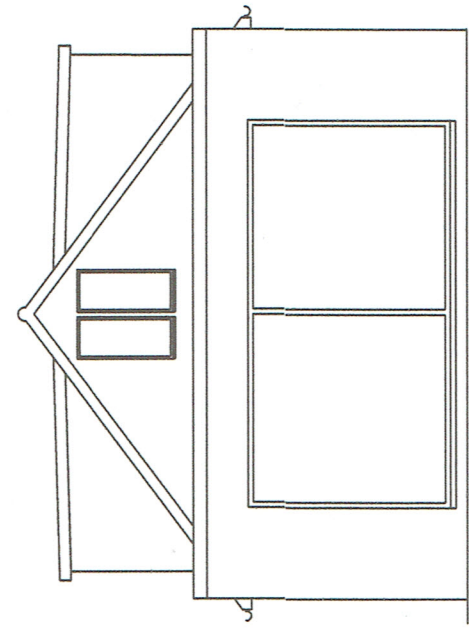

REAR AS BUILT
April 2025

FRONT AND REAR ELEVATIONS
ILLUSTRATING FENESTRATION & DORMERS
SCALE 1 : 100 at A4
Drawing CH/Copperfield/1

