





AS PROPOSED

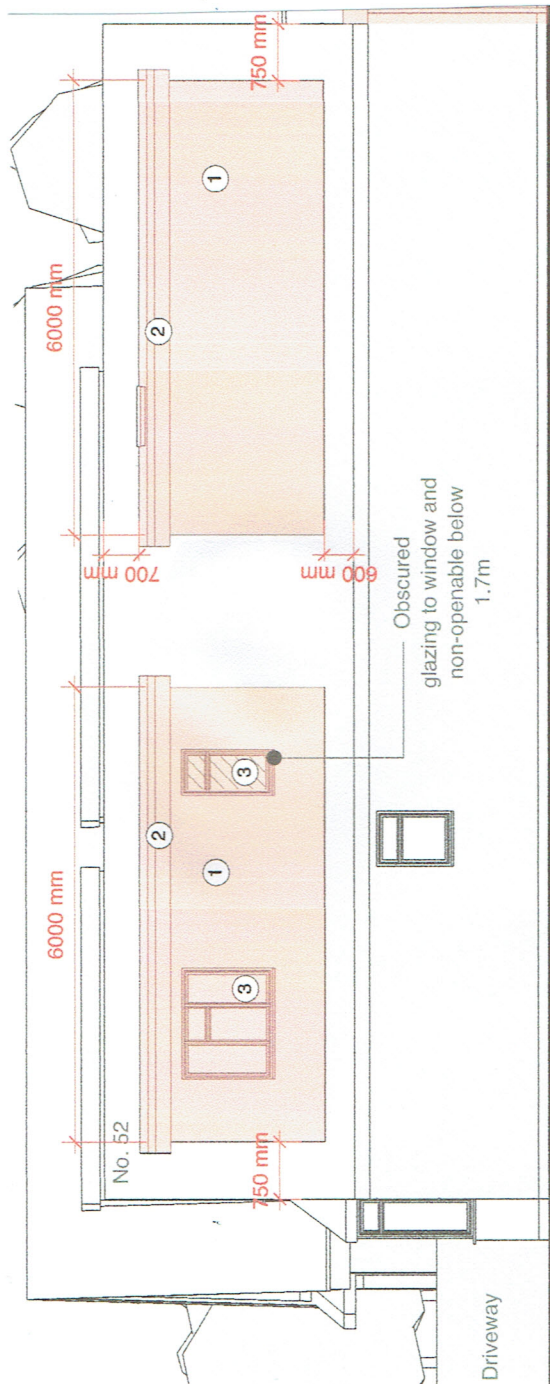

SOUTH ELEVATION
ILLUSTRATING FENESTRATION & DORMERS
SCALE 1 : 100 at A4
Drawing CH/Copperfield/2

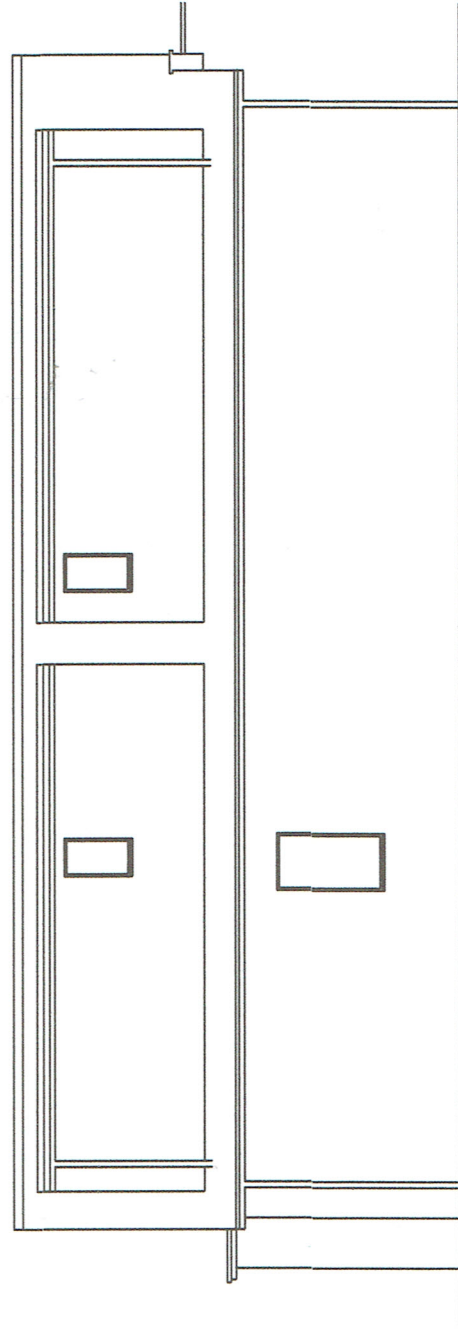

ALL GLAZING USING TRANSLUCENT GLASS
SOUTH ELEVATION AS BUILT
April 2025