





AS PROPOSED

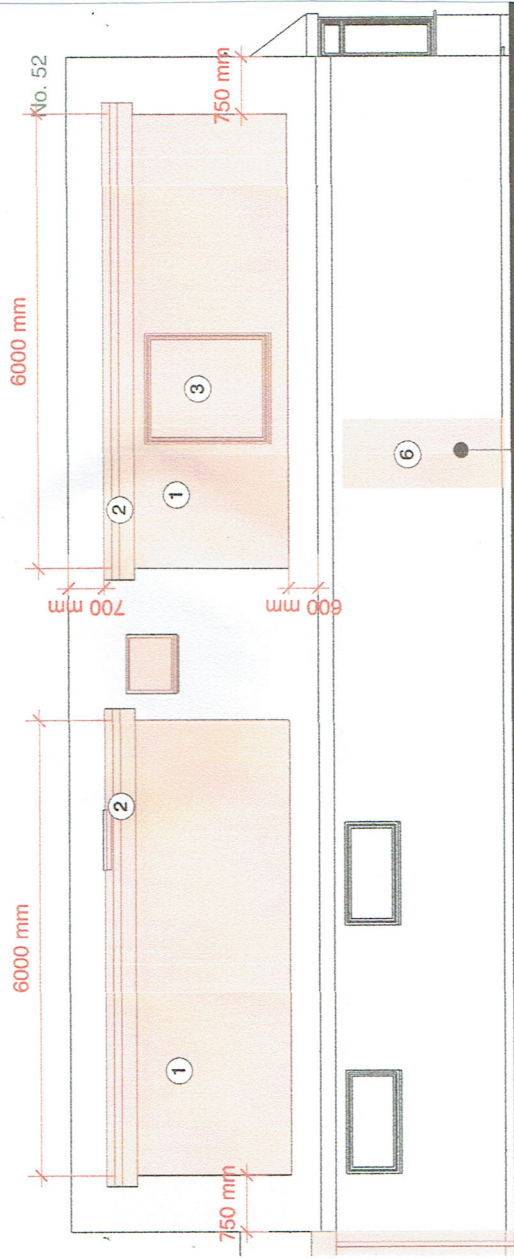

NORTH ELEVATION
ILLUSTRATING FENESTRATION & DORMERS
SCALE 1 : 100 at A4
Drawing CH/Copperfield/3

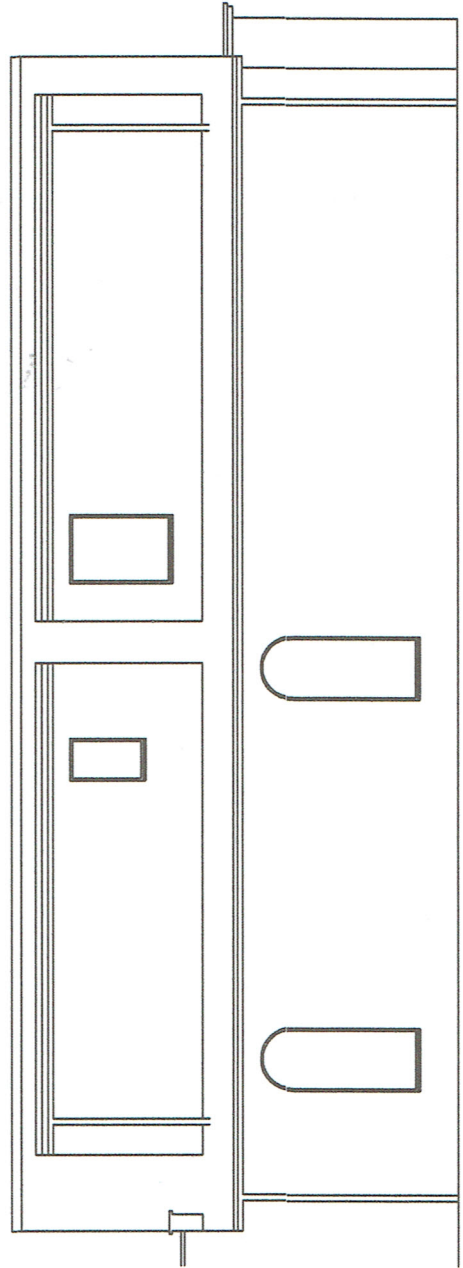

ALL GLAZING USING TRANSLUCENT GLASS
NORTH ELEVATION AS BUILT
April 2025