



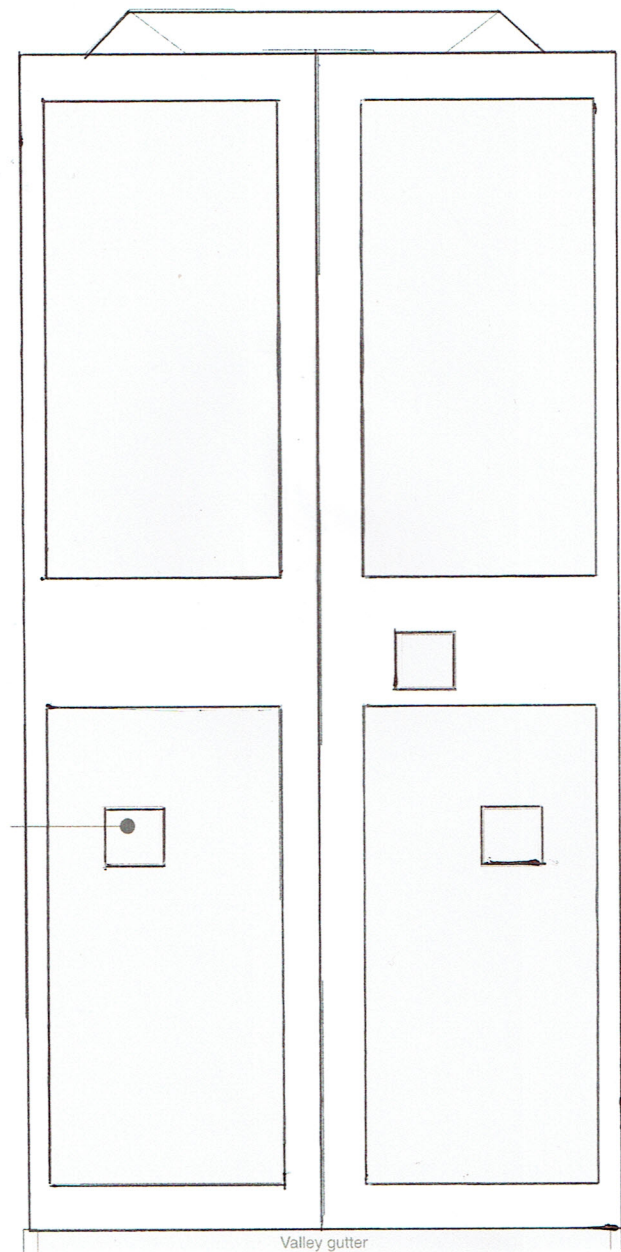

AS PROPOSED

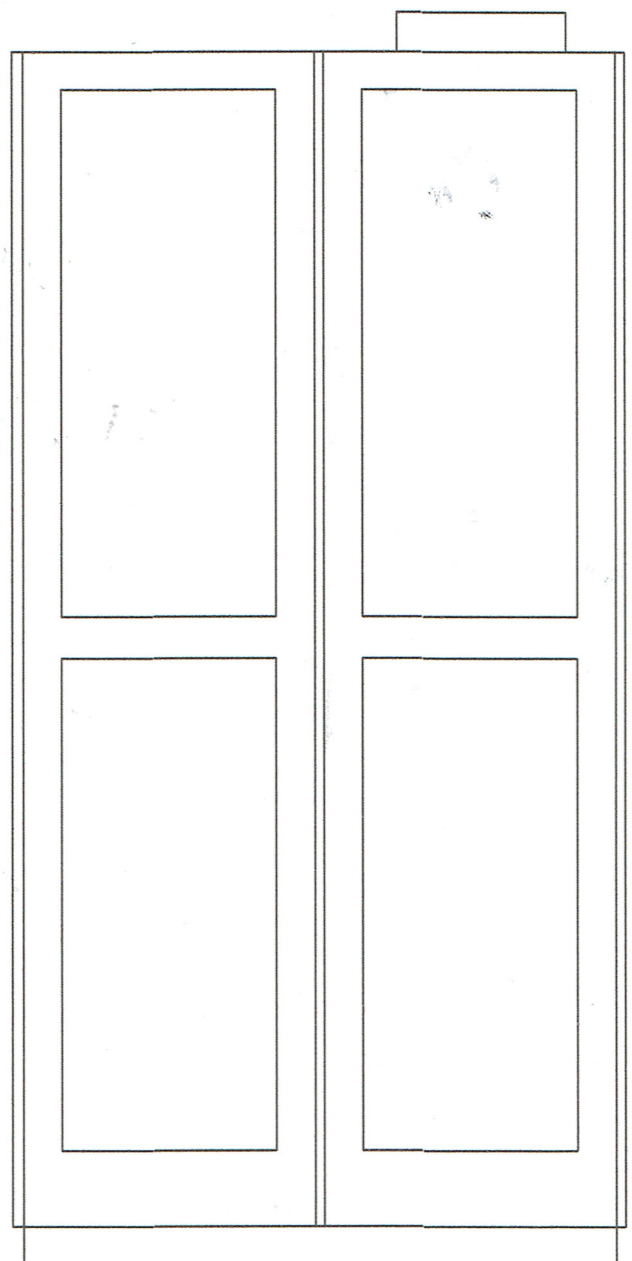

ROOF VIEW AS BUILT
April 2025

ROOF VIEW
ILLUSTRATING DORMERS
SCALE 1 : 100 at A4
Drawing CH/Copperfield/4

