


NOTES:

Black Lines Indicates as Existing.

Red Lines Indicates as Proposed.

Grey Dash Indicates Existing Demolished.

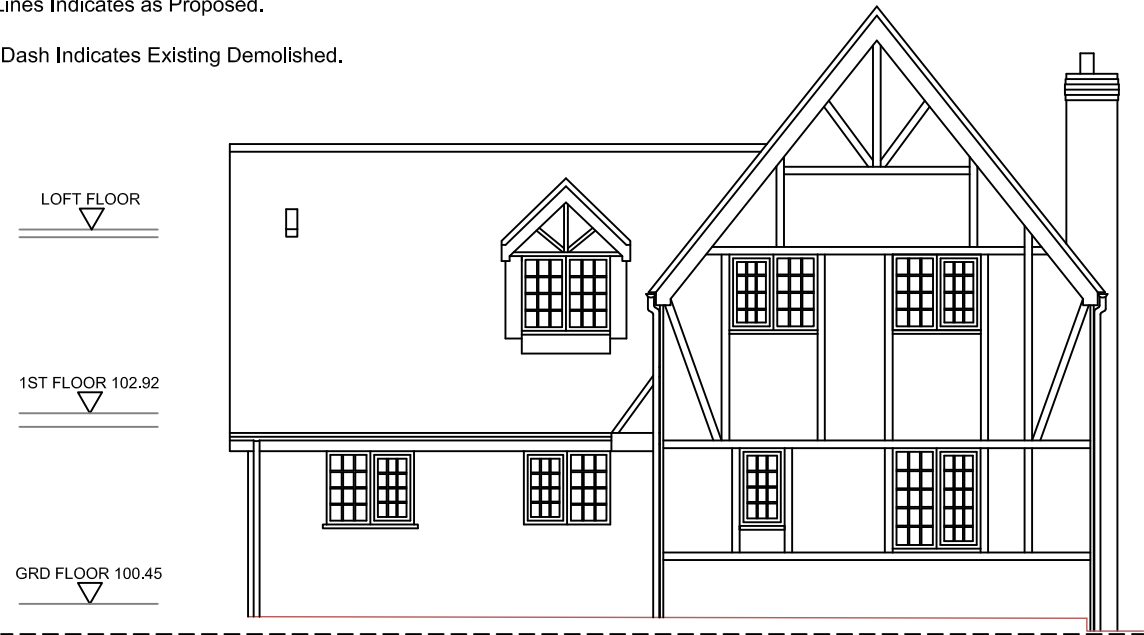


FRONT ELEVATION

DATUM LEVEL = 100.00m



REAR ELEVATION

DATUM LEVEL = 100.00m

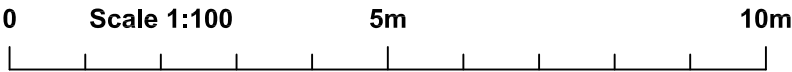

PROJECT
25 DEERINGS DRIVE
EASTCOTE
HA5 2NZ

DRAWING
Proposed Front &
Rear Elevations

Drawn By : SA

Date : 16.04.21

Approved By :

Scale : 1:100 @ A4

Drawing No.
5724/EL001

Rev.

SEABROOK
ARCHITECTS

CHARTERED ARCHITECTS

Unit 17, Chiltern Court, Asheridge Road,
Chesham, Bucks HP5 2PX
Tel: 01494 778918 e-mail: info@gsparchitects.co.uk