

GENERAL NOTES

All dimensions, levels, sizes, positions and locations of particulars as indicated on drawings are to be verified by the appointed contractor on site prior to engaging in works.

Any discrepancies must be reported to the Designer/Engineer/Surveyor or responsible person/s immediately.

No dimension to be scaled from the drawings for construction purposes unless otherwise indicated. All work is to comply with current Building Regulations.

Party Wall etc Act 1996 would apply and contractor is to assure that no work is commenced until this formality is completed.

The sole purpose of this drawing is the procurement of Planning Permission and Building regulation approval and work is NOT to commence before such approvals.


Where the drawing is used for the works, contractors should request at the time of tender, form the tenderer, full specification and schedule of work. To avoid any disputes, this schedule of works in conjunction with the drawings would be used to resolve matters.

Contractors to assure and satisfy himself that necessary Planning permission and Building Regulations are approved before tendering or commencement if works.

The competent person is to send to the local authority via the scheme provider a self certification certificate within 30 days of the electrical works completion. The client must receive both a copy of the self certificate and a BS7671 Electrical Installation Test Certificate (Reg.P1)

The Gas and Boiler installations will be carried out by a suitably qualified CORGI registered gas engineer or equal approved.

The contractor is responsible for ensuring compliance with the CDM Regulations and appropriate Health & Safety on site precautions.

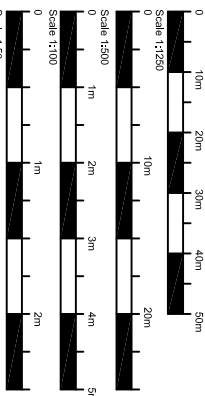

www.dhivadesigns.co.uk

DHIVA

Designs

REVISION


NO.	DESCRIPTION	BY	DATE
P8	MINOR AMENDMENTS	NP	15.05.25
P7	AS BUILT	NP	06.05.25
P6	OFFICER AMENDS	NP	12.01.23
P5	OFFICER AMENDS	NP	11.01.23
P4	MINOR AMENDMENT	NP	07.11.22

DRAWING TITLE			
AS BUILT PLANS			
DATE	SEPT 2022	DRAWN BY	NP
SCALE	1:100 @ A3	CHECKED BY	
DRAWING NO.	DD316-04-P8	REVISION	

SITE ADDRESS


16 THE CLOSE
HILLINGDON
UB10 0BP

17 The Close

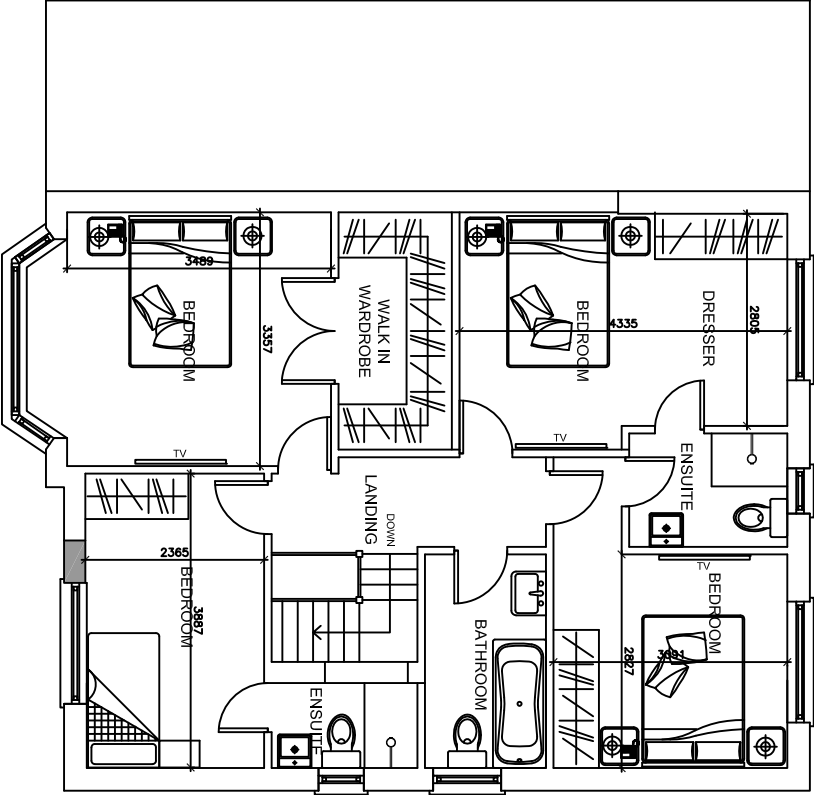


15 The Close

AS BUILT FIRST FLOOR PLAN

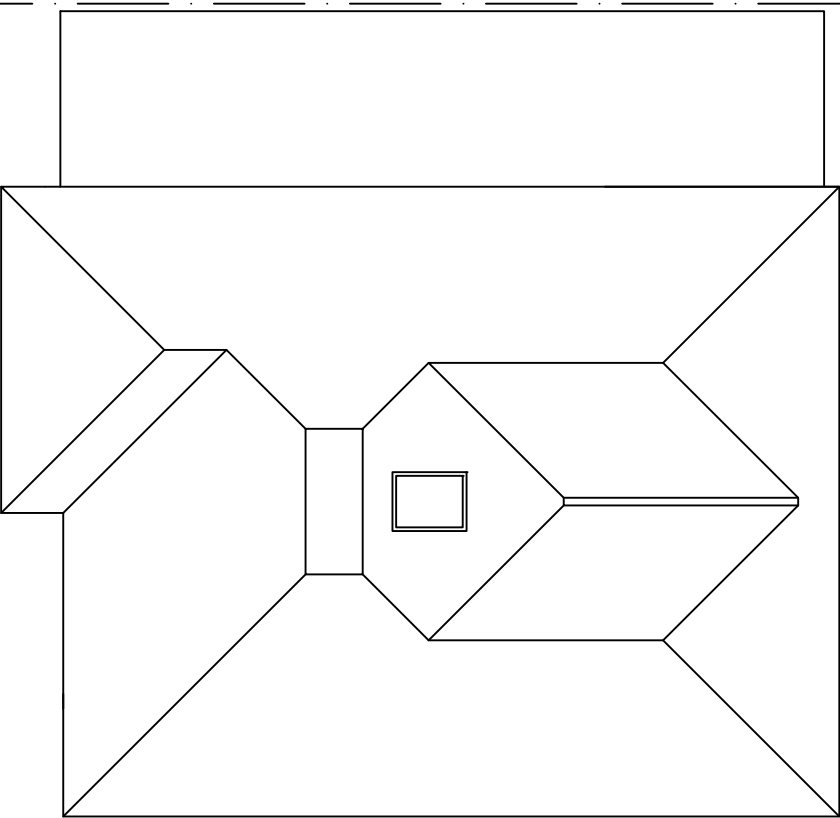

AS BUILT ROOF PLAN

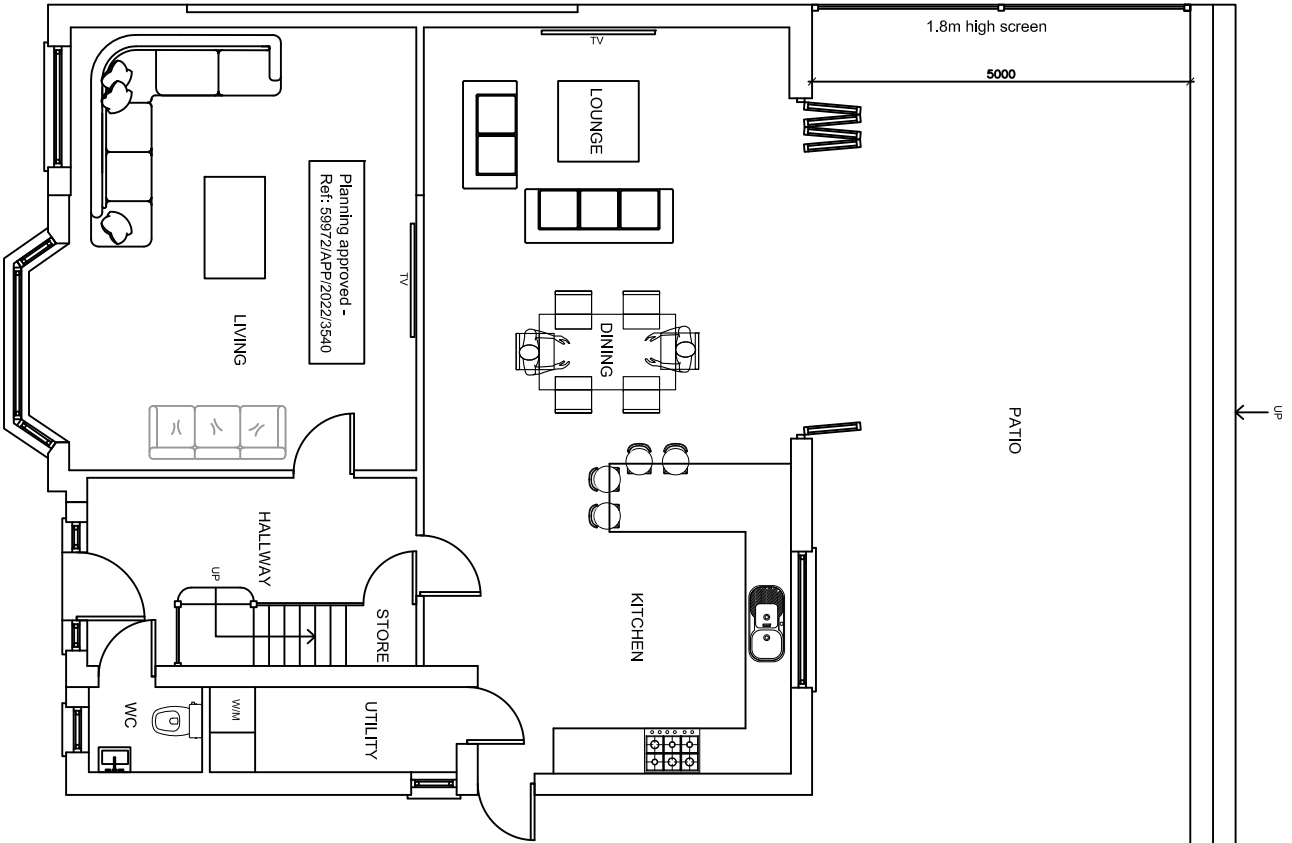

AS BUILT GROUND FLOOR PLAN