


Metres

5 0 1 2 3 4 5 10

SCALE 1 : 100

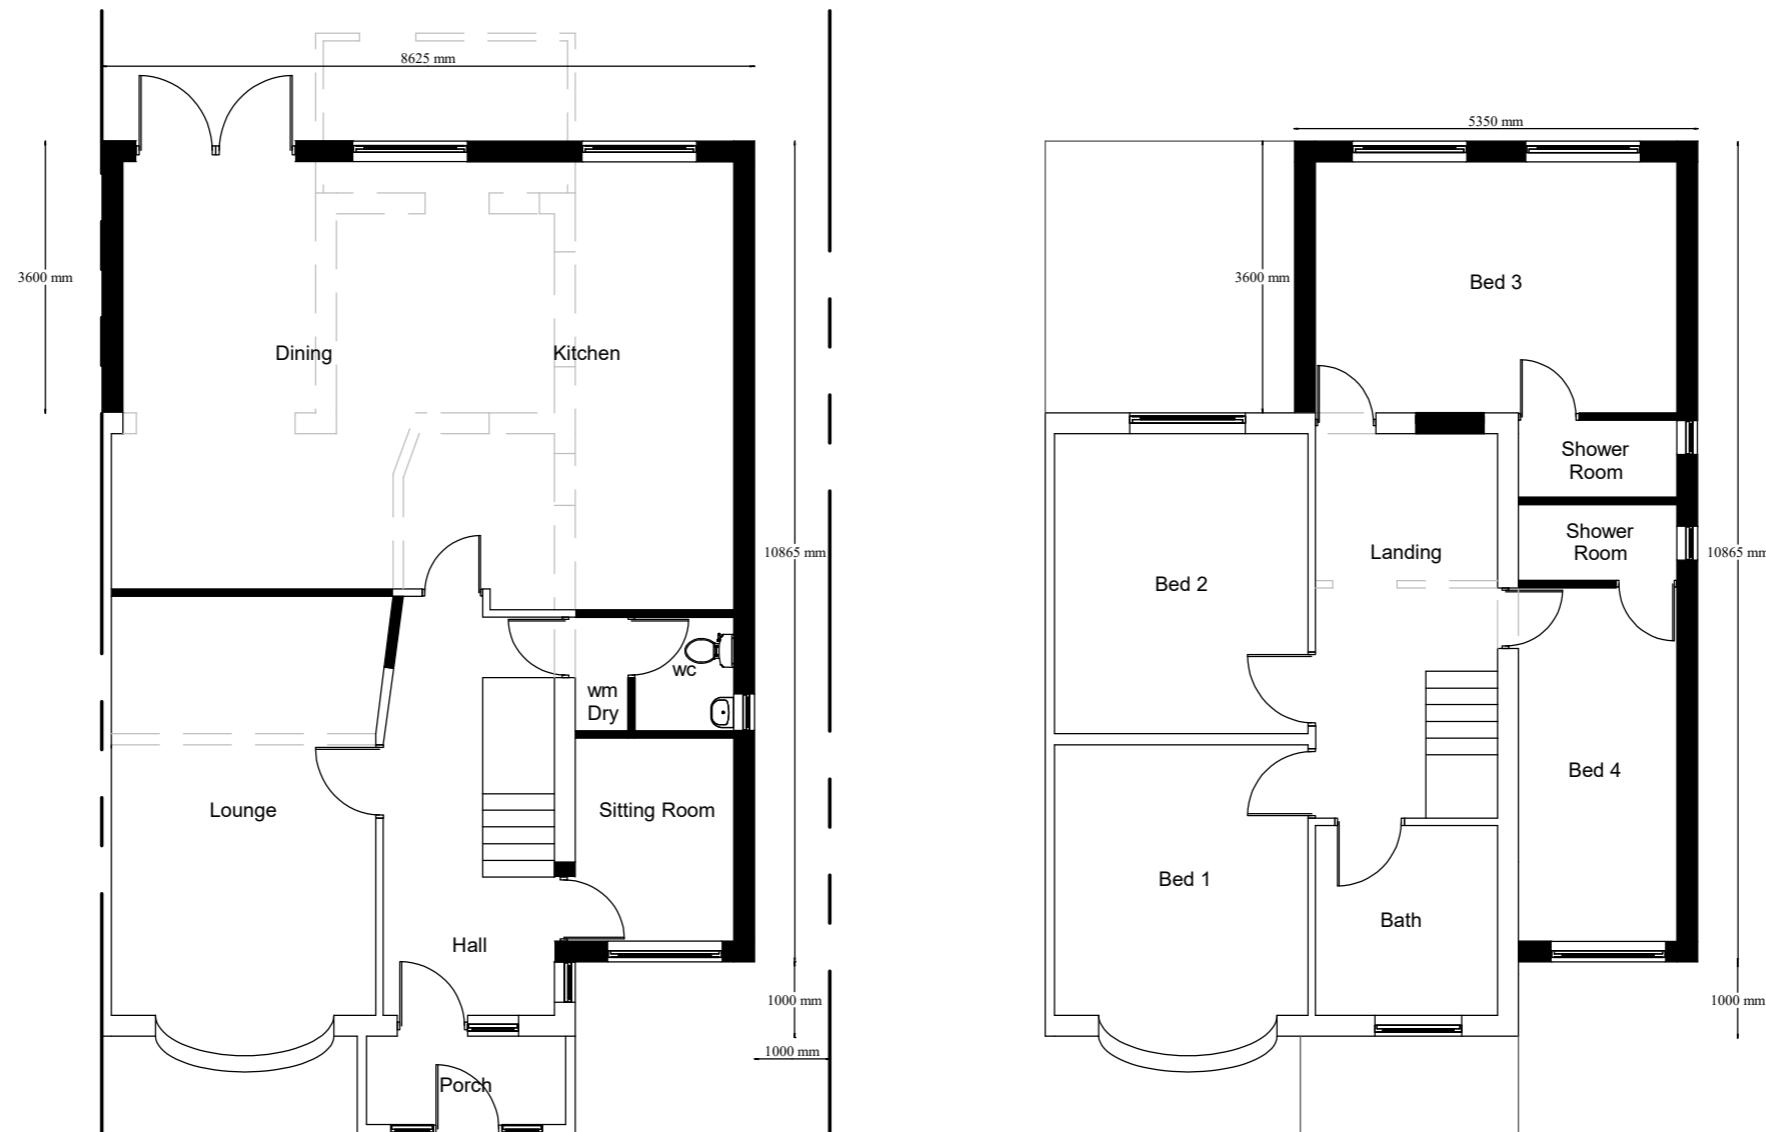

AS BUILT GF / FF LAYOUT
Scale 1:100

REV/NOTES:

Where building to the boundaries the adjacent owner is to be informed under the terms of the Party Wall Act 1996 and its provisions followed. Where building over boundaries the adjacent owner is to be served notice under section 65 of the Town & Country Planning Act 1990.

©This drawing and the works depicted are the copyright of ASB Property Consultants LTD and may not be reproduced or amended except by written permission of ASB Property Consultants LTD

Application:
HPA – Amendments to approved planning application (Ref : 60067/APP/2019/3774) – Retention of Side facing windows

Client: Mr K Singh Date: 23rd Oct 2024
Site: 152 Windsor Avenue, Drawn By: Gurps Benning
UB10 9BD
Scale: Refer to Drawing @ A3 Dwg.No: GTD1258 – 05

G T DESIGNZ LTD
Building Designs & Technical services

GT Designz Ltd, Tel : 0208 212 7981
Unit 1, Gethcien House, Dawley Road Mob : 07854 351 934
Hayes, UB3 1EH Email : enquiries@gtdesignztd.com