



GROUND FLOOR PLAN

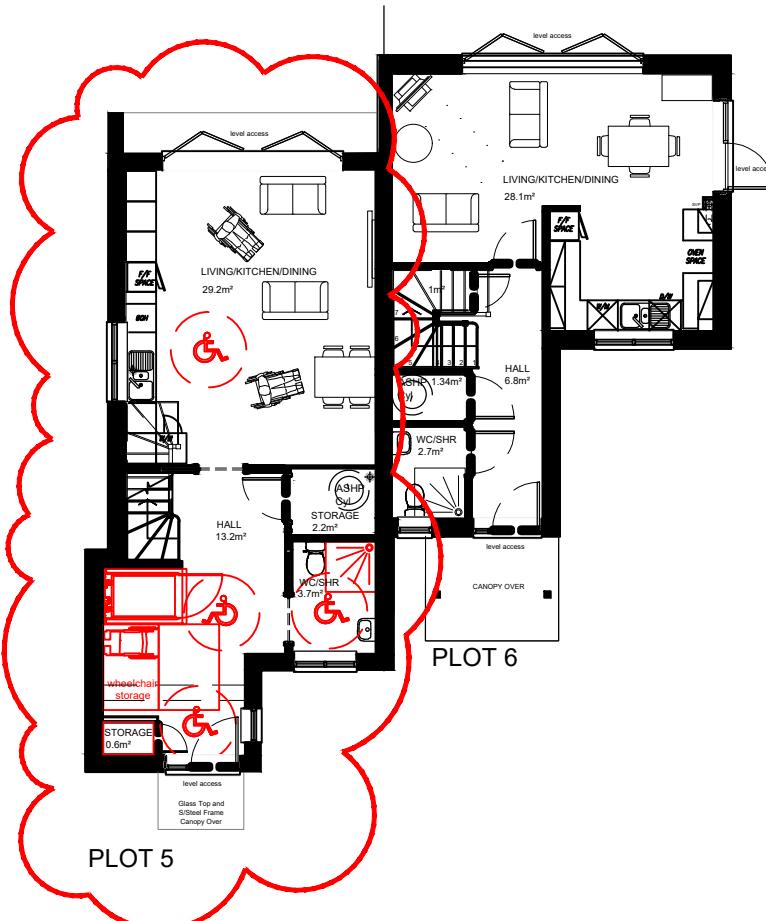

FIRST FLOOR PLAN

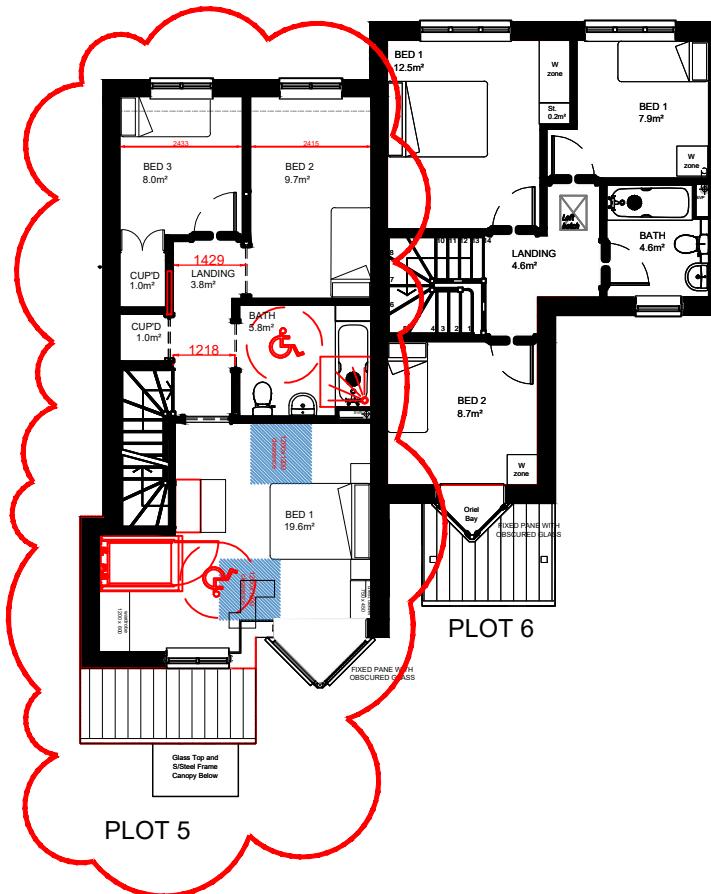


TOTAL AREAS:
PLOT 5
4P- 3 BED - Accessible House
gia gf = 54.1
ff = 54.3
GIA @ 108.5m²

PLOT 6
4P-3BED
GIA @ 88.6m²

**2 CAR PARKING SPACES
TO EACH HOUSE &
1 ADAPTABLE PARKING
SPACE TO EACH**

ROOF PLAN (SHOWING FOOTPRINT INCREASE REQUIRED TO MEET M4(3) CONDITION 10)

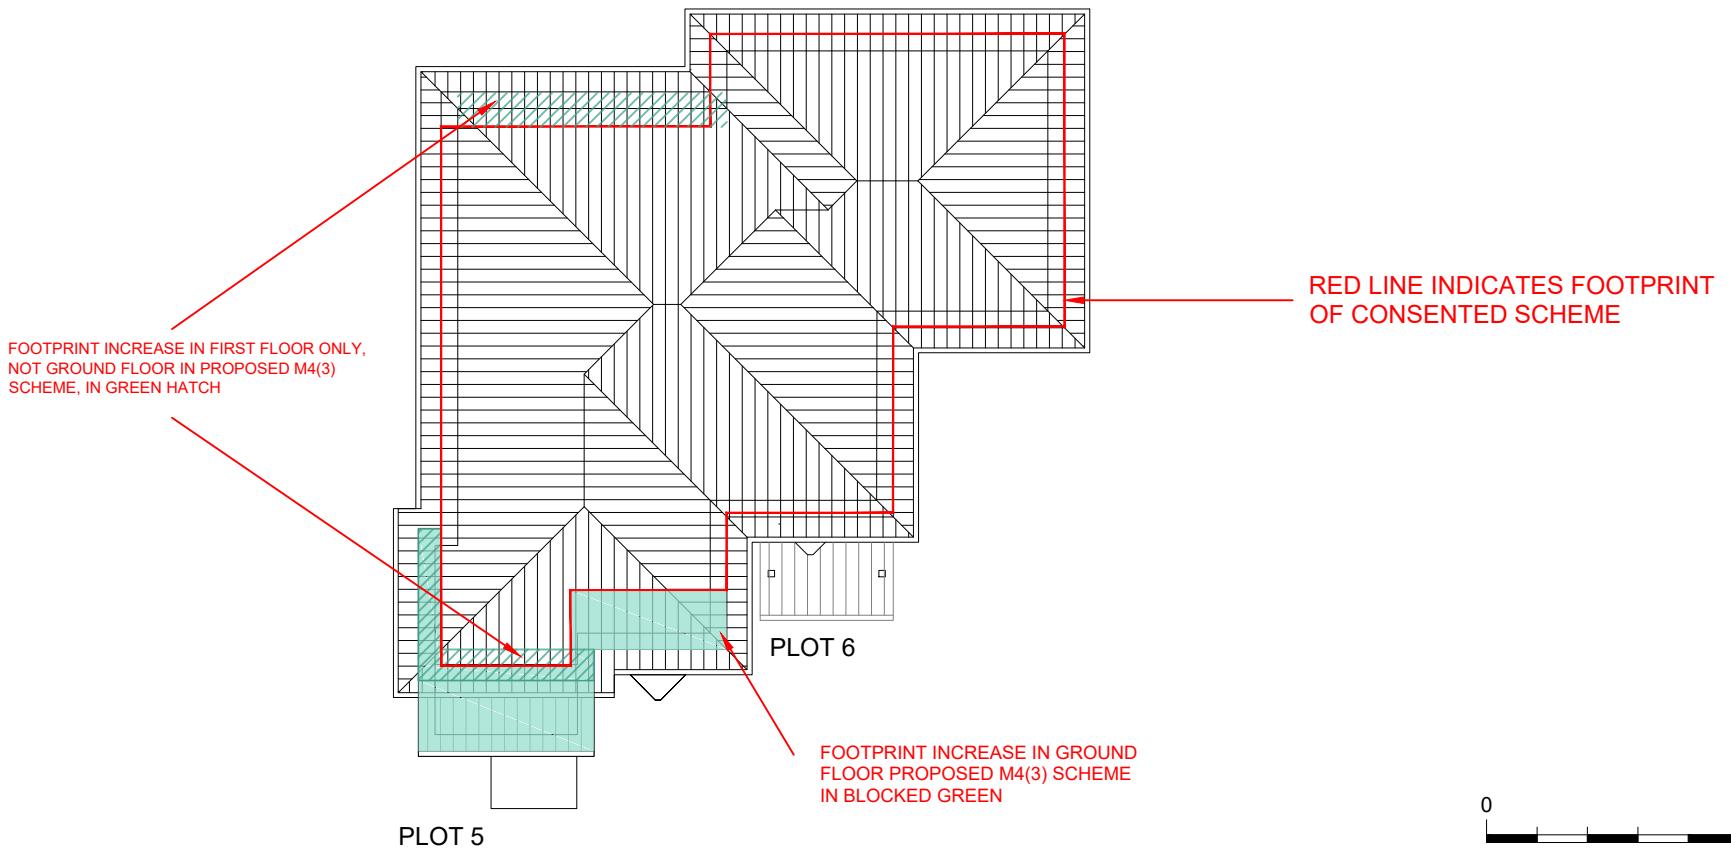

A horizontal scale bar with tick marks at 0, 5, 10, and 15. Below the scale bar is the text "Scale 1:150".

H	GF-store reduced (to 2.2m²) to increase Living/Kitchen/Dining to 28m². Nbs added to GF, 1st floor nominally reconfigured, Bed 3 now with standard door for 1200mm clearance. Roof plan amended to show increase in footprint for S73 application	DB	15.01.24
G	Layout updated to meet M4(3) and notes revised.	DB	16.12.23
F	Lift provision relocated and upstairs layout update	DB	05.10.23
E	Ground floor reconfigured to meet M4(3).	DB	05.10.23
D	M4(3) layout showing wheelchair storage and lift provisions. Alternate GF M4(3) w/c layout, reduction to living/dining/kitchen area agreed with dda officer. Reduction from 3 bed to 2 bed, M4(3) bathroom layout shown on 1st floor.	DB	03.10.23
C	Plot 5 ground floor plan updated to show M4(3) requirements with wall layouts shown in red.	MY	11.05.23
B	GEA removed	MY	11.05.23
A	Spayed bay windows with obscured glass to rbs added to front bedrooms, plans revised accordingly. EV charger note revised	DB	18.01.23
Rev	Revision notes	Initials	Date
 HILLINGDON LONDON			
RESIDENTS SERVICES CAPITAL PROGRAMME & WORKS SERVICE 2E/10, CIVIC CENTRE, UXBRIDGE, UB8 1UW Tel: 01895 250 111 Fax: 01895 277 224			
PROJECT FORMER GARAGES SITE SULLIVAN CRESCENT HAREFIELD, UB9 6NL			
DESCRIPTION			
PROPOSED PLANS OF PLOT 5 AND 6			
SCALE 1:150 @ A3	DRAWN BY MY	CHECKED BY SV	DATE NOV 2021
DRAWING No.		REV.	
2021/D/320/P/06.		H	