



This page shows the approved plans
ref: 60789/APP/2021/1767 & ref:
60789/APP/2019/2344

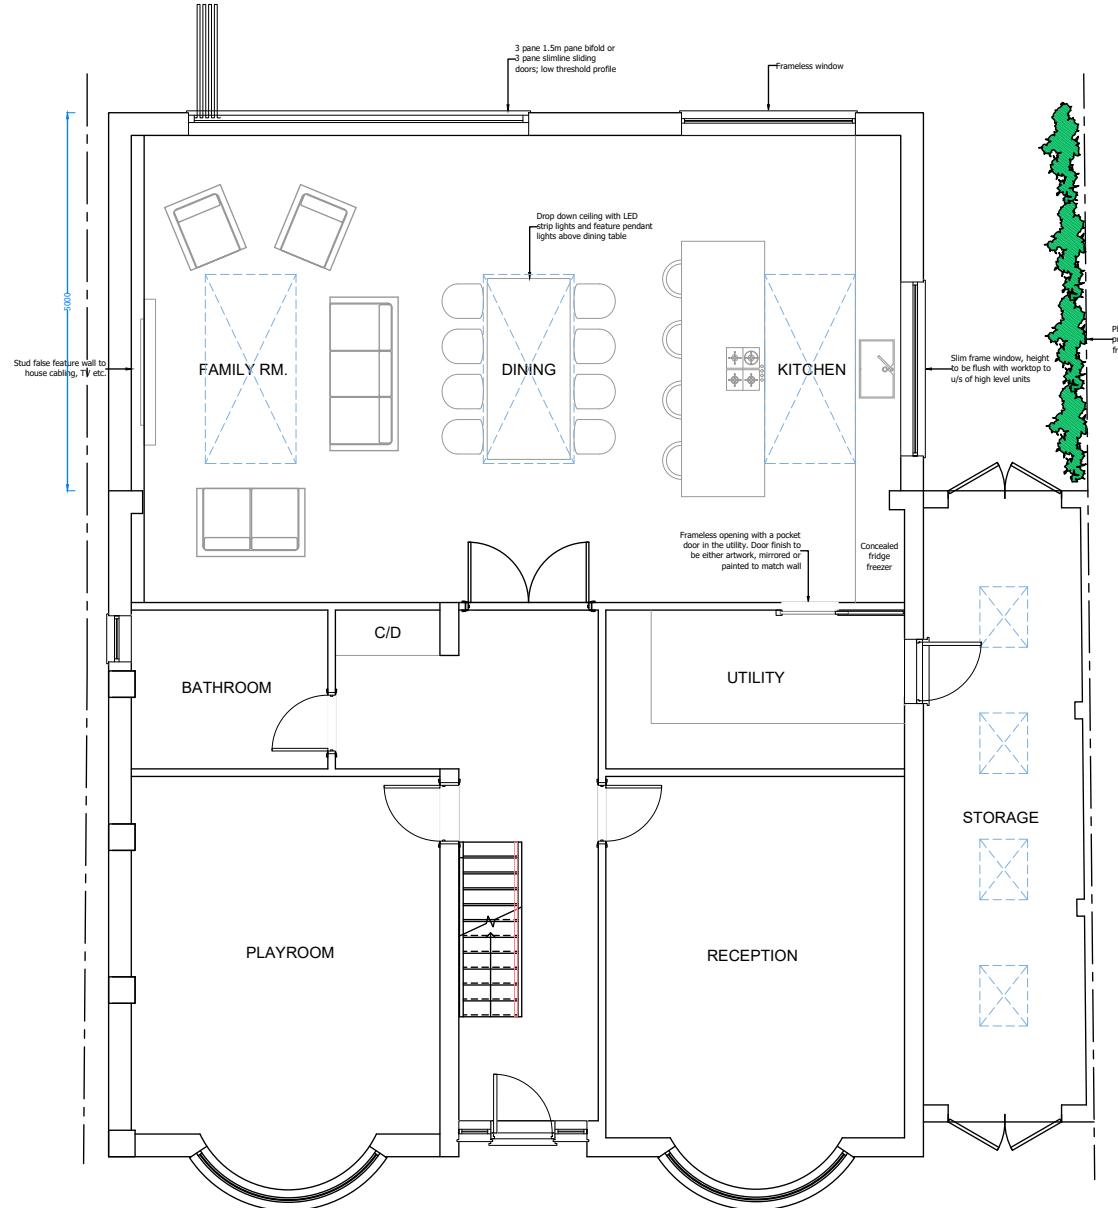

GROUND FLOOR PLAN

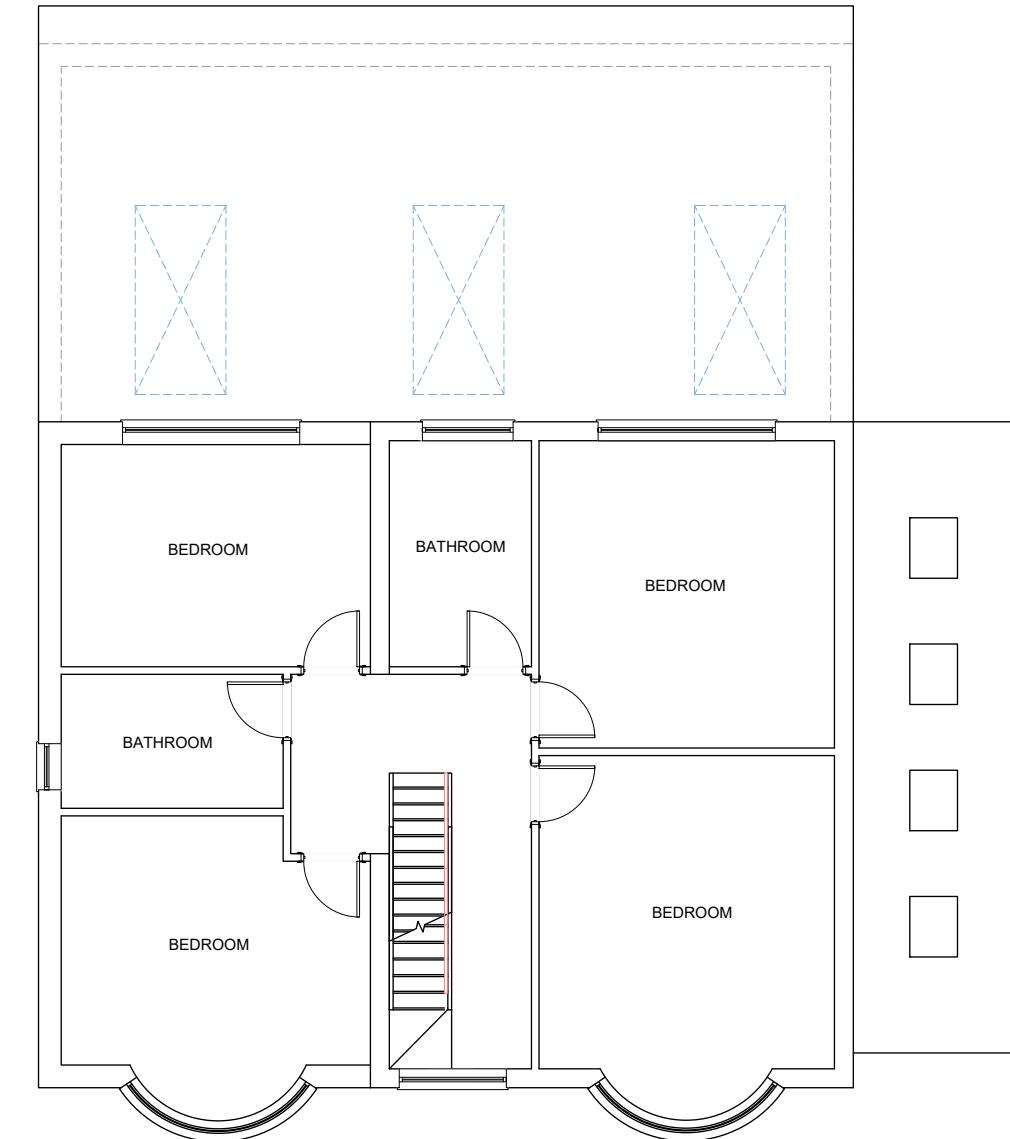

FIRST FLOOR PLAN
(SHOWING EXT ROOF PLAN)

PROJECT. Multiple extensions

ADDRESS. 4 Belmont Close Uxbridge UB8 1RF

DRAWING. Approved GA

DATE. 08/2022

REV. SCALE.1/100

PAGE. 01

PAPER. A3


Unit 1 Cowley Mill Trading Estate
Longbridge Way, Uxbridge
UB8 2YG

T +44 (0) 7973 663 706


E info@blueprintvista.co.uk

W www.blueprintvista.co.uk

This page shows the approved plans
ref: 60789/APP/2021/1767 & ref:
60789/APP/2019/2344

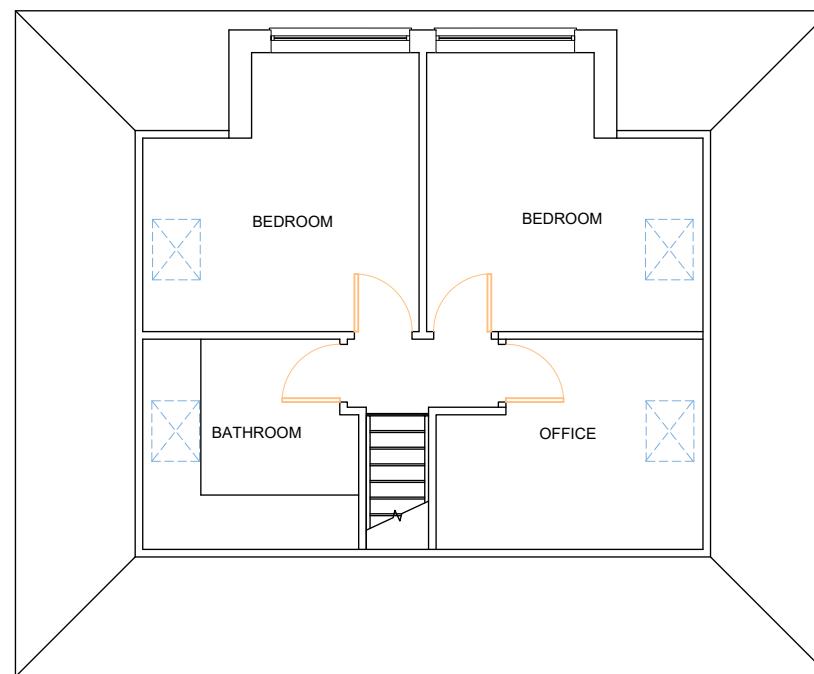

SECOND FLOOR PLAN

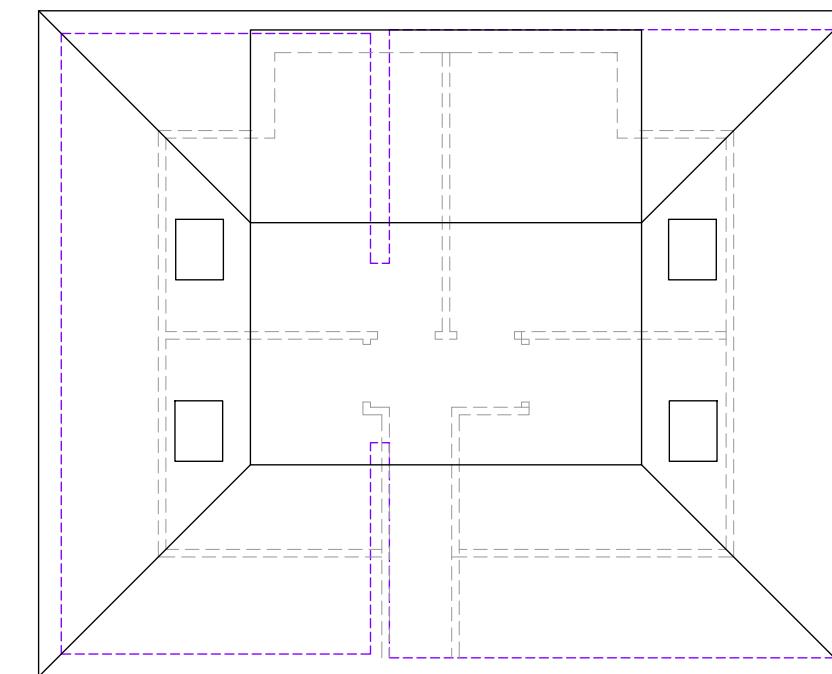

ROOF PLAN

PROJECT. Multiple extensions

ADDRESS. 4 Belmont Close Uxbridge UB8 1RF

DRAWING. Approved GA 2

REV. SCALE.1/100

PAGE. 01a

DATE. 08/2022

PAPER. A3

Unit 1 Cowley Mill Trading Estate
Longbridge Way, Uxbridge
UB8 2YG

T +44 (0) 7973 663 706

E info@blueprintvista.co.uk

W www.blueprintvista.co.uk

Do not scale from drawing (apart from the planning department). All dimensions/levels must be checked on site by a contractor/third party prior to commencement. Any discrepancies must be reported to us in writing before proceeding. All works are copyright protected and must not be copied or

transmitted without our prior written permission. Copyright infringements shall be legally enforced and pursued. Works should not commence before a Planning/Building Control approval is received. Client bears full responsibility for any resulting alterations due to commencement of works prior to an approval.

1/100 2m 4m
1/200 4m 8m
1/500 10m 20m


Date	Rev.	Details
-	-	-

BLUEPRINT
VISTA +
ARCHITECTURE

Architecture + Interiors
Planning + Engineering



FRONT ELEVATION

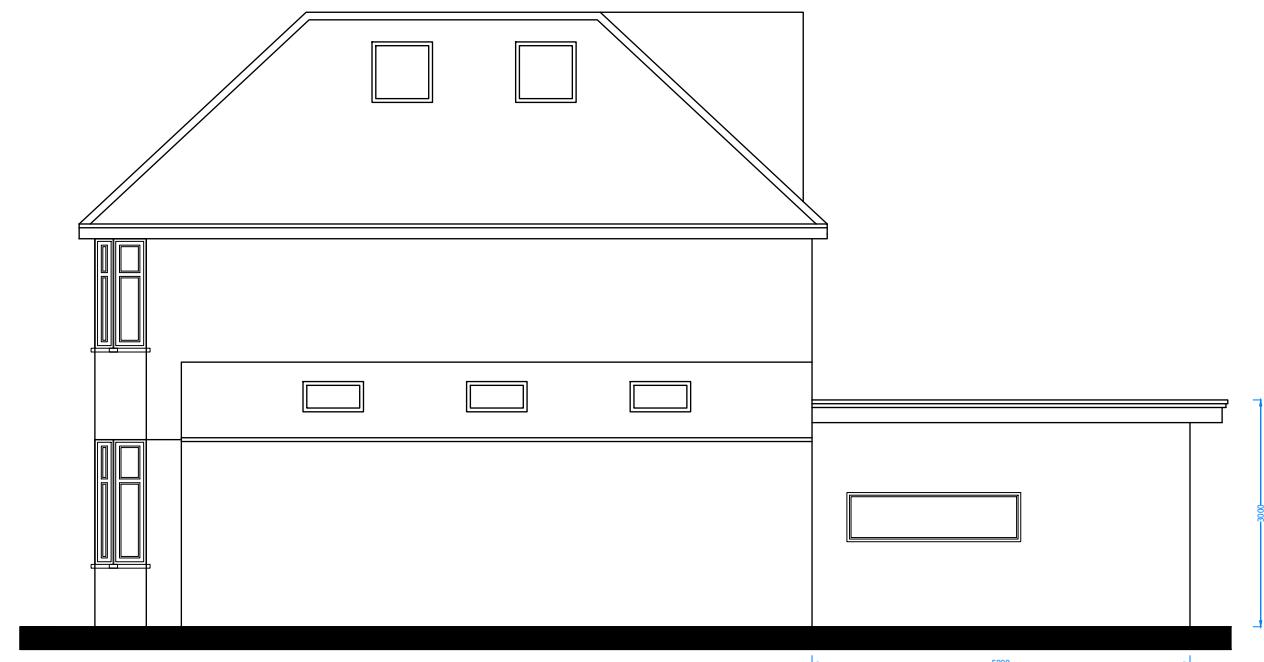


SIDE ELEVATION



REAR ELEVATION

This page shows the approved plans
ref: 60789/APP/2021/1767 & ref:
60789/APP/2019/2344

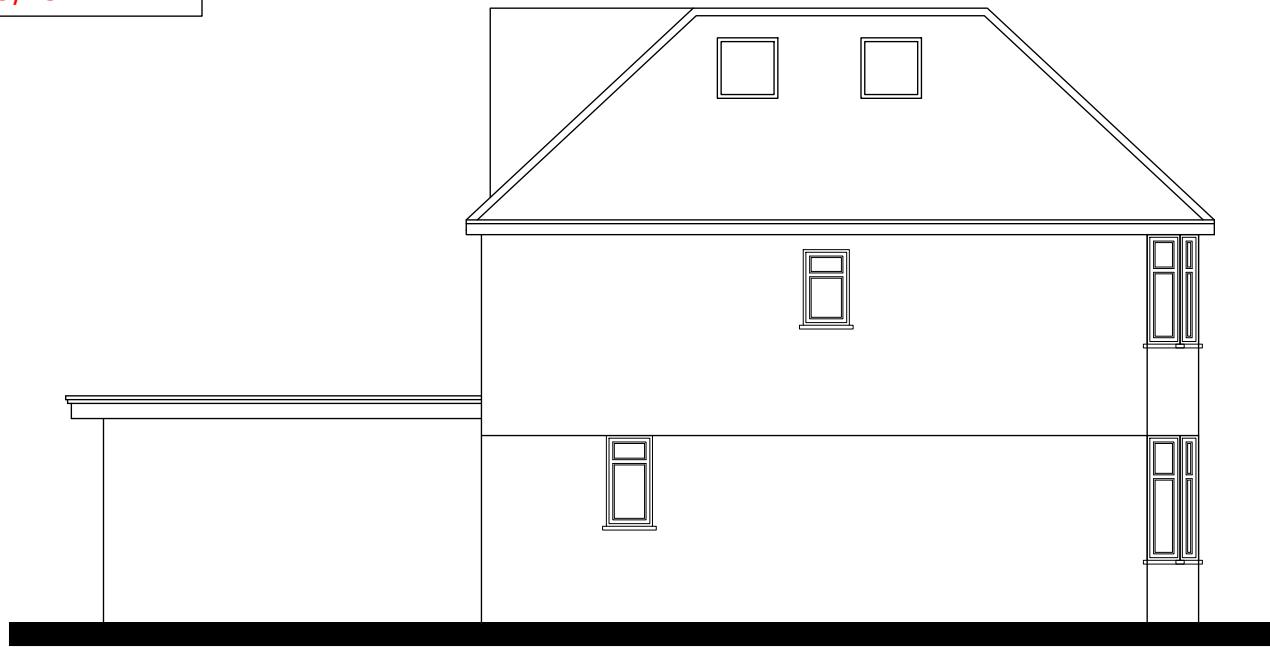

SIDE ELEVATION

PROJECT. Multiple extensions

ADDRESS. 4 Belmont Close Uxbridge UB8 1RF

DRAWING. Approved Elevations

DATE. 08/2022

REV. SCALE.1/100

PAGE. 02

PAPER. A3




Architecture + Interiors
Planning + Engineering


1/100 2m 4m
1/200 4m 8m
1/500 10m 20m

Date	Rev.	Details
-	-	-

As Built Plans

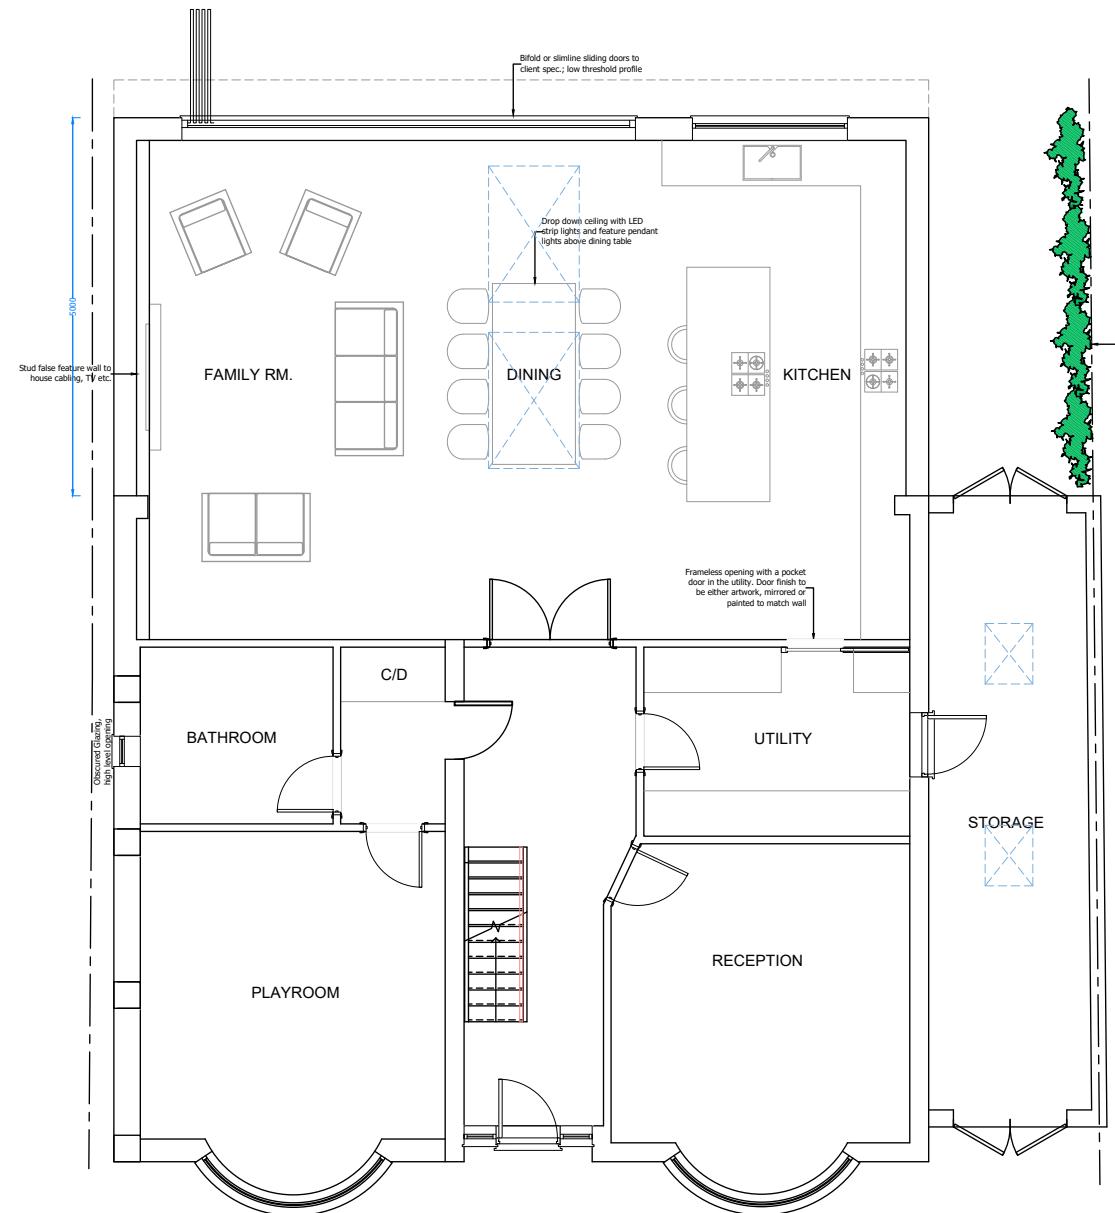

GROUND FLOOR PLAN

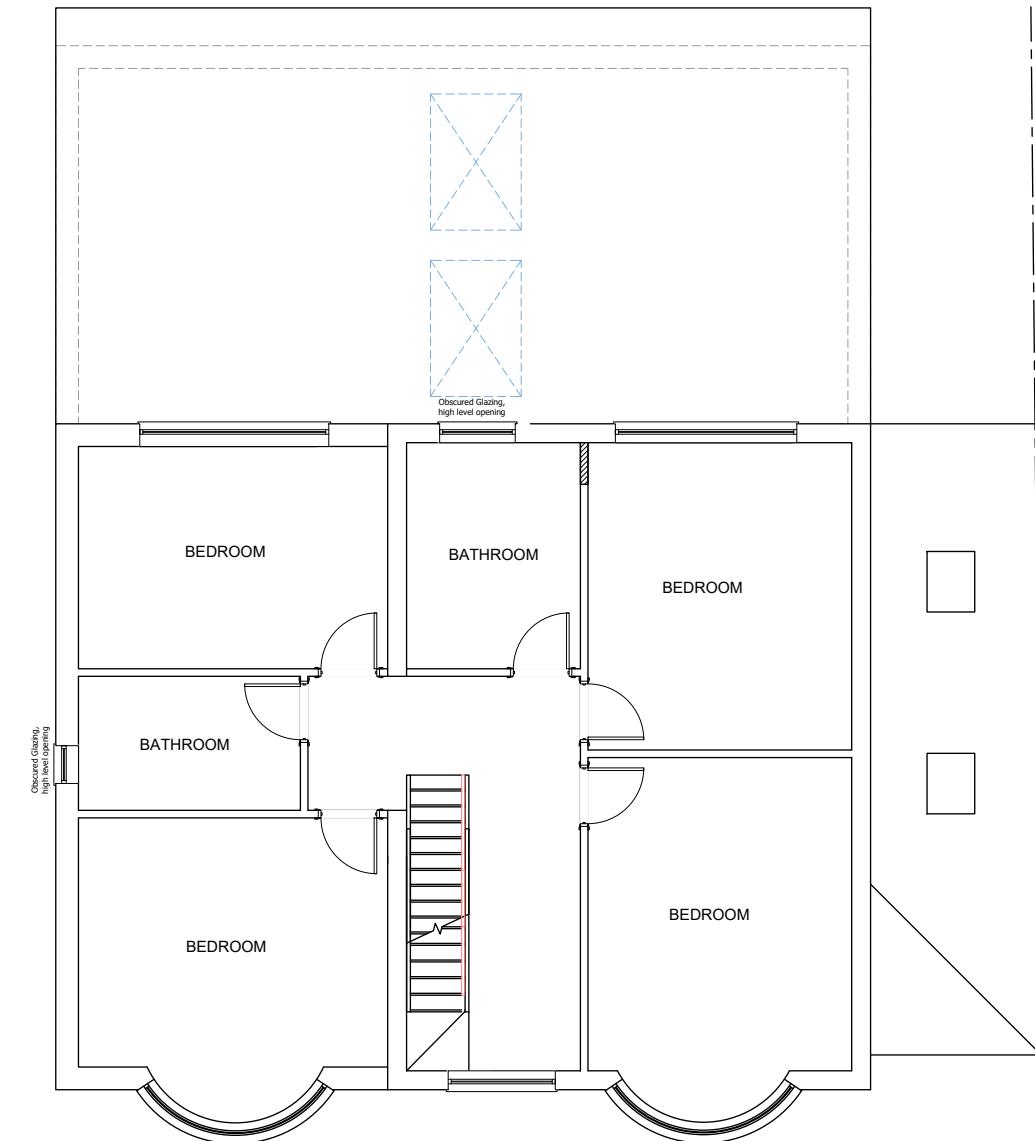

FIRST FLOOR PLAN
(SHOWING EXT ROOF PLAN)

PROJECT. Multiple extensions

ADDRESS. 4 Belmont Close Uxbridge UB8 1RF

DRAWING. As Built GA

REV. SCALE.1/100

PAGE. 03

DATE. 08/2022

PAPER. A3


Unit 1 Cowley Mill Trading Estate
Longbridge Way, Uxbridge
UB8 2YG

T +44 (0) 7973 663 706


E info@blueprintvista.co.uk

W www.blueprintvista.co.uk

As Built Plans

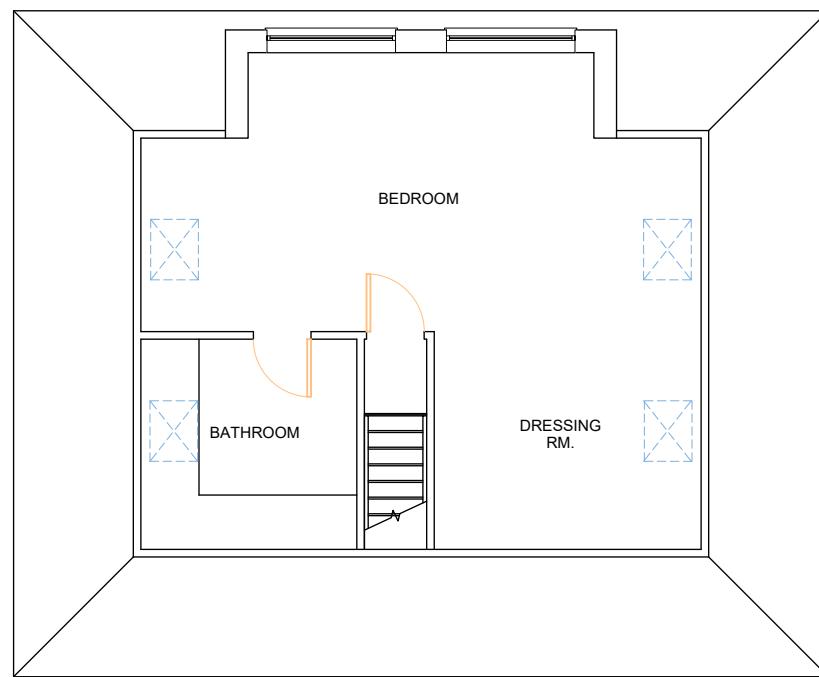

SECOND FLOOR PLAN

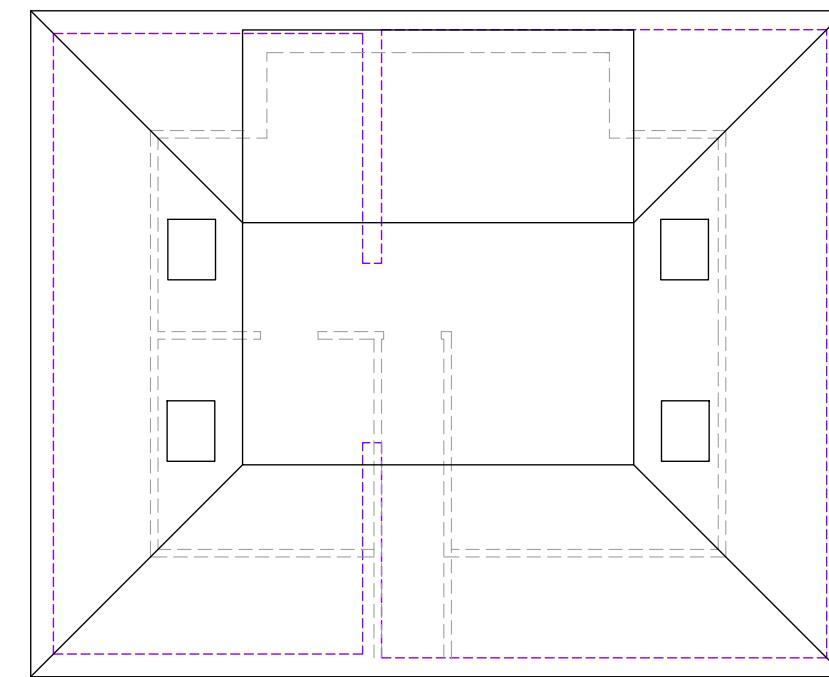

ROOF PLAN

PROJECT. Multiple extensions

ADDRESS. 4 Belmont Close Uxbridge UB8 1RF

DRAWING. As Built GA 2

REV. SCALE.1/100

PAGE. 03a

DATE. 08/2022

PAPER. A3

Unit 1 Cowley Mill Trading Estate
Longbridge Way, Uxbridge
UB8 2YG

T +44 (0) 7973 663 706

E info@blueprintvista.co.uk

W www.blueprintvista.co.uk

Do not scale from drawing (apart from the planning department). All dimensions/levels must be checked on site by a contractor/third party prior to commencement. Any discrepancies must be reported to us in writing before proceeding. All works are copyright protected and must not be copied or transmitted without our prior written permission. Copyright infringements shall be legally enforced and pursued. Works should not commence before a Planning/Building Control approval is received. Client bears full responsibility for any resulting alterations due to commencement of works prior to an approval.

1/100 2m 4m
1/200 4m 8m
1/500 10m 20m


Date	Rev.	Details
-	-	-

**BLUEPRINT
VISTA +
ARCHITECTURE**

Architecture + Interiors
Planning + Engineering



FRONT ELEVATION

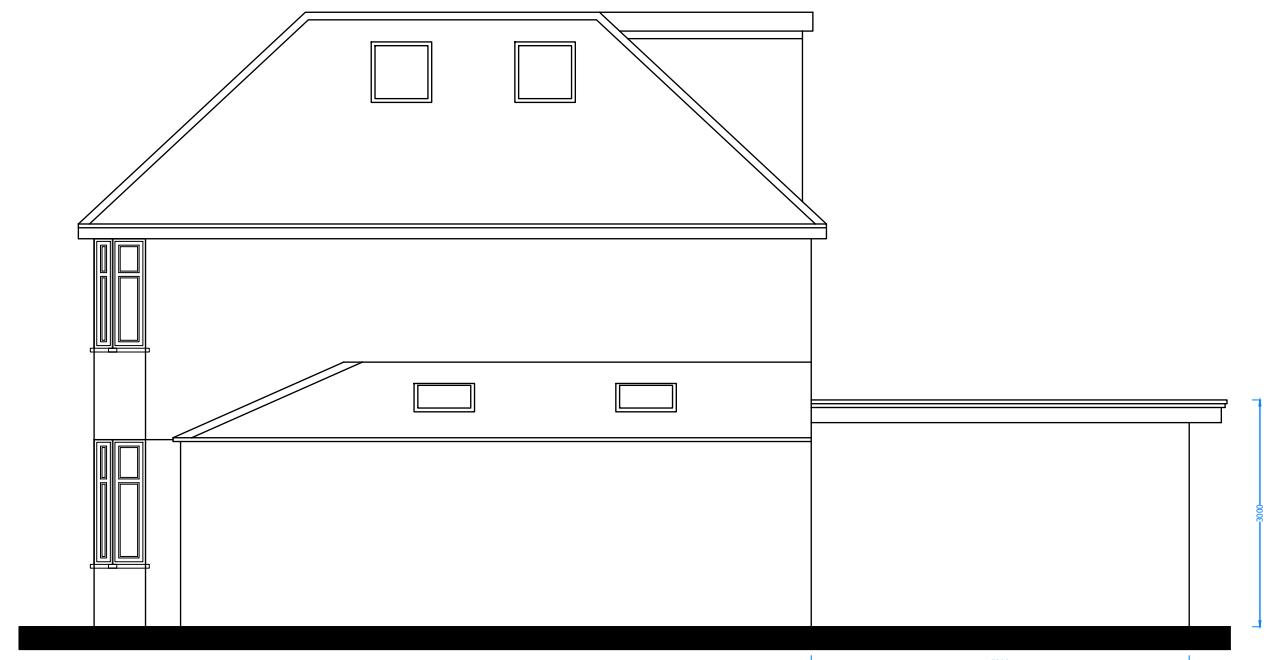


SIDE ELEVATION



REAR ELEVATION

As Built Plans

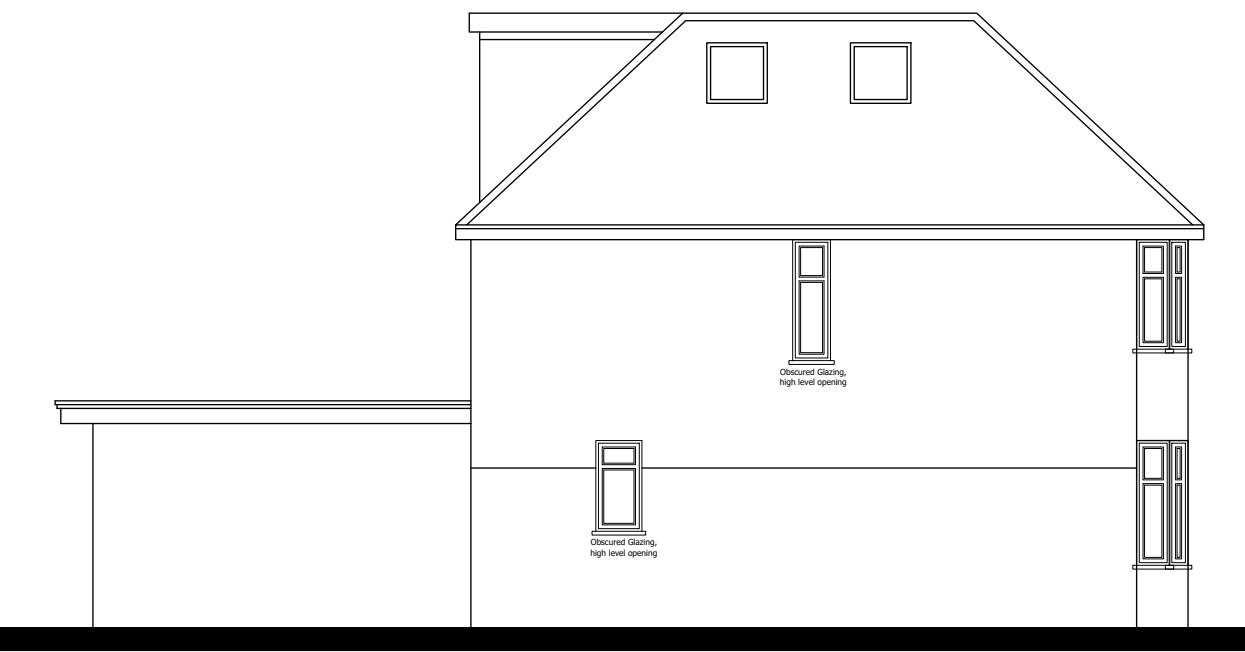

SIDE ELEVATION

PROJECT. Multiple extensions

ADDRESS. 4 Belmont Close Uxbridge UB8 1RF

DRAWING. As Built Elevations

REV. SCALE.1/100

PAGE. 04

DATE. 08/2022

PAPER. A3

Unit 1 Cowley Mill Trading Estate
Longbridge Way, Uxbridge
UB8 2YG

T +44 (0) 7973 663 706

E info@blueprintvista.co.uk


W www.blueprintvista.co.uk

1/100 2m 4m
1/200 4m 8m
1/500 10m 20m

Date Rev. Details

BLUEPRINT
VISTA +
ARCHITECTURE

Architecture + Interiors
Planning + Engineering

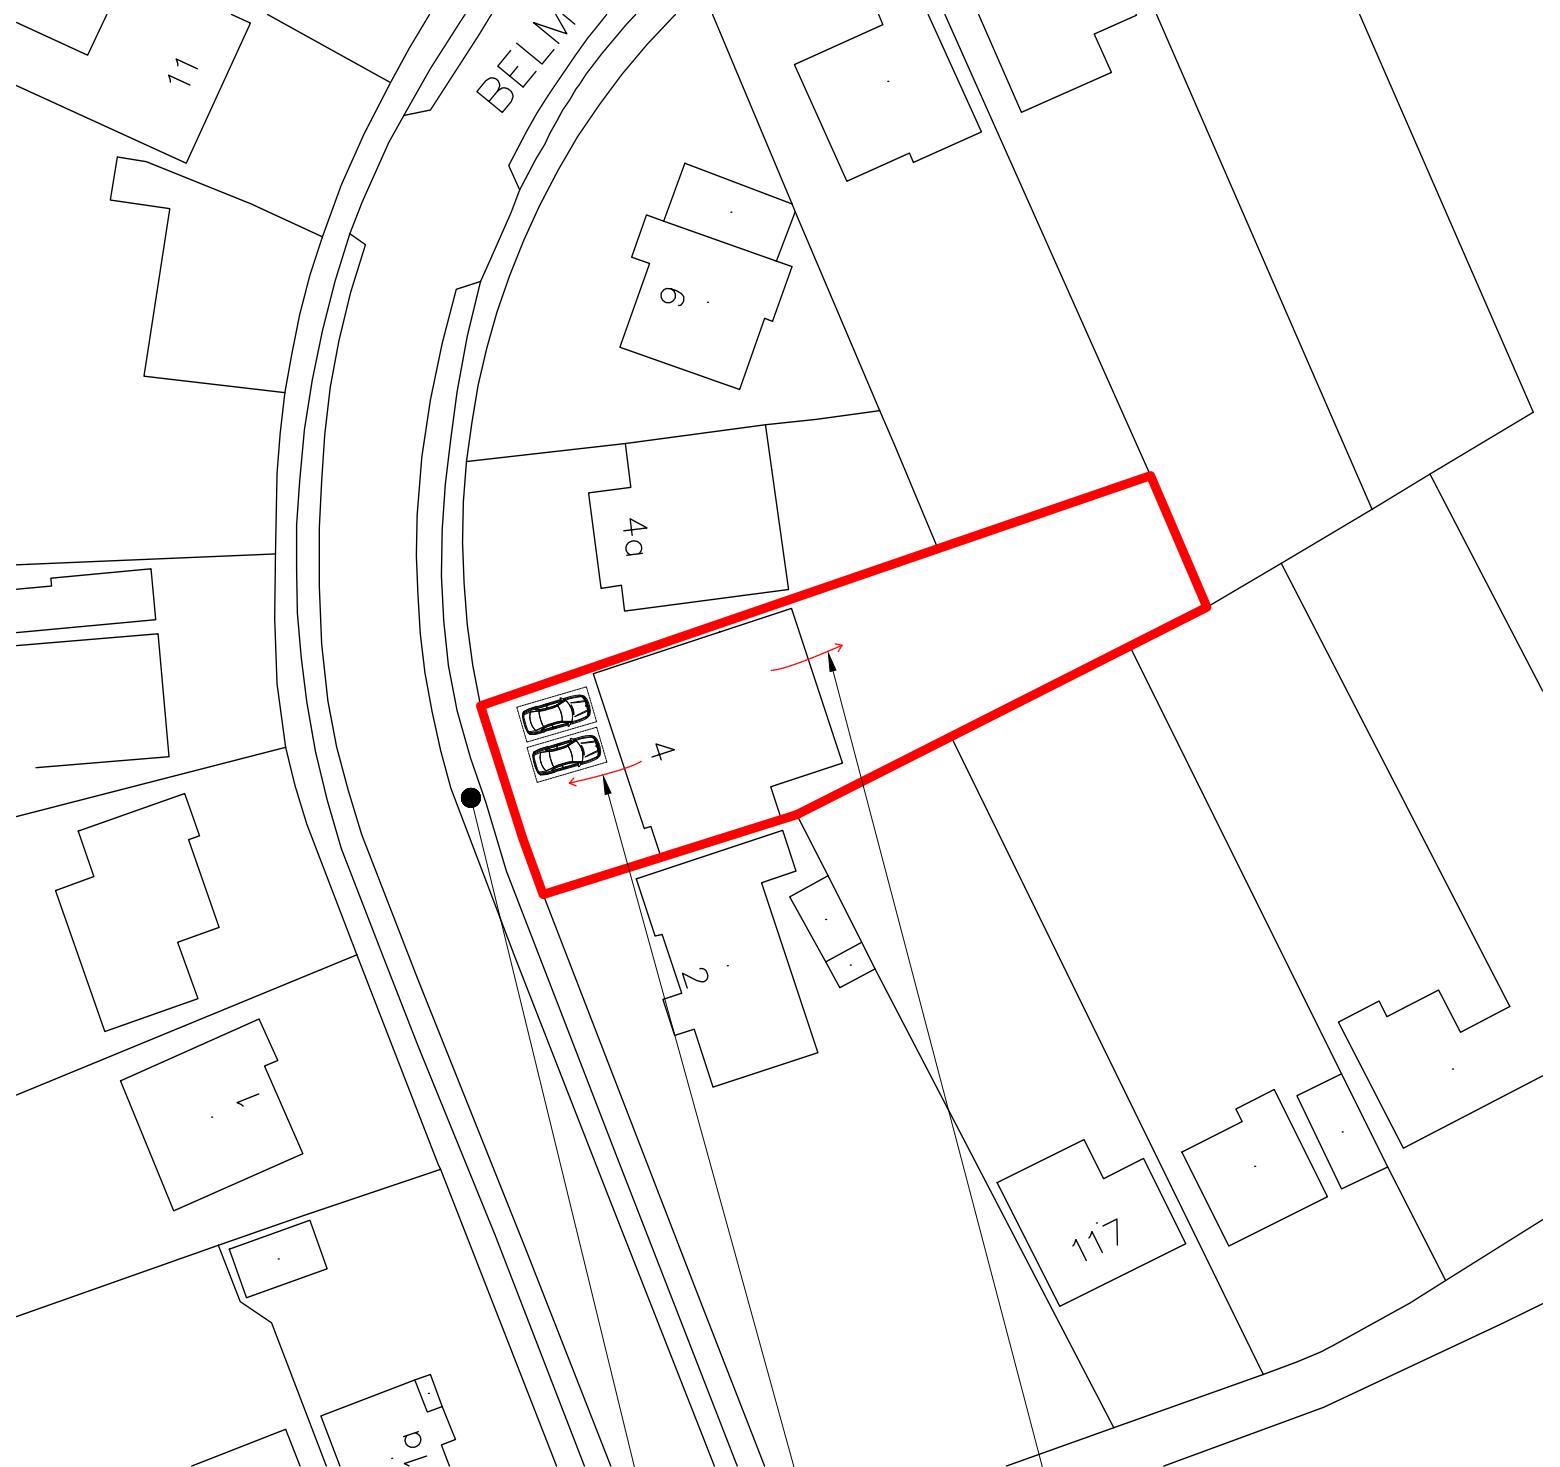

Proposed Site Plan

1:500

Assembly point

Primary escape route leading to assembly point.

Indicating multiple secondary escape route (if/when required) leading to both the rear garden and the assembly point to the front.

