

Amendments/Notes			
Rev.	Detail	By	Date
A	Amends as per sketch & extension	SA	26.03.21
B	Layouts amends for planning	SA	06.04.21
C	Internal alterations	SL	11.01.22
D	Obscure glazed E/S flankwindow FFL	SL	14.01.22
E	Omit flank windows GFL, FFL bathrooms	SL	29.03.22

NOTE:
Grey Dash As Demolished
Red line as Proposed

All dimensions and levels to be checked on site by contractor prior to preparation of shop drawings and commencement of work on site. Dimensions MUST NOT be scaled from this drawing.
This drawing and the copyrights and patents therein are the property of the Architect and may not be used or reproduced without consent.
This drawing is to be read in conjunction with all relevant consultants and/or specialist's drawings/documents and any discrepancies or variations are to be notified to the Architect before the affected work commences.
All works on site are to be carried out fully in accordance with current CDM regulations and recommendations, current Building Regulations, British Standards and Codes of Practice as appropriate.

Project
**3 MAYCROFT
PINNER
HA5 3UB**

Drawing
**PROPOSED
ELEVATIONS**

**SEABROOK
ARCHITECTS**
CHARTERED ARCHITECTS
Link House, St. Marys Way, Chesham, Bucks HP5 1HR
Tel: 01494 778918 e-mail: info@seabrookarchitects.co.uk

Drawn By	SA	Date	01.03.21
Checked By	JS	Date	27.04.21
Approved By		Scale	1:50@ A1

Drawing No. 5809/EL002 Rev. E

Ridge Level (Assumed) ▾


1F Ceiling ▾

1F Level ▾

GF Level ▾



PROPOSED FRONT ELEVATION

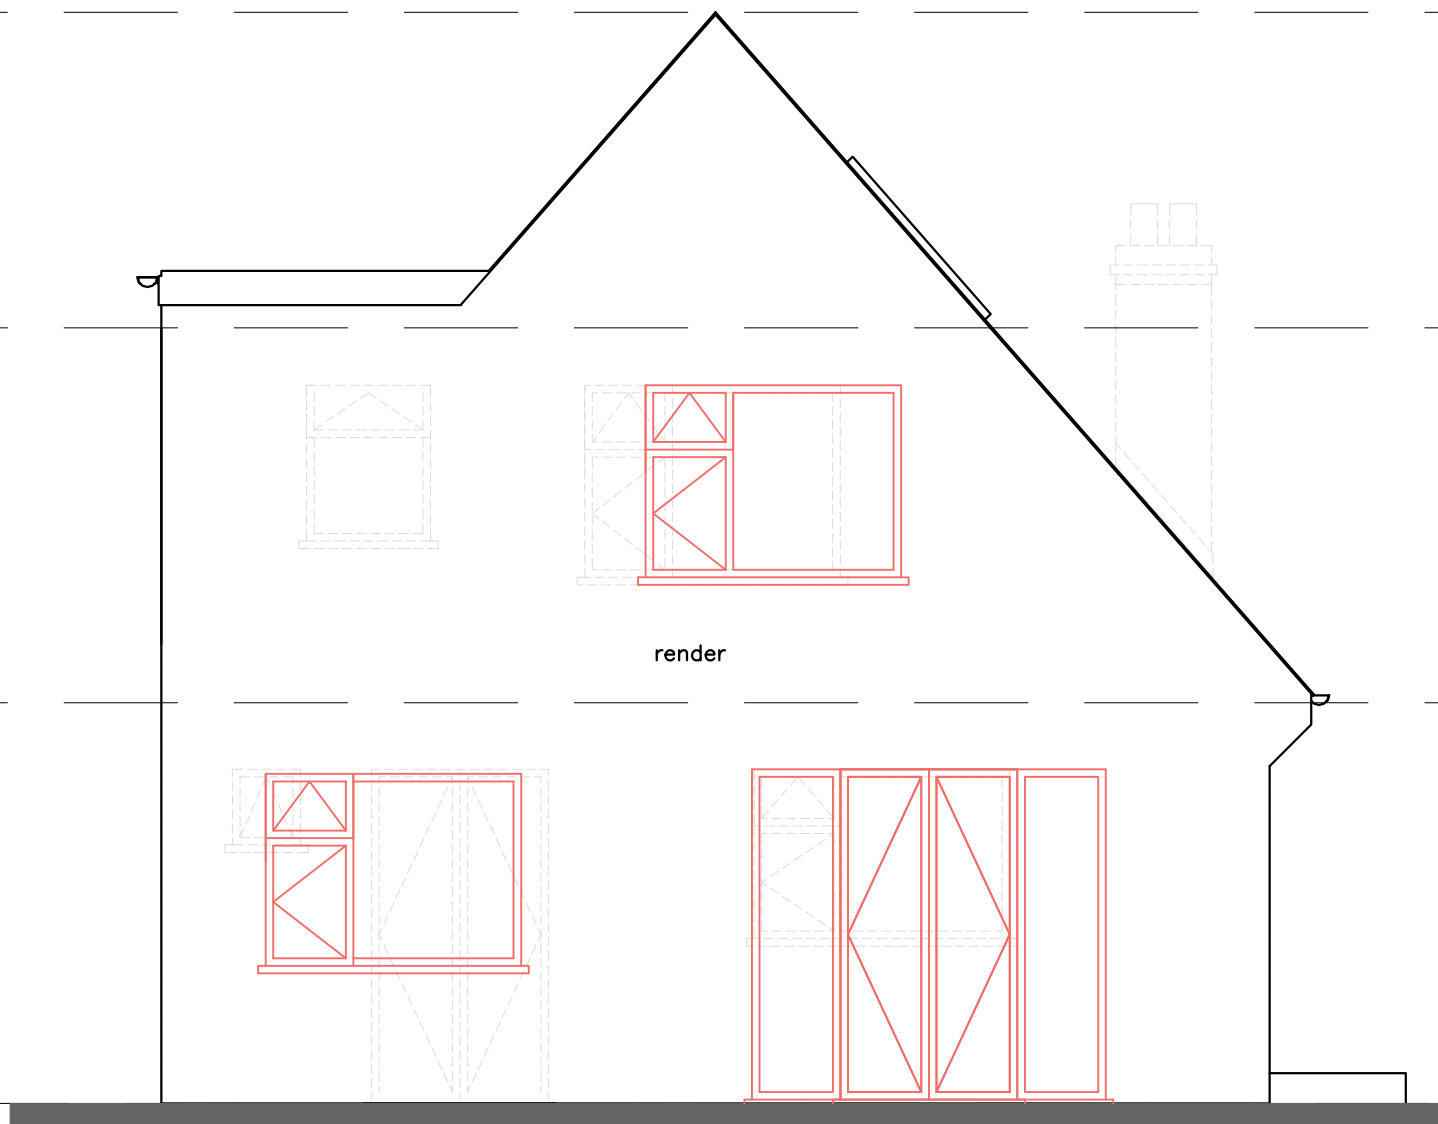


PROPOSED REAR ELEVATION

Ridge Level (Assumed) ▾


1F Ceiling ▾

1F Level ▾

GF Level ▾

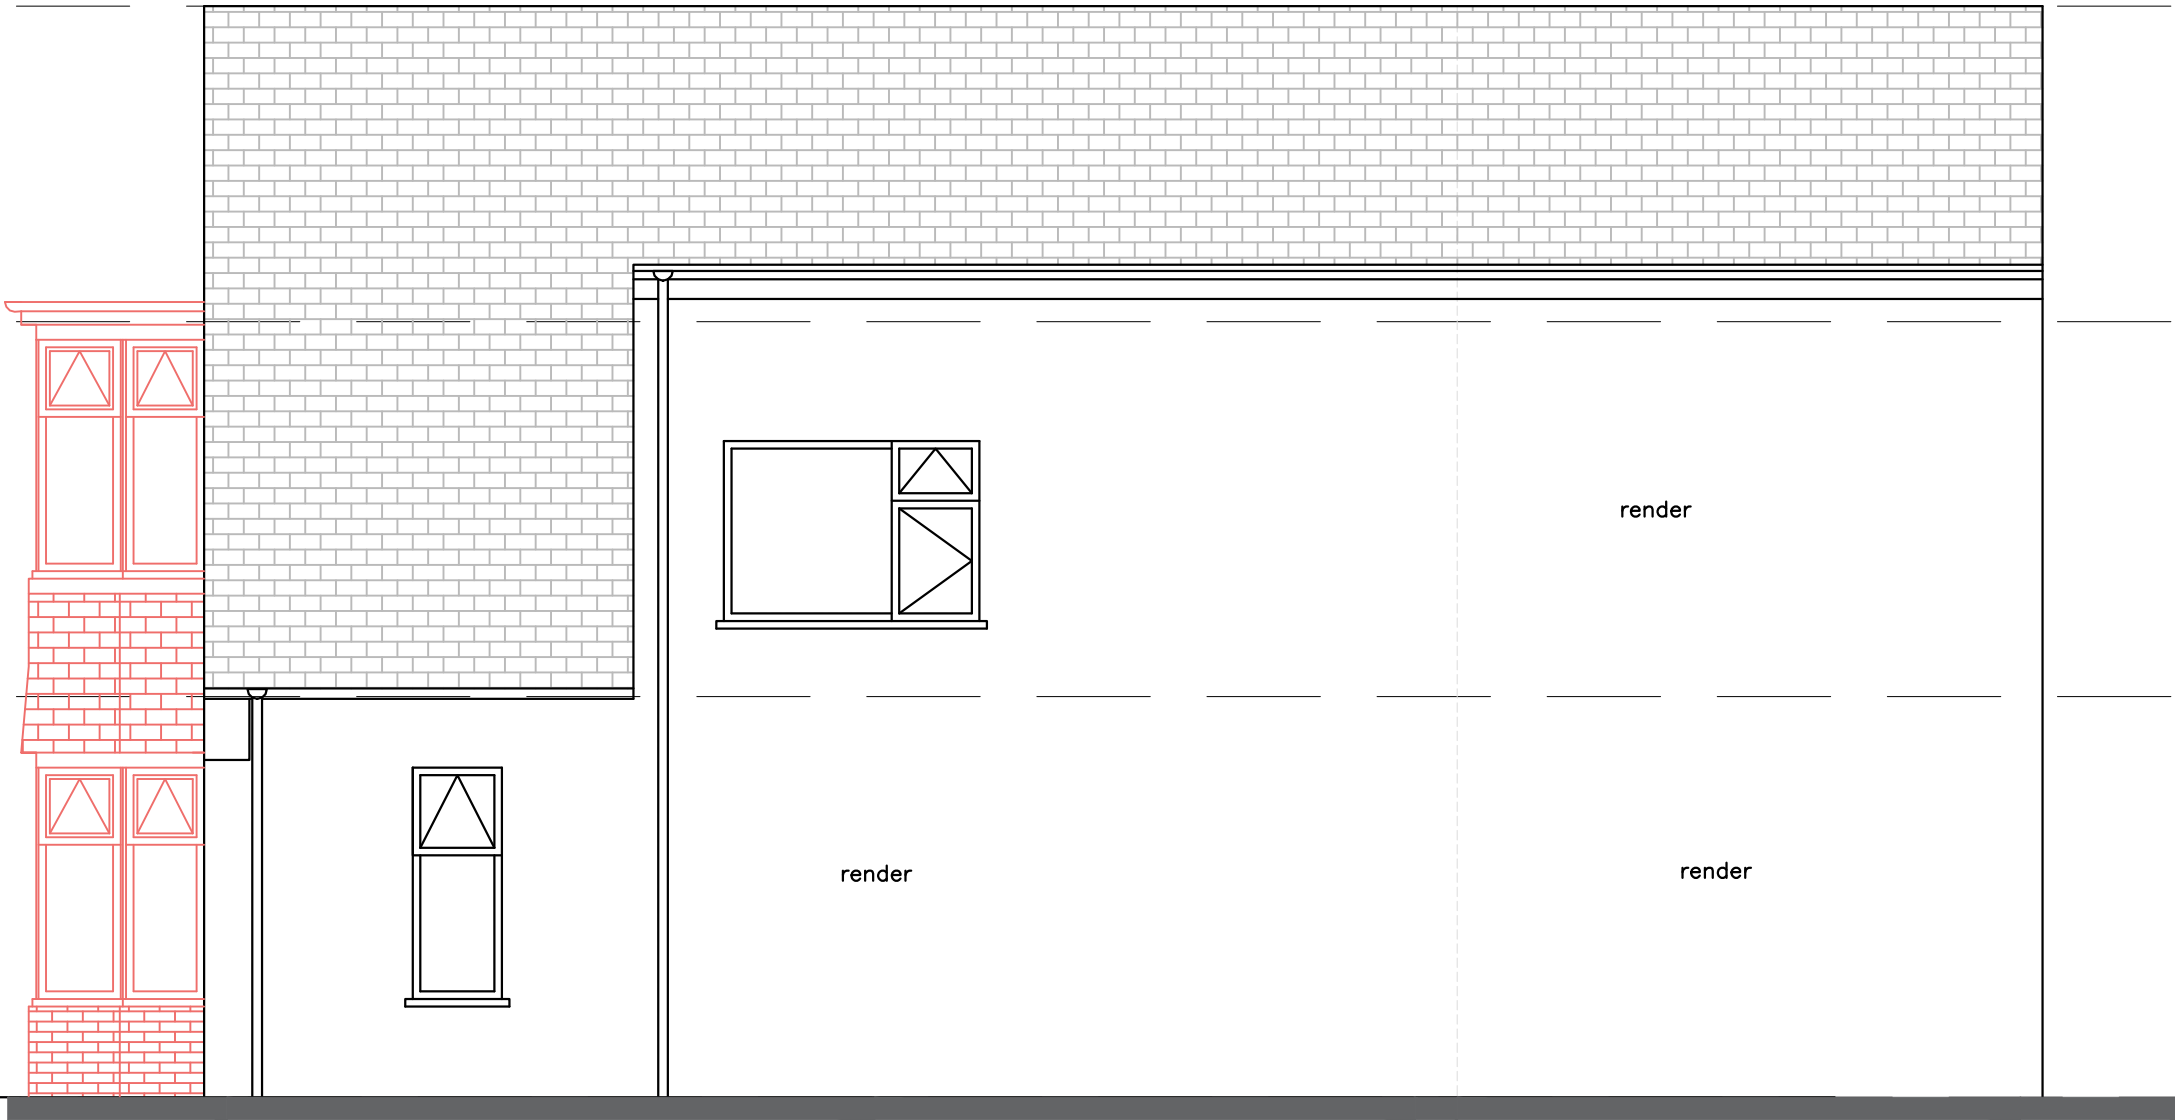

RIGHT FLANK ELEVATION

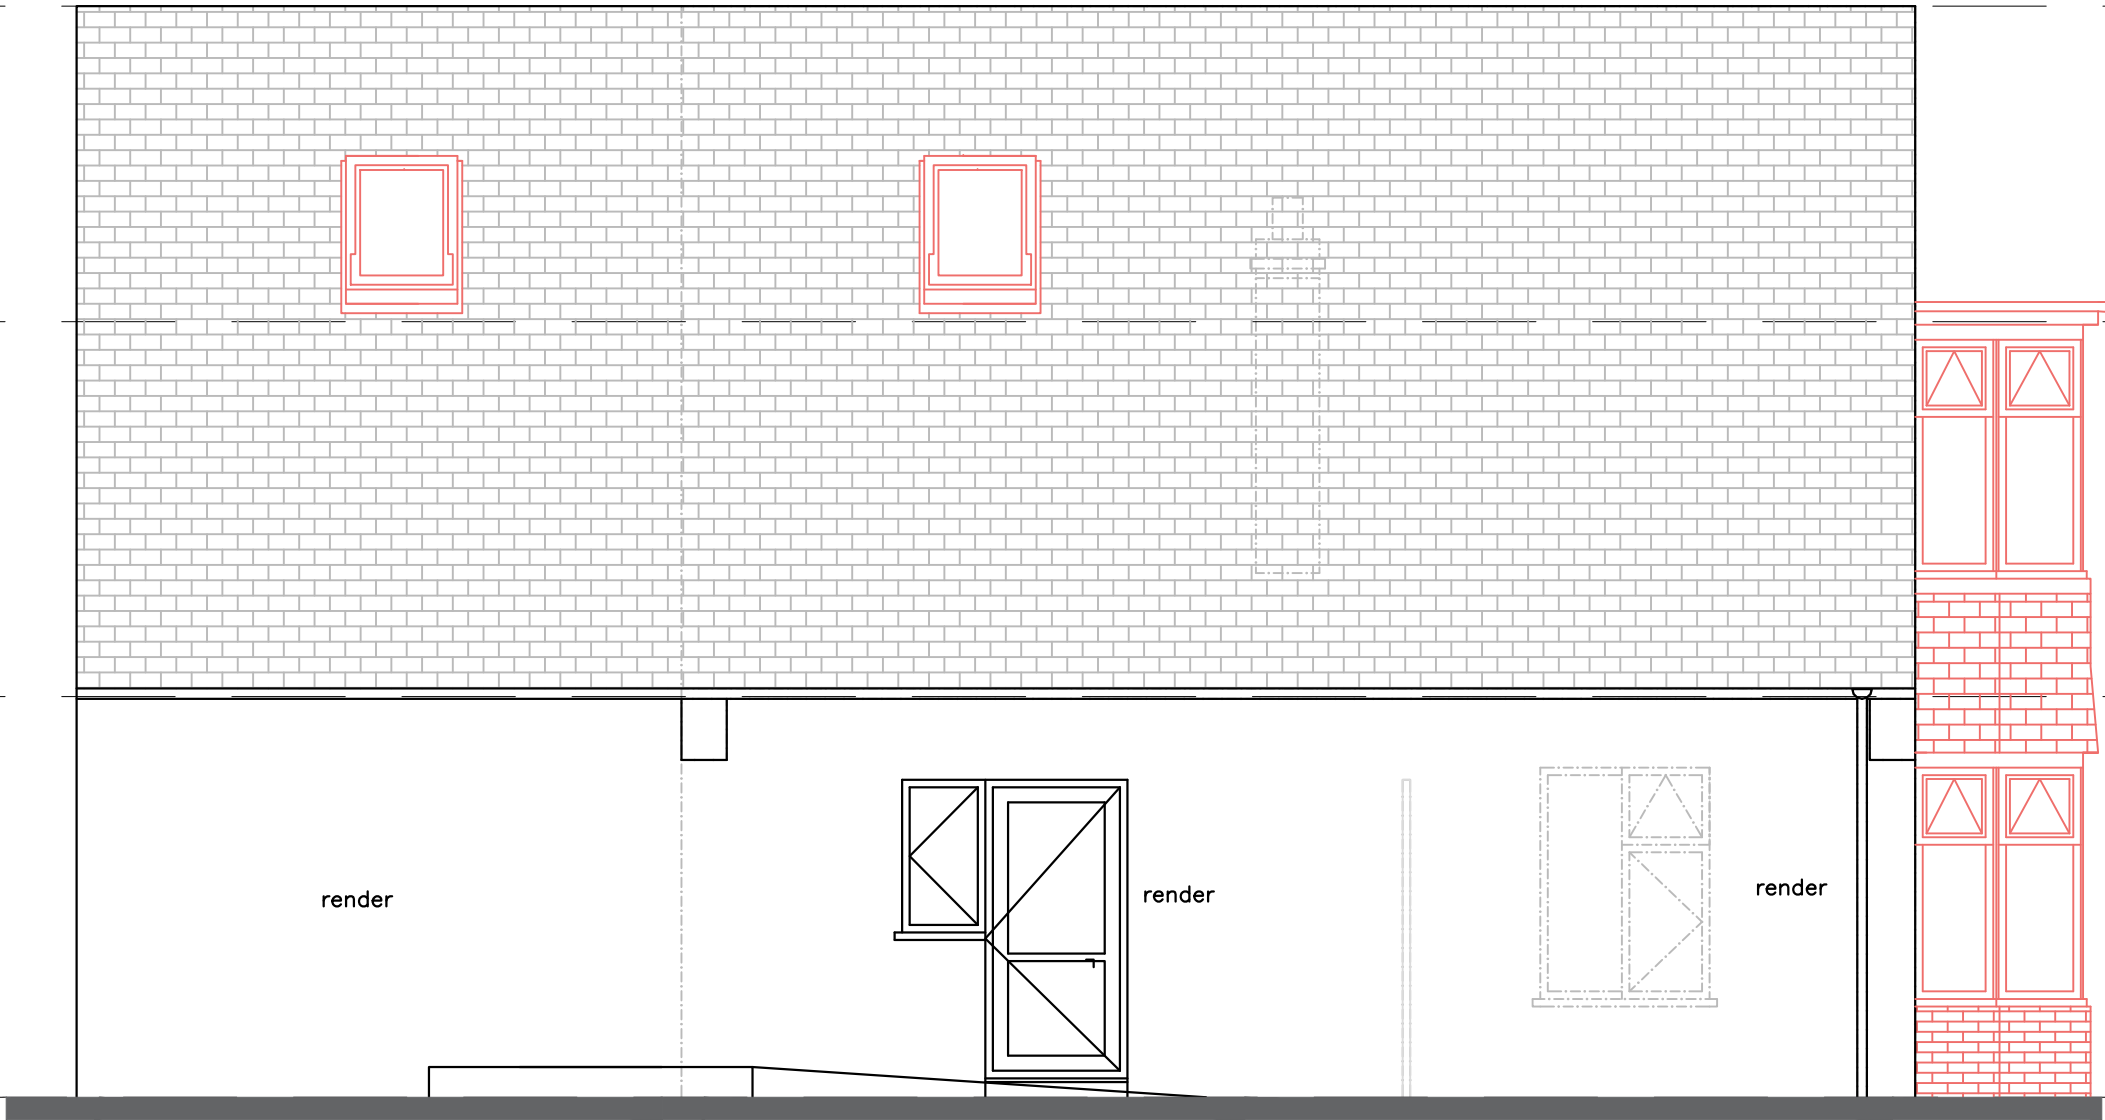

LEFT FLANK ELEVATION

0 Scale 1:50 5m