




AS MODIFIED GROUND FLOOR PLAN

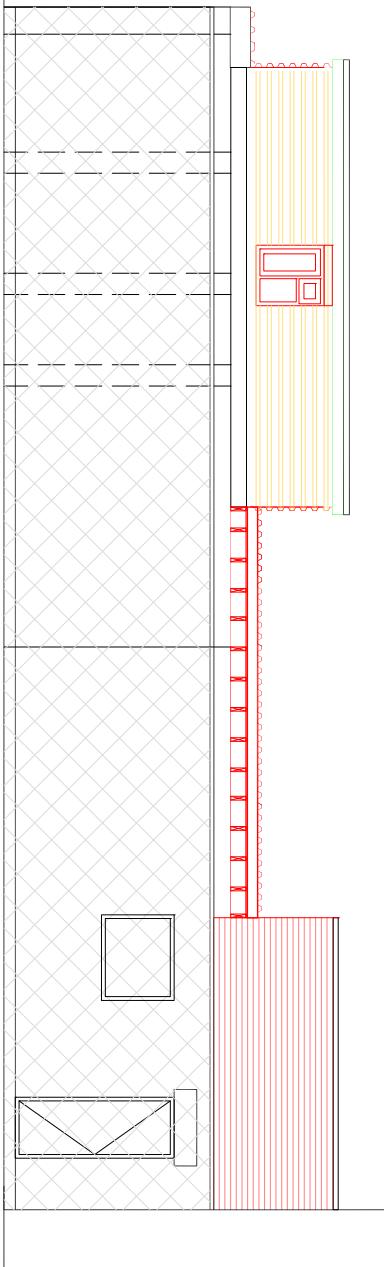


AS MODIFIED SIDE ELEVATION VIEWED FROM SIDE ACCESS

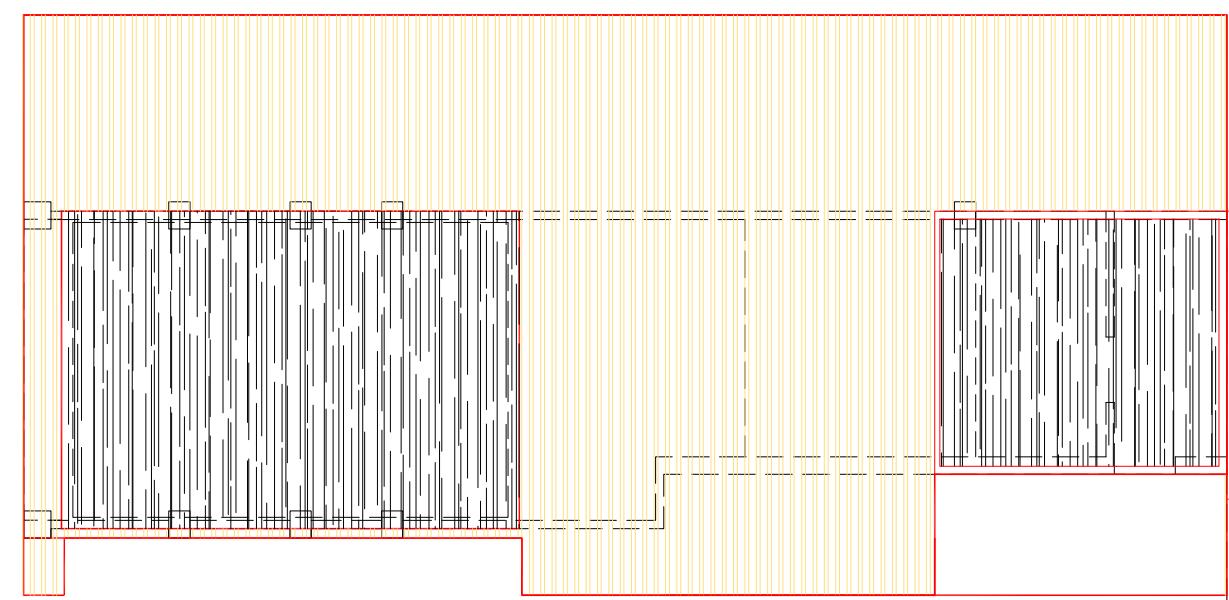

AS MODIFIED ROOF PLAN

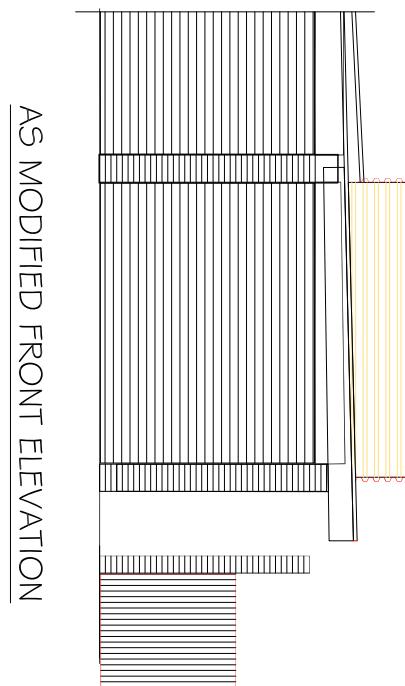

AS MODIFIED FRONT ELEVATION

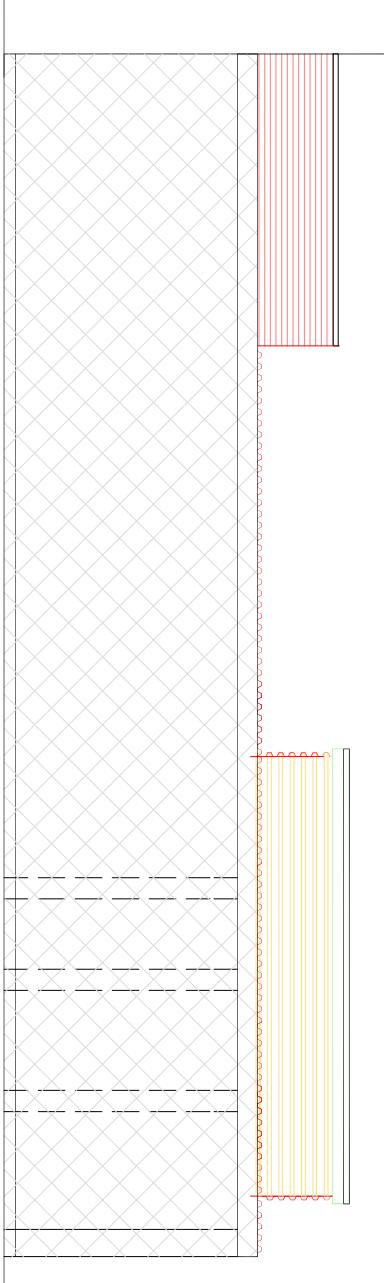

AS MODIFIED SIDE ELEVATION VIEWED FROM NO 163

HAR - GUNN Associates Ltd	
Tel : 020 917 9296	Email: hargunn@aol.com
Mob. 07803 619161	
Rev	Revision Note

This drawing remains the property of HAR - Gunn Associates and shall not be reproduced or altered without prior written permission.

Drawing Name	Location	Scale (@A3)
Single Storey Garage Roof Top Extension As Built - Unauthorized	Rear of 165 North Hyde Road Hayes UB3 4NS	1 : 100
Dig No	1722 / 2023 / PL-03	Date
		Feb 2023

Do not scale off drawings. Check all dimensions on site and report any discrepancies before commencing work. All figured dimensions are millimeters unless noted otherwise.