





DO NOT SCALE
These drawings and designs are the
copyright of
SEVENCROFT LTD.

Outline of the original boundary wall shown in Red on the Elevations

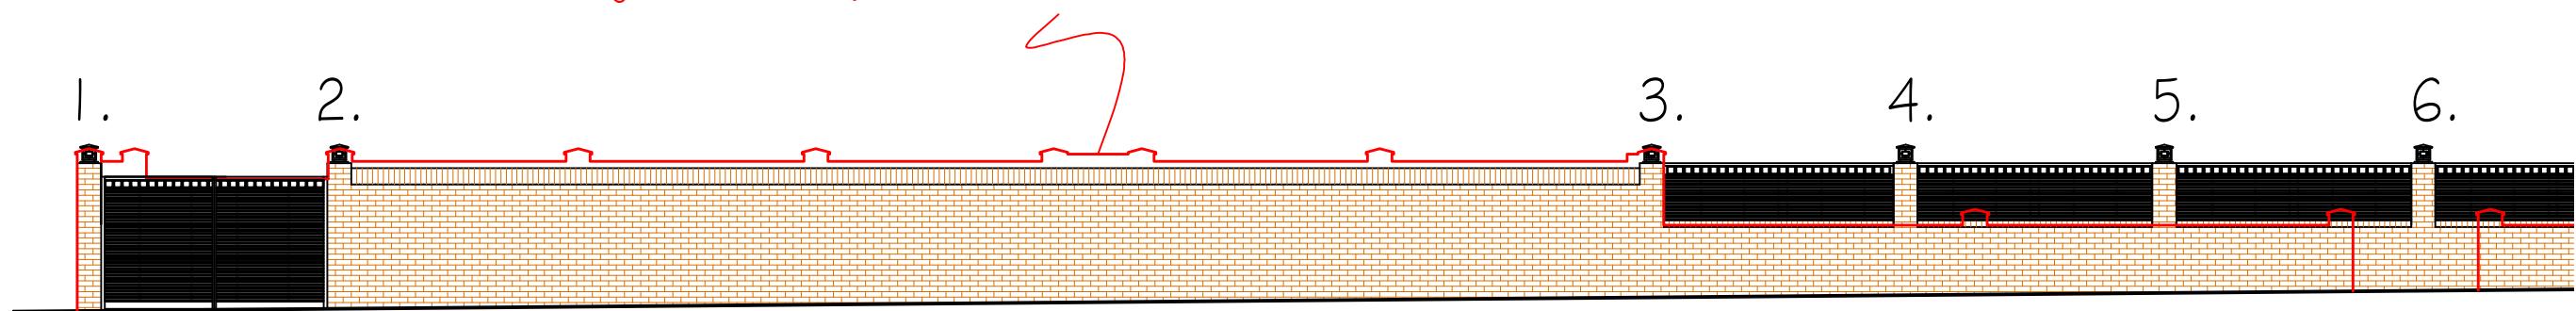

Proposed Boundary Wall Elevation facing Crossway reinstated after the Collapse - Scale 1:100

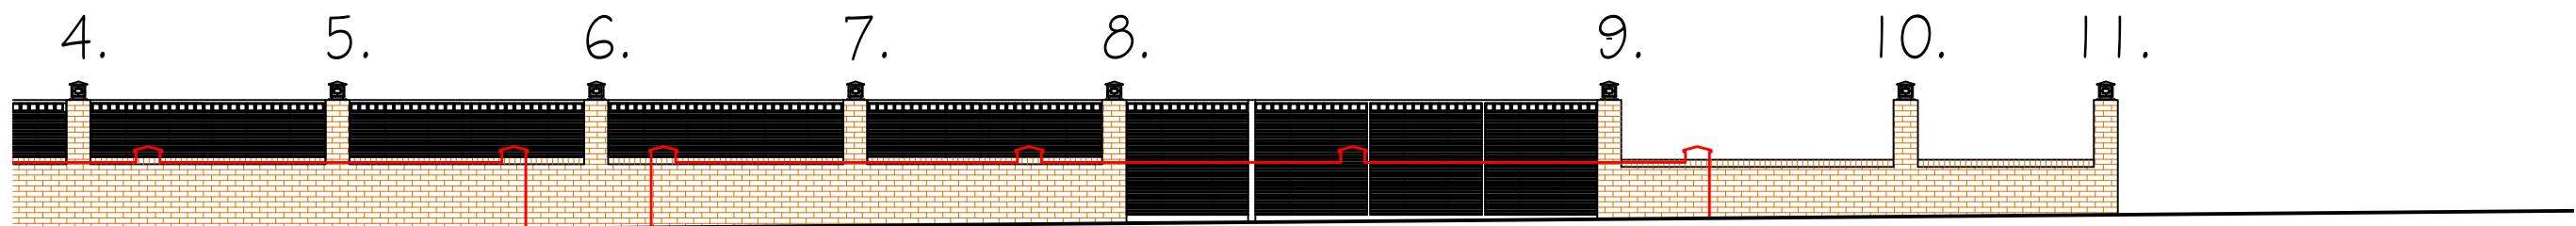

Proposed Boundary Wall Elevation facing The Croft reinstated after the Collapse - Scale 1:100

Proposed Boundary Wall Elevations reinstated after the Collapse - Scale 1:100@A3

NOTE: ALL PIERS HAVE BEEN NUMBERED FOR EASE OF CROSS REFERENCING WITH CURVE TAKEN OUT TO GIVE TRUE LENGTH

Proposed Replacement of Existing Boundary Wall which
collapsed at 1 The Croft, Ruislip, Hillingdon, HA4 0SF

Date Dec 2023

Drawing No. 2023/42/05

CORPORATE ARCHITECTURE
& DESIGN GROUP



SEVENCROFT LTD.

277 Canterbury Road, Kennington
Ashford, Kent TN24 9QW
Tel: 01233 625553
e-mail : sevencroft@hotmail.co.uk