





DO NOT SCALE  
These drawings and designs are the  
copyright of  
**SEVENCROFT LTD.**

Outline of the original boundary wall shown in Red on the Elevations

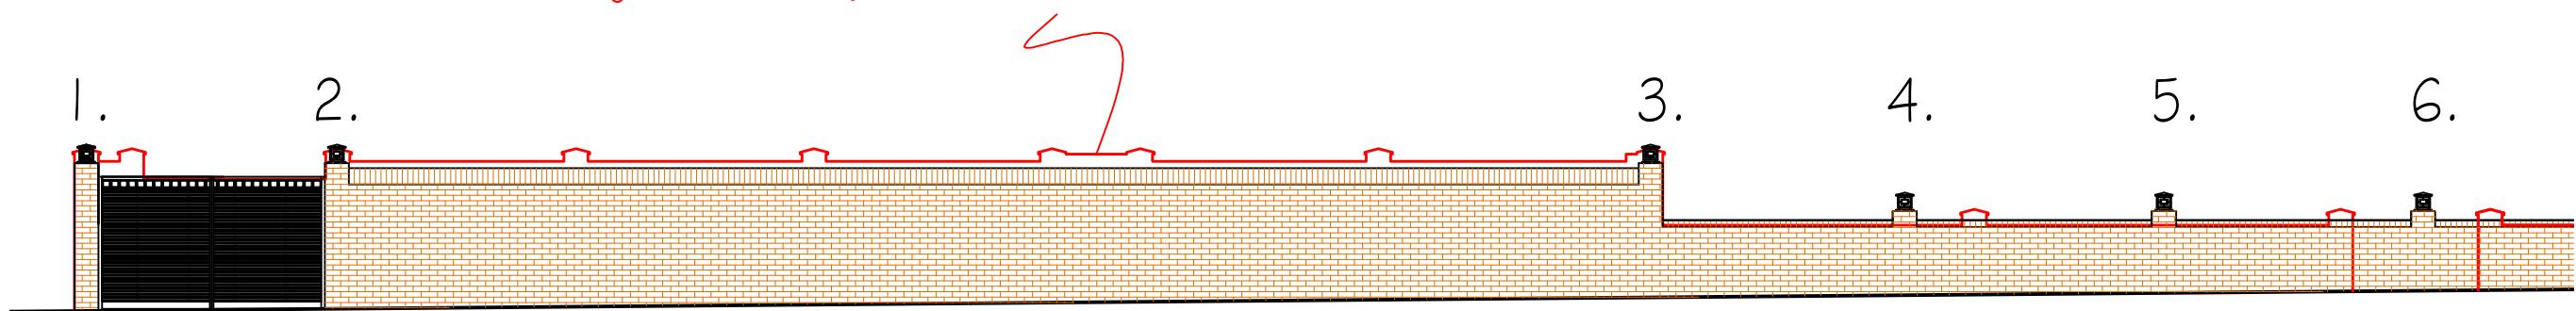

Proposed Boundary Wall Elevation facing Crossway reinstated after the Collapse - Scale 1:100

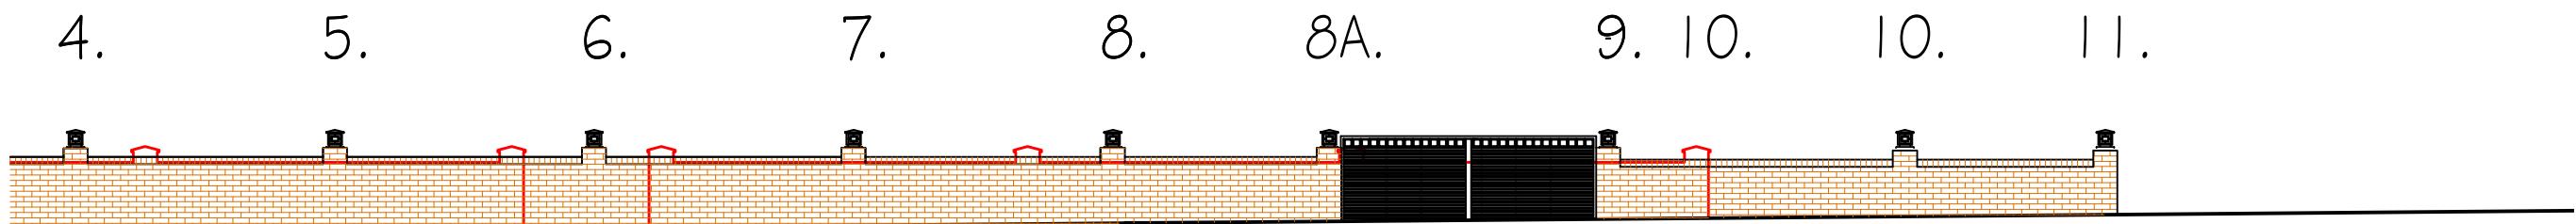

Proposed Boundary Wall Elevation facing The Croft reinstated after the Collapse - Scale 1:100

Proposed Boundary Wall Elevations reinstated after the Collapse - Scale 1:100@A3

NOTE: ALL PIERS HAVE BEEN NUMBERED FOR EASE OF CROSS REFERENCING WITH CURVE TAKEN OUT TO GIVE TRUE LENGTH

Proposed Replacement of Existing Boundary Wall which  
collapsed at 1 The Croft, Ruislip, Hillingdon, HA4 0SF

Date Dec 2023

Rev B - 29/02/24 - Vehicular opening reduced in width as requested by Planning Officer  
Rev A 22/02/24 - Amended to Email from Planner dated 09/02/24  
Drawing No. 2023/42/05B

CORPORATE ARCHITECTURE  
& DESIGN GROUP



SEVENCROFT LTD.

277 Canterbury Road, Kent TN24 9QW  
Tel: 01233 625553  
e-mail : seavencroft@hotmail.co.uk