



10m 5m 0m 5m 10m

FOR PLANNING PURPOSES ONLY
These drawings and designs are
the copyright of
SEVCROFT LTD.

Outline of the original boundary wall shown in Red on the Elevations

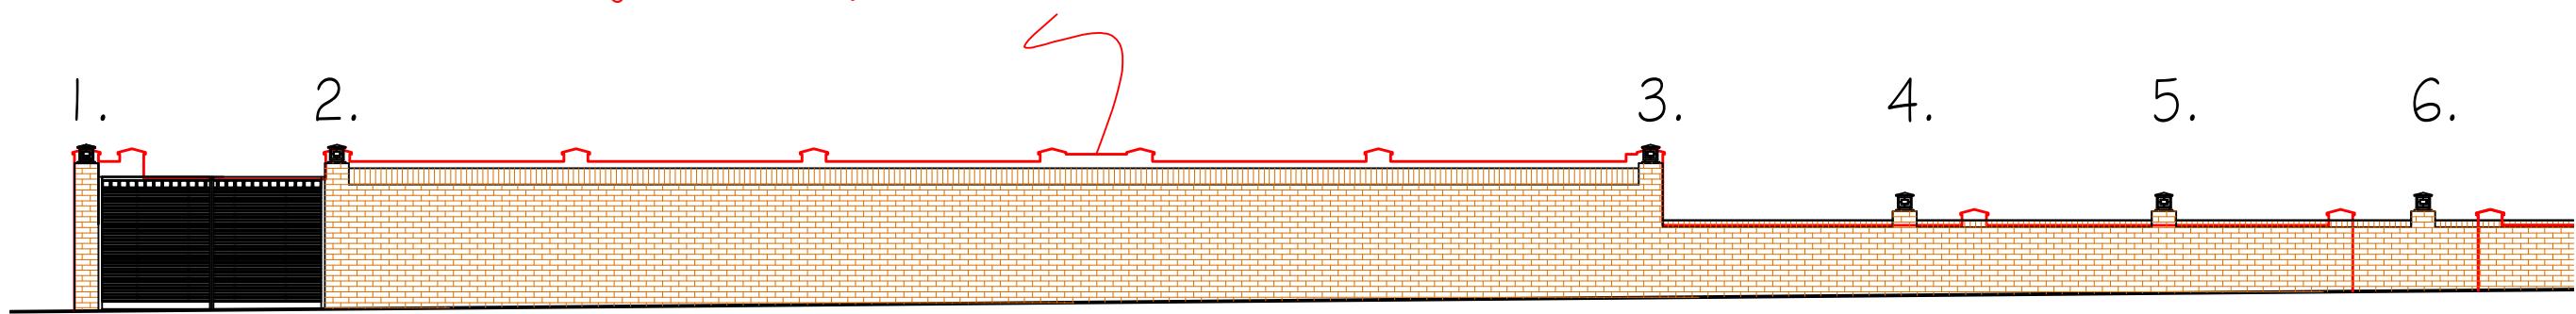

Proposed Boundary Wall Elevation facing Crossway reinstated after the Collapse - Scale 1:100

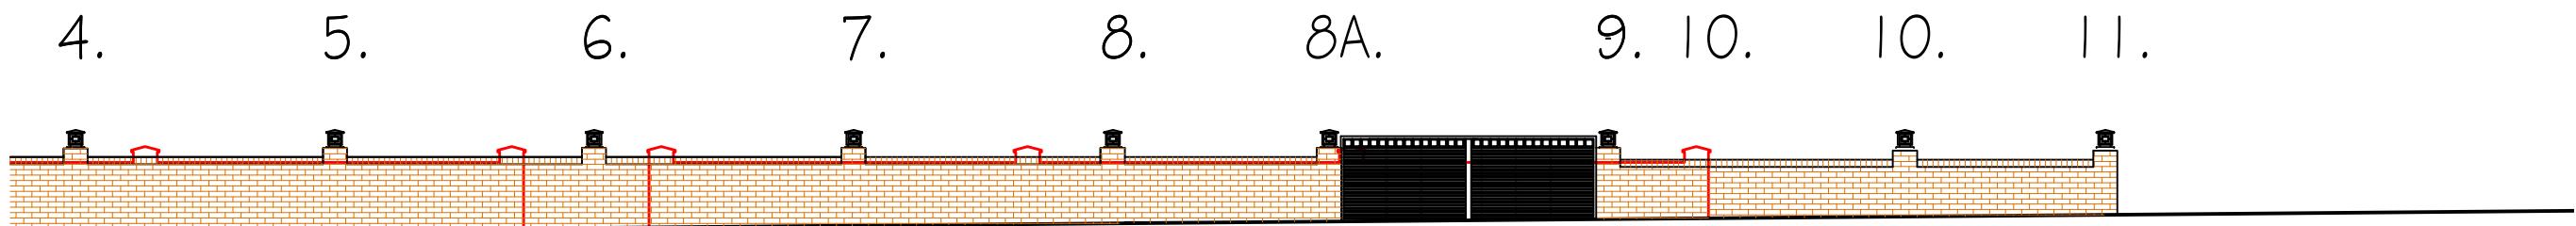

Proposed Boundary Wall Elevation facing The Croft reinstated after the Collapse - Scale 1:100

Proposed Boundary Wall Plan reinstated after the Collapse - Details Approved under
Application ref. 629/APP/2023/3636 - Scale 1:100@A3

NOTE: ALL PIERS HAVE BEEN NUMBERED FOR EASE OF CROSS REFERENCING

Proposed Raising of Piers 4 - 11 & infilling with open grills along with installation
of sliding security gates at 1 The Croft, Ruislip, Hillingdon, HA4 0SF

Date April 2024

Drawing No. 2024/09/02

CORPORATE ARCHITECTURE
& DESIGN GROUP



SEVCROFT LTD.

277 Canterbury Road, Kennington
Ashford, Kent TN24 9QW
Tel: 01233 625553
e-mail : sevcroft@hotmail.co.uk