





Outline of the original boundary wall shown in Red on the Elevations

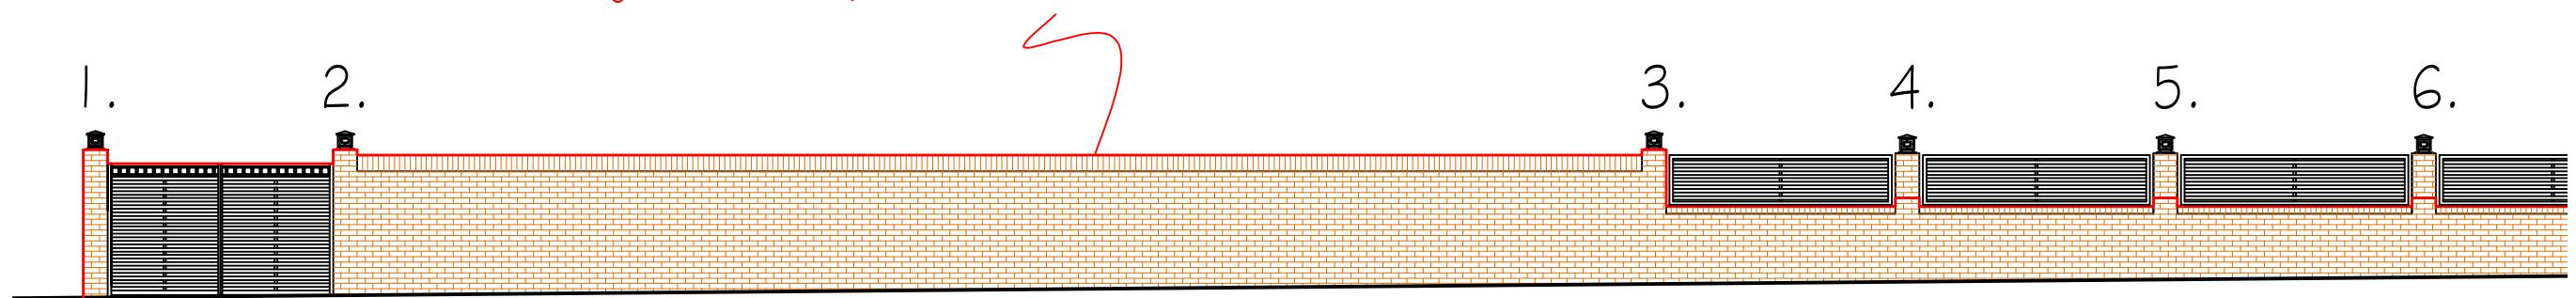

Proposed Boundary Wall Elevation facing Crossway reinstated after the Collapse with Raised Pillars & Open Grill Infill - Scale 1:100

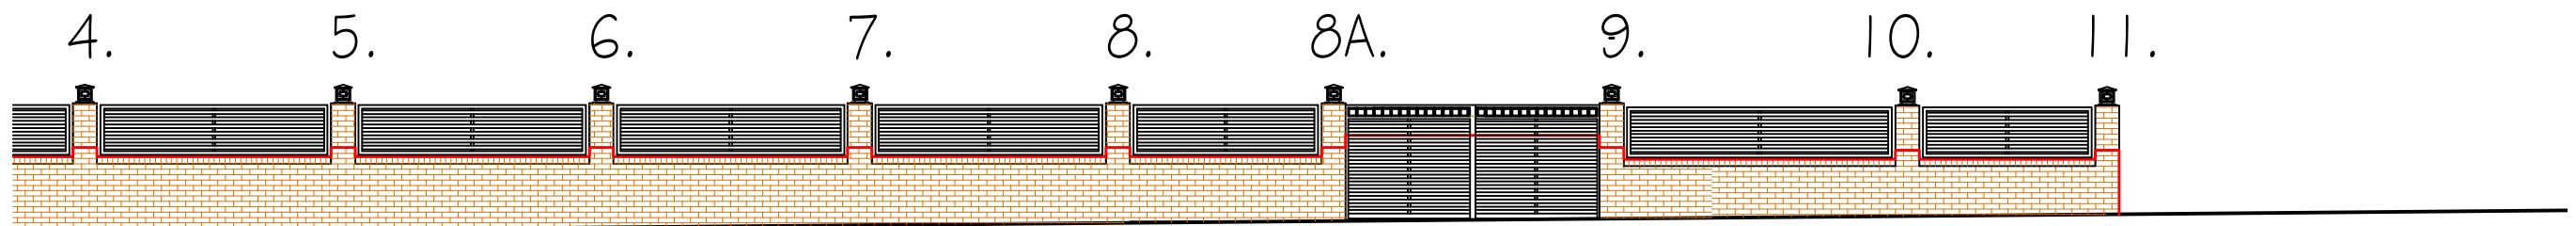

Proposed Boundary Wall Elevation facing Crossway reinstated after the Collapse with Raised Pillars & Open Grill Infill - Scale 1:100

CORPORATE ARCHITECTURE  
 & DESIGN GROUP

Proposed Boundary Wall Elevation facing Crossway reinstated after the Collapse with Raised Pillars & Open Grill Infill - Scale 1:100@A3

NOTE: ALL PIERS HAVE BEEN NUMBERED FOR EASE OF CROSS REFERENCING

Proposed Raising of Piers 4 - 11 by 675mm & infilling with open grills along with  
 installation of sliding security gates at 1 The Croft, Ruislip, Hillingdon, HA4 0SF

Date March 2025  
 Drawing No. 2025/40/04