


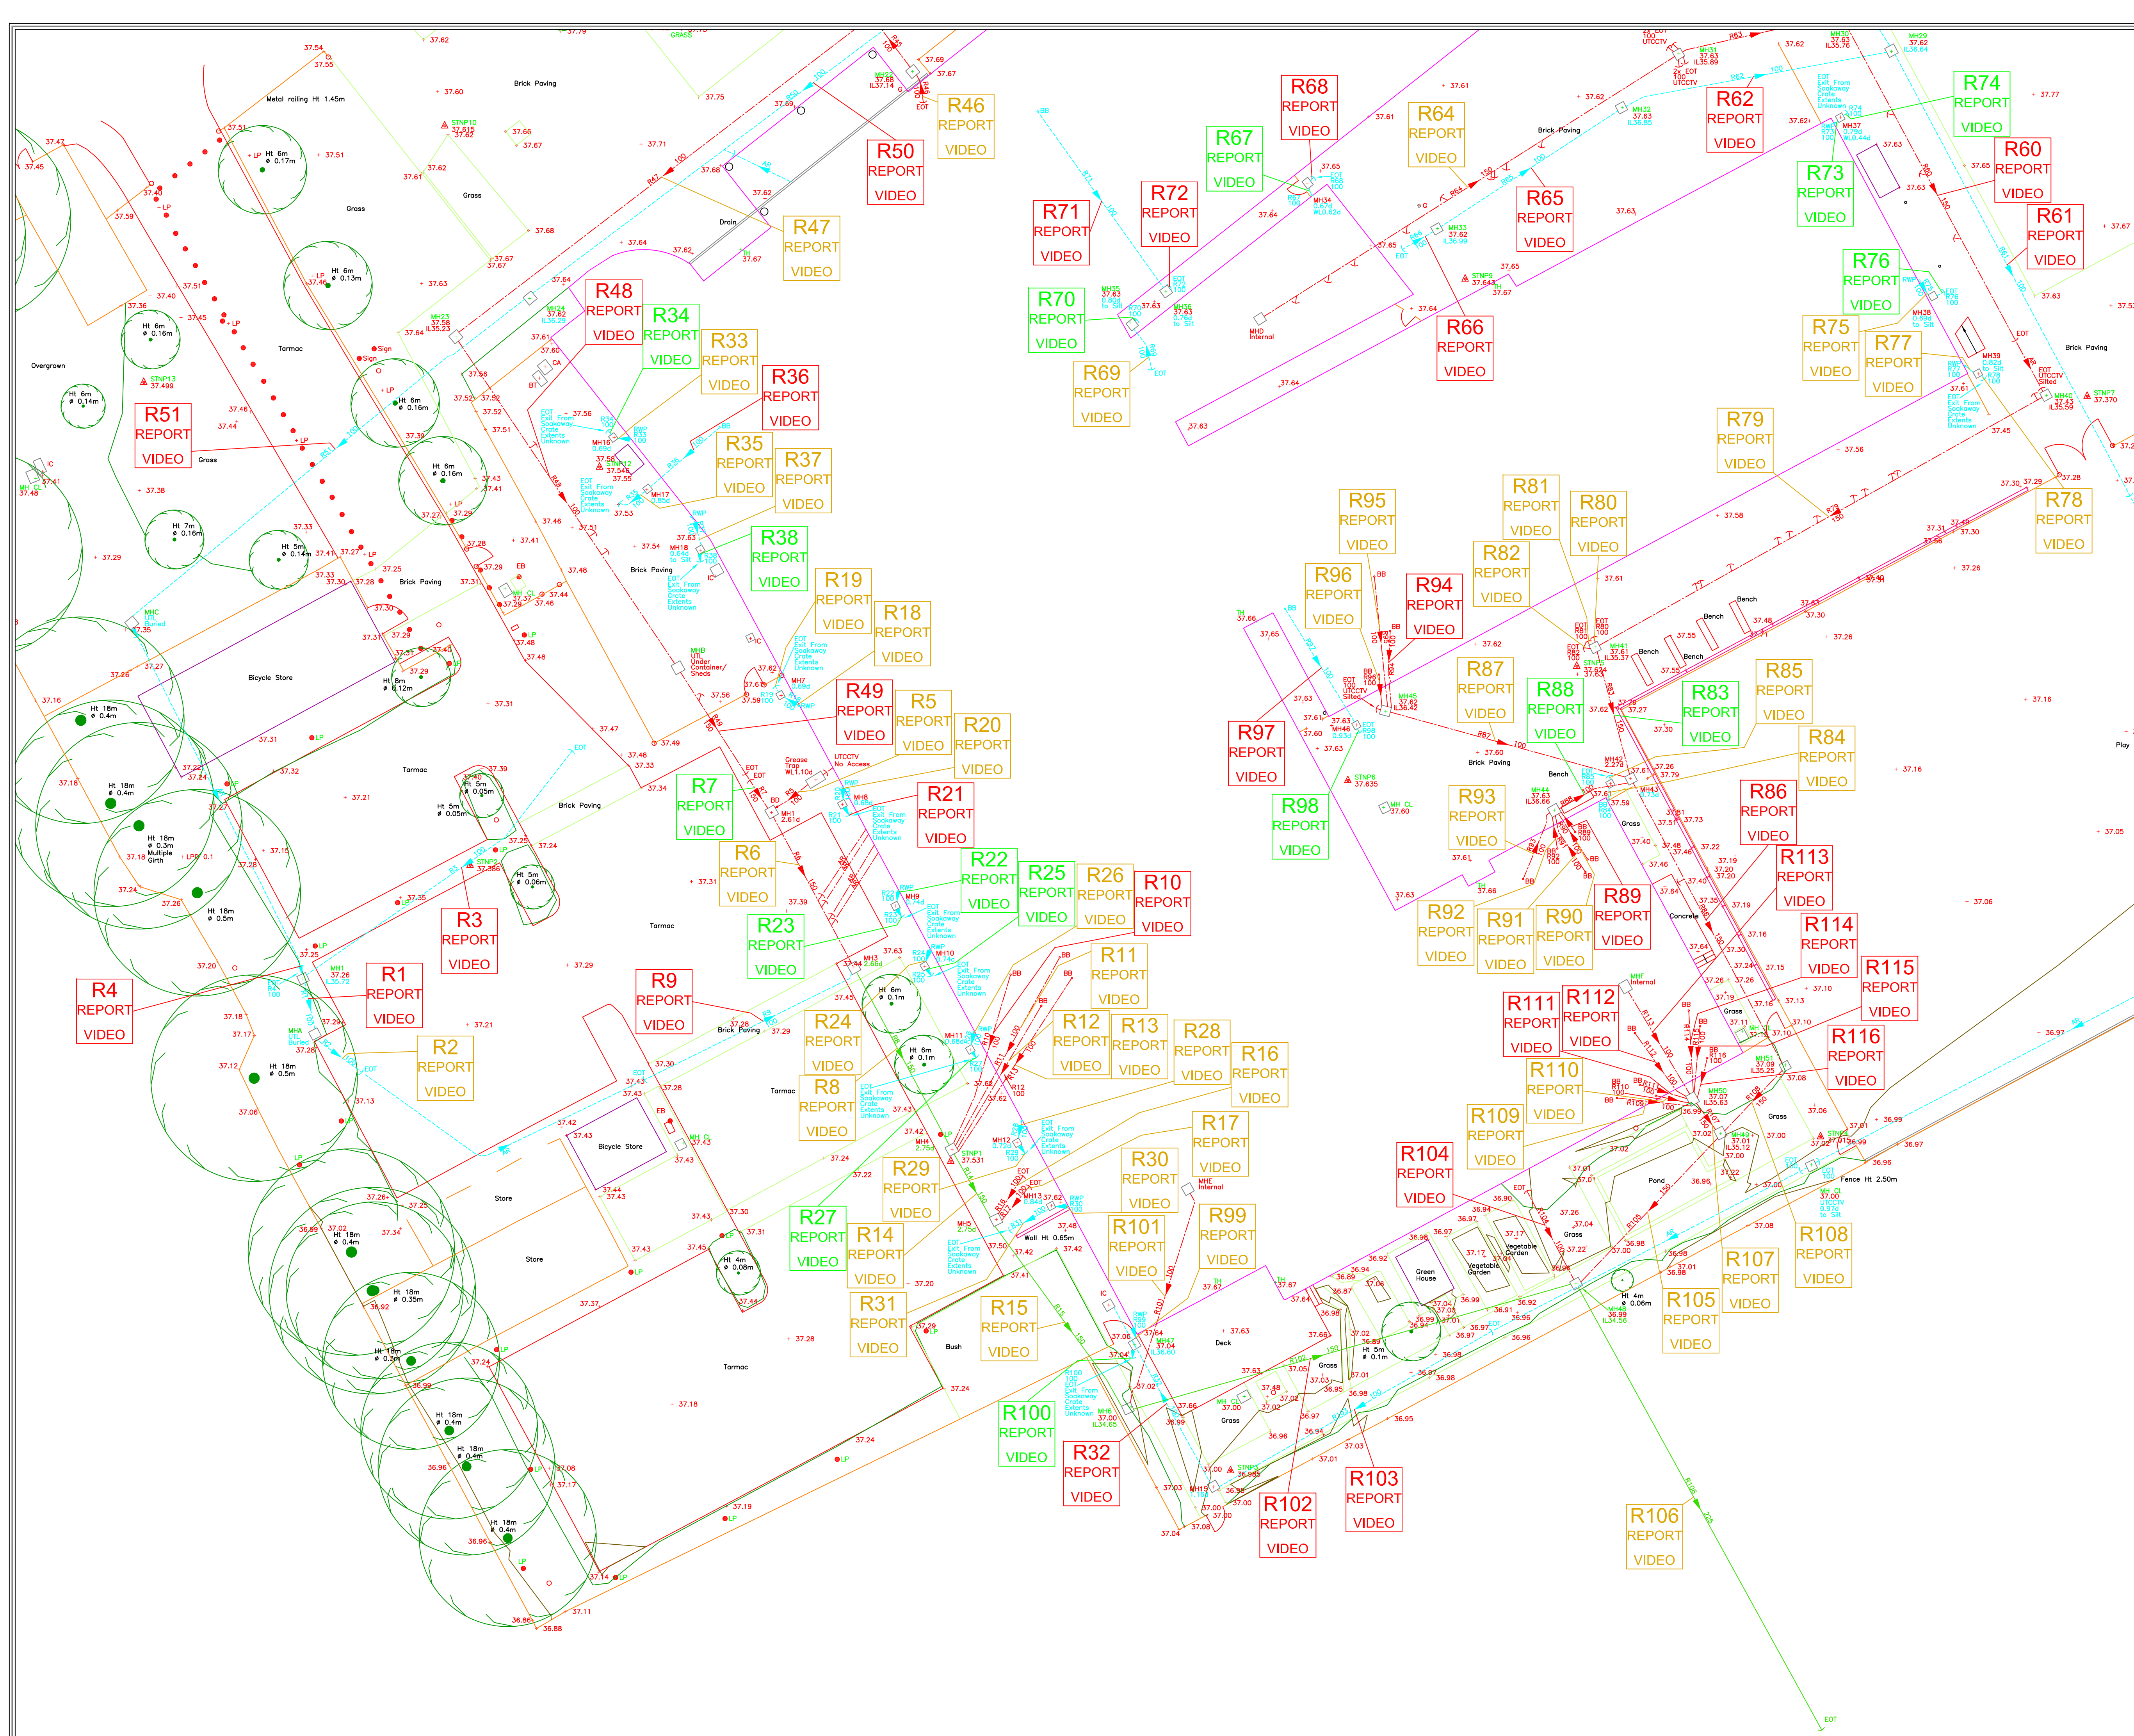

NOTES:

CCTV KEY
R1
R2
R3

RED CCTV RUN NUMBER
DENOTES MAJOR FAULT
AMBER CCTV RUN NUMBER
DENOTES MINOR FAULT
GREEN CCTV RUN NUMBER
DENOTES NO FAULTS

UTILITY KEY

ABBREVIATIONS

AC	ASBESTOS CEMENT	LP	LAMP POST
AR	ASSUMED ROUTE	MH	MANHOLE
BB	BASE BEND	MW	MONITORING WELL
BD	BACKDROP	OH	OVERHEAD
BH	BOREHOLE	OSA	OFF SURVEY AREA
BR	BRICK	PL	POLYETHYLENE
BT	BT INSPECTION CHAMBER	PR	PIPE RISER
CATV	CATV INSPECTION CHAMBER	PVC	POLYVINYL CHLORIDE
CBX	CONTROL BOX	RE	RODDING EYE
CI	CAST IRON	RWP	RAIN WATER PIPE
CL	COVER LEVEL	SIA	SOAKAWAY
CR	CABLE RISER	SI	SPIN IRON
CP	CATCHPIT	ST	STOP TAP
d	DEPTH	S.T	STEEL
DI	DUCTILE IRON	SV	SLUICE VALVE
DP	DOWN PIPE	SVP	SOIL VENT PIPE
EM	EMPTY DUCT	TF	TRAPPED EXIT
EOSC	END OF TRENCH SCAR	TFR	TAKEN FROM RECORD
EOT	END OF TRACE	TL	TRAFFIC LIGHT
ER	EARTHING ROD	TP	TELEGRAPH POLE
EP	ELECTRICITY POLE	UT	UNABLE TO CCTV
FH	FIRE HYDRANT	UTCTV	UNABLE TO FIND
FL	FLOOD LIGHT	UTL	UNABLE TO LIFT
G	GULLY	UTS	UNABLE TO SURVEY
GPR	GROUND PENETRATING RADAR	VC	VITRIFIED CLAY
GRP	GLASS REINFORCED PLASTIC	VP	VENT PIPE
GV	GAS VALVE	VR	VAPOUR RECOVERY
HL	HIGH LEVEL	WL	WATER LEVEL
HOR	HEAD OF RUN	WM	WATER METER
IC	INSPECTION CHAMBER	WO	WASH OUT VALVE
IL	INVERT LEVEL		
SWS	SURFACE WATER SEWER		
CWS	CONTAMINATED SURFACE WATER SEWER		
FWS	FOUL WATER SEWER		
CWS	COMBINED WATER SEWER		

DISCLAIMER

ELECTRO-MAGNETIC TECHNIQUES AND/OR GROUND PENETRATING RADAR HAVE BEEN USED IN THE LOCATION OF UNDERGROUND SERVICES. THE RESULTS ARE NOT INFALLIBLE AND TRIAL EXCAVATIONS SHOULD BE CARRIED OUT TO CONFIRM SERVICE IDENTIFICATION, POSITIONS AND PARTICULARLY DEPTHS. WHERE THESE ARE CRITICAL, ALTHOUGH ALL REASONABLE EFFORT HAS BEEN MADE IN SEARCHING AVAILABLE RECORD DRAWINGS, THE COMPLETENESS OF THE UNDERGROUND SERVICES INFORMATION CANNOT BE GUARANTEED. THE METHODS OF SURVEY DOES NOT DIFFERENTIATE BETWEEN LIVE AND DEAD SERVICES AND AS SUCH ALL SERVICES SHOULD BE TREATED AS LIVE. WHERE SERVICES ARE NON-METALLIC POSITIONS MAY BE TAKEN FROM RECORDS, TRENCH SCARS & SURFACE DETAIL. WHERE QUOTED, DEPTH ESTIMATIONS ARE GENERALLY TO THE CENTRE OF THE SERVICE. DEPTHS TO GRAVITY SEWERS AND DRAINS ARE GENERALLY TO INVERT LEVELS UNLESS OTHERWISE STATED. PIPE SIZES WHICH CANNOT BE OBTAINED BY VISUAL SURVEY ARE TAKEN FROM RECORD DRAWINGS OR MARKER PLATES WHERE AVAILABLE. WHERE GROUND PENETRATING RADAR HAS BEEN USED IT WILL PRIMARILY HAVE BEEN TO IDENTIFY UNDERGROUND UTILITIES. IF POSSIBLE WE WILL ALSO IDENTIFY UNDERGROUND STRUCTURES/ TANKS ETC. BUT CANNOT GUARANTEE TO HAVE LOCATED ALL SUCH ITEMS. THE USE OF RADAR CAN BE LIMITED BOTH BY SURFACE CONDITIONS AND ALSO BY SOIL TYPE. DEPTH ESTIMATES WOULD NOT NORMALLY BE PROVIDED FOR SERVICES LOCATED WITH GPR.

REV	DATE	COMMENT	CAD

CLIENT
London Borough of Hillingdon

PROJECT
Ruislip High School
Sidmouth Drive
Ruislip
HA4 0BY


TITLE
Underground
CCTV Survey

AMETHYST
SURVEYS LIMITED

Unit 6a Davy Court, Central Park
Rugby, Warwickshire, CV23 0UZ
Tel: 01788 566740
Fax: 01788 571158
Email: enquiries@amethystsurveys.com
www.amethystsurveys.com

DATE: 23.02.17	JOB No: 12306b
DRAWING No: 12306b_CCTV 1	REV: 0
DRAWN: TO	SURVEYED: AS
APPROVED: T.P.D	SCALE: 1:200 @ A1

© Copyright: Amethyst Surveys Ltd. 11/10/16

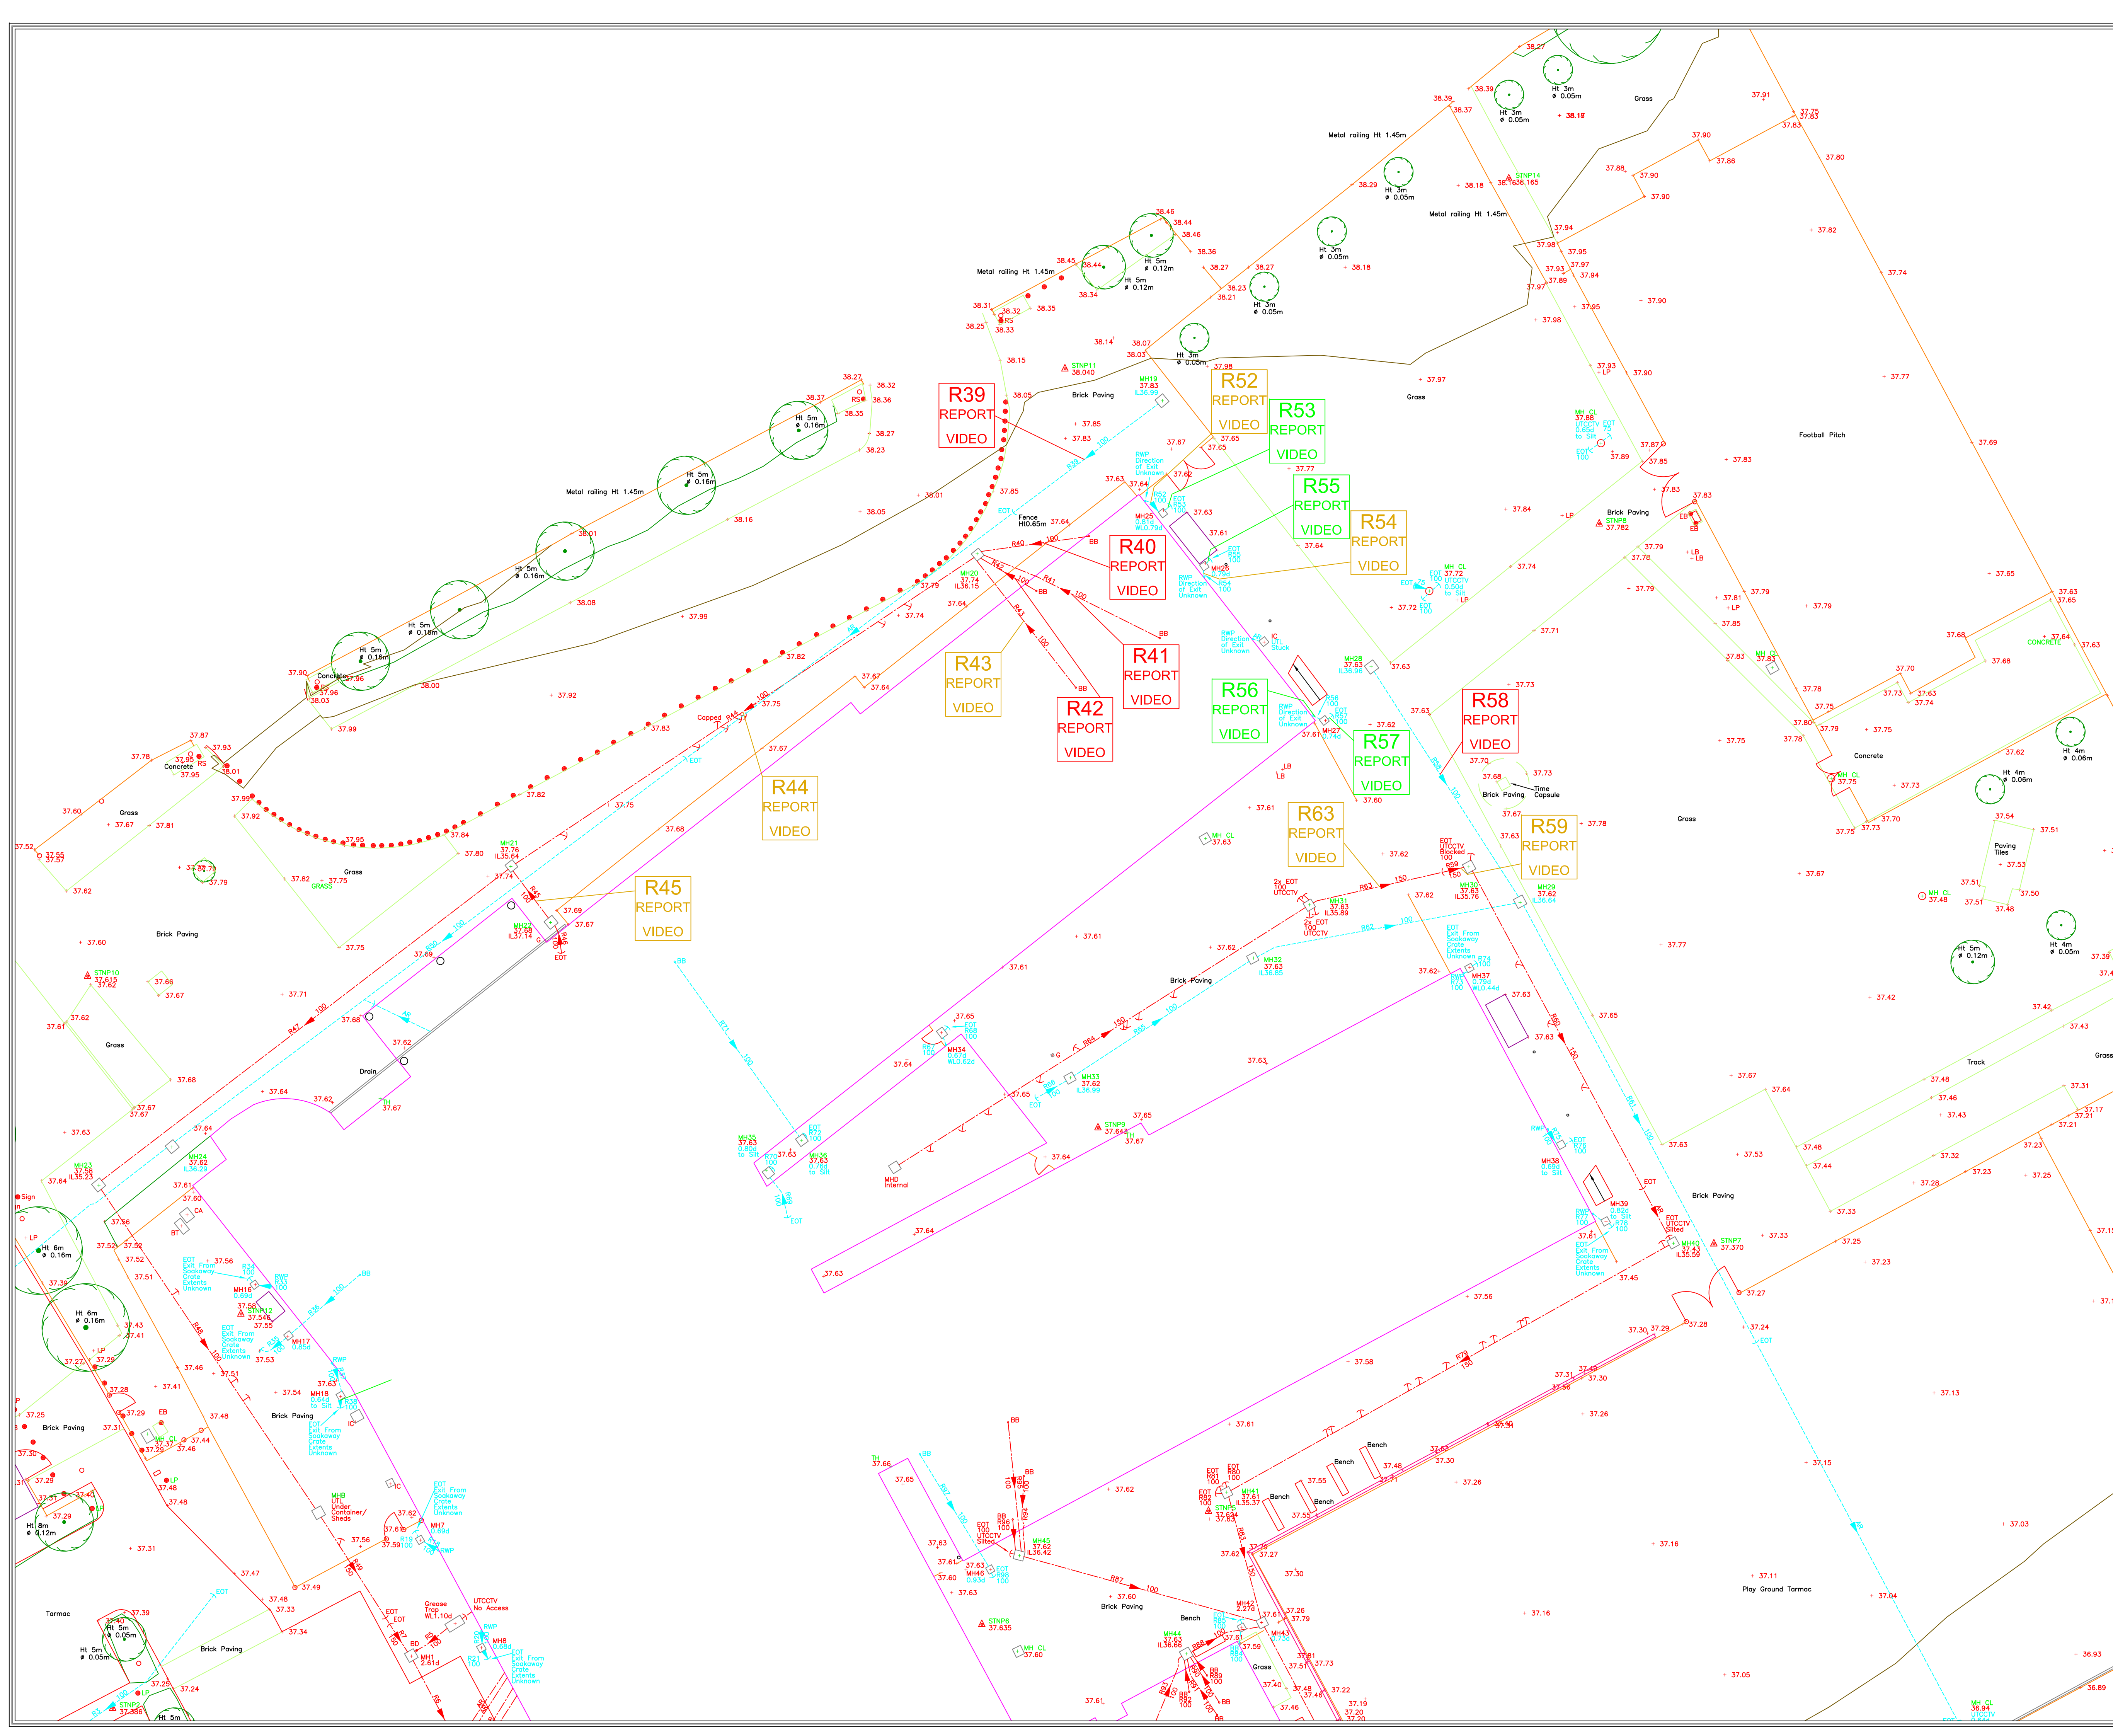

NOTES;

CCTV KEY
R1 RED CCTV RUN NUMBER DENOTES MAJOR FAULT
R2 AMBER CCTV RUN NUMBER DENOTES MINOR FAULT
R3 GREEN CCTV RUN NUMBER DENOTES NO FAULTS

UTILITY KEY
FOUL WATER SEWER
SURFACE WATER SEWER
COMBINED WATER SEWER
CONTAMINATED SURFACE
PUMPING MAIN
SERVICE DUCTS / TRENCH
SCARP
UNIDENTIFIED SERVICE
BACKDROP / TRAPPED EXIT
END OF TRACE

ABBREVIATIONS
AC ASBESTOS CEMENT
AR ASSUMED ROUTE
BB BASE BEND
BD BACKDROP
BH BOREHOLE
BR BRICK
BT BT INSPECTION CHAMBER
CATV CATV INSPECTION CHAMBER
CBX CONTROL BOX
CI CAST IRON
CL COVER LEVEL
CR CABLE RISER
CP CATCHPIT
d DEPTH
DI DUCTILE IRON
DP DOWN PIPE
ED EMPTY DUCT
EOSC END OF TRENCH SCAR
EOT END OF TRACE
ER EARTHING ROD
EP ELECTRICITY POLE
FH FIRE HYDRANT
FL FLOOD LIGHT
G GULLY
GPR GROUND PENETRATING RADAR
GRP GLASS REINFORCED PLASTIC
GV GAS VALVE
HL HIGH LEVEL
HOR HEAD OF RUN
IC INSPECTION CHAMBER
IL INVERT LEVEL
SWS SURFACE WATER SEWER
CSWS CONTAMINATED SURFACE WATER SEWER
FWS FOUL WATER SEWER
CWS COMBINED WATER SEWER
LP LAMP POST
MH MANHOLE
MW MONITORING WELL
OH OVERHEAD
OSA OFF SURVEY AREA
PE POLYETHYLENE
PL PLASTIC
PR PIPE RISER
PVC POLYVINYL CHLORIDE
RE RODDING EYE
RWP RAIN WATER PIPE
S/A SOAKAWAY
SI SPIN IRON
ST STOP TAP
S.T. STEEL
SV SLUICE VALVE
SVP SOIL VENT PIPE
TE TRAPPED EXIT
TFR TAKEN FROM RECORD
TL TRAFFIC LIGHT
UT TELEGRAPH POLE
UNABLE TO CCTV
UNABLE TO FIND
UTL UNABLE TO LIFT
UNABLE TO SURVEY
VC VITRIFIED CLAY
VP VENT PIPE
VR VAPOUR RECOVERY
WL WATER LEVEL
WM WATER METER
WO WASH OUT VALVE

DISCLAIMER
ELECTRO-MAGNETIC TECHNIQUES AND/OR GROUND PENETRATING RADAR HAVE BEEN USED IN THE LOCATION OF UNDERGROUND SERVICES. THE RESULTS ARE NOT INFALLIBLE AND TRIAL EXCAVATIONS SHOULD BE CARRIED OUT TO CONFIRM SERVICE IDENTIFICATION, POSITIONS AND PARTICULARLY DEPTHS, WHERE THESE ARE CRITICAL. ALTHOUGH ALL REASONABLE EFFORT HAS BEEN MADE IN SEARCHING AVAILABLE RECORD DRAWINGS, THE COMPLETENESS OF THE UNDERGROUND SERVICES INFORMATION CANNOT BE GUARANTEED. THE METHODS OF SURVEY DOES NOT DIFFERENTIATE BETWEEN LIVE AND DEAD SERVICES AND AS SUCH ALL SERVICES SHOULD BE TREATED AS LIVE. WHERE SERVICES ARE NON-METALLIC POSITIONS MAY BE TAKEN FROM RECORDS, TRENCH SCARS & SURFACE DETAIL. WHERE QUOTED, DEPTH ESTIMATIONS ARE GENERALLY TO THE CENTRE OF THE SERVICE. DEPTHS TO GRAVITY SEWERS AND DRAINS ARE GENERALLY TO INVERT LEVEL UNLESS OTHERWISE STATED. PIPE SIZES WHICH CANNOT BE OBTAINED BY VISUAL SURVEY ARE TAKEN FROM RECORD DRAWINGS OR MARKER PLATES WHERE AVAILABLE. WHERE GROUND PENETRATING RADAR HAS BEEN USED IT WILL PRIMARILY HAVE BEEN TO IDENTIFY UNDERGROUND UTILITIES IF POSSIBLE WE WILL ALSO IDENTIFY UNDERGROUND STRUCTURES/ TANKS ETC. BUT CANNOT GUARANTEE TO HAVE LOCATED ALL SUCH ITEMS. THE USE OF RADAR CAN BE LIMITED BOTH BY SURFACE CONDITIONS AND ALSO BY SOIL TYPE. DEPTH ESTIMATES WOULD NOT NORMALLY BE PROVIDED FOR SERVICES LOCATED WITH GPR.

REV	DATE	COMMENT	CAD

CLIENT
London Borough of Hillingdon

PROJECT
Ruislip High School
Sidmouth Drive
Ruislip
HA4 0BY

TITLE
Underground
CCTV Survey

AMETHYST SURVEYS LIMITED
Unit 6a Davy Court, Central Park
Rugby, Warwickshire, CV23 0UZ
Tel: 01788 566740
Fax: 01788 571158
Email: enquiries@amethystsurveys.com
www.amethystsurveys.com

DATE: 23.02.17	JOB No: 12306b
DRAWING No: 12306b_CCTV 2	REV: 0
DRAWN: TO	SURVEYED: AS
APPROVED: T.P.D	SCALE: 1:200 @ A1

© Copyright Amethyst Surveys Ltd. 11/10/16