



1 EAST (side)

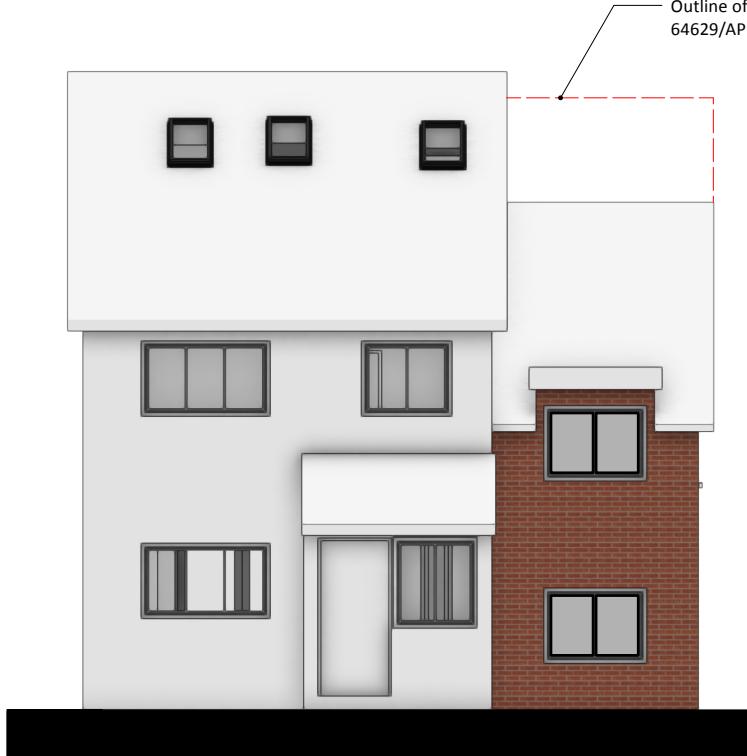

2 NORTH (front)

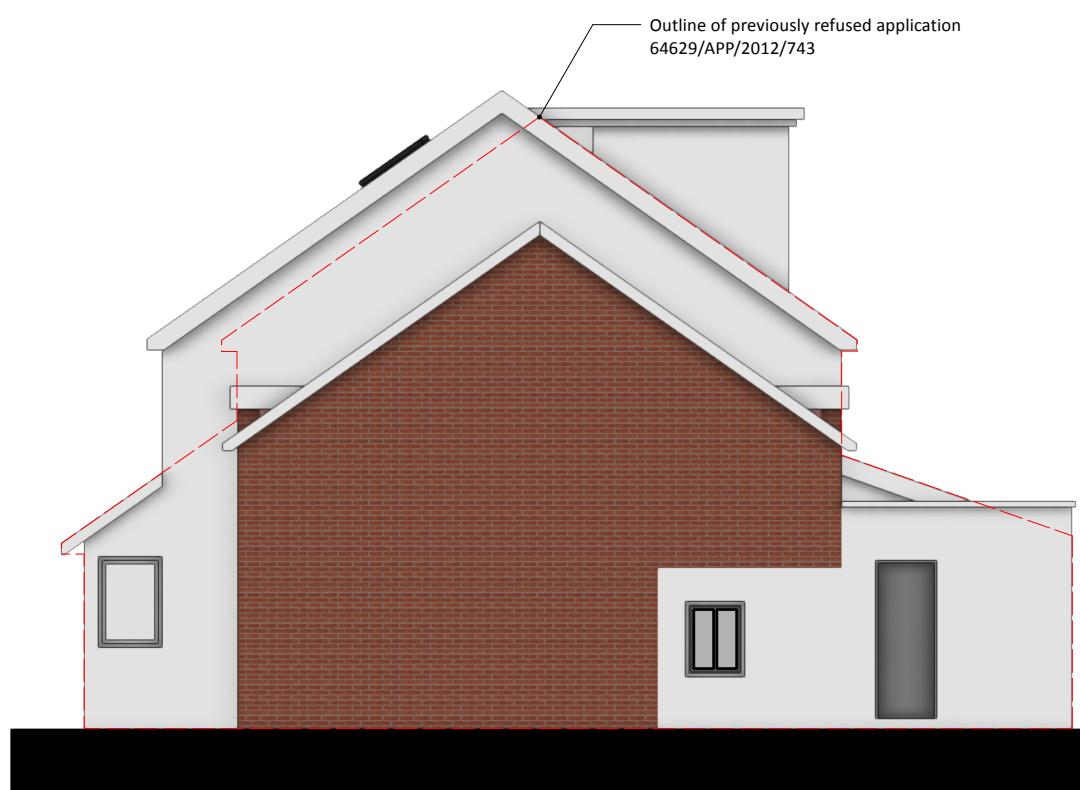

7 WEST (side)



8 SOUTH (rear)

General Notes

1. New work shown shaded
2. Demolition shown dotted
3. W: Wardrobe
4. All dimensions are indicative and in mm
5. If shown levels indicated in red dotted

0 1 2 3 4 5 m

ISSUE DATE REVISION

PROJECT
7 Glenorchy Close, Hayes UB4 9SU

CLIENT
Mr & Mrs Patel

DRAWING
PROPOSED ELEVATIONS

STONES
A R C H I T E C T S

All rights reserved in chapter IV of the copyright designs & patents act 1988 have been asserted. This drawing must not be scaled; only figured dimensions should be used. Check and verify all dimensions on site prior to commencing any work. Any discrepancies should be reported to the Architects immediately.

PROJECT # 2025.023 DWG # REV
DATE 14/07/2025
SCALE 1:100
DRAWN S.W. CHKD J.C.

C04

Stones Architects Ltd
50 Coldharbour Lane Hayes Middlesex UB3 3EP
t 020 8969 0000 e mail@stonesarchitects.co.uk w stonesarchitects.co.uk