


1:100 0 1 2 5 10 Meter

<p>LB Archigroup</p>	<p>Project: 27 Edgar Road West Drayton UB7 8HN</p>	<p>Title: Floor/Roof Plans - As Built</p>	<p>Scale: 1:100 @ A3 Date: 11.06.2024 Drawing No.: LBA 3059E - 04/LB Revision</p>
			<p>info@lbarchigroup.co.uk Mob: 07710410150</p>




Front Elevation-As Built
Scale:1:100

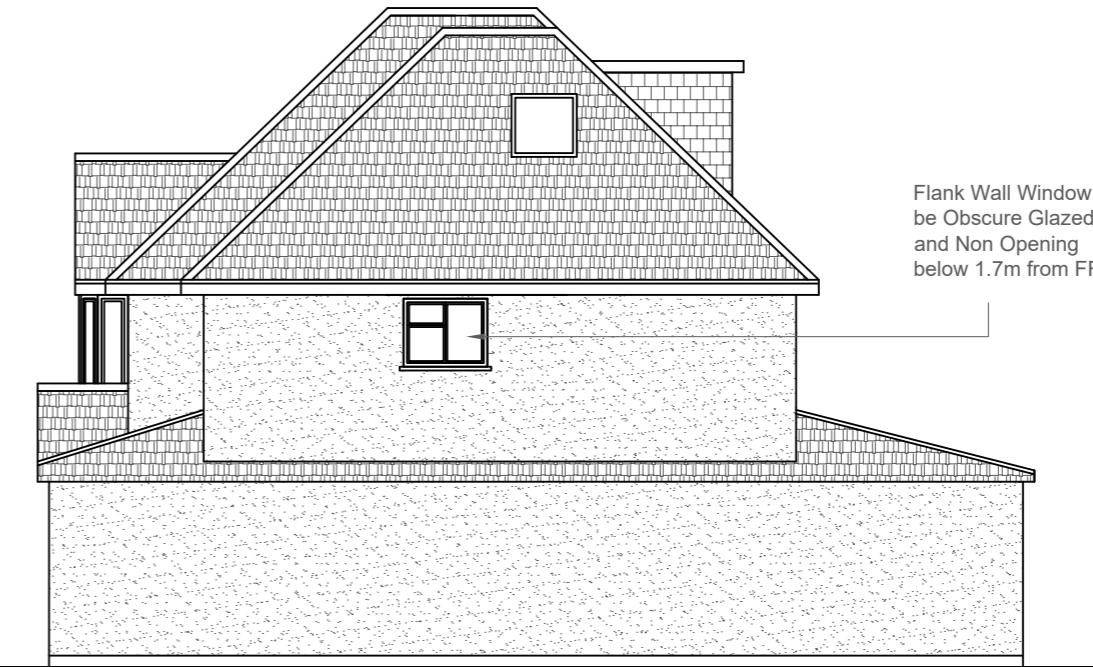

Side Elevation-As Built
Scale:1:100



Rear Elevation-As Built
Scale:1:100

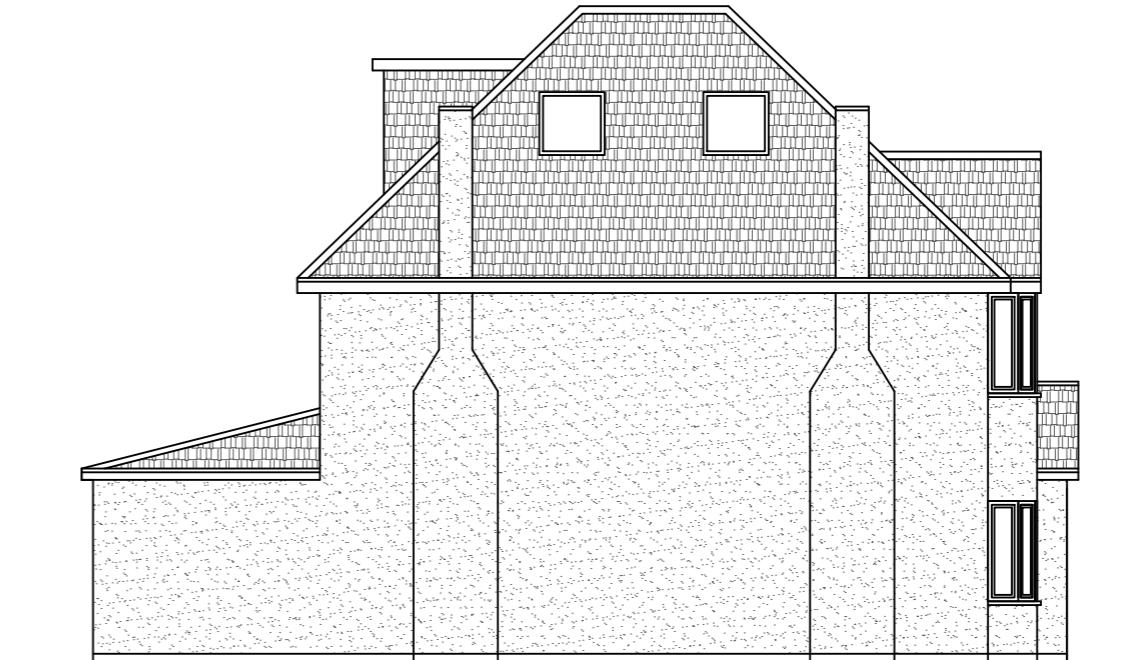

Side Elevation-As Built
Scale:1:100

1:100



10 Meter



Project:
27 Edgar Road
West Drayton
UB7 8HN

Title:
Elevations-As Built

Scale: 1:100 @ A3
Date: 11.06.2024
Drawing No.:
LBA 3059E - 05/LB
Revision

info@lbarchigroup.co.uk

Mob: 07710410150