


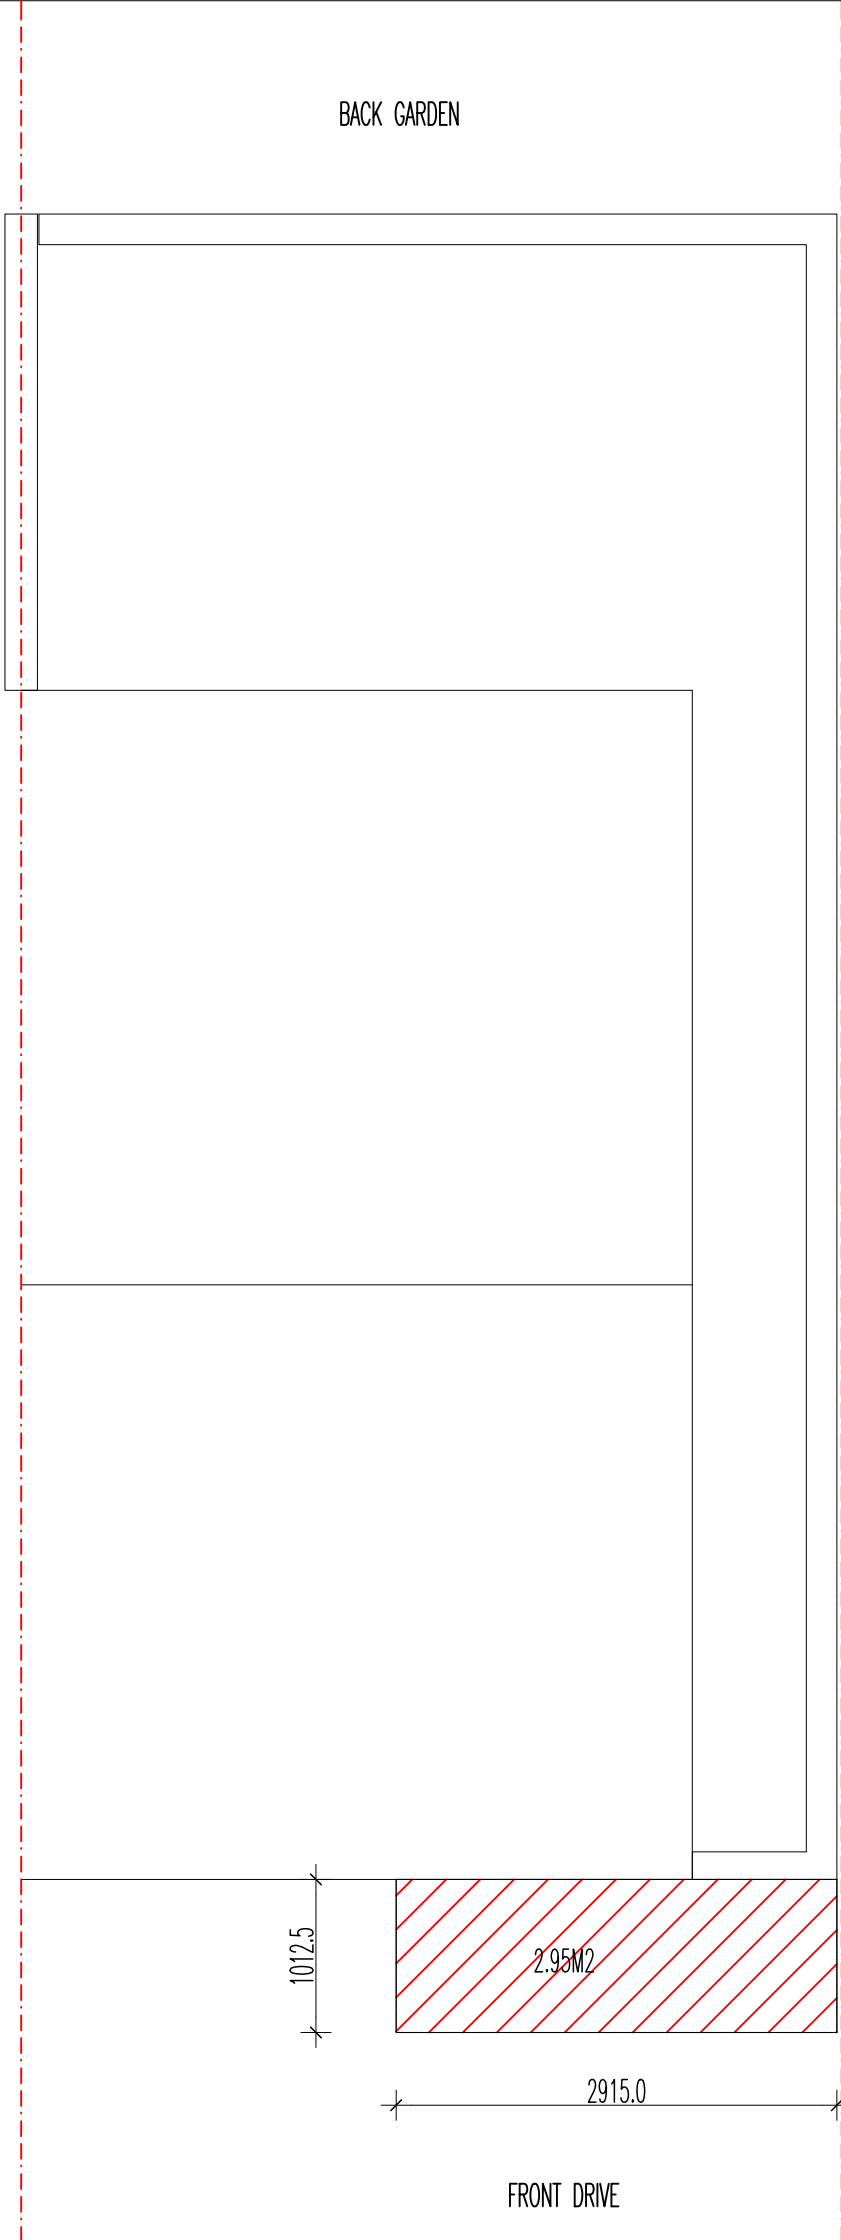


BLOCK PLAN FRONT SINGLE STOREY PORCH ADDED




SITE BOUNDARY



AS APPROVED UNDER PLANNING APPLICATION
REF 64878/APP/2023/1330

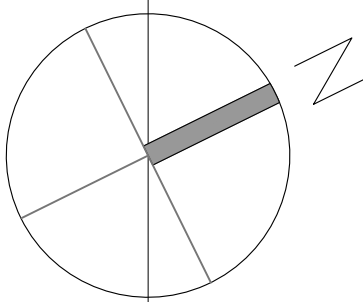

GROUND FLOOR PLAN AS BUILD

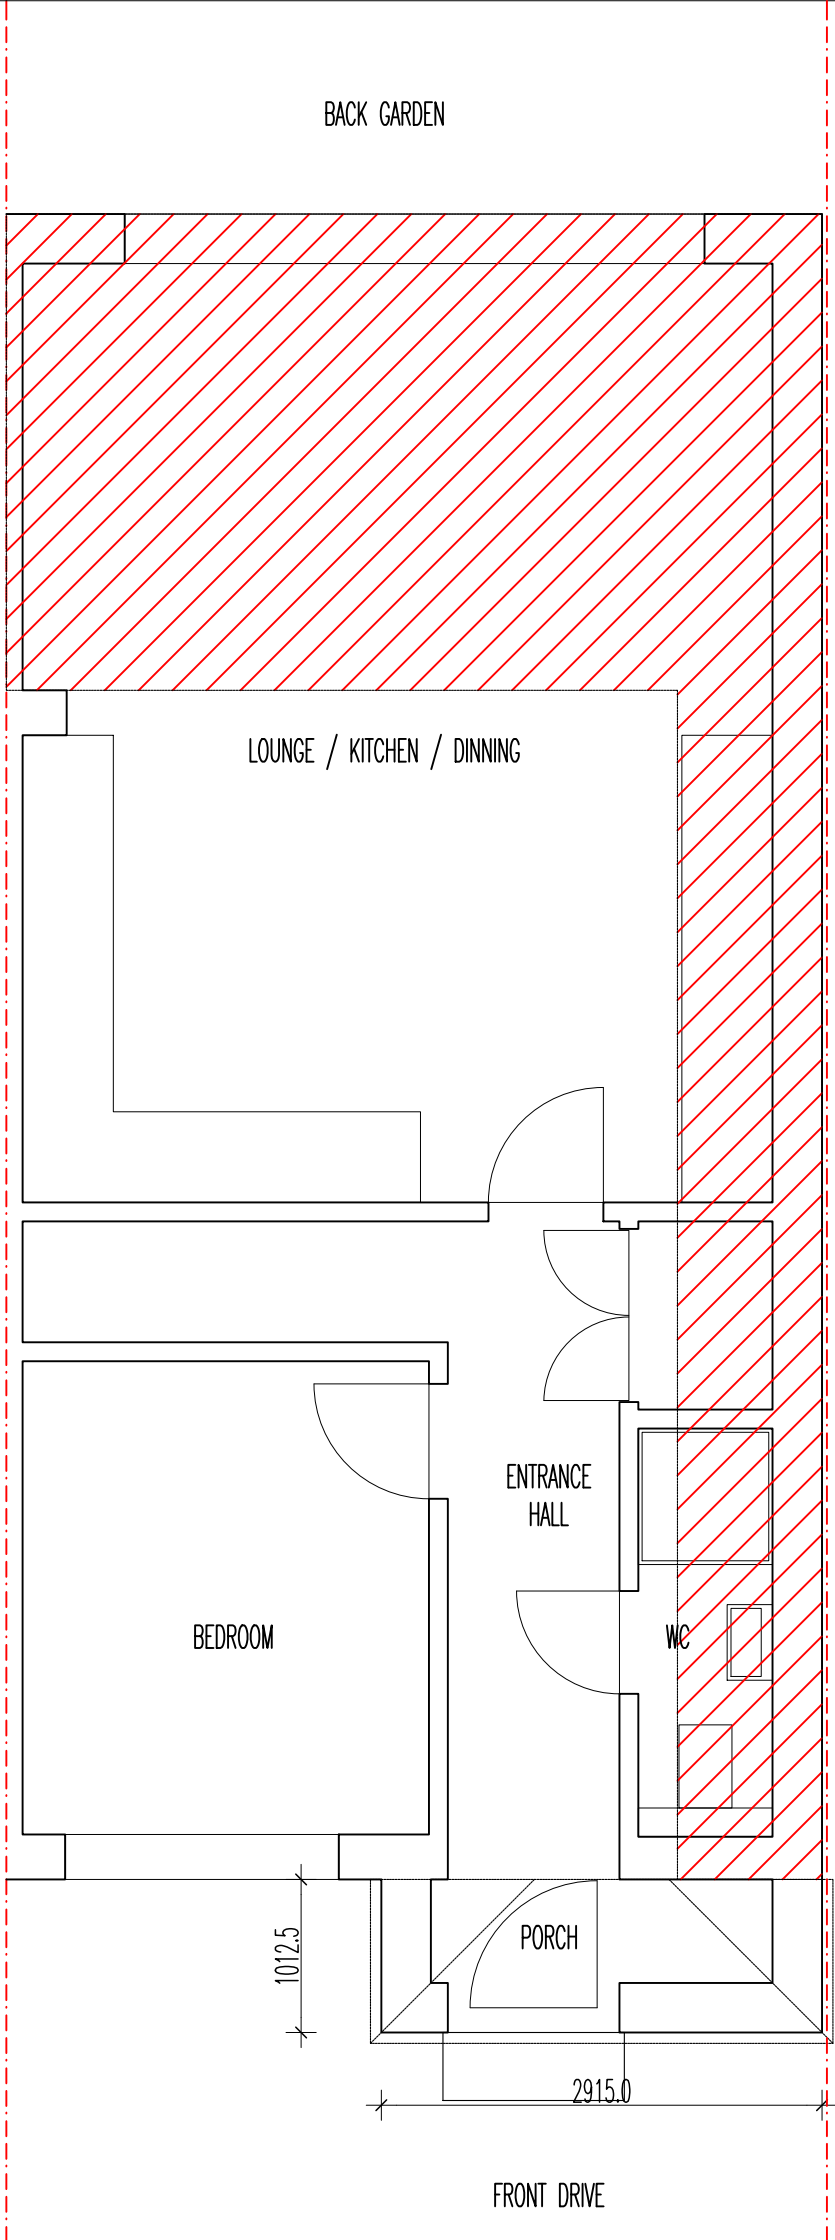

SITE BOUNDARY

SITE BOUNDARY

SITE BOUNDARY

PUBLIC FOOTPATH

BACK GARDEN

FLAT ROOF

PITCHED ROOF

SITE BOUNDARY

FLAT ROOF

FRONT DRIVE

ROOF PLAN AS BUILD




PARTY WALL ELEVATION AS APPROVED

7 LEAHOLME WAY

SITE BOUNDARY


FRONT ELEVATION AS APPROVED
REF 64878/APP/2023/1330

9 LEAHOLME WAY

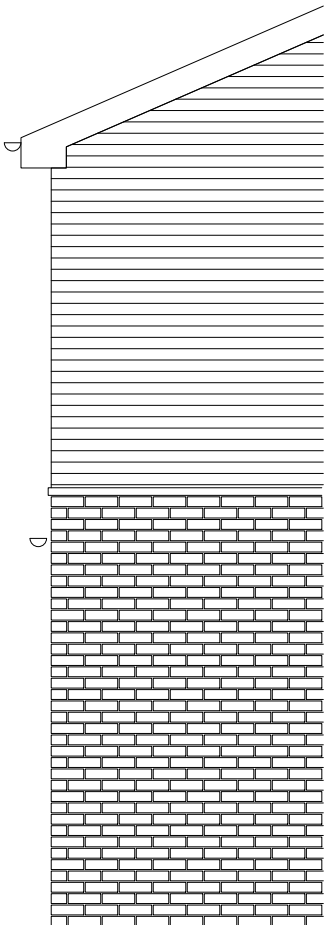

SIDE ELEVATION AS APPROVED

SITE BOUNDARY

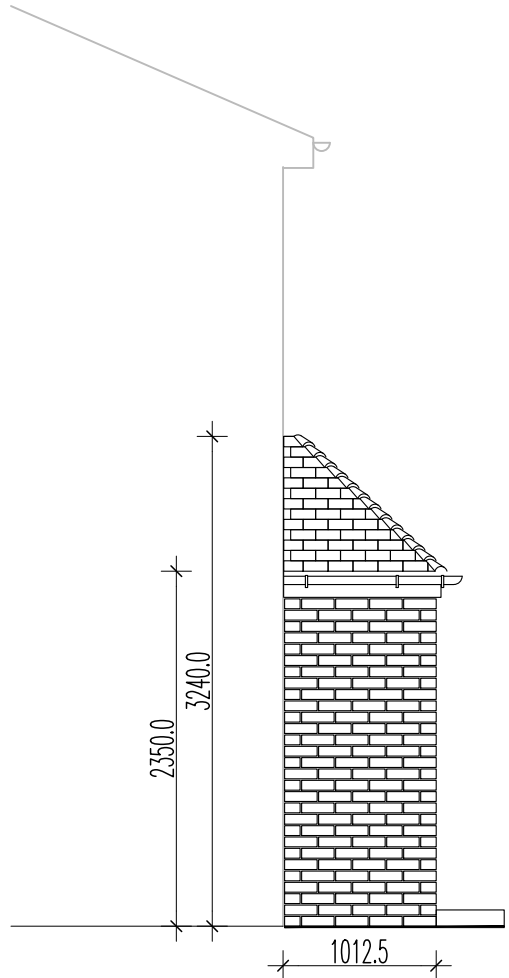

PARTY WALL ELEVATION AS BUILD




FRONT ELEVATION AS BUILD

7 LEAHOLME WAY

SITE BOUNDARY

9 LEAHOLME WAY

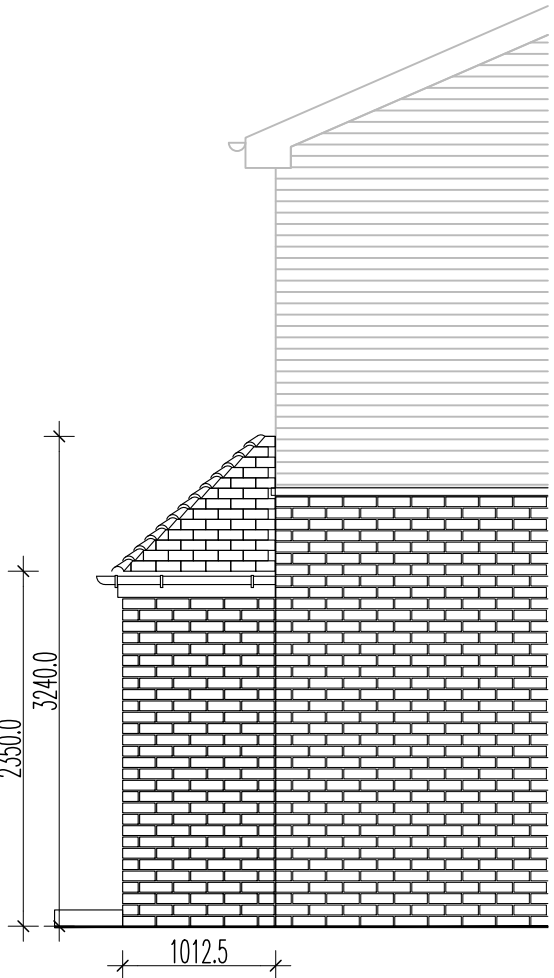

SIDE ELEVATION AS BUILD

PROJECT:
9 LEAHOLME WAY
RUISLIP
HA4 7RA

TITLE:
SINGLE STOREY FRONT PORCH
AS BUILT

RMCI Design
tel 07776202245
e mail j.cric@rmlworld.com

SCALE:
1:50@A1
DRAWN BY:
jtc
ISSUED:
PLANNING

PROJ. No: 02-24
DWG. No: PL-01
DATE: JULY 2024
CHECKED BY: