


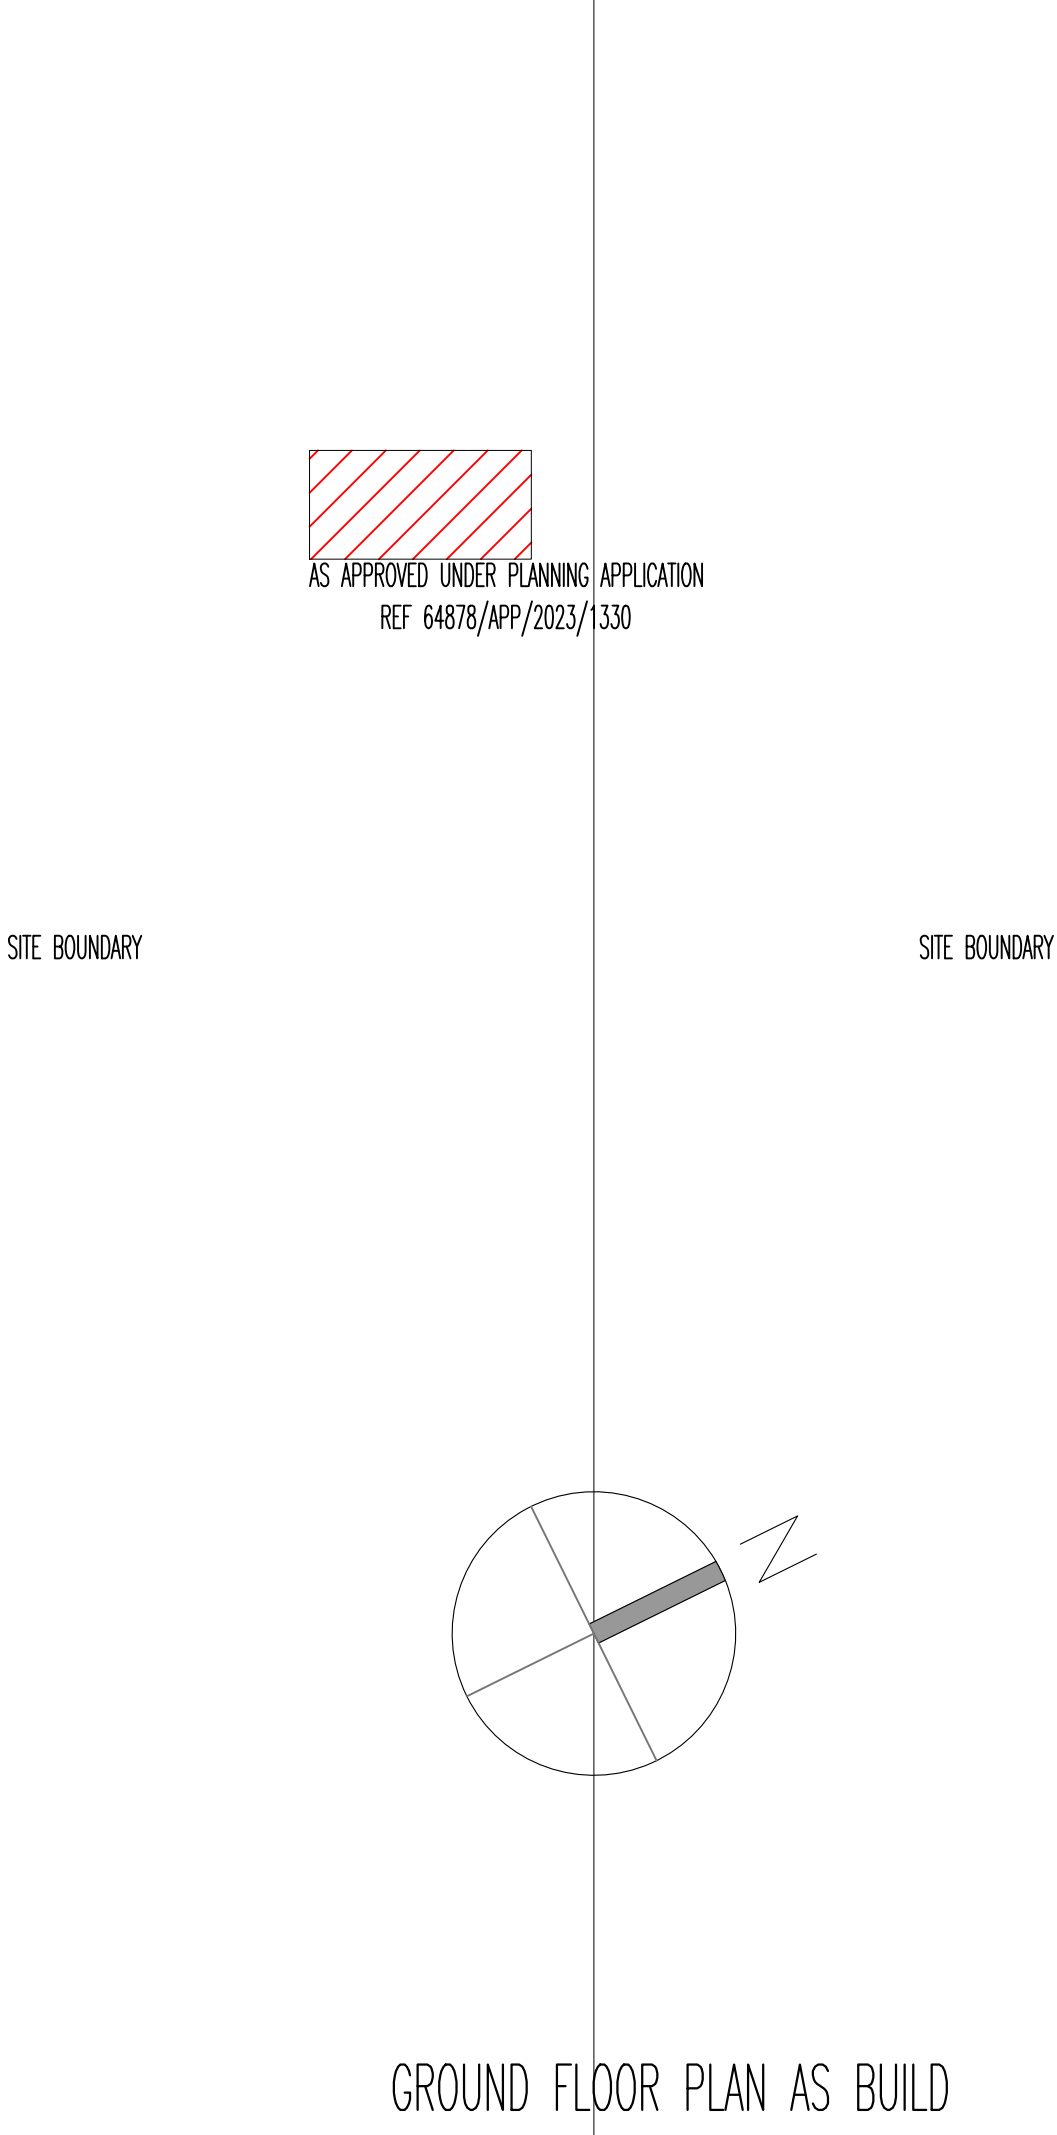


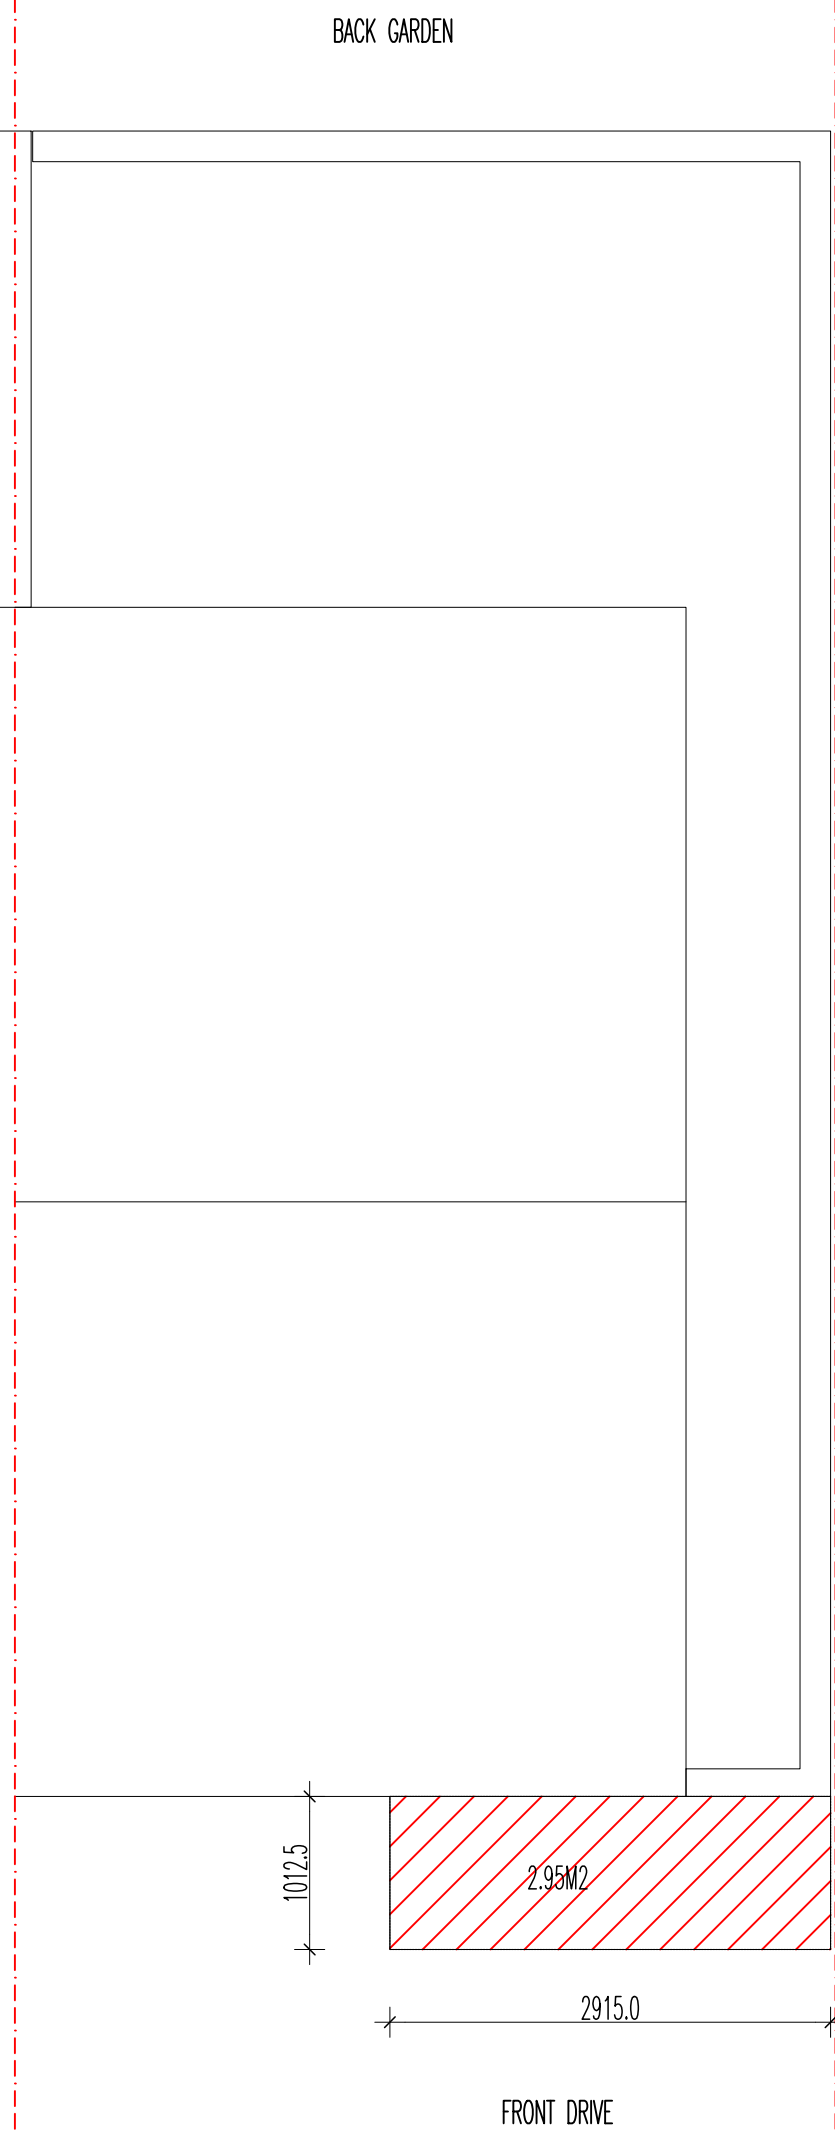

BLOCK PLAN FRONT SINGLE STOREY PORCH ADDED

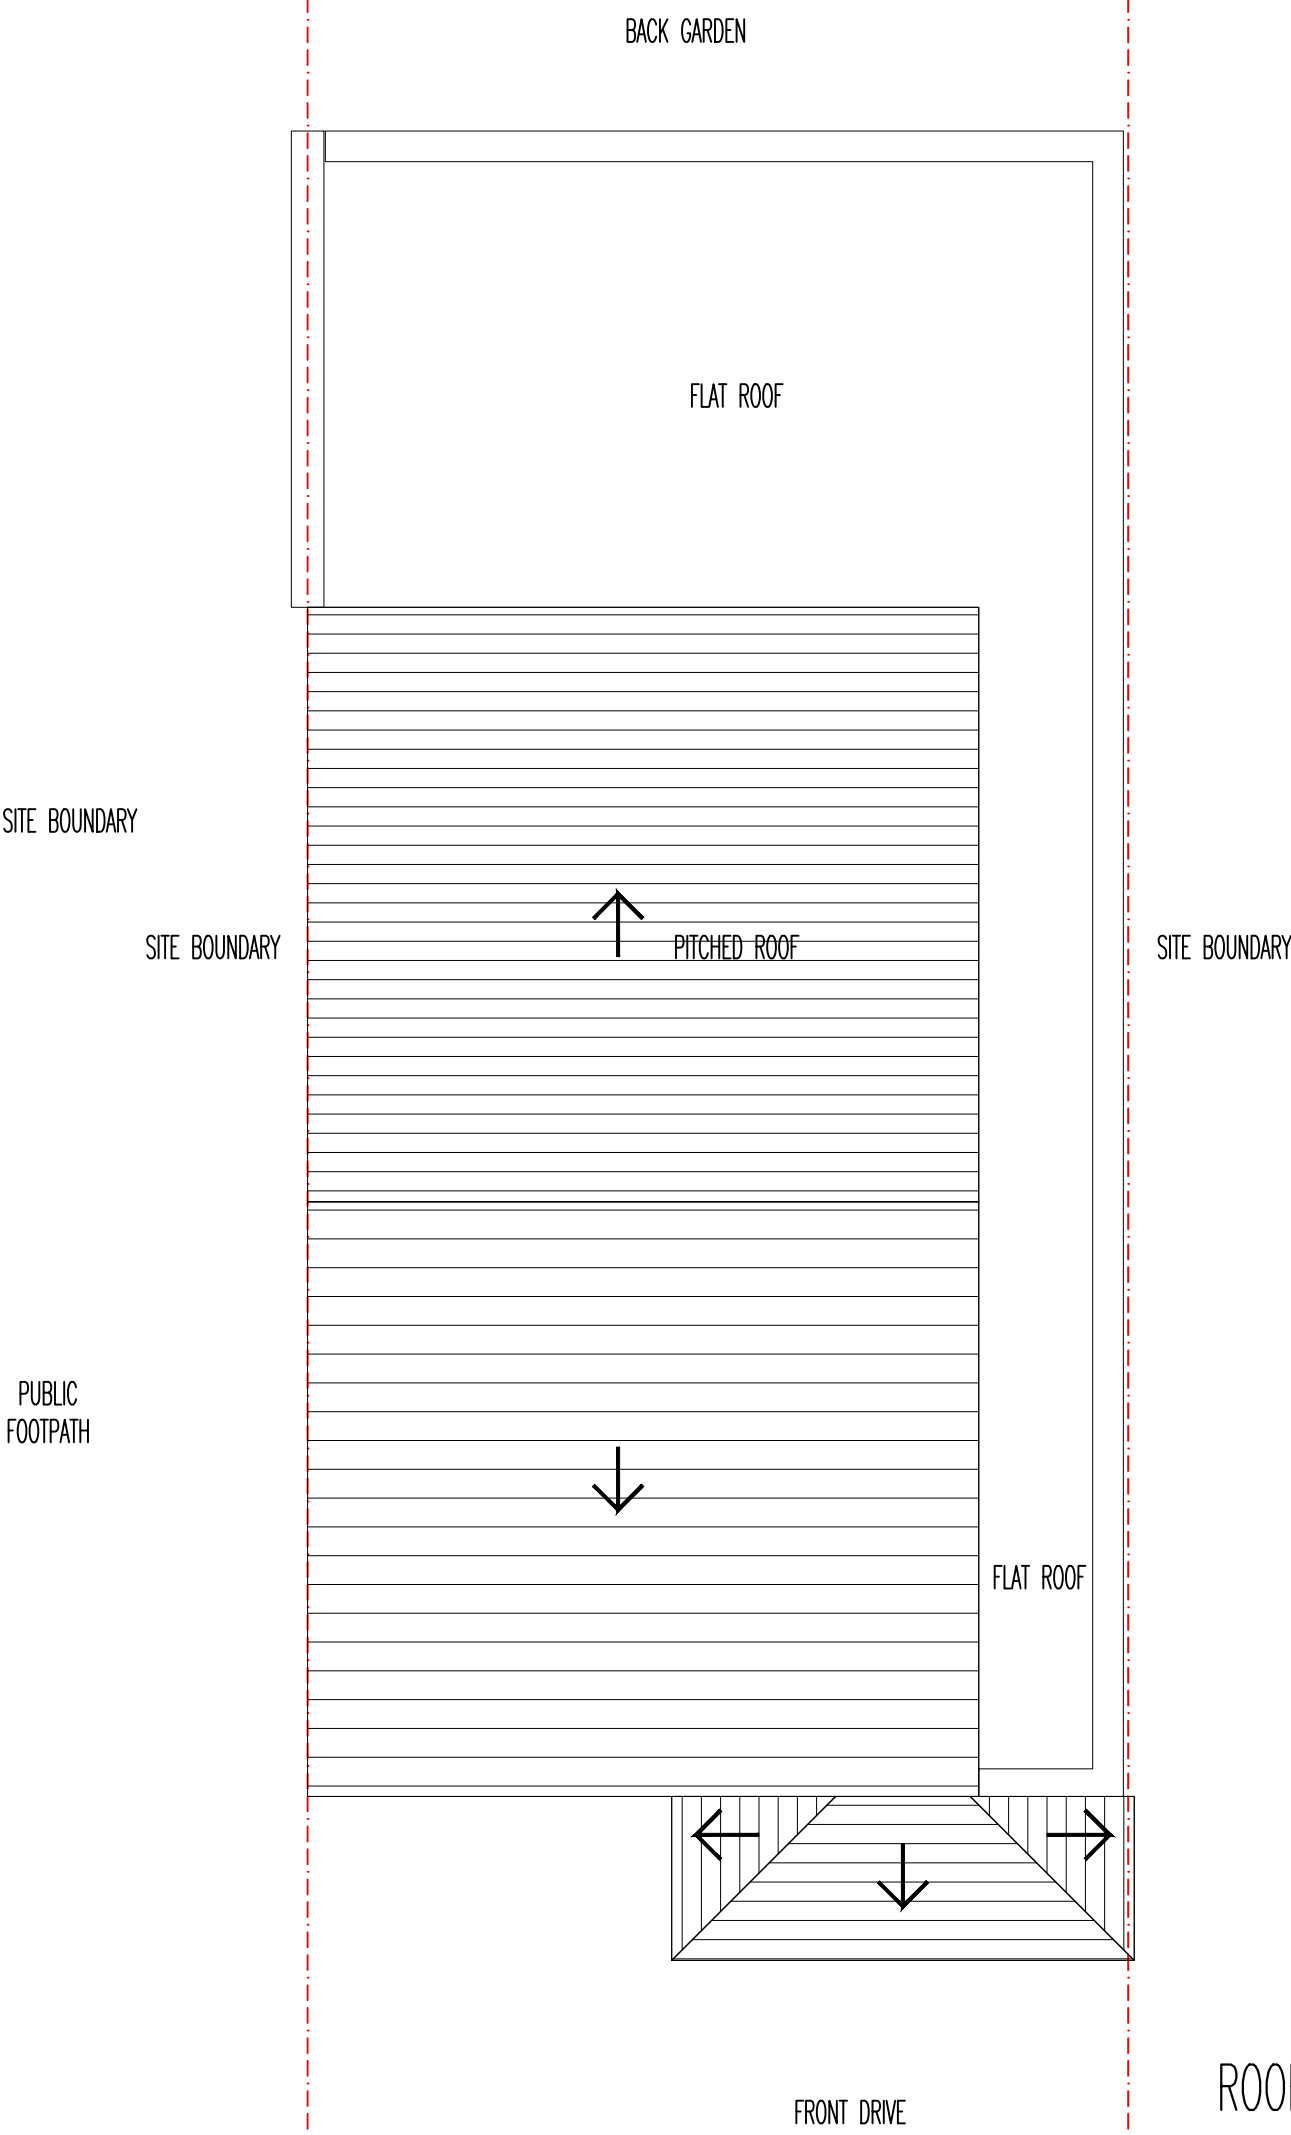

GROUND FLOOR PLAN AS BUILT

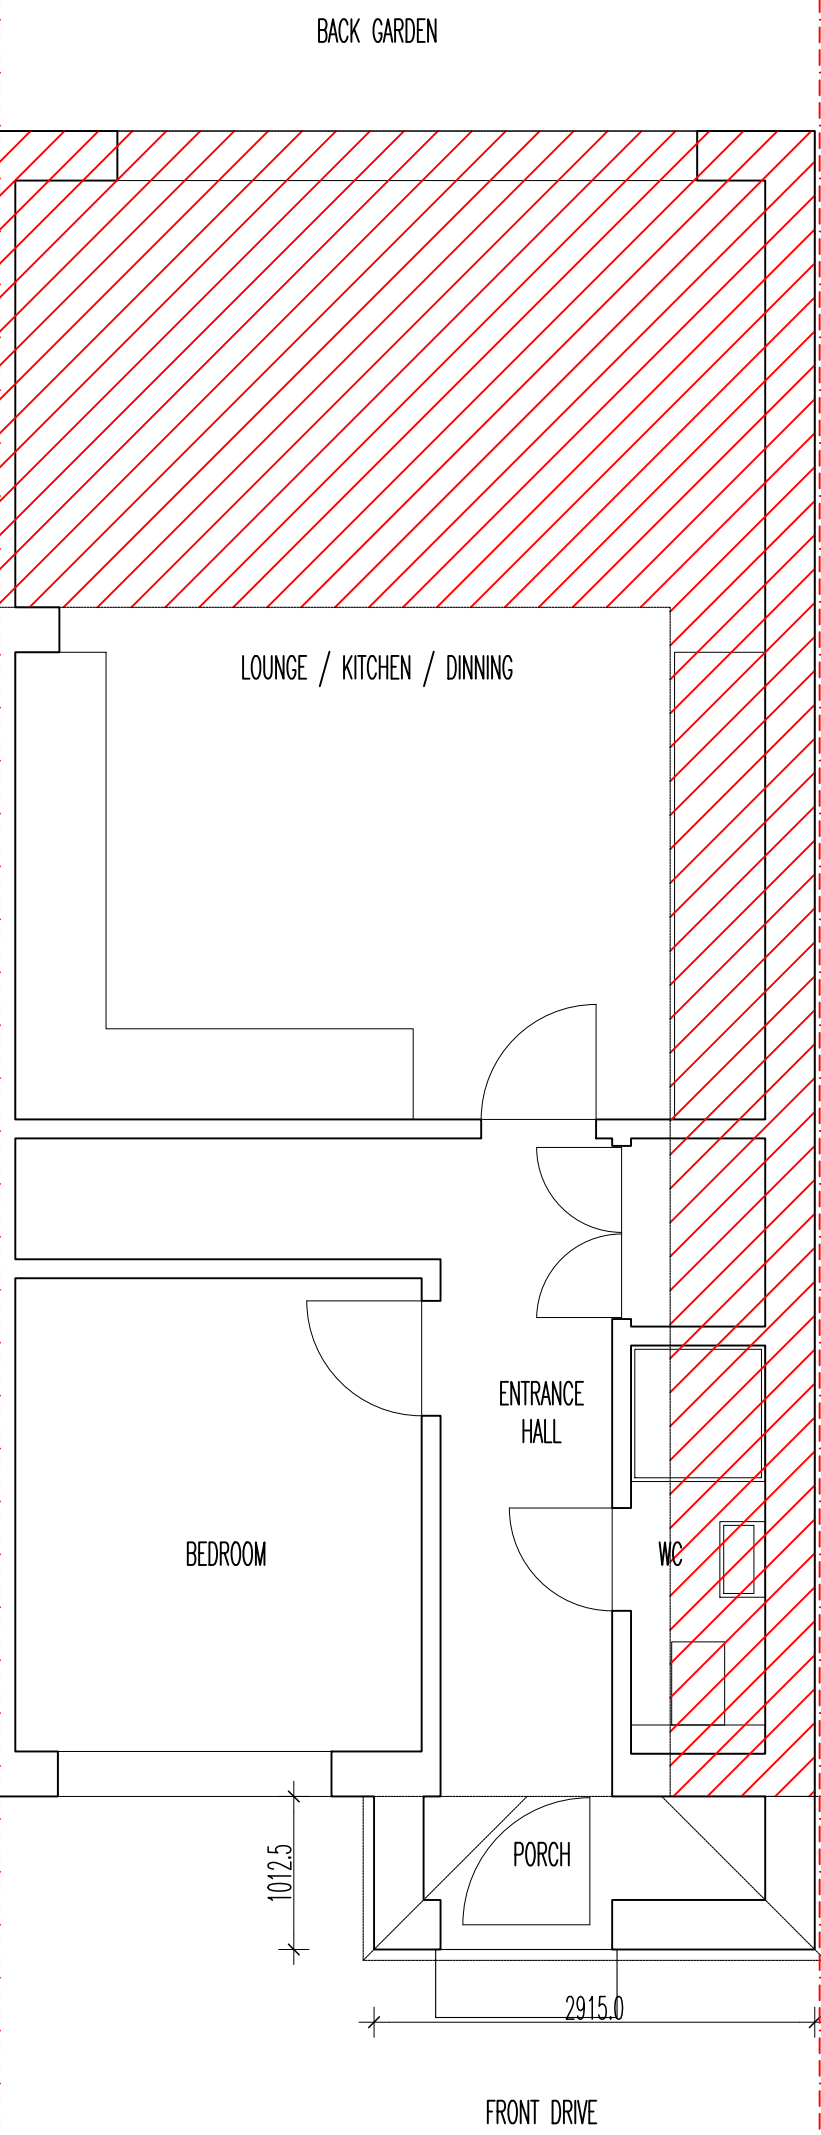

ROOF PLAN AS BUILT




PARTY WALL ELEVATION AS APPROVED

7 LEAHOLME WAY


FRONT ELEVATION AS APPROVED
REF 64878/APP/2023/1330

9 LEAHOLME WAY

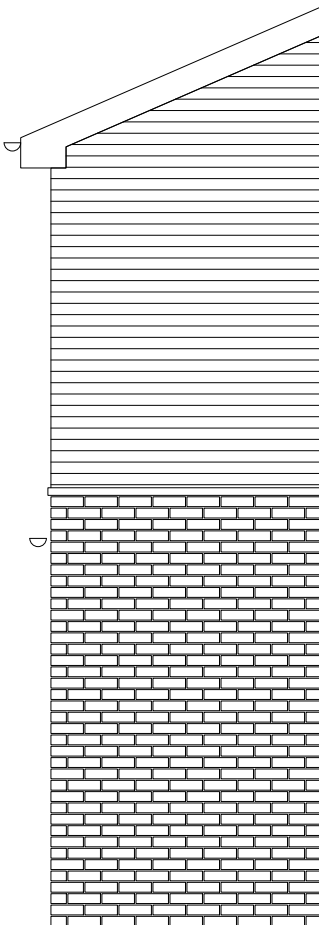

SIDE ELEVATION AS APPROVED

SITE BOUNDARY

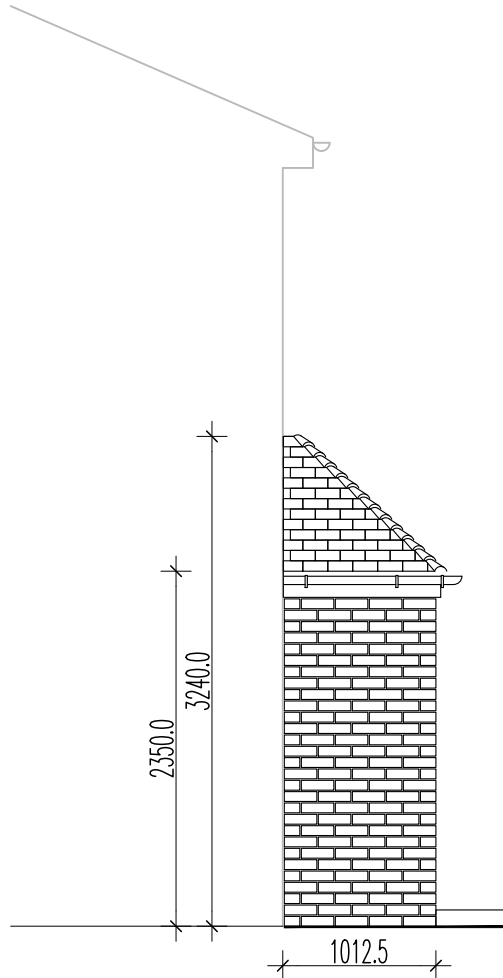


PARTY WALL ELEVATION AS BUILT



FRONT ELEVATION AS BUILT

7 LEAHOLME WAY

9 LEAHOLME WAY

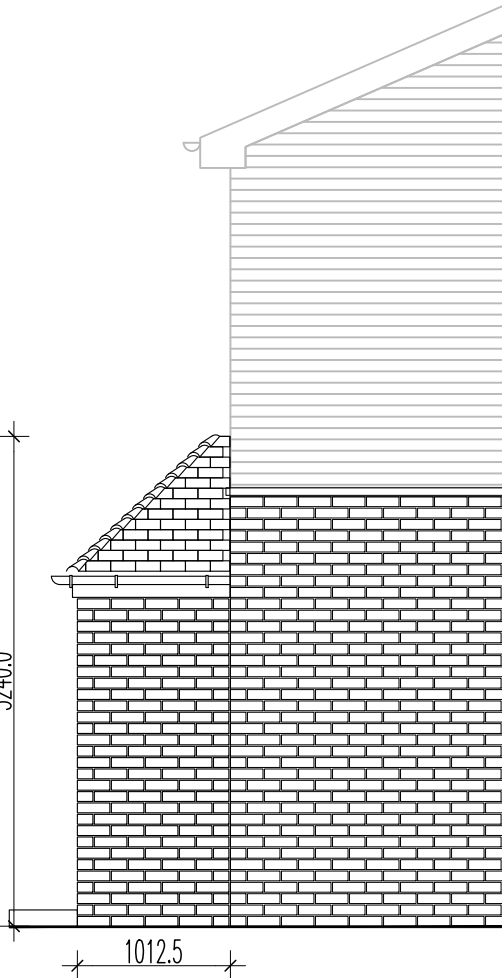

SIDE ELEVATION AS BUILT

SITE BOUNDARY

RMCI Design
tel 07776202245
e mail j.c@rmciworld.com

PROJECT:
9 LEAHOLME WAY
RUISLIP
HA4 7RA

TITLE:
SINGLE STOREY FRONT PORCH
AS BUILT

SCALE:
1:50@A1

DATE:
JULY 2024

DRAWN BY:
jtc

CHECKED BY:

ISSUE:
PLANNING

PROJ No:

DWG No:

REV:

A