
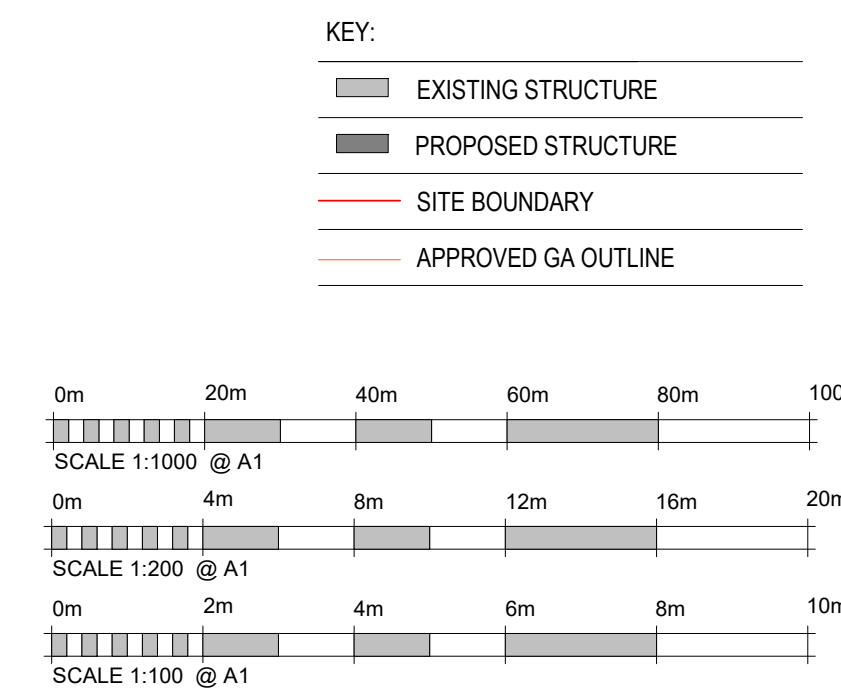
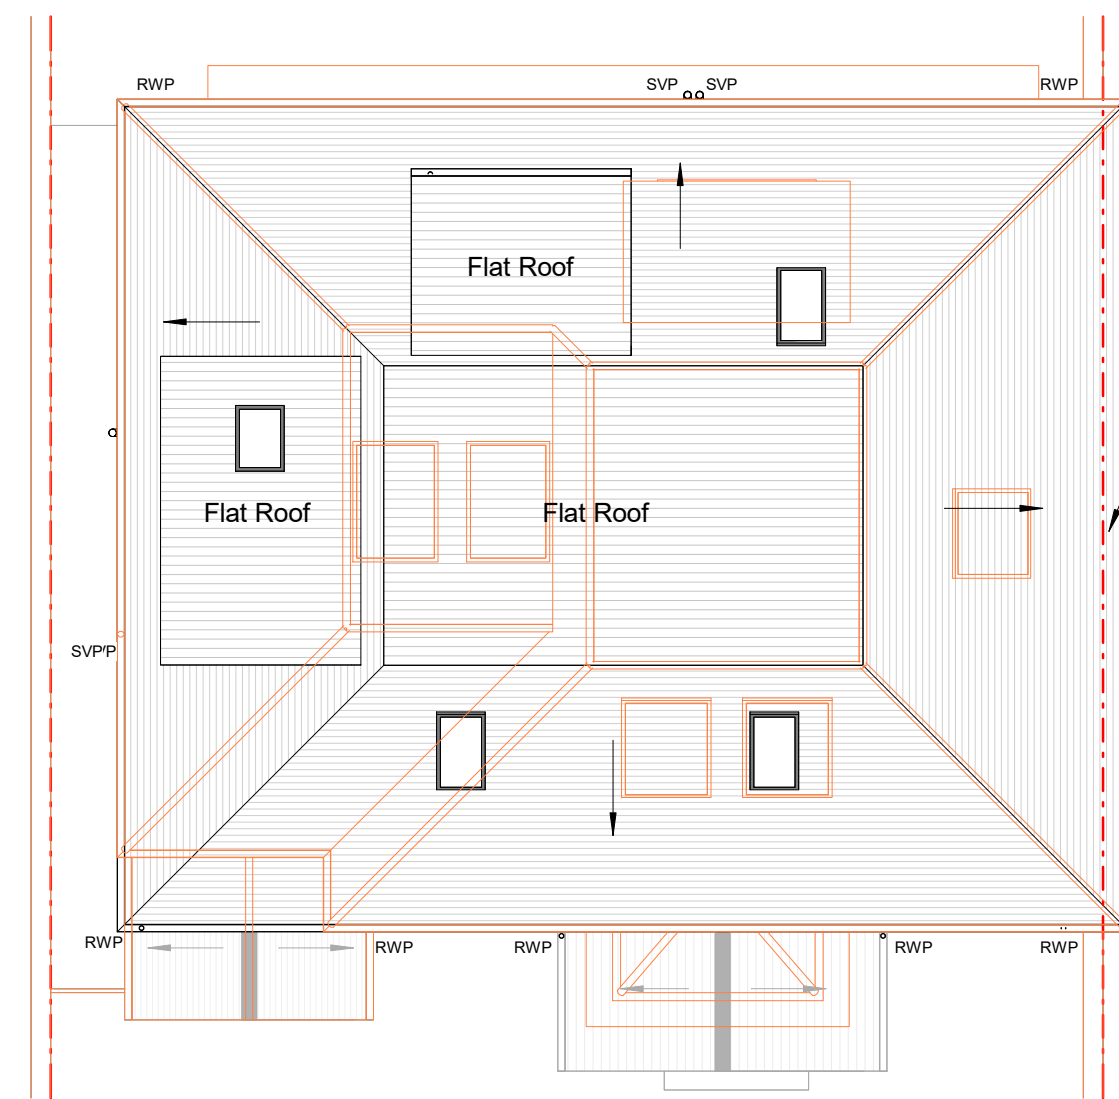
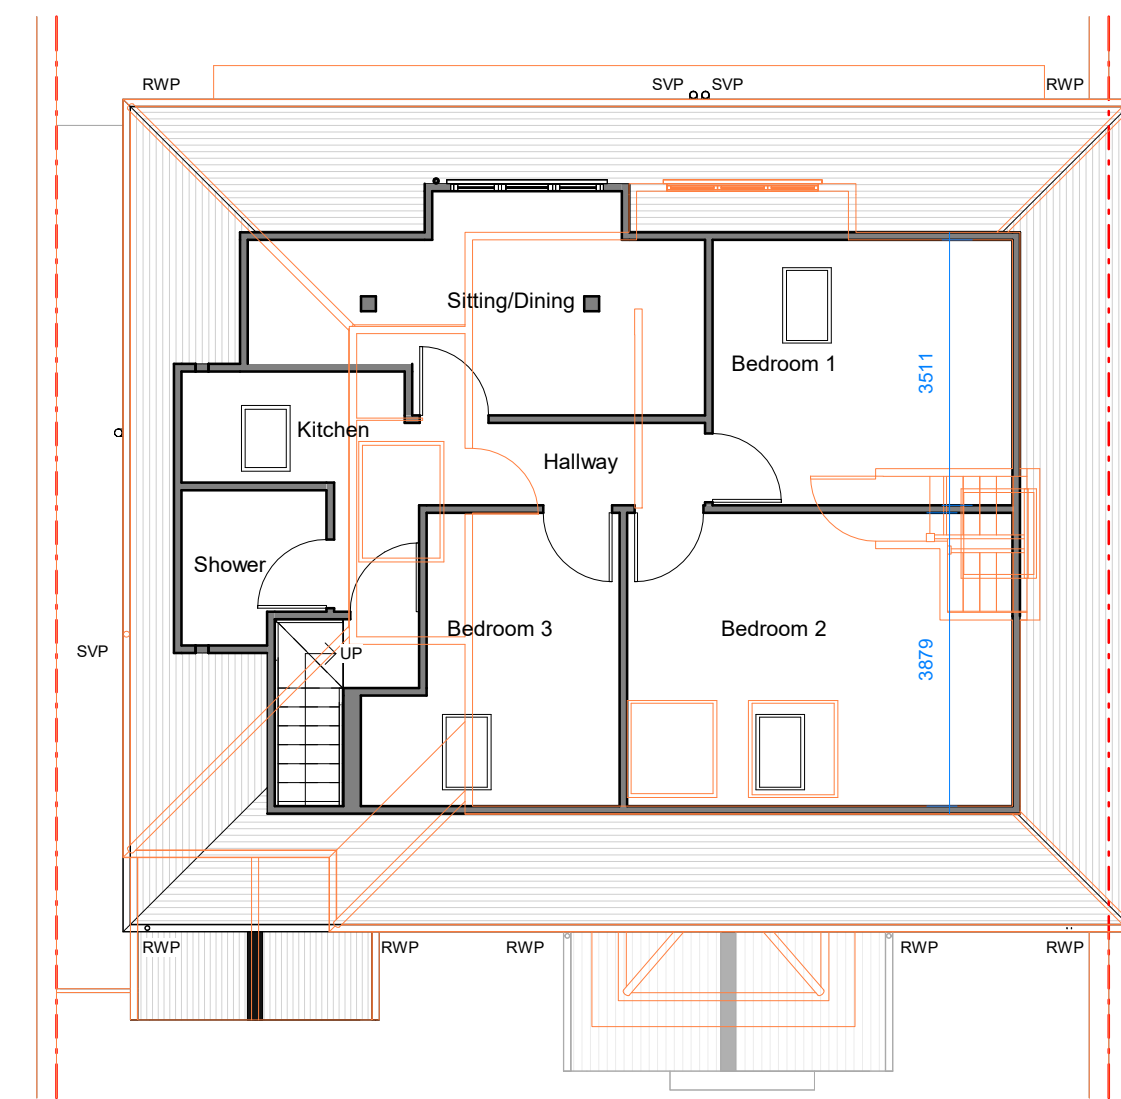
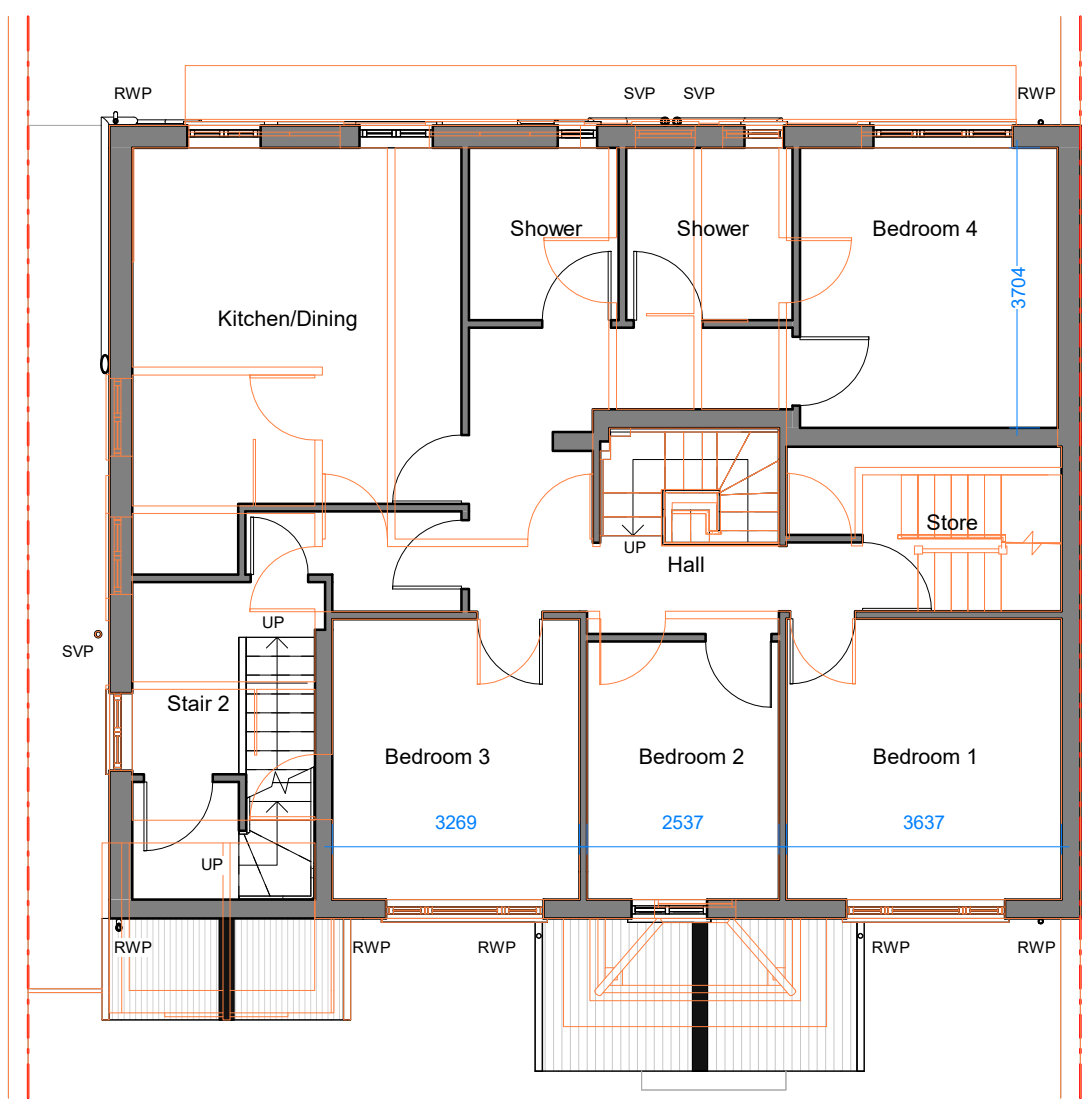


1 Proposed GF Plan As Approved
1 : 100
APPROVED UNDER APP REF NO.
6620/APP/2018/2694

2 Proposed 1F Plan As Approved
1 : 100
APPROVED UNDER APP REF NO.
6620/APP/2018/2694

3 Proposed Loft Plan As Approved
1 : 100
APPROVED UNDER APP REF NO.
6620/APP/2018/2694

4 Proposed Roof Plan As Approved
1 : 100
APPROVED UNDER APP REF NO.
6620/APP/2018/2694

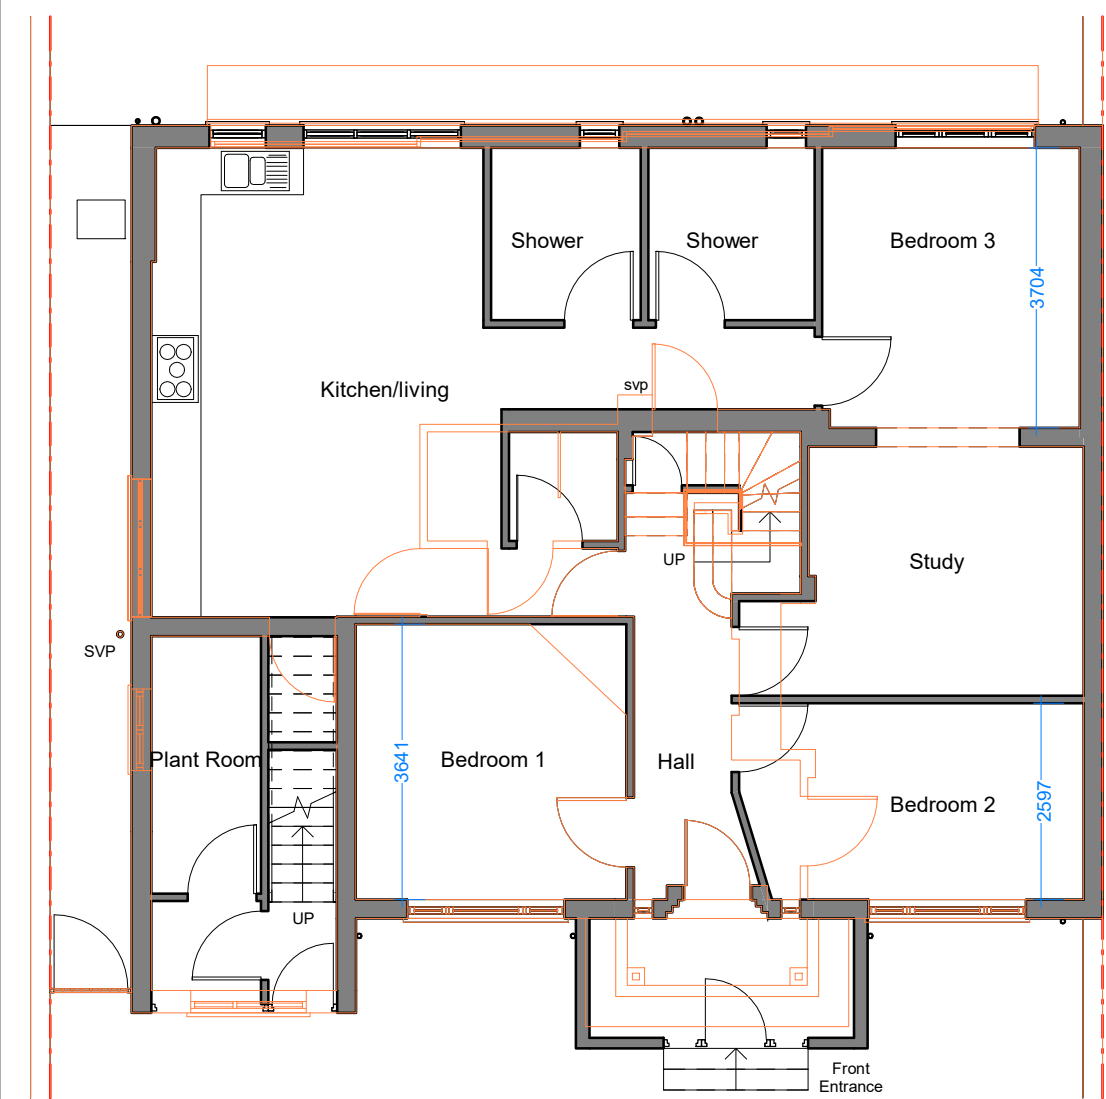

5 Proposed GF Plan- As Built
1 : 100

6 Proposed 1F Plan- As Built
1 : 100

7 Proposed Loft Plan- As Built
1 : 100

8 Proposed Roof Plan- As Built
1 : 100

As-Built Changes Compared to Approved Drawings:

PLAN CHANGE

SECTION 5: GROUND FLOOR

- CHANGE E1: Additional staircase to porch 2
CHANGE E2: sub-division of spaces to create additional bedrooms and showers.
All bedrooms comply with national space standard.
CHANGE E3: enlargement of the front porch, in line with no. 28

SECTION 6: FIRST FLOOR


- CHANGE F1: Removal of existing staircase.
CHANGE F2: sub-division of spaces to create additional kitchen

SECTION 7: SECOND FLOOR

- CHANGE G1: Removal of existing staircase.
CHANGE G2: sub-division of spaces to create additional bedroom & kitchen



PHOTO 1: FRONT VIEW OF NO. 28,
VIEW TOWARDS NO.30

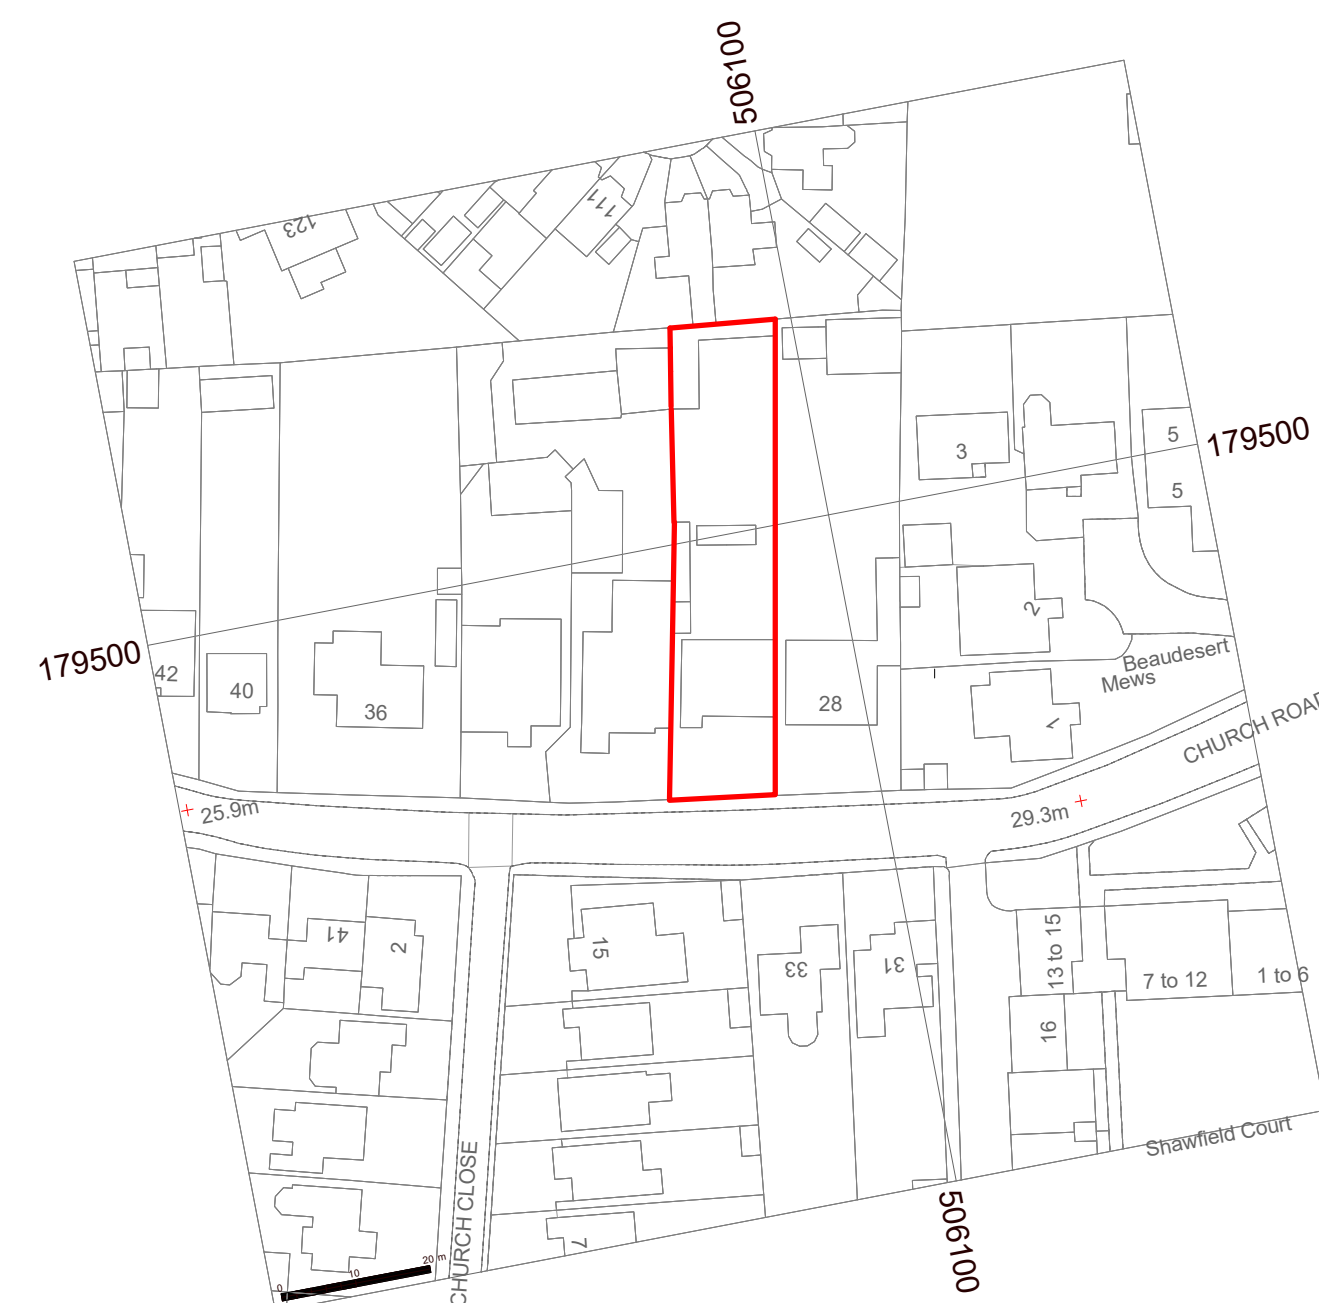

9 Location Plan
1 : 1000

J79 STUDIO

T: +44 (0)7742 071 052
W: info@j79studio.co.uk

Unit 312
Wey House
15 Church Street
Weybridge
KT13 8NA

PLANNING ISSUE P1

FOR CLIENT

CONFIRM ALL DESIGN WITH CLIENT ON SITE
BUILDING CONTROL APPROVAL TBC
ALL DIMENSION TO BE CHECKED ON SITE

This drawing is the property of J79 Studio. Copyright is reserved & this drawing is issued on the condition that it is not copied, reproduced, retained or disclosed to any unauthorised person, either wholly or in part, without our consent. Do not scale from this drawing, check all dimensions on site. Any errors please notify architect in the first instance.

Rev	Date	Note
P1	02-09-2025	PLANNING ISSUE 1

PROJECT

30 Church Rd UB7 7PU

DRAWING TITLE

APPROVED VS AS BUILT PLAN

STATUS

DRAWN BY

Author

Checker

PROJECT NO.	DATE	SCALE
2003	AUG 2025	1:100 @ A1

DRAWING NO.	REVISION
A100	P1