


1 Proposed East Side Elevation- As Approved  
1 : 100

APPROVED UNDER APP REF NO.  
6620/APP/2018/2694

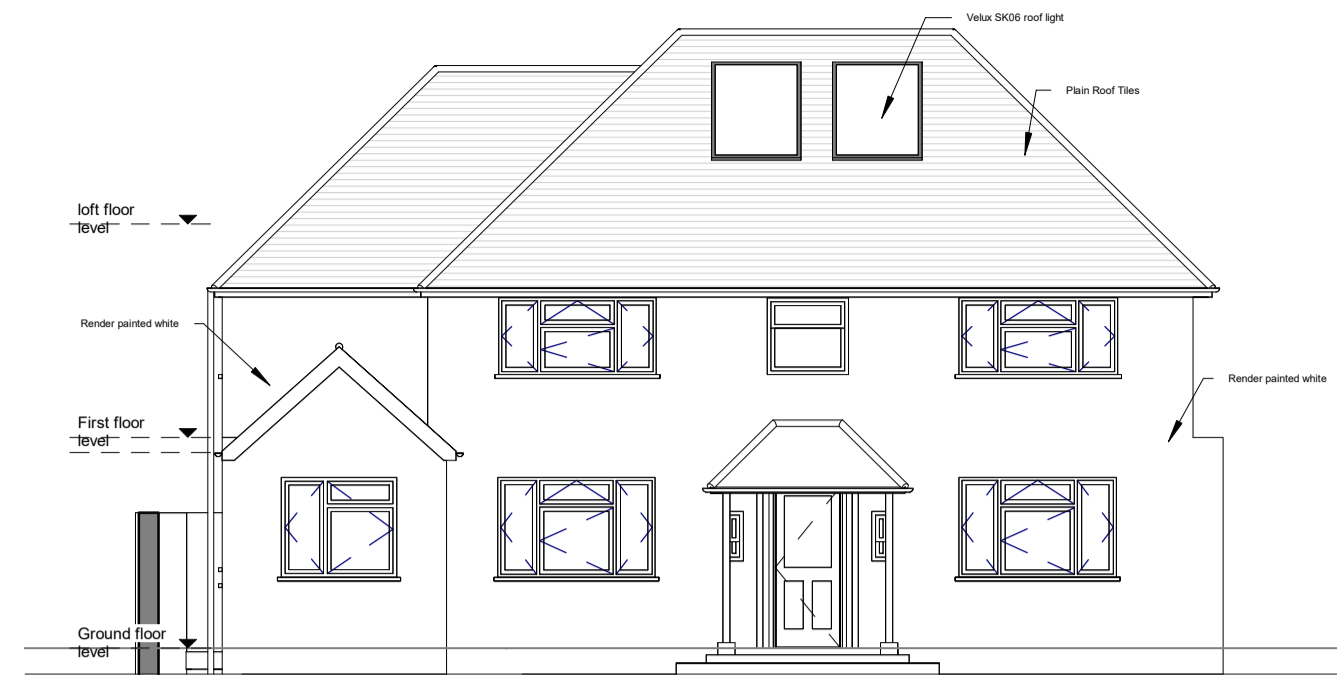

3 Proposed Front Elevation As Approved  
1 : 100

APPROVED UNDER APP REF NO.  
6620/APP/2018/2694




5 Proposed Rear Elevation As Approved  
1 : 100

APPROVED UNDER APP REF NO.  
6620/APP/2018/2694




7 Proposed West Side Elevation- As Approved  
1 : 100

APPROVED UNDER APP REF NO.  
6620/APP/2018/2694

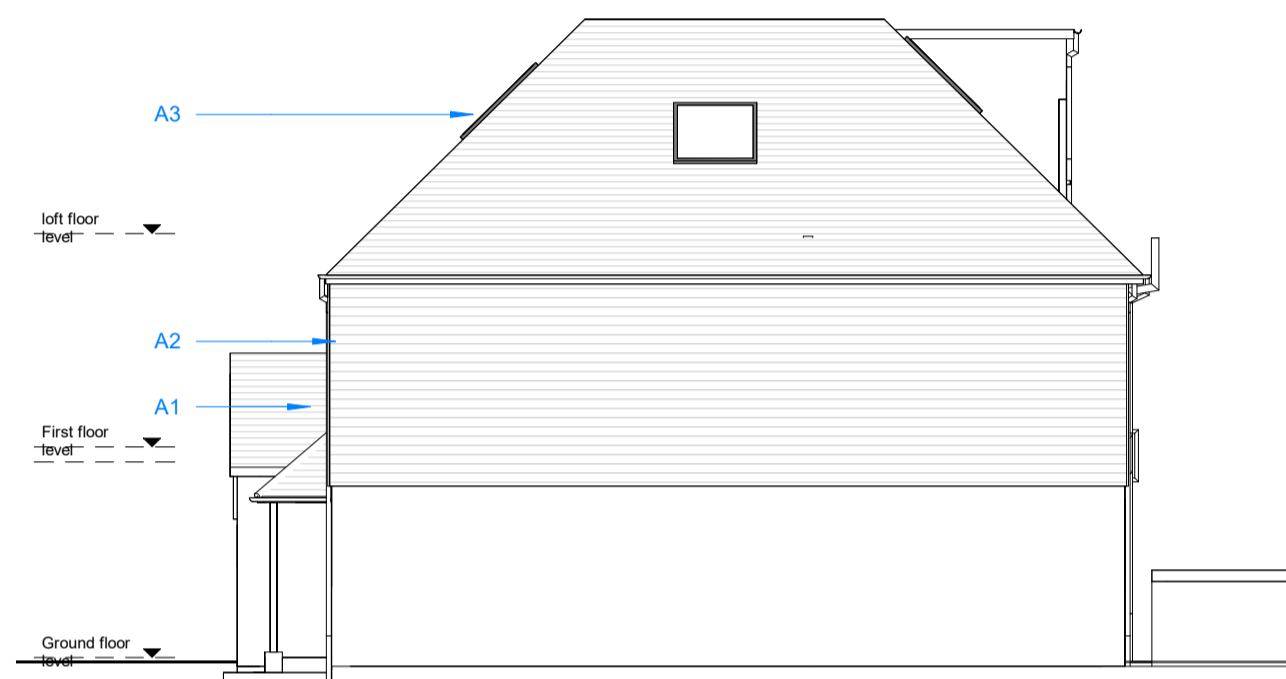


2 Proposed East Side Elevation  
1 : 100

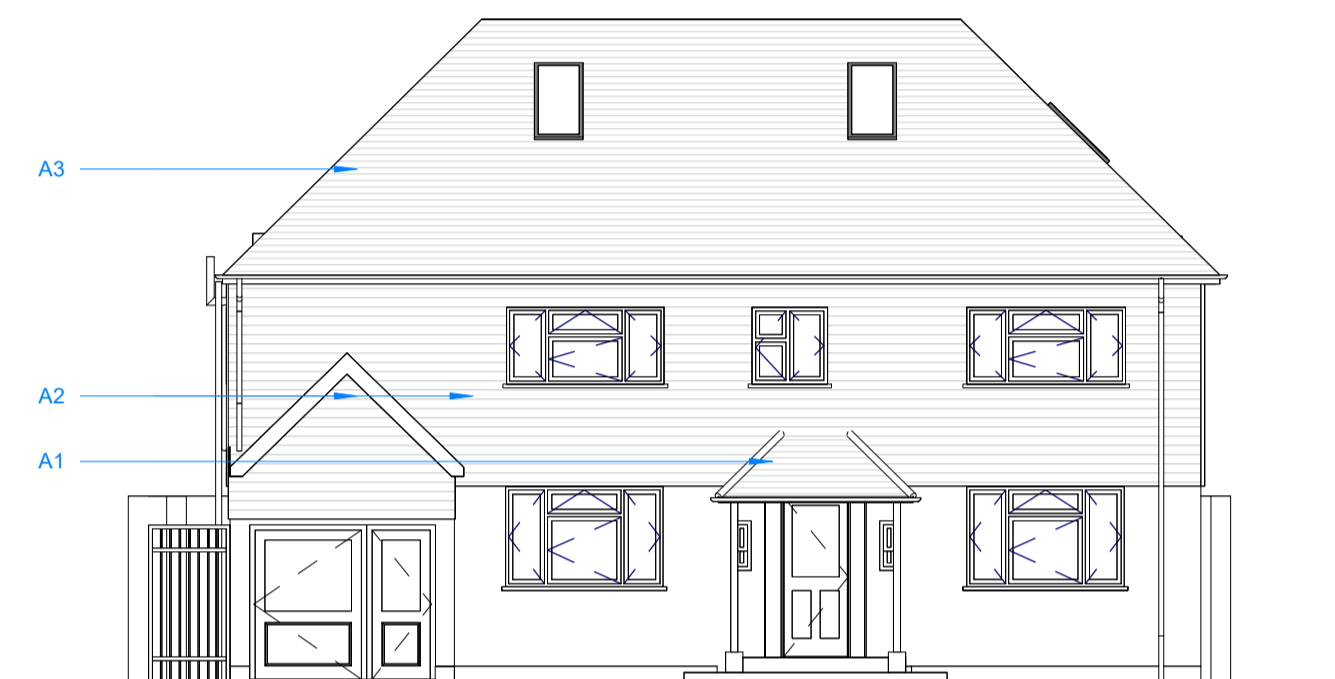

4 Proposed Front Elevation  
1 : 100



6 Proposed Rear Elevation  
1 : 100

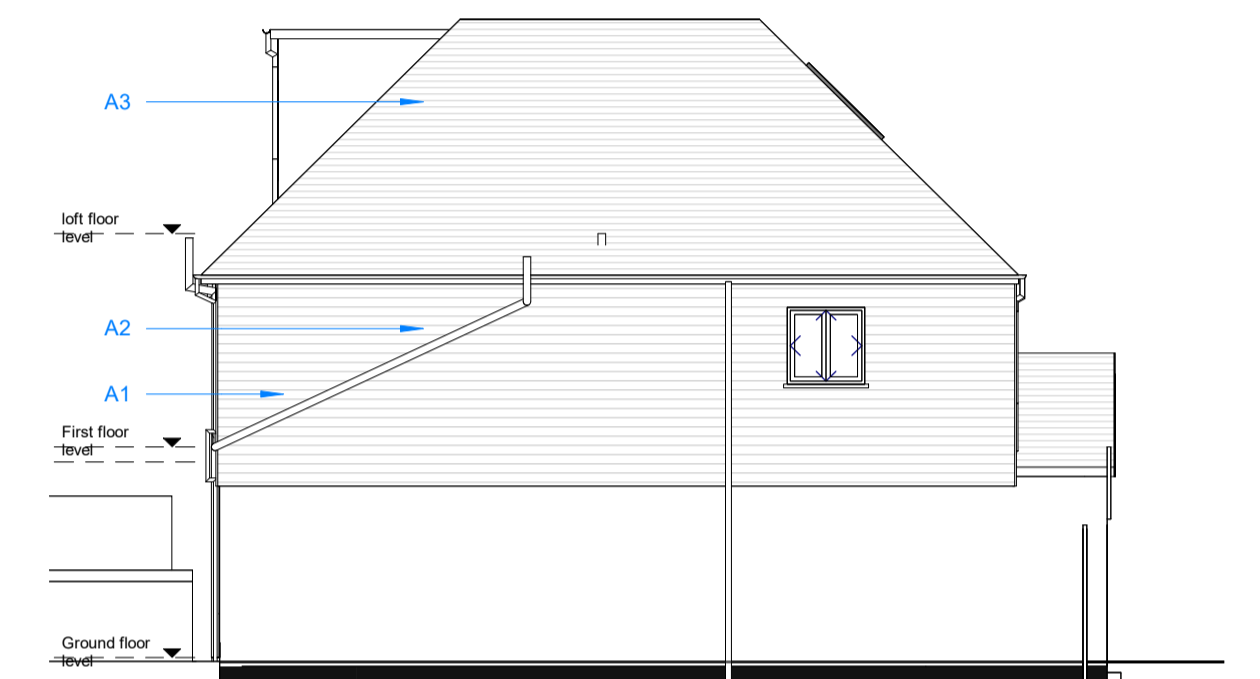

8 Proposed West Side Elevation  
1 : 100

As-Built Changes Compared to Approved Drawings:

SECTION 1: FRONT ELEVATION

- CHANGE A1: Porch to be altered in size to match existing building.
- CHANGE A2: Roof cladding facade cladding to 1F and entrance porch
- CHANGE A3: crown roof is match neighbouring building.

SECTION 2: EAST / SIDE ELEVATION

- CHANGE A2: Roof cladding facade cladding to 1F and entrance porch
- CHANGE A3: crown roof is match neighbouring building.




PHOTO 1: CHURCH RD VIEW TOWARDS NO. 28 AND NO.30



PHOTO 2: CHURCH RD VIEW TOWARDS NO. 28 AND NO.30



PHOTO 3: CHURCH RD VIEW TOWARDS THE REAR OF NO. 28 AND NO.30

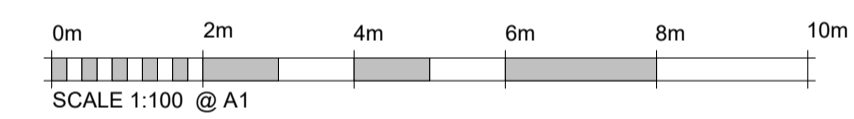

**J79 STUDIO**  
 T:+44 (0)7742 071 052  
 W: info@j79studio.co.uk  
 Unit 312  
 Wey House  
 15 Church Street  
 Weybridge  
 KT13 8NA

**PLANNING ISSUE P1**

FOR CLIENT

CONFIRM ALL DESIGN WITH CLIENT ON SITE  
 BUILDING CONTROL APPROVAL TBC  
 ALL DIMENSION TO BE CHECKED ON SITE

This drawing is the property of J79 Studio. Copyright is reserved & this drawing is issued on the condition that it is not copied, reproduced, retained or disclosed to any unauthorised person, either wholly or in part, without our consent. Do not scale from this drawing, check all dimensions on site. Any errors please notify architect in the first instance.

Rev	Date	Note
P1	25-03-2026	PLANNING ISSUE 1

PROJECT	30 Church Rd UB7 7PU	
DRAWING TITLE	APPROVED VS AS BUILT ELEVATION	
STATUS	2 X FLAT DEVELOPMENT	
DRAWN BY	Author	Checker

PROJECT NO.	DATE	SCALE
2003	MAR 2026	1:100 @ A1
DRAWING NO.	REVISION	
A101	P1	

HMO 6 PPL APR 2026