


6 Front Elevation - As BUILT
1 : 100


5 EAST Elevation - As BUILT
1 : 100

7 Rear Elevation - As BUILT
1 : 100


8 West Side Elevation - As BUILT
1 : 100

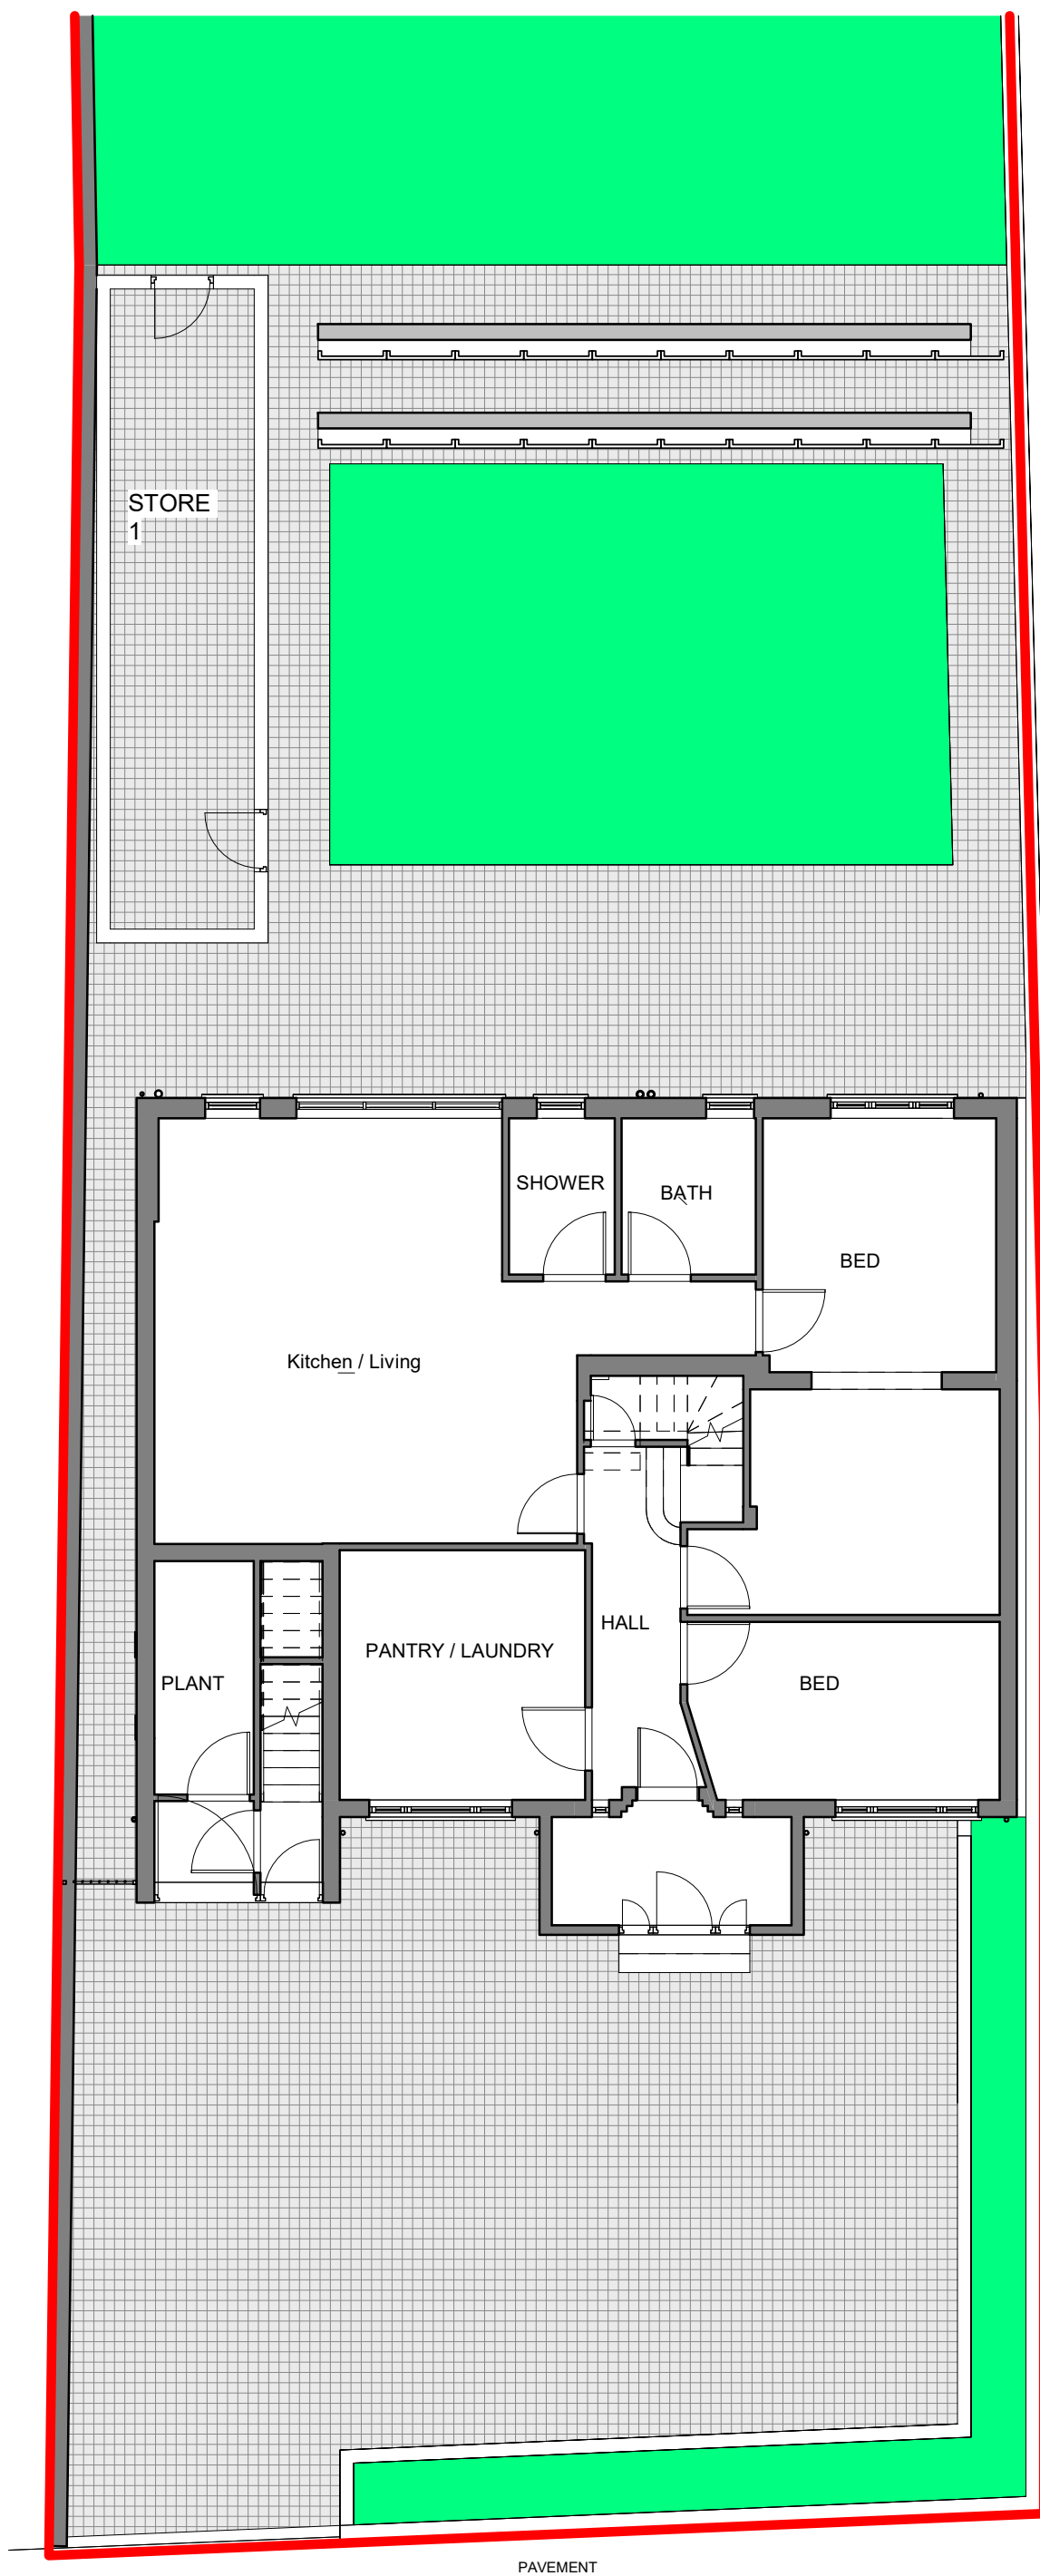


1 GF Plan -AS BUILT
1 : 100

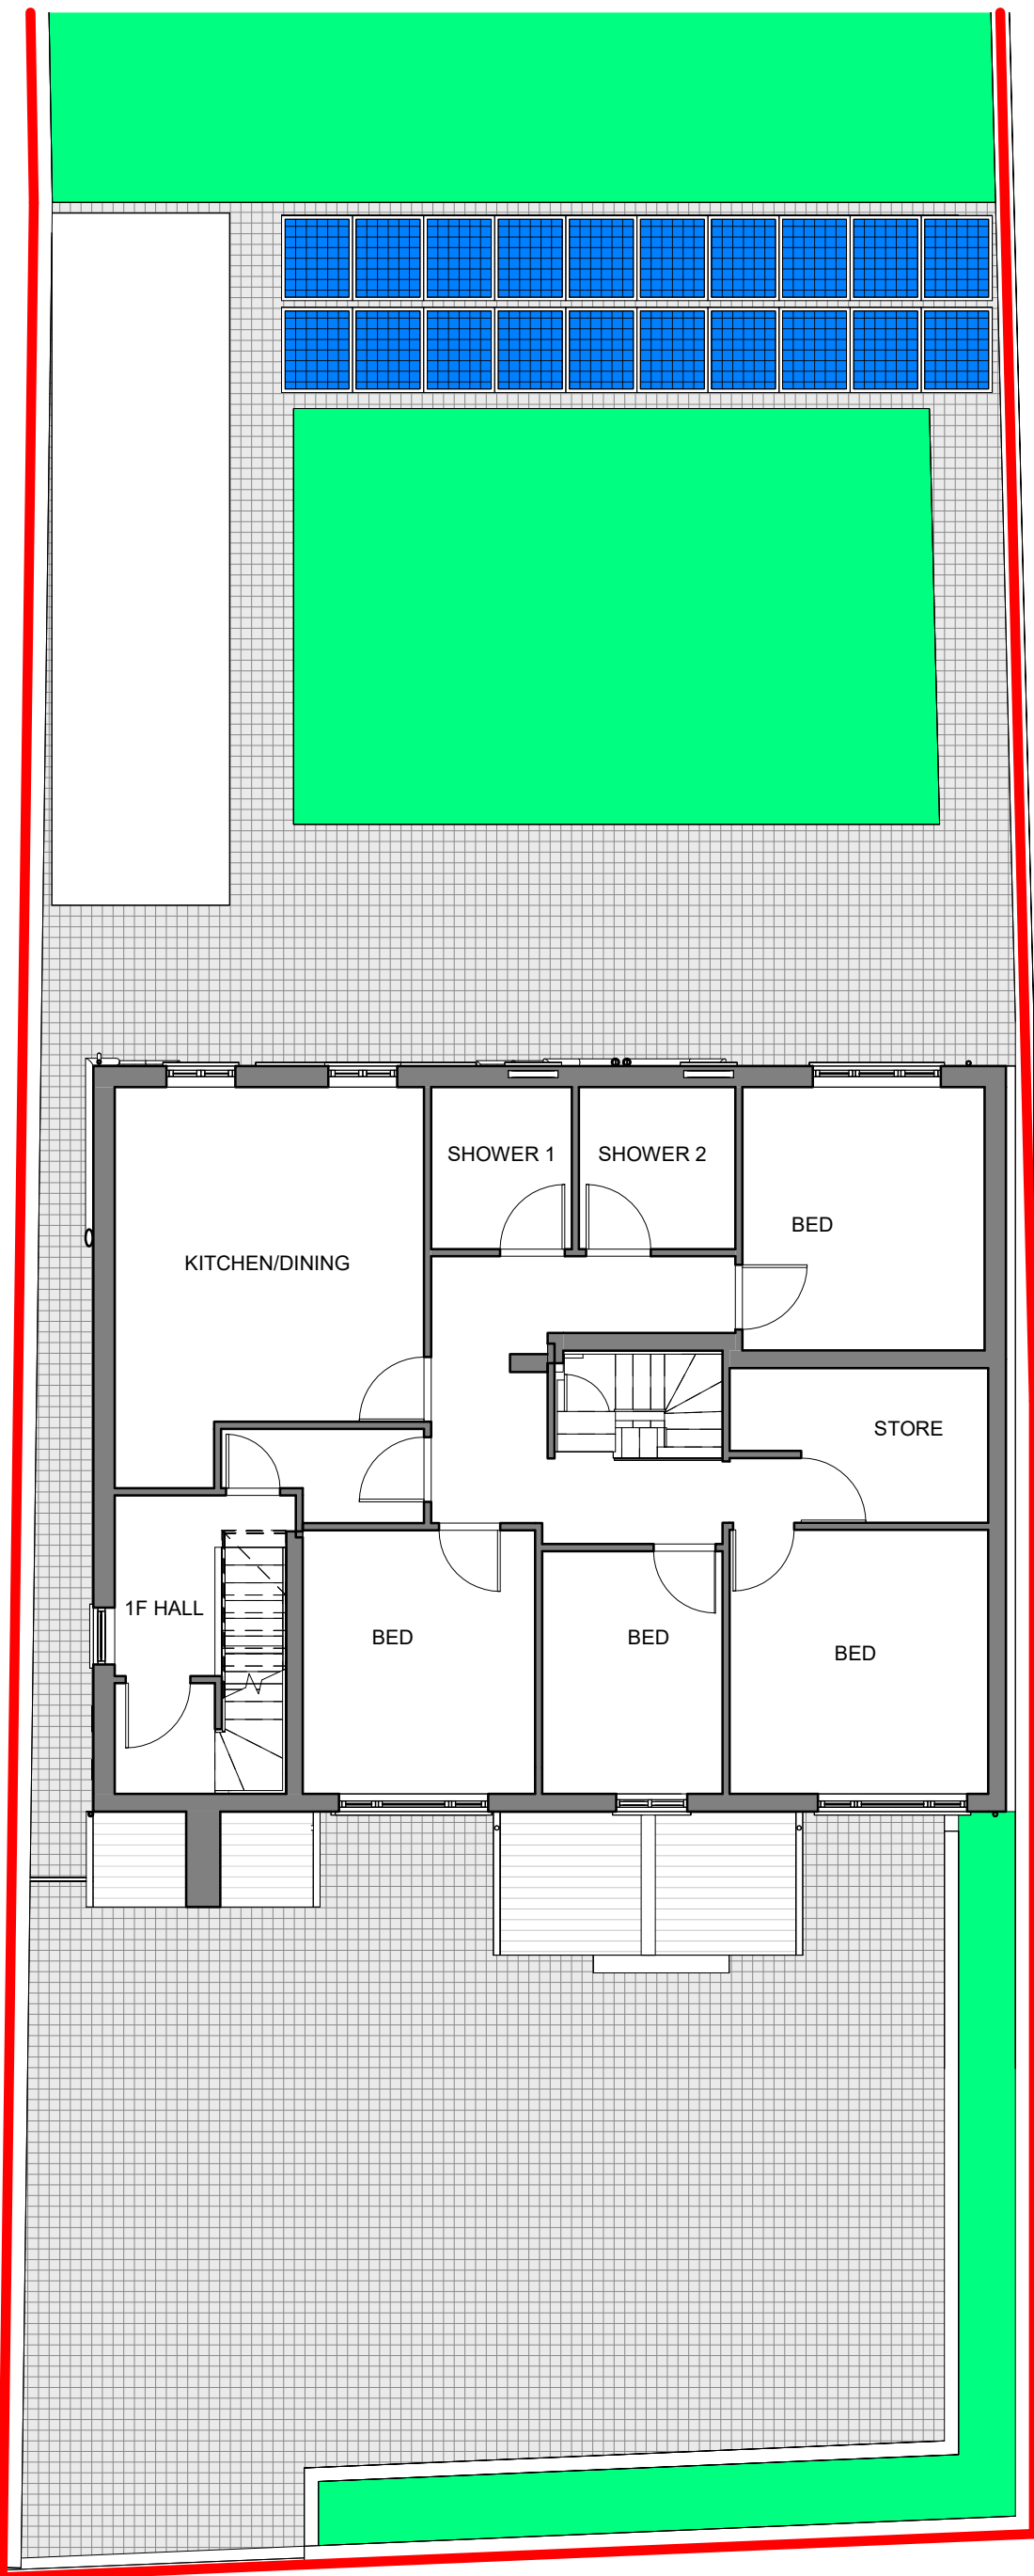

2 1F Plan - AS BUILT
1 : 100

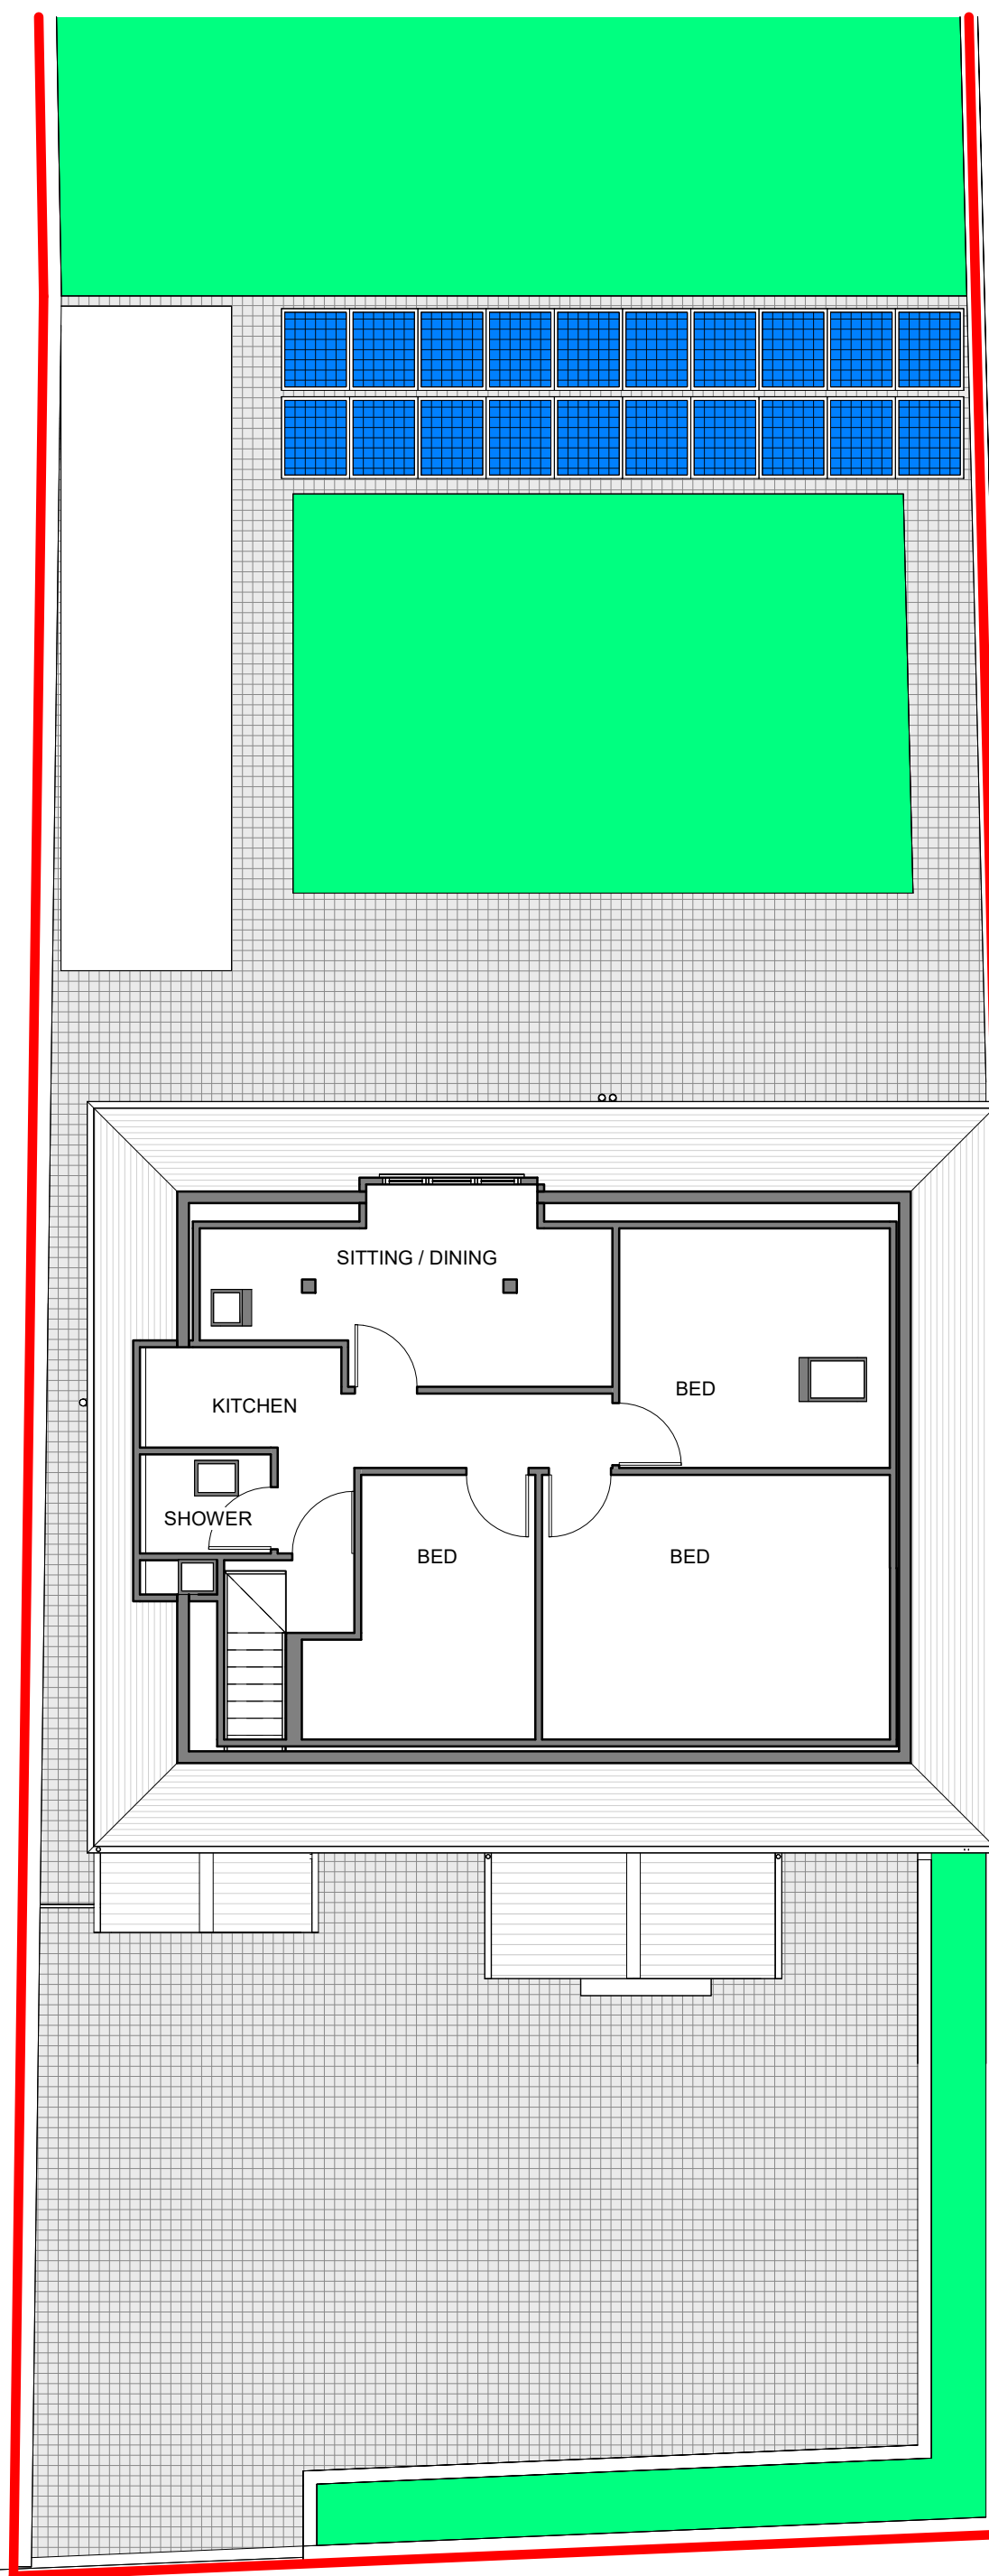

3 Loft Plan - AS BUILT
1 : 100

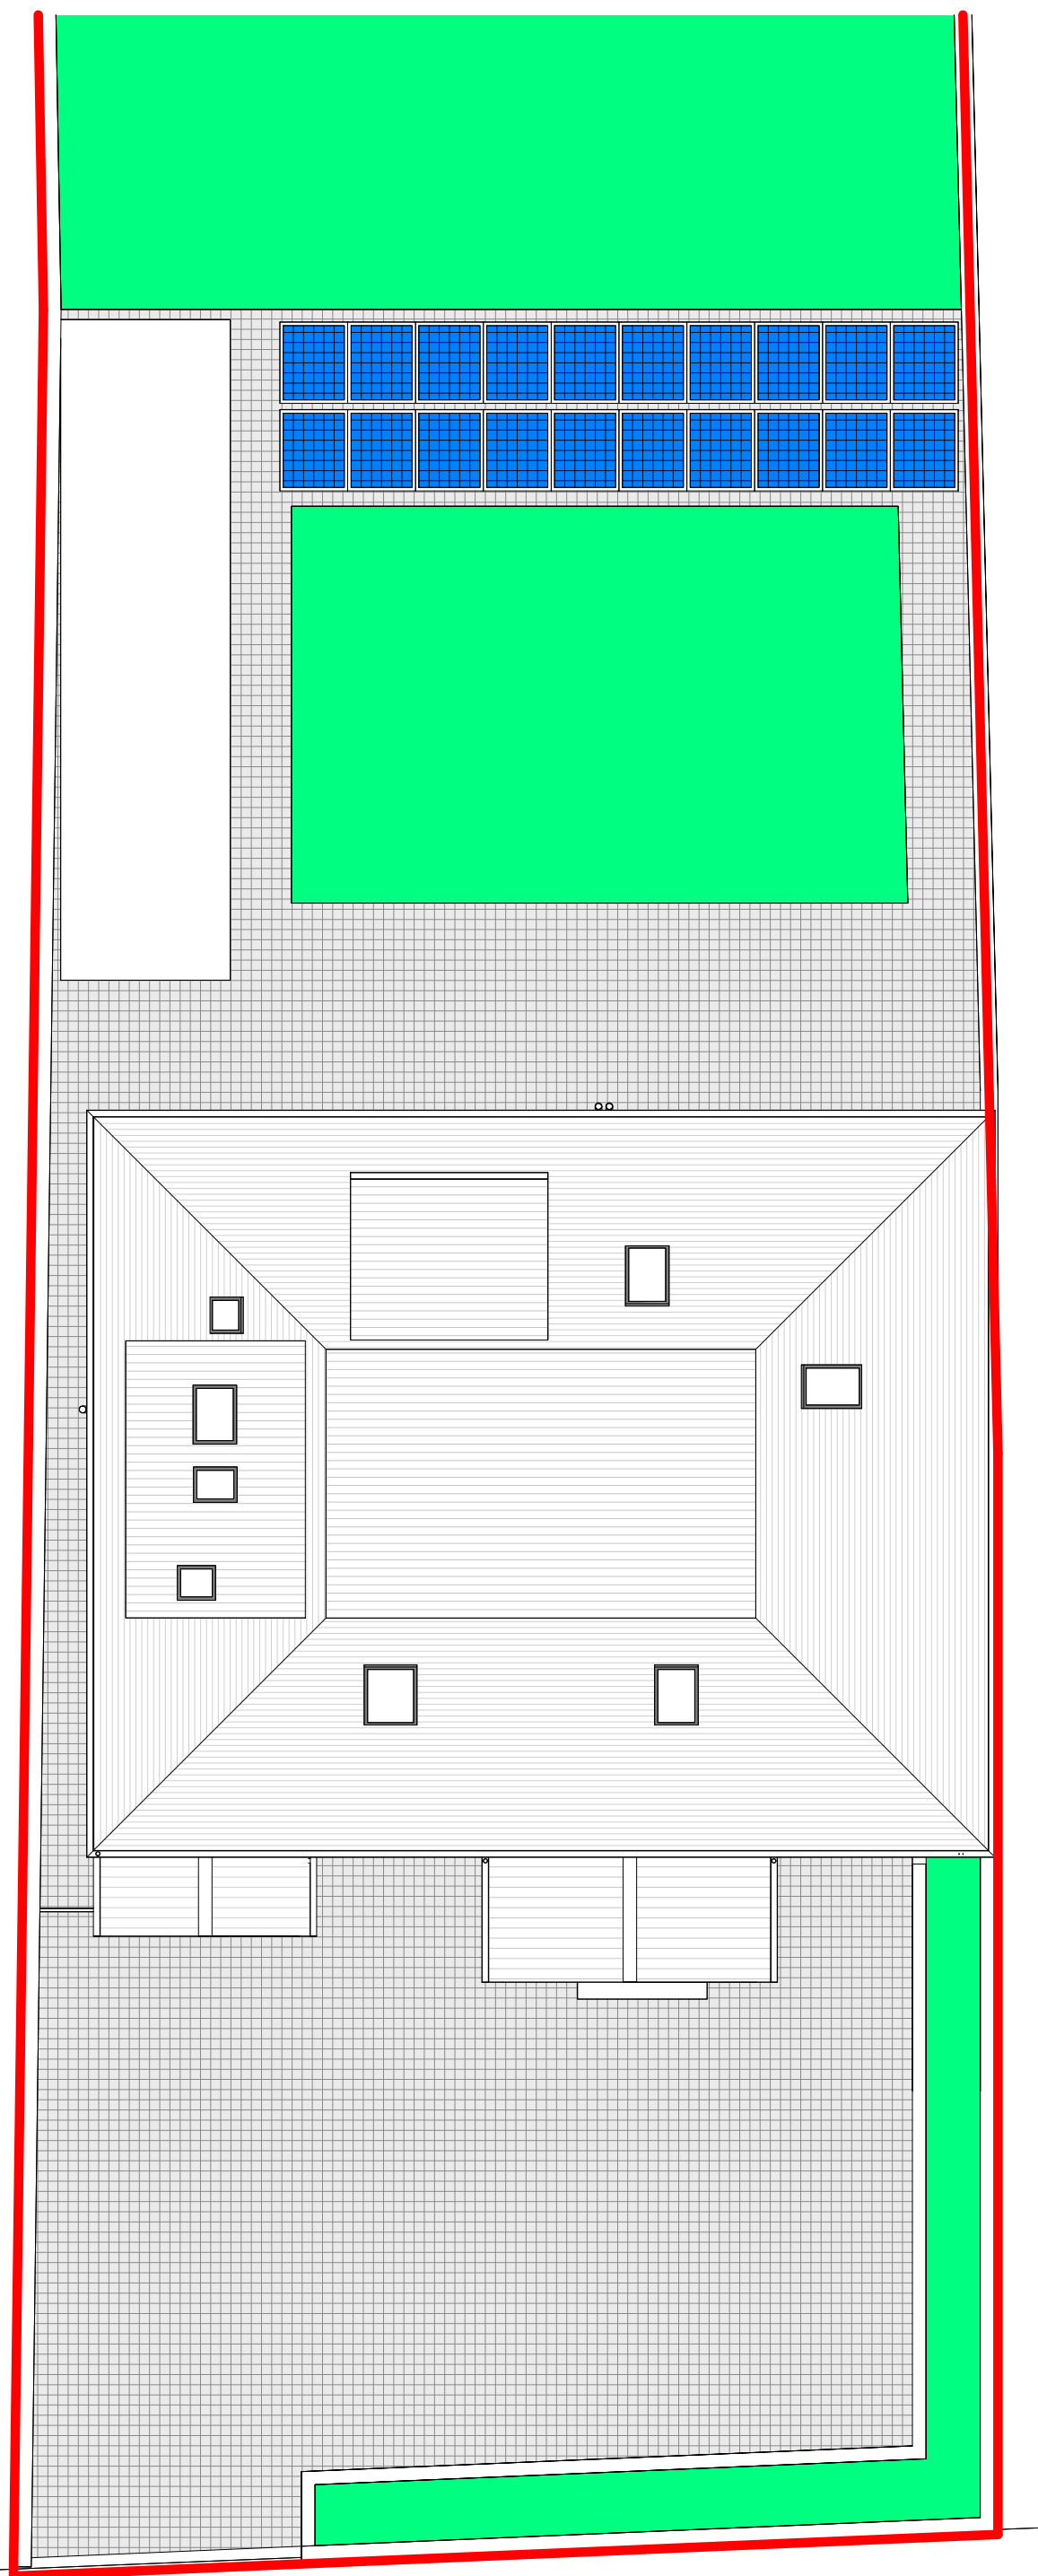

4 Roof Plan - AS BUILT
1 : 100

AS BUILT DRAWINGS

0m 2m 4m 6m 8m 10m
SCALE 1:100 @ A1

J79 STUDIO

T: +44 (0)7742 071 052
W: info@j79studio.co.uk

Unit 312
Wey House
15 Church Street
Weybridge
KT13 8NA

HMO 6 PPL APR 2026

PLANNING ISSUE P3

FOR CLIENT

CONFIRM ALL DESIGN WITH CLIENT ON SITE
BUILDING CONTROL APPROVAL TBC
ALL DIMENSION TO BE CHECKED ON SITE

This drawing is the property of J79 Studio. Copyright is reserved & this drawing is issued on the condition that it is not copied, reproduced, retained or disclosed to any unauthorised person, either wholly or in part, without our consent. Do not scale from this drawing, check all dimensions on site. Any errors please notify architect in the first instance.

Rev	Date	Note
P1	25-03-2026	PLANNING ISSUE 1
P2	26-05-2026	PLANNING ISSUE 2
P3	29-05-2026	PLANNING ISSUE 3

PROJECT	30 Church Rd UB7 7PU	
DRAWING TITLE	AS BUILT GA DRAWINGS	
STATUS	HMO 6 PPL	
DRAWN BY	Author	Checker

PROJECT NO.	DATE	SCALE
2003	MAR 2026	1:100 @ A1
DRAWING NO.	REVISION	
A102	P3	