



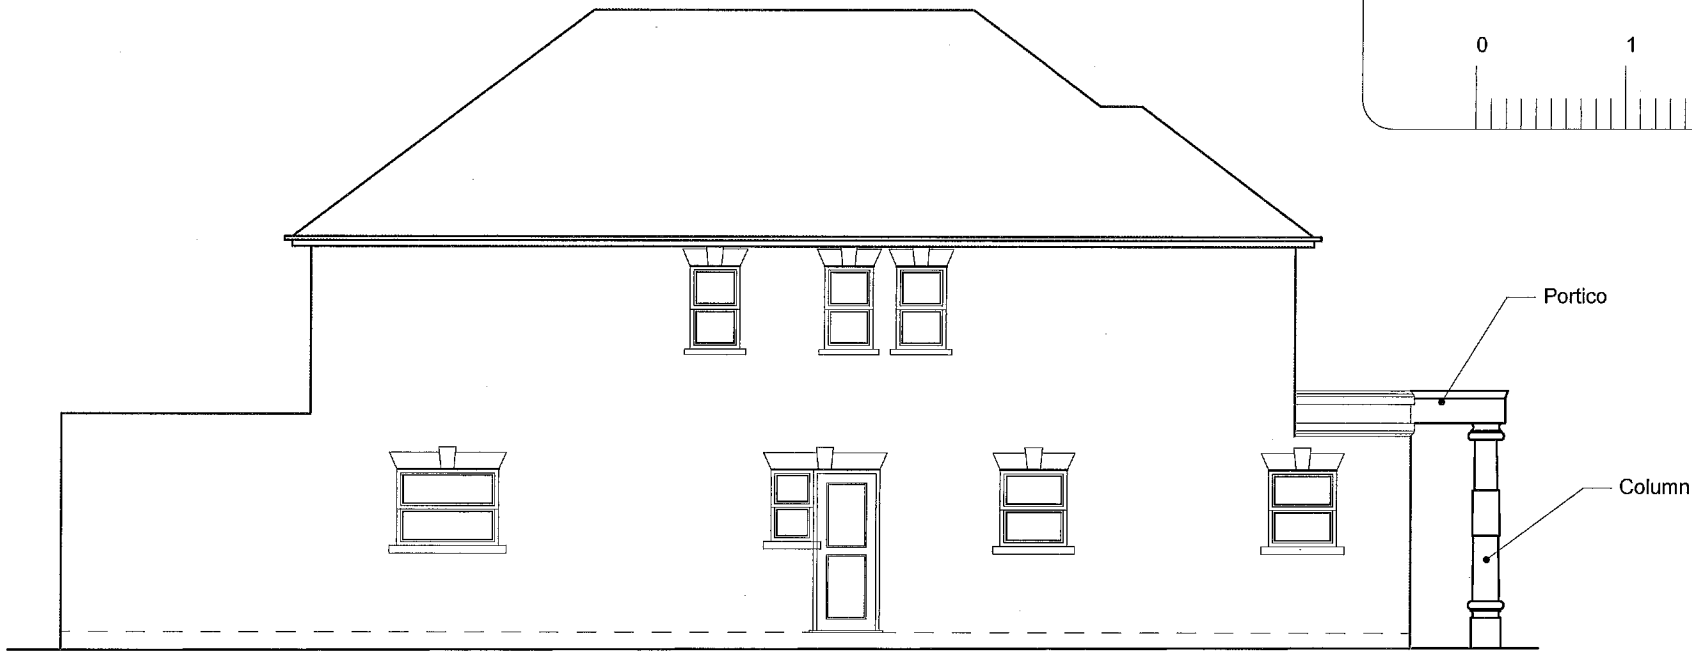


PROPOSED LEFT SIDE ELEVATION

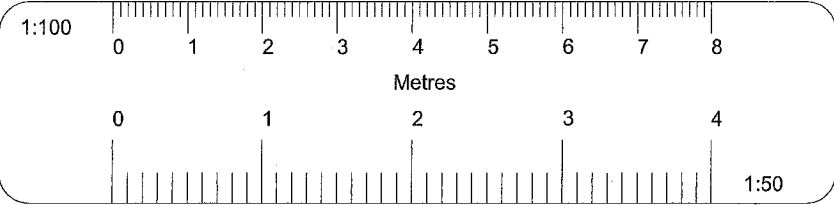

PROPOSED FRONT ELEVATION

PROPOSED PORTICO TO CONSIST
OF CAST STONE FINISH COLUMNS,
ARCHITRAVE & CORNICE.

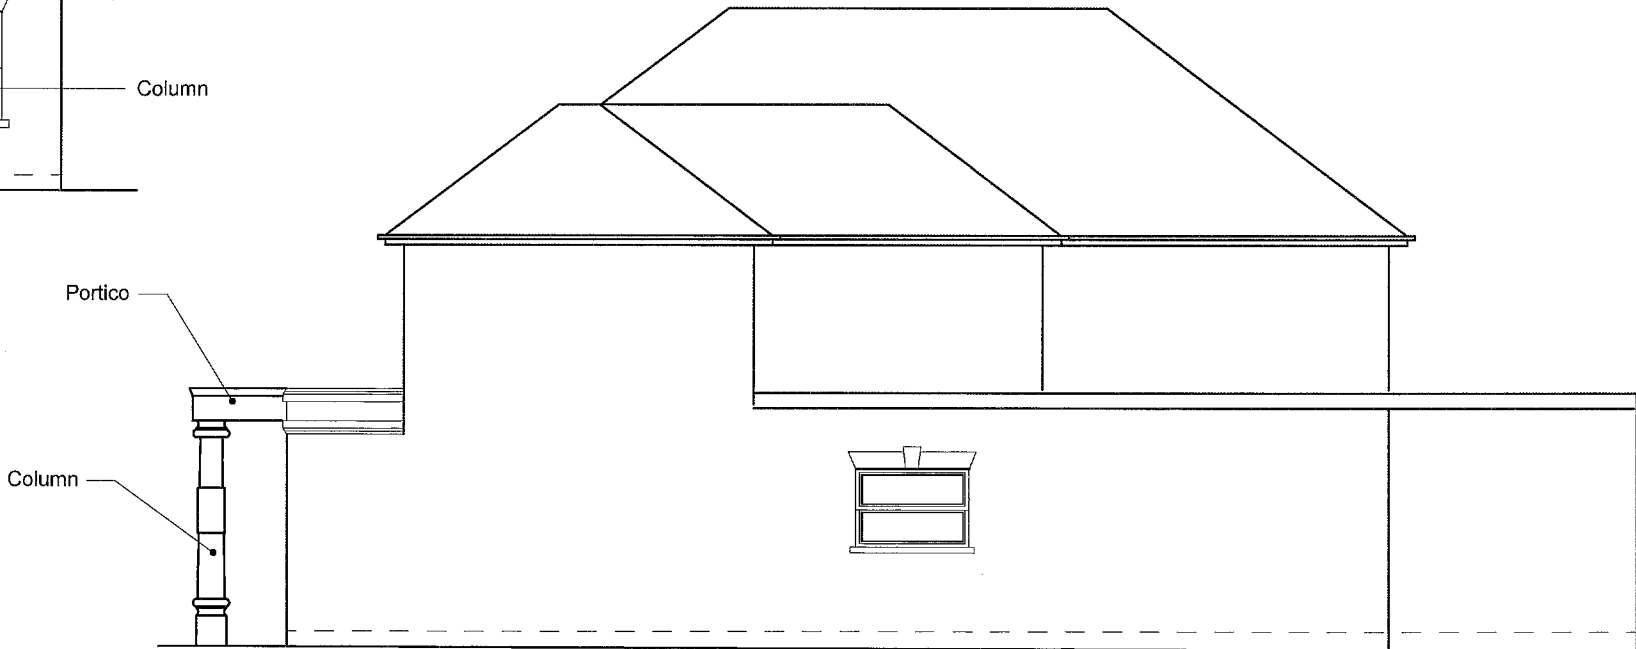

PROPOSED RIGHT SIDE ELEVATION

All dimensions verified on site.
All work to comply with British Standards, Code of practice.
All internal works to be in accordance with client instructions.
All external surfaces to match existing.
All work to be to the satisfaction of the local authority-building surveyor.
Builder to serve building notice and comply fully in all respects.
Owner responsible for compliance with 1.Party Wall etc Act 1996. 2. Thames water Build Over Agreement.
Builder to ensure all work in compliance with Build Over agreement as approved by

Thames Water
All proprietary materials to manufacturers recommendations
Works to boiler/Gas to be carried out by Gas Safe registered installer and to Gas Safe recommendations

All wiring and electrical work will be designed, installed, inspected and tested in accordance with the requirements of BS 7671:2001 (2004), the 17th edition Wiring Guidance and Building Regulation Part P (Electrical Safety) by a competent person registered with an electrical self-certification scheme, (BRE, BSI, ELECSA, NAPIT, or NICEIC), authorised by the Secretary of State

The competent person is to send a self-certification certificate to the Local Authority Building Control Department within 30 days of completion of the electrical works. The client must receive both a copy of the self-certification certificate and a BS 7671:2001 (2004) Electrical Installation Test Certificate and forward copies to the Local Authority Building Control Dept.

DATE	REVISION

COPYRIGHT:
PLANS 4 U LTD.
15 NORTH PARADE
NORTH ROAD MIDDX
SOUTHALL UB1 2LF
TEL: 07775 900565
E-MAIL: planningpermission1@hotmail.com


JOB TITLE:
1 HIGHFIELD DRIVE,
ICKENHAM

DRAWING TITLE:
PROPOSED ELEVATIONS

SCALE : 1:100

DATE: 25/03/2019 DRAWN BY:

DRG. NO.	REV.
19/1/HDI/204	

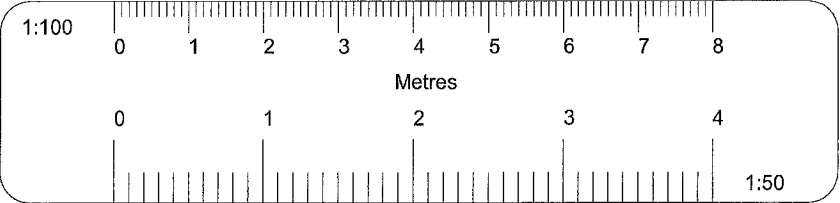


All dimensions verified on site.
All work to comply with British Standards, Code of practice.
All internal works to be in accordance with client instructions.
All external surfaces to match existing.
All work to be to the satisfaction of the local authority-building surveyor.
Builder to serve building notice and comply fully in all respects.
Owner responsible for compliance with 1.Party Wall etc Act 1996. 2. Thames water Build Over Agreement.
Builder to ensure all work in compliance with Build Over agreement as approved by

Thames Water
All proprietary materials to manufacturers recommendations
Works to boiler/Gas to be carried out by Gas Safe registered installer and to Gas Safe recommendations

All wiring and electrical work will be designed, installed, inspected and tested in accordance with the requirements of BS 7671:2001 (2004), the 17th edition Wiring Guidance and Building Regulation Part P (Electrical Safety) by a competent person registered with an electrical self-certification scheme, (BRE, BSI, ELECSA, NAPIT, or NICEIC), authorised by the Secretary of State


The competent person is to send a self-certification certificate to the Local Authority Building Control Departement within 30 days of completion of the electrical works. The client must receive both a copy of the self-certification certificate and a BS 7671:2001 (2004) Electrical Installation Test Certificate and forward copies to the Local Authority Building Control Dept.

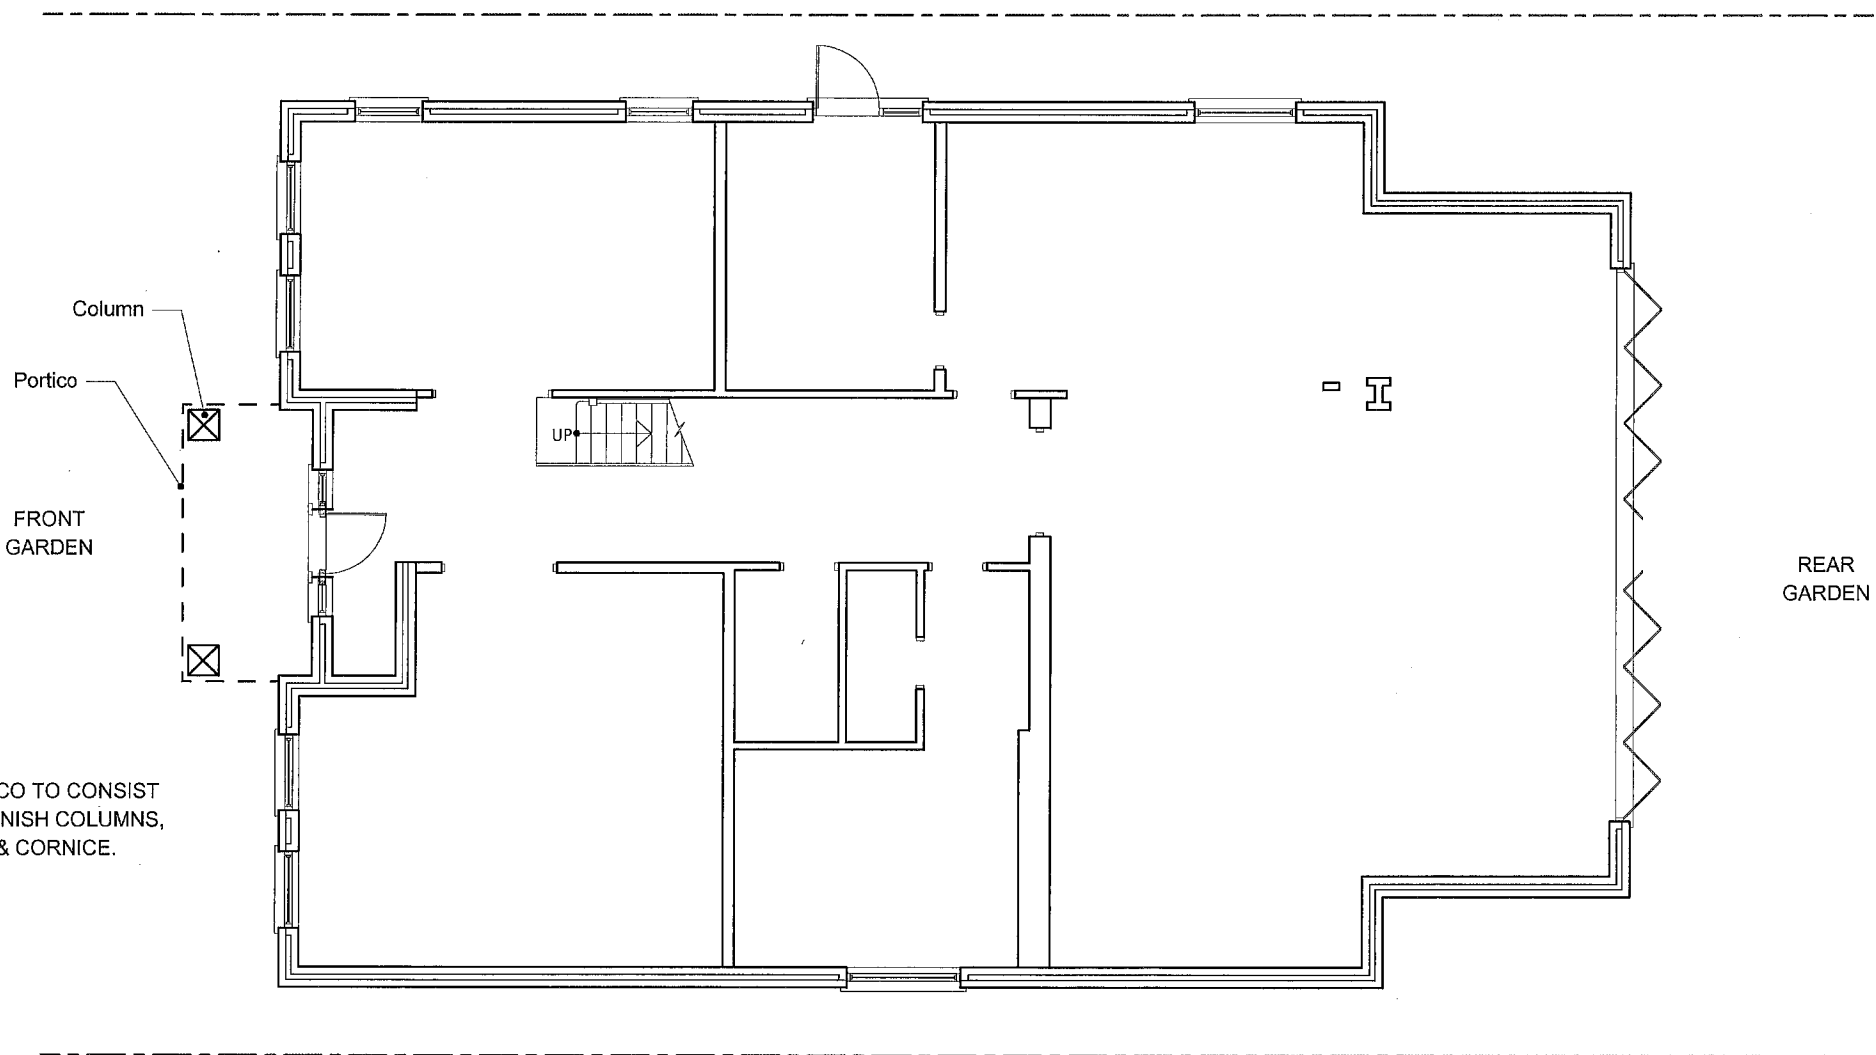

PROPOSED PORTICO TO CONSIST OF CAST STONE FINISH COLUMNS, ARCHITRAVE & CORNICE.

PROPOSED GROUND FLOOR PLAN


	DATE	REVISION
COPYRIGHT: PLANS 4 U LTD. 15 NORTH PARADE NORTH ROAD MIDDX SOUTHALL UB1 2LF TEL: 07775 900555 E-MAIL: planningpermission1@hotmail.com		
JOB TITLE: 1 HIGHFIELD DRIVE, ICKENHAM		
DRAWING TITLE: PROPOSED GROUND FLOOR PLAN		
SCALE : 1:100		
DATE: 25/03/2019		DRAWN BY:
DRG. NO. 19/1/HDI/203		REV.

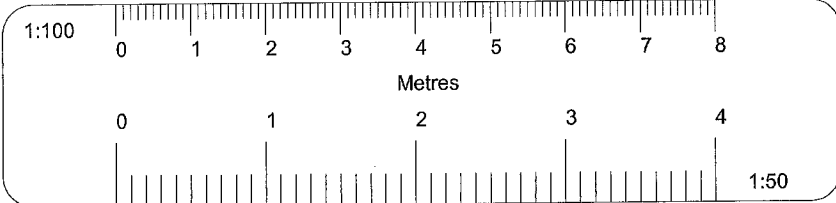

EXISTING LEFT SIDE ELEVATION



EXISTING FRONT ELEVATION

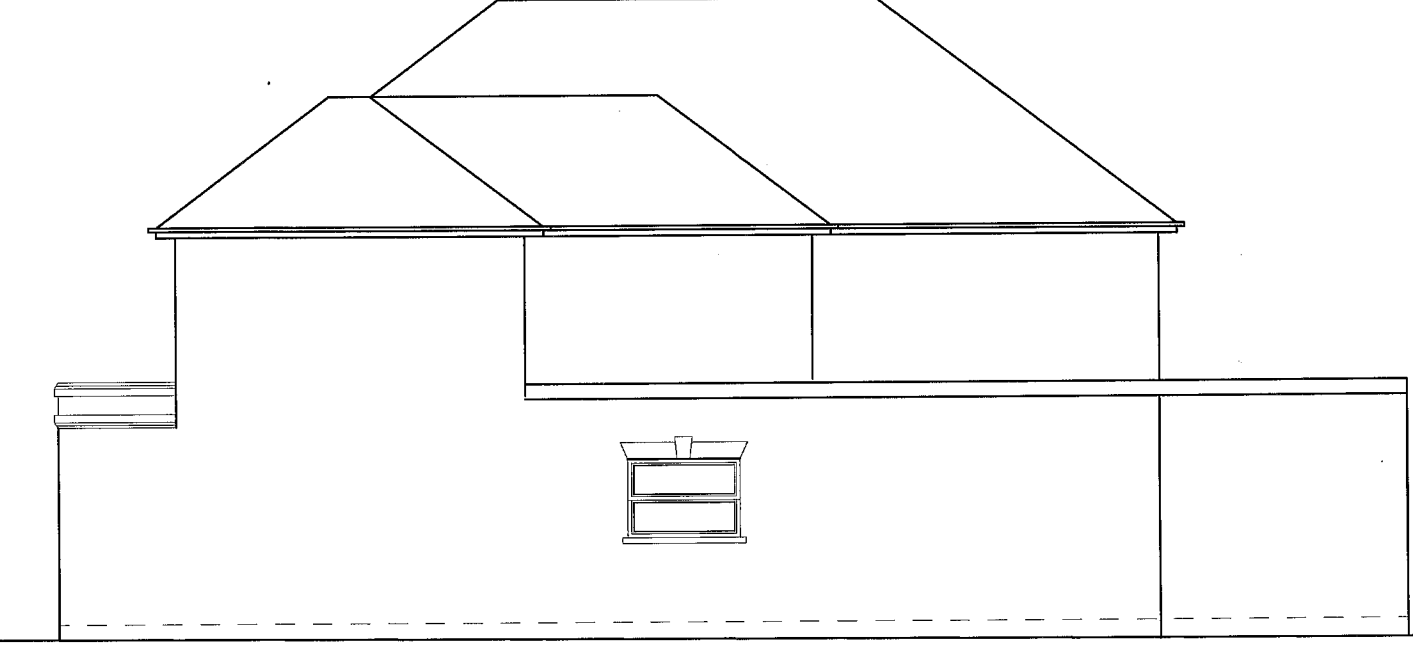

EXISTING RIGHT SIDE ELEVATION

All dimensions verified on site.
All work to comply with British Standards, Code of practice.
All internal works to be in accordance with client instructions.
All external surfaces to match existing.
All work to be to the satisfaction of the local authority-building surveyor.
Builder to serve building notice and comply fully in all respects.
Owner responsible for compliance with 1.Party Wall etc Act 1996. 2. Thames water Build Over Agreement.
Builder to ensure all work in compliance with Build Over agreement as approved by

Thames Water
All proprietary materials to manufacturers recommendations
Works to boiler/Gas to be carried out by Gas Safe registered installer and to Gas Safe recommendations

All wiring and electrical work will be designed, installed, inspected and tested in accordance with the requirements of BS 7671:2001 (2004), the 17th edition Wiring Guidance and Building Regulation Part P (Electrical Safety) by a competent person registered with an electrical self-certification scheme, (BRE, BSI, ELECSA, NAPIT, or NICEIC), authorised by the Secretary of State

The competent person is to send a self-certification certificate to the Local Authority Building Control Departement within 30 days of completion of the electrical works. The client must receive both a copy of the self-certification certificate and a BS 7671:2001 (2004) Electrical Installation Test Certificate and forward copies to the Local Authority Building Control Dept.

DATE	REVISION

COPYRIGHT:
PLANS 4 U LTD.
15 NORTH PARADE
NORTH ROAD MIDDX
SOUTHALL UB1 2LF
TEL: 07775 900555
E-MAIL: planningpermission1@hotmail.com



JOB TITLE:
1 HIGHFIELD DRIVE,
ICKENHAM

DRAWING TITLE:
EXISTING ELEVATIONS

SCALE : 1:100

DATE: 25/03/2019 DRAWN BY:

DRG. NO.	REV.
19/1/HDI/202	

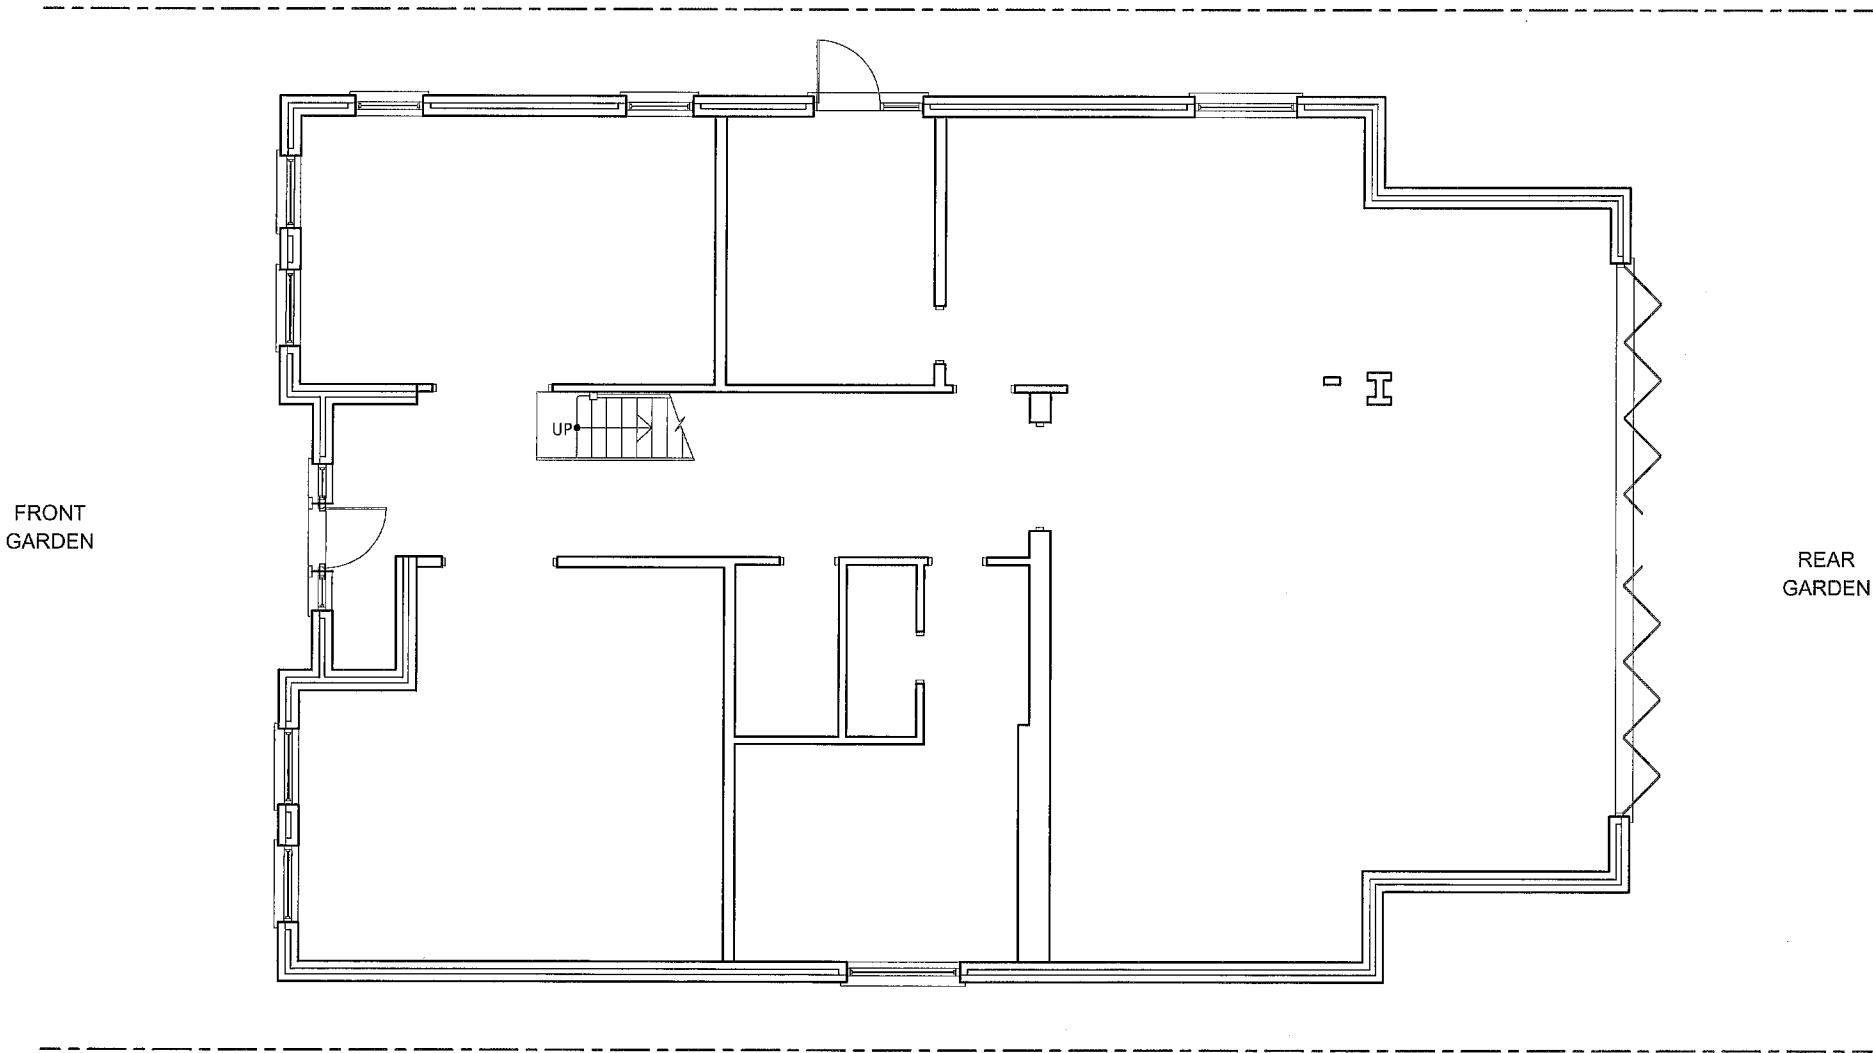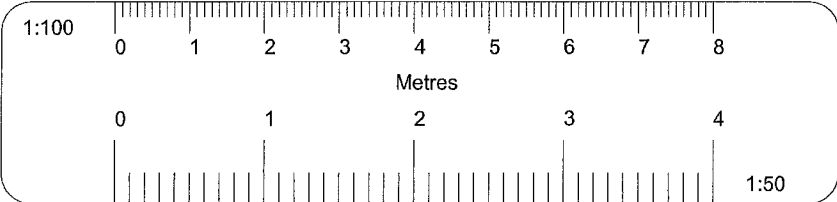

EXISTING GROUND FLOOR PLAN
(AS BUILT)

All dimensions verified on site.
All work to comply with British Standards, Code of practice.
All internal works to be in accordance with client instructions.
All external surfaces to match existing.
All work to be to the satisfaction of the local authority-building surveyor.
Builder to serve building notice and comply fully in all respects.
Owner responsible for compliance with 1.Party Wall etc Act 1996. 2. Thames water Build Over Agreement.
Builder to ensure all work in compliance with Build Over agreement as approved by

Thames Water
All proprietary materials to manufacturers recommendations
Works to boiler/Gas to be carried out by Gas Safe registered installer and to Gas Safe recommendations

All wiring and electrical work will be designed, installed, inspected and tested in accordance with the requirements of BS 7671:2001 (2004), the 17th edition Wiring Guidance and Building Regulation Part P (Electrical Safety) by a competent person registered with an electrical self-certification scheme, (BRE, BSI, ELECSA, NAPIT, or NICEIC), authorised by the Secretary of State

The competent person is to send a self-certification certificate to the Local Authority Building Control Department within 30 days of completion of the electrical works. The client must receive both a copy of the self-certification certificate and a BS 7671:2001 (2004) Electrical Installation Test Certificate and forward copies to the Local Authority Building Control Dept.

	DATE	REVISION

COPYRIGHT:

PLANS 4 U LTD.
15 NORTH PARADE
NORTH ROAD MIDDX
SOUTHALL UB1 2LF
TEL: 07775 900555
E-MAIL: planningpermission1@hotmail.com

JOB TITLE:

1 HIGHFIELD DRIVE,
ICKENHAM

DRAWING TITLE:

EXISTING GROUND FLOOR PLAN
(AS BUILT)

SCALE : 1:100

DATE: 25/03/2019 DRAWN BY:

DRG. NO.	REV.
19/1/HDI/201	