

3 JUN 2019

PLANNING DRAWINGS FOR NEW PORTICO - 1:100 @ A3

FOR

ALTERATION & EXTENSION

TO

1 HIGHFIELD DRIVE, ICKENHAM, UB10 8AL.



TEKTON DPW
Architects & Designers

Registered Office: 12 Station Road, London W7 3JE
TEL : 020 8840 7300
FAX : 020 8840 7307
Email : tekton.dpw@btconnect.com
Registered in England No. 03728986

Date : May. 2019
Ref : 18/461/PDwgs

PLANNING APPLICATION DRAWINGS - 6653/APP/2016/967 - 1:100 @ A3

FOR

ALTERATION & EXTENSION

TO


1 HIGHFIELD DRIVE, ICKENHAM, UB10 8AL.

TEKTON DPW
Architects & Designers


Registered Office: 12 Station Road, London W7 3JE
TEL : 020 8840 7300
FAX : 020 8840 7307
Email : tekton.dpw@btconnect.com
Registered in England No. 03728986

Date: MAY 2019
Ref: 18/461/PDwgs.



PROPOSED PLANS & ELEVATIONS scale 1:100

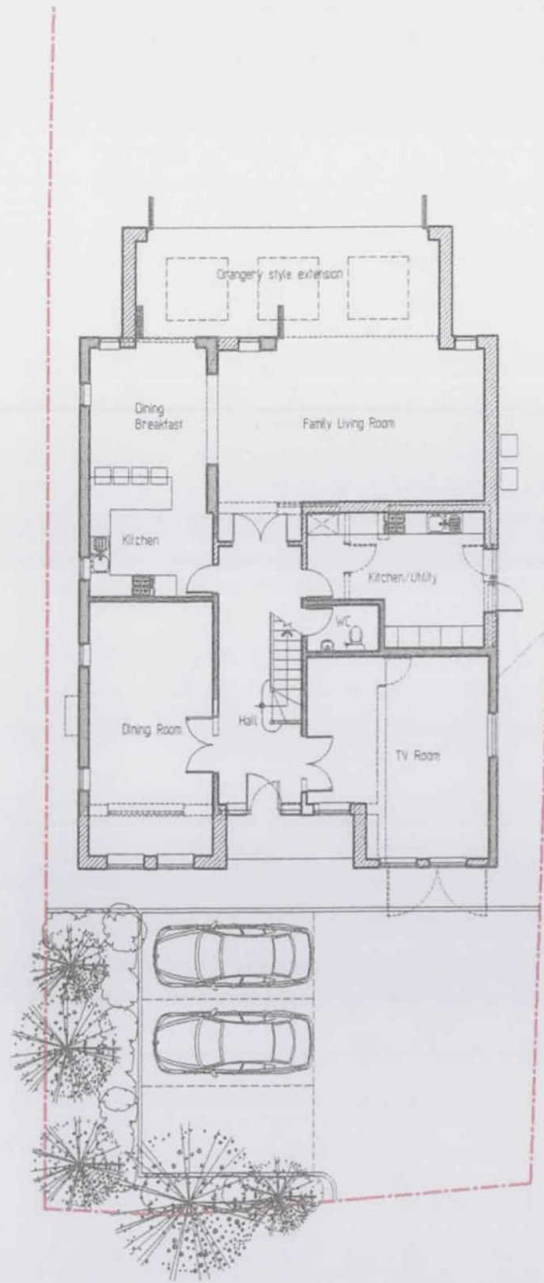


Ground Floor Layout

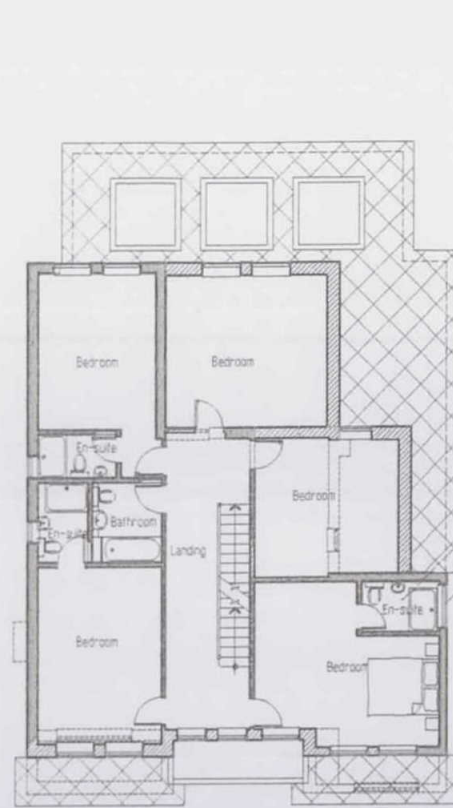


First Floor Layout

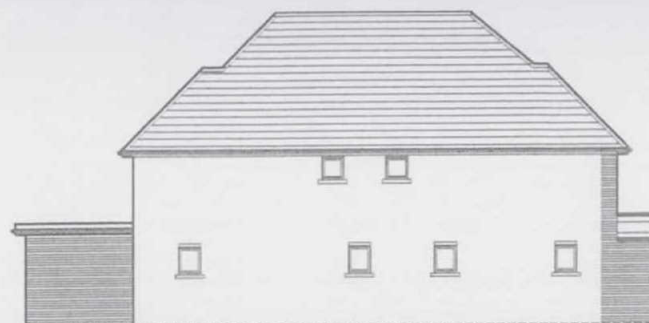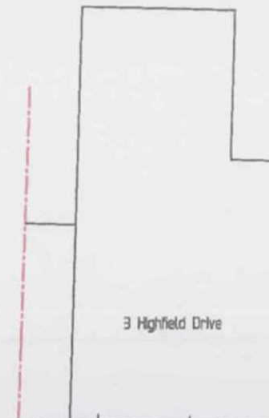


Side Elevation

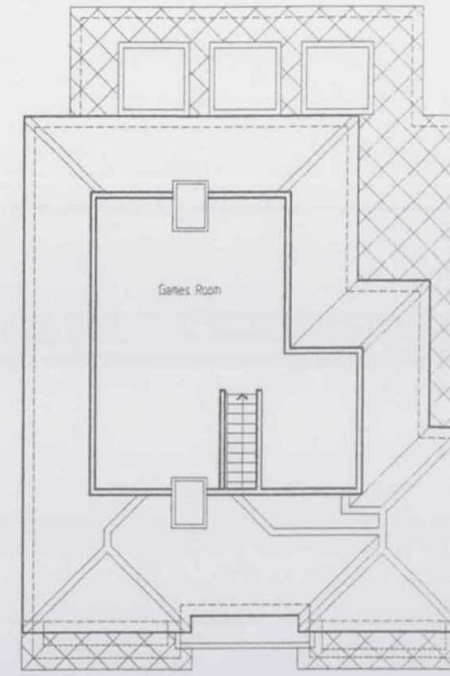


Second Floor / Roof Layout

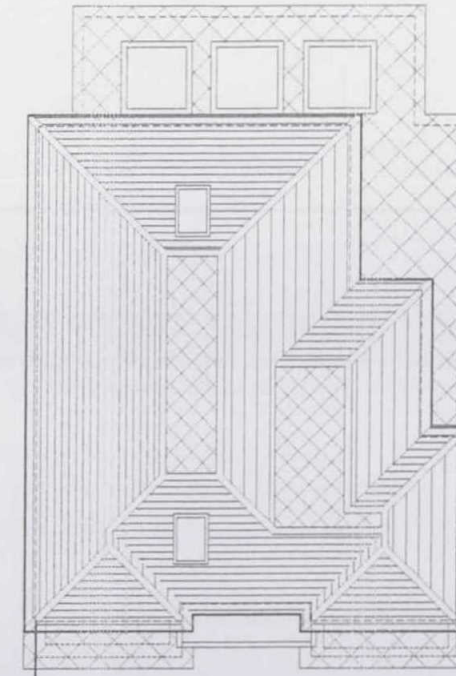

Roof Layout

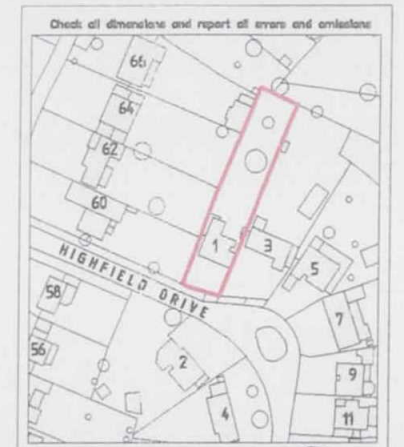

Site Plan - 1:1250

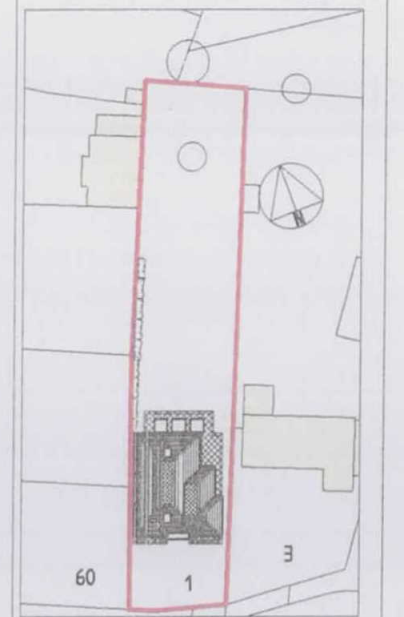

Block Plan - 1:500

0 5m 10m 20m 30m 40m 50m 60m Scale 1:100

All external finished to match existing
Area of proposed single/two storey extension & new fenestration

Rev N Clients comments 04/03/16
Rev M Amendments to Planning Officers comments 08/03/16
Rev L Additional information to Planning Officers comments 26/02/16
Rev K Planning Officers pre-app comments incorporated 19/02/16
Rev J Planning Officers pre-app comments incorporated 04/12/15
Rev H Planning Officers comments incorporated 25/09/15
Rev G Clients revision, g plan amended 11/09/15
Rev F Clients revision, site plan amended 04/09/15
Rev A General revision 15/08/15

Proposed Alterations & Extension to
1 Highfield Drive
Ickenham
Project:

APPROVED DRAWING
RE No 6653/APP/2019/164

Mr S Viring
Client:

Zyntax
Chartered Architect
8 Arborfield Close, Slough
Berkshire SL1 2JW
Tel: 01753 522944
reception@zyntaxarchitects.com

Date:	Scale:	Drawing No.:	Revision:
Aug 2015	1:100@A1	33-15-02	N



Front Elevation



Side Elevation



Rear Elevation

EXISTING DRAWINGS - 1:100 @ A3

FOR

ALTERATION & EXTENSION


TO

1 HIGHFIELD DRIVE, ICKENHAM, UB10 8AL.

TEKTON DPW
Architects & Designers

Registered Office: 12 Station Road, London W7 3JE
TEL : 020 8840 7300
FAX : 020 8840 7307
Email : tekton.dpw@btconnect.com
Registered in England No. 03728986

Date: MAY 2019
Ref: 18/461/ExDwgs.

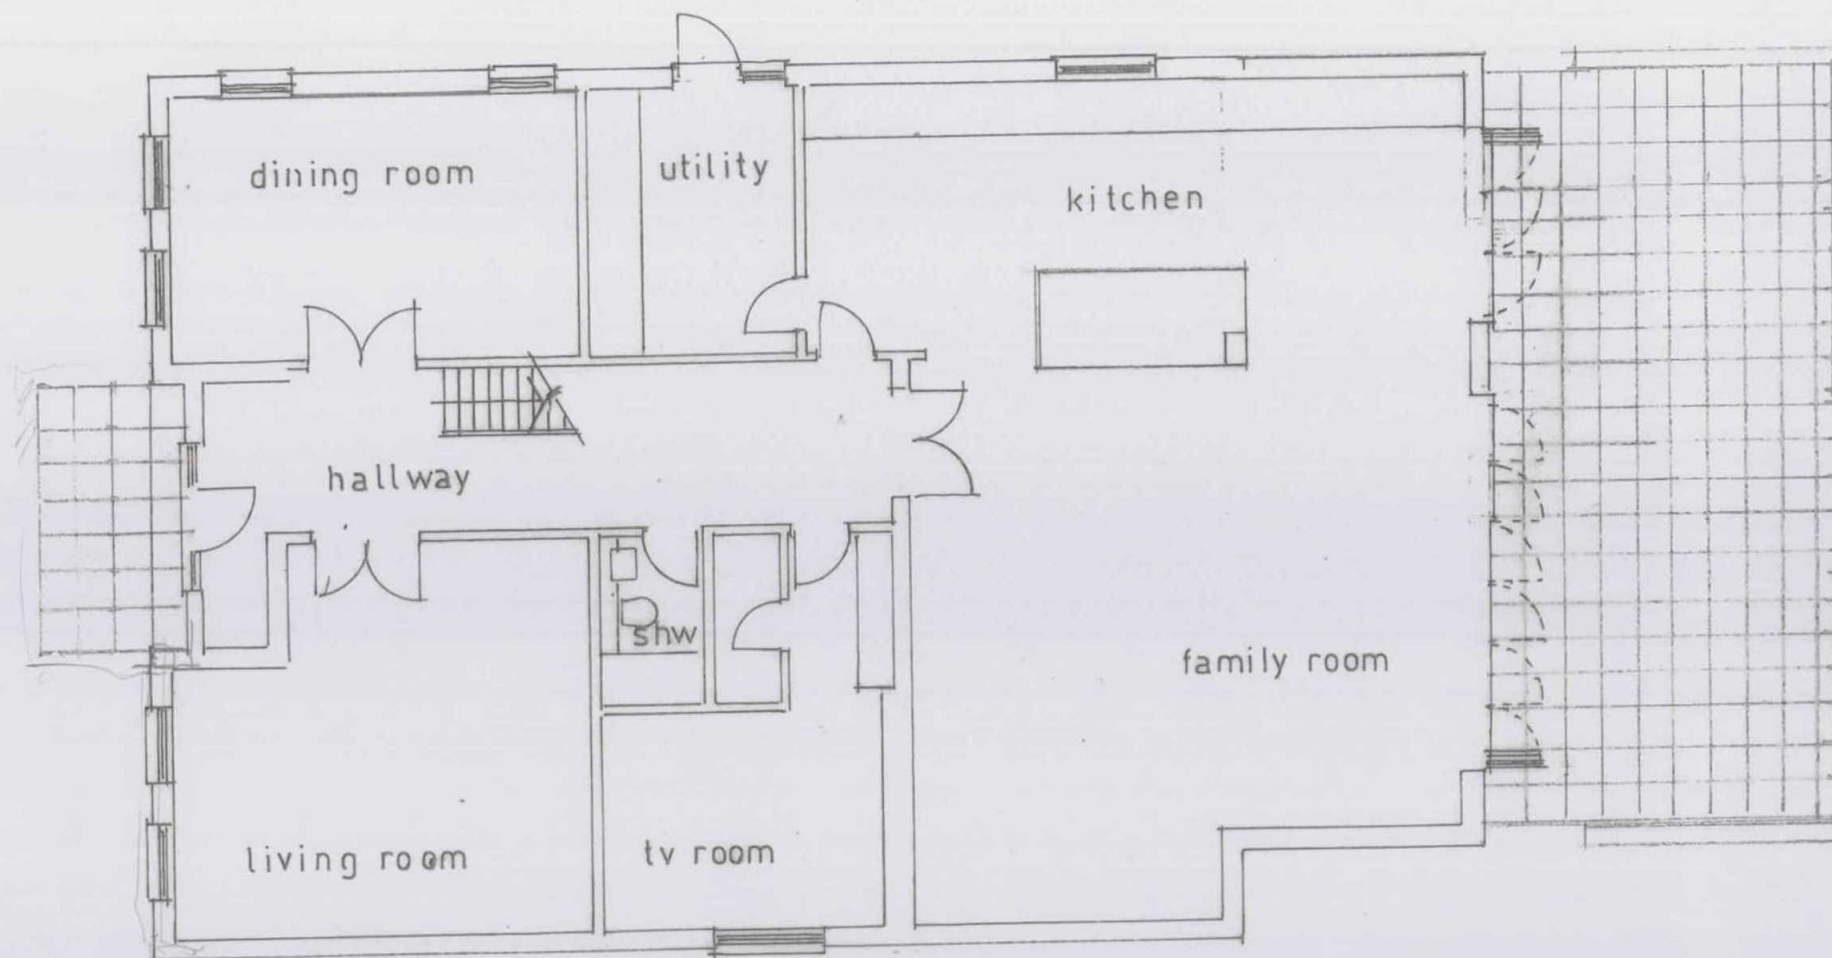

TEKTON DPW
Architects & Designers

12 STATION ROAD LONDON W7 3JE

Tel : 0208 840 7300
Email : tekton.dpw@btconnect.com

Site

1 HIGHFIELD DRIVE, ICKENHAM, UB10 8AL.

Drawing Title

AS BUILT
EXISTING GROUND FLOOR PLAN

Scale

1:100 @ A3



Drawing No.

19/461/E/01

Date

MAY 2019

Revision

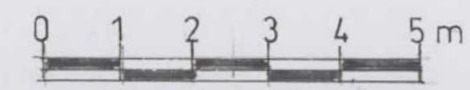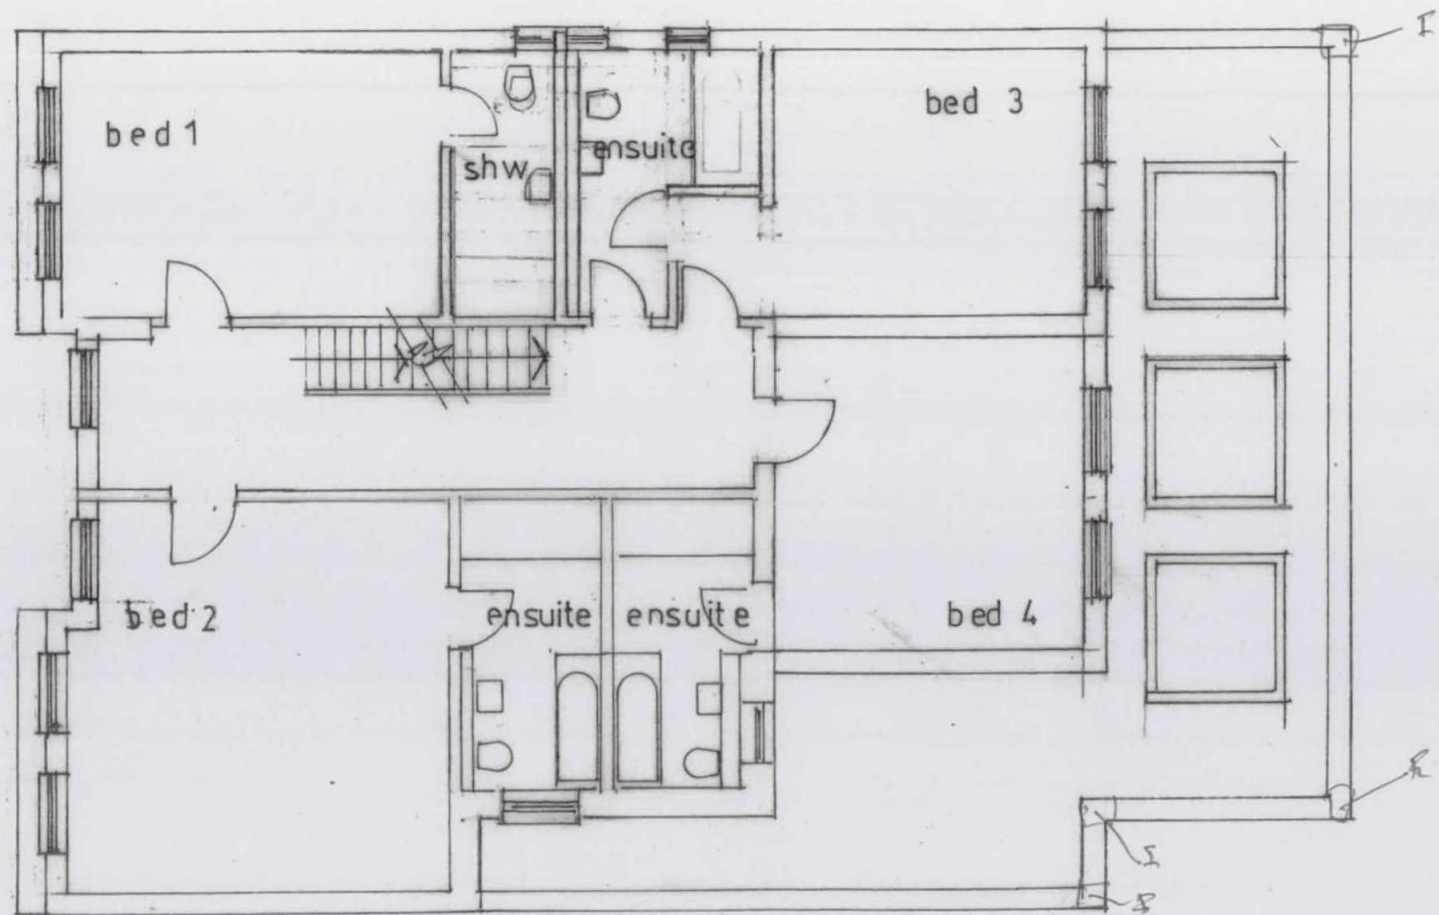

TEKTON DPW
Architects & Designers

12 STATION ROAD LONDON W7 3JE

Tel : 0208 840 7300
Email : tekton.dpw@btconnect.com

Site

1 HIGHFIELD DRIVE, ICKENHAM, UB10 8AL

Drawing Title

AS BUILT
EXISTING FIRST FLOOR PLAN

Scale

1:100 @ A3



Drawing No.

19/461/E/02

Date

MAY 2019

Revision

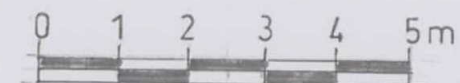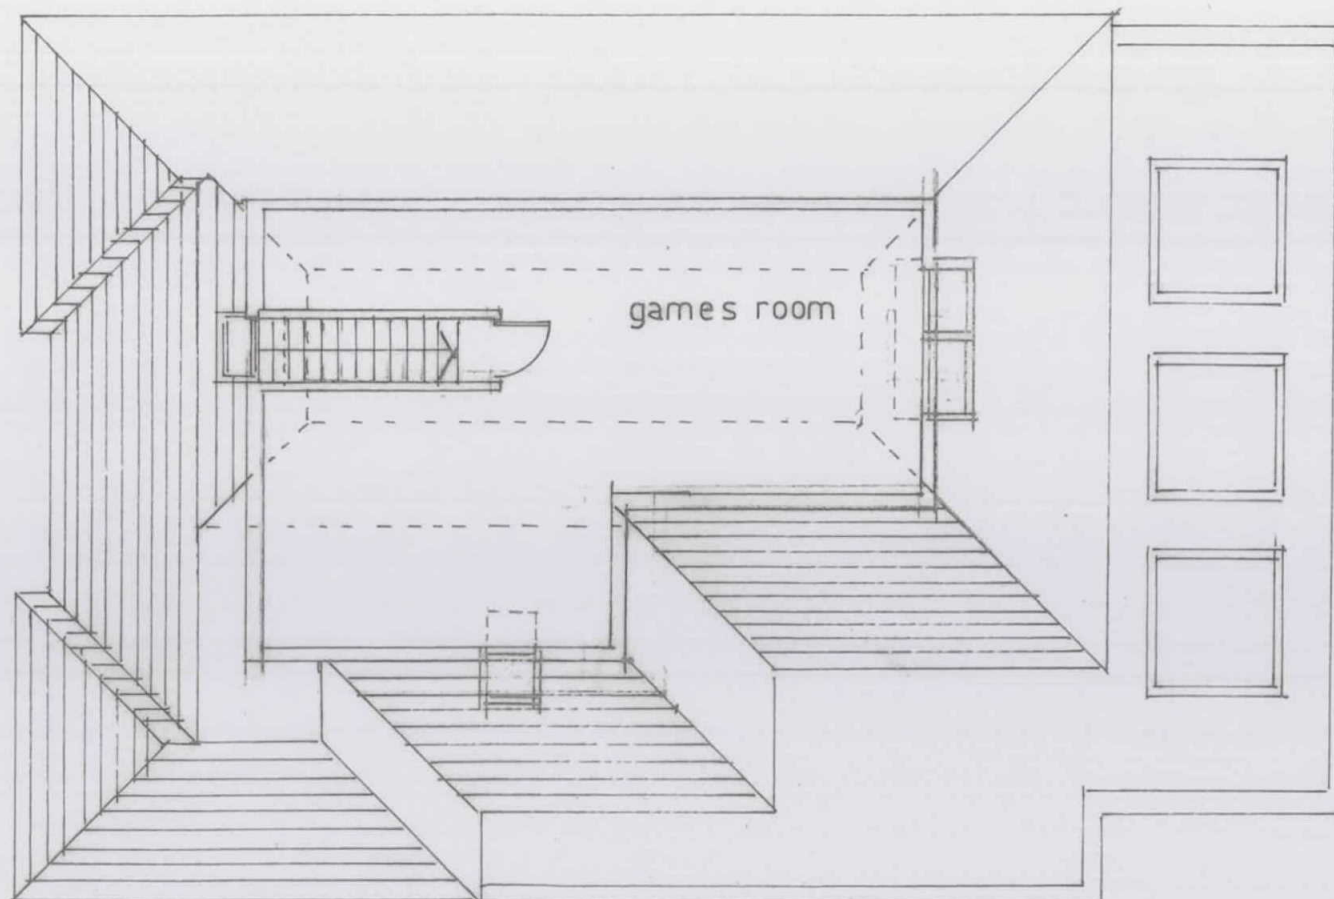

TEKTON DPW
Architects & Designers

12 STATION ROAD LONDON W7 3JE

Tel : 0208 840 7300
Email : tekton.dpw@btconnect.com

Site

1 HIGHFIELD DRIVE, ICKENHAM, UB10 8AL.

Drawing Title

AS BUILT
EXISTING SECOND FLOOR PLAN

Scale

1:100 @ A3



Drawing No.

19/461/E/03

Date

MAY 2019

Revision

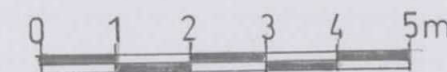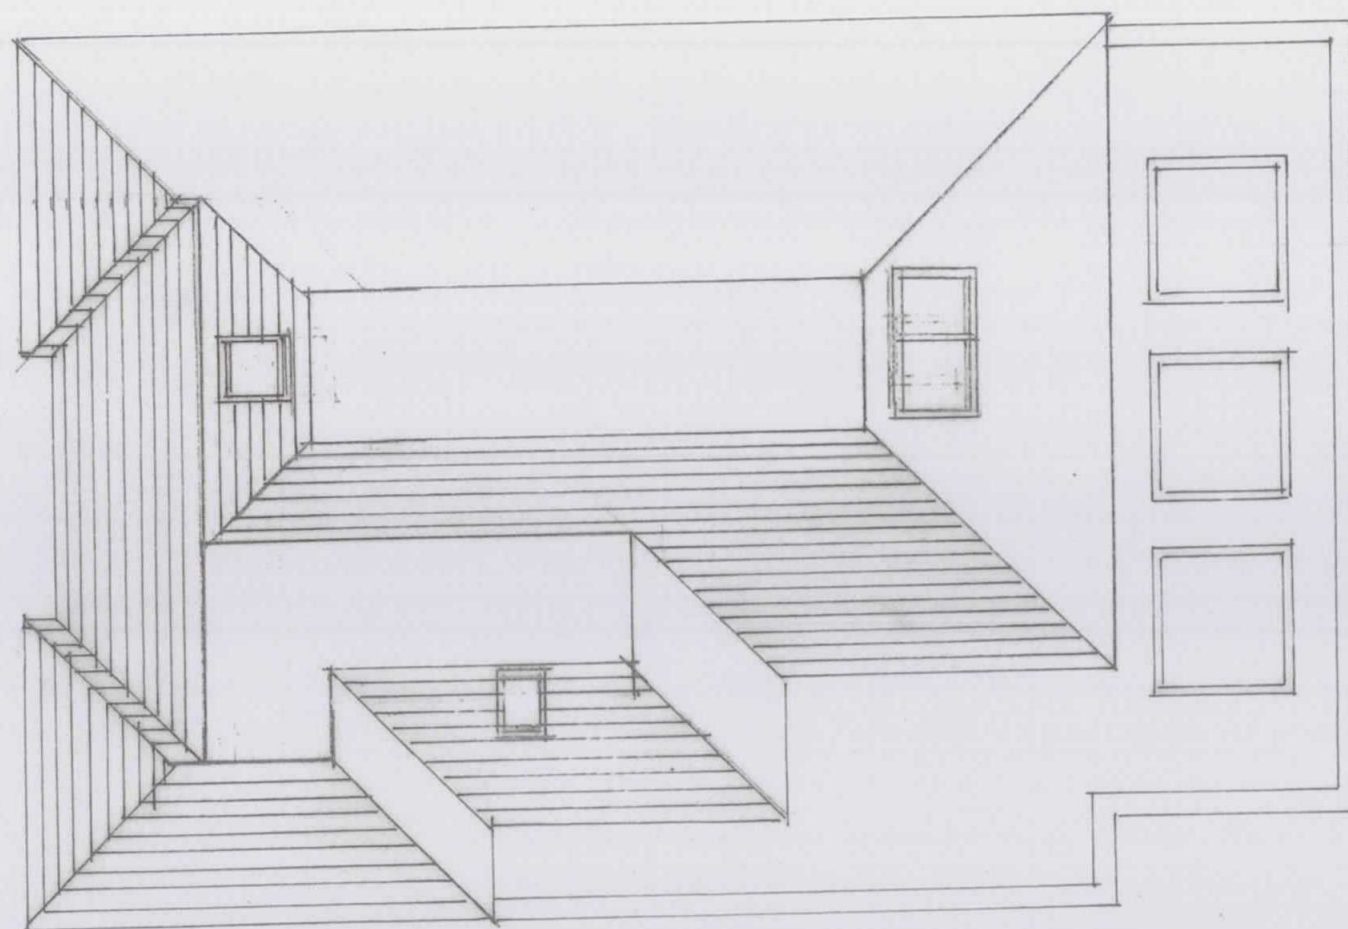

TEKTON DPW
Architects & Designers

12 STATION ROAD LONDON W7 3JE

Tel: 0208 840 7300
Email: tekton.dpw@btconnect.com

Site

1 HIGHFIELD DRIVE, ICKENHAM, UB10 8AL.

Drawing Title

AS BUILT
EXISTING ROOF PLAN

Scale

1:100 @ A3

Drawing No.

19/461/E/04


Date

MAY 2019

Revision



STREET ELEVATION

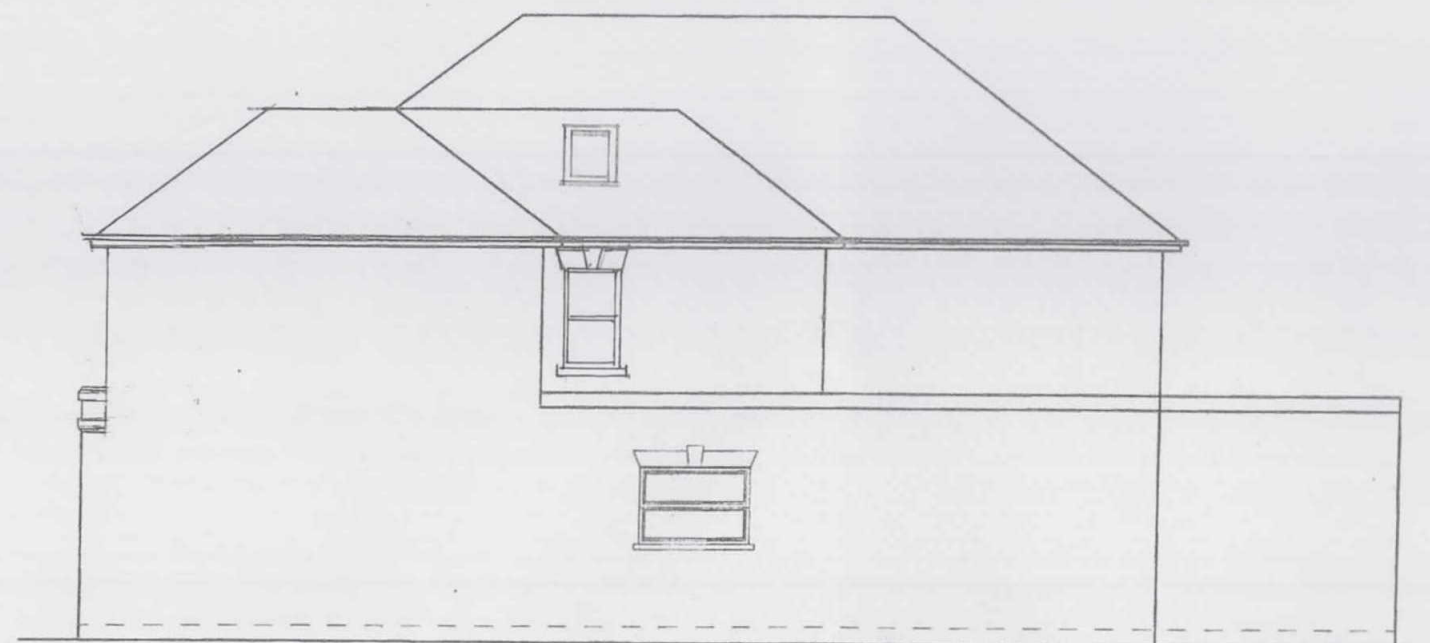

EAST ELEVATION



TEKTON DPW
Architects & Designers

12 STATION ROAD LONDON W7 3JE

Tel : 0208 840 7300
Email : tekton.dpw@btconnect.com

Site

1 HIGHFIELD DRIVE, ICKENHAM, UB10 8AL.

Drawing Title

EXISTING STREET & EAST ELEVATIONS

Scale

1:100 @ A3

Drawing No.

19/461/E/05

Date

MAY 2019


Revision



WEST ELEVATION



GARDEN ELEVATION

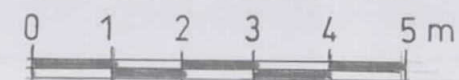

TEKTON DPW
Architects & Designers

12 STATION ROAD LONDON W7 3JE

Tel : 0208 840 7300

Email : tekton.dpw@btconnect.com

Site

1 HIGHFIELD DRIVE, ICKENHAM, UB10 8AL.

Drawing Title

EXISTING GARDEN & WEST ELEVATIONS

Scale

1:100 @ A3

Drawing No.

19/461/E/06

Date

MAY 2019

Revision

PROPOSED DRAWINGS - 1:100 @ A3

FOR

ALTERATION & EXTENSION



TO

1 HIGHFIELD DRIVE, ICKENHAM, UB10 8AL.

TEKTON DPW
Architects & Designers

Registered Office: 12 Station Road, London W7 3JE
TEL : 020 8840 7300
FAX : 020 8840 7307
Email : tekton.dpw@btconnect.com
Registered in England No. 03728986

Date: MAY 2019
Ref: 18/461/PDwgs.

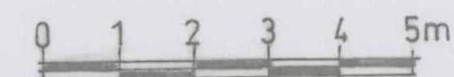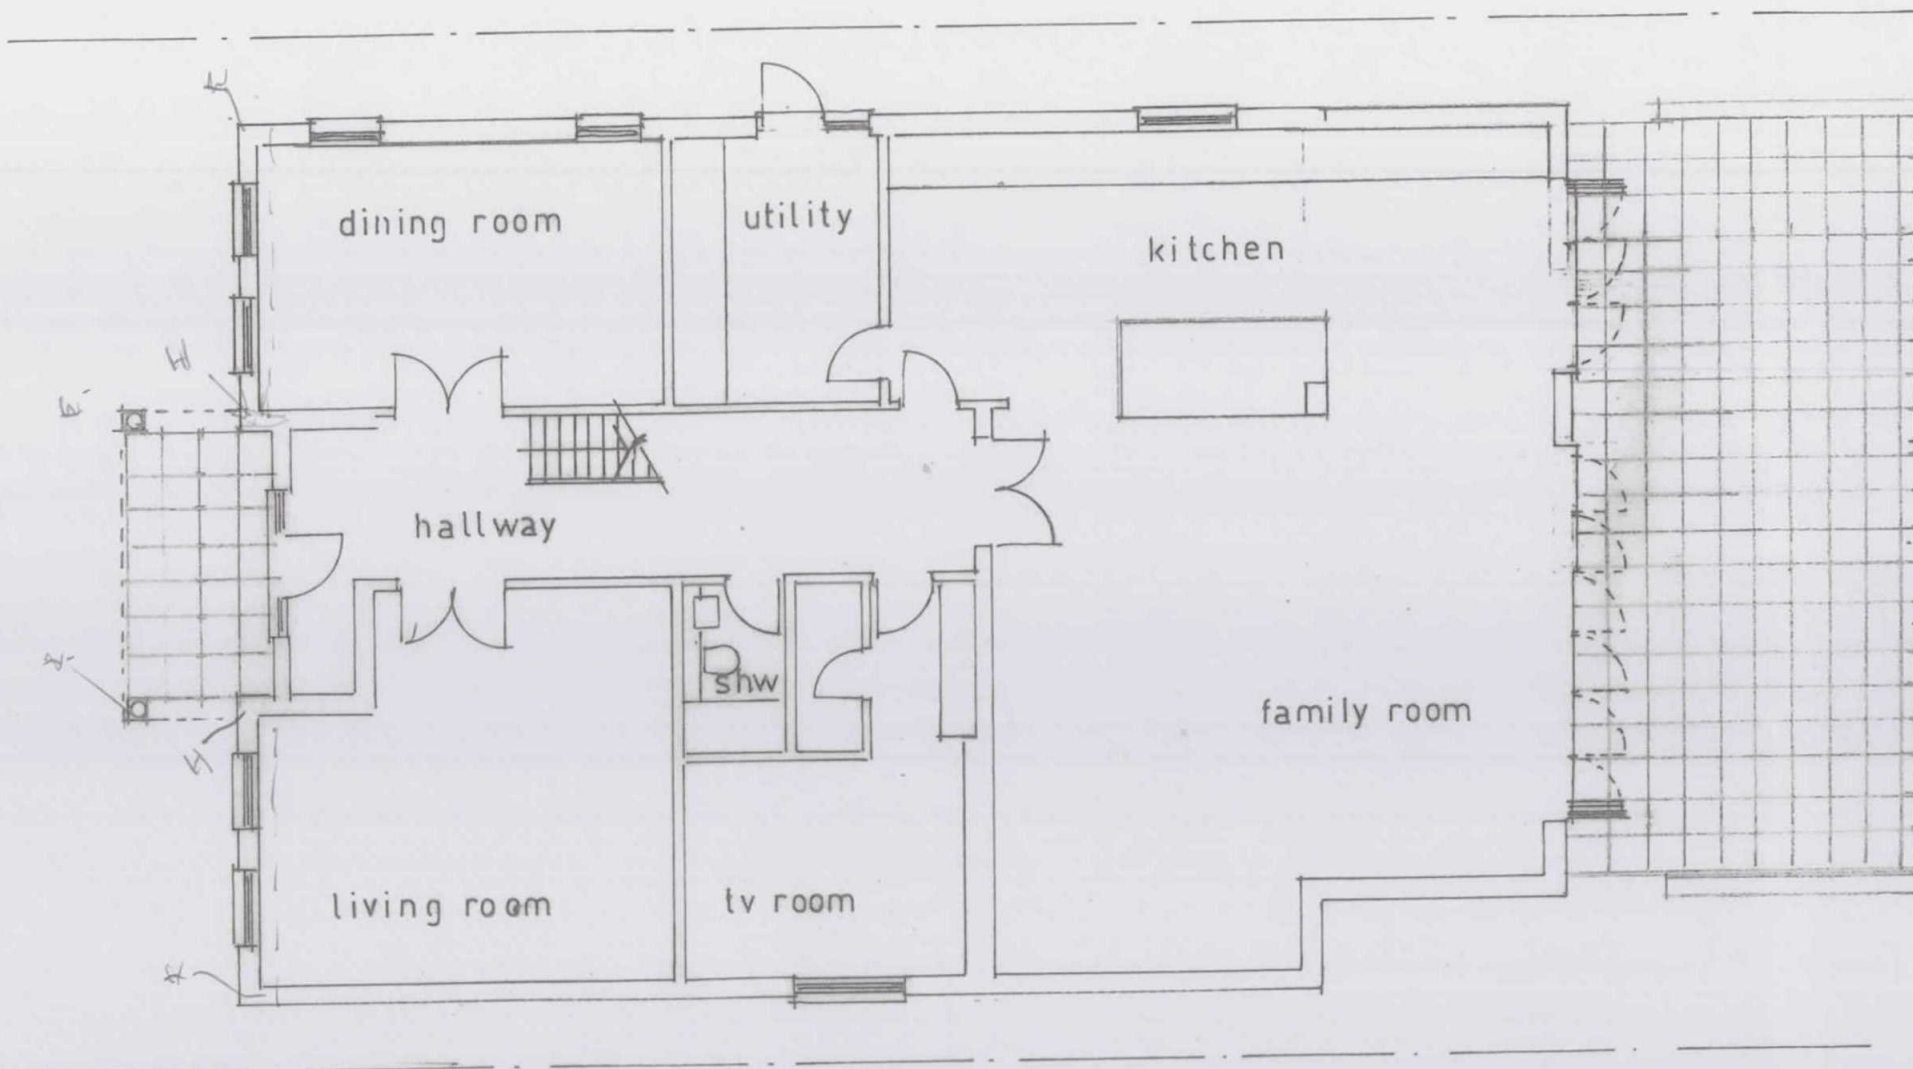

TEKTON DPW
Architects & Designers

12 STATION ROAD LONDON W7 3JE

Tel : 0208 840 7300
Email : tekton.dpw@btconnect.com

Site

1 HIGHFIELD DRIVE, ICKENHAM, UB10 8AL.

Drawing Title

PROPOSED GROUND FLOOR PLAN

Scale

1:100 @ A3



Drawing No.

19/461/P/01

Date

MAY 2019

Revision

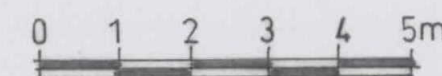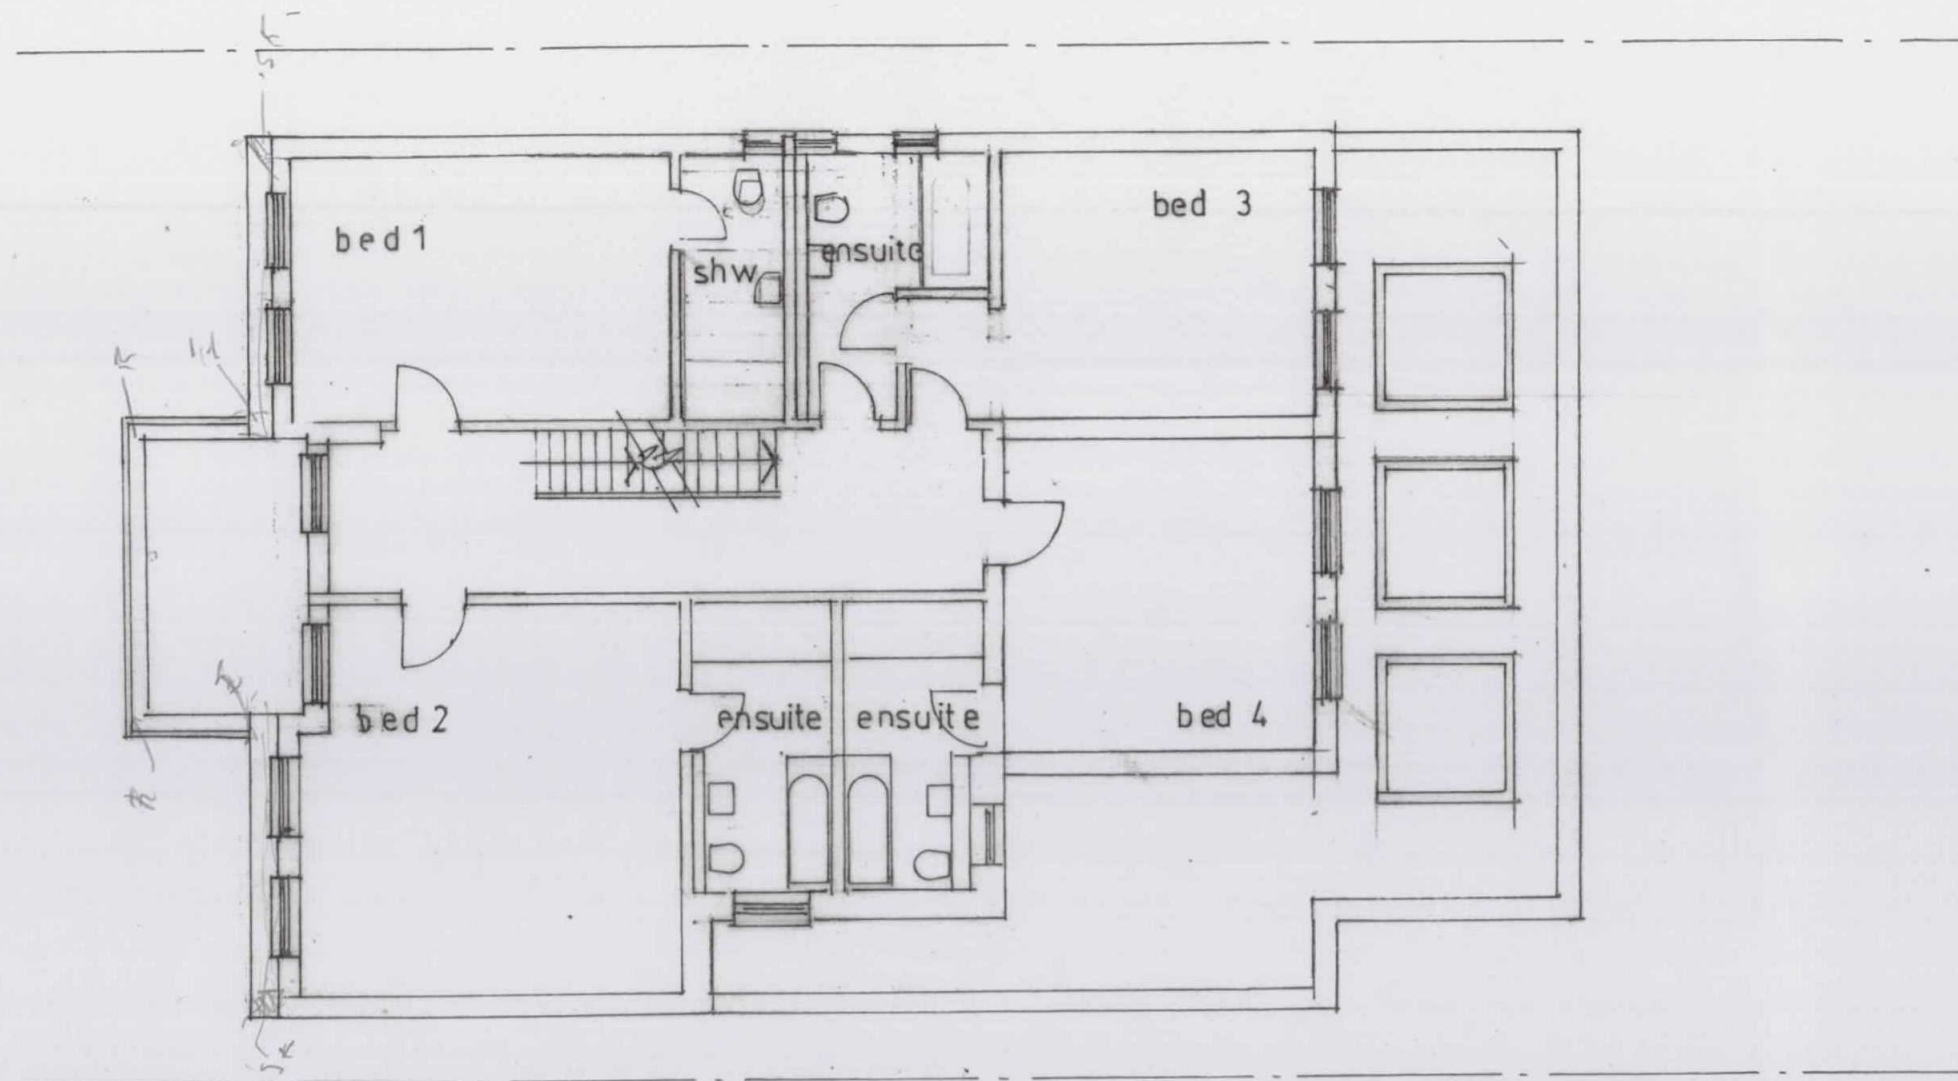

TEKTON DPW

Architects & Designers

12 STATION ROAD LONDON W7 3JE

Tel: 0208 840 7300
Email: tekton.dpw@btconnect.com

Site

1 HIGHFIELD DRIVE, ICKENHAM, UB10 8AL

Drawing Title

PROPOSED FIRST FLOOR PLAN

Scale

1:100 @ A3


Drawing No.

19/461/P/02

Date

MAY 2019

Revision

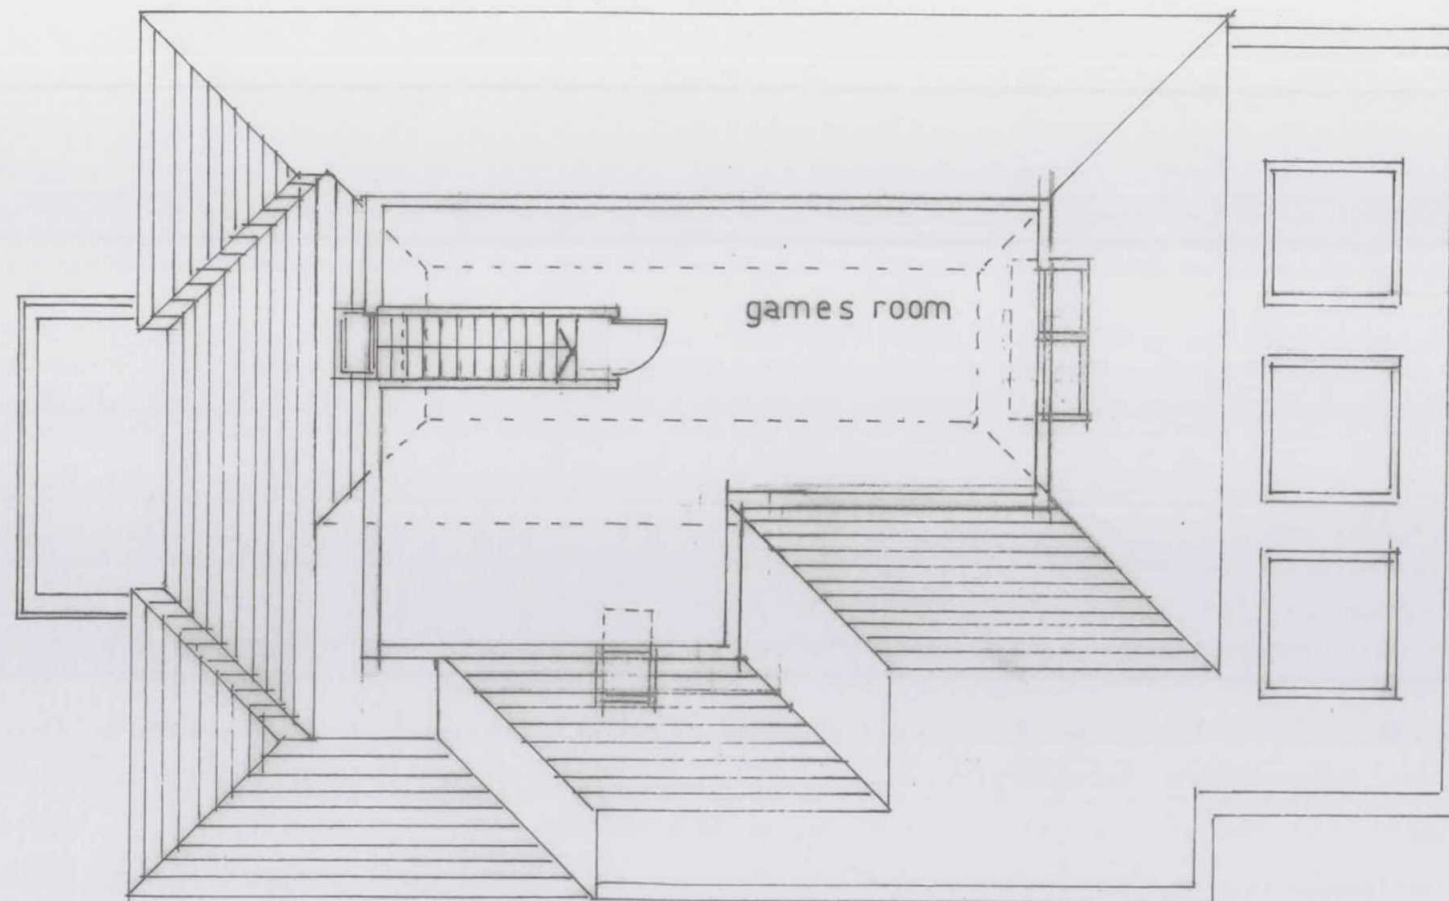

TEKTON DPW

Architects & Designers

12 STATION ROAD LONDON W7 3JE

Tel : 0208 840 7300

Email : tekton.dpw@btconnect.com

Site

1 HIGHFIELD DRIVE, ICKENHAM, UB10 8AL.

Drawing Title

PROPOSED SECOND FLOOR PLAN

Scale

Date



1:100 @ A3

MAY 2019

Drawing No.

Revision

19/461/P/03

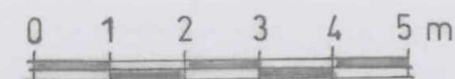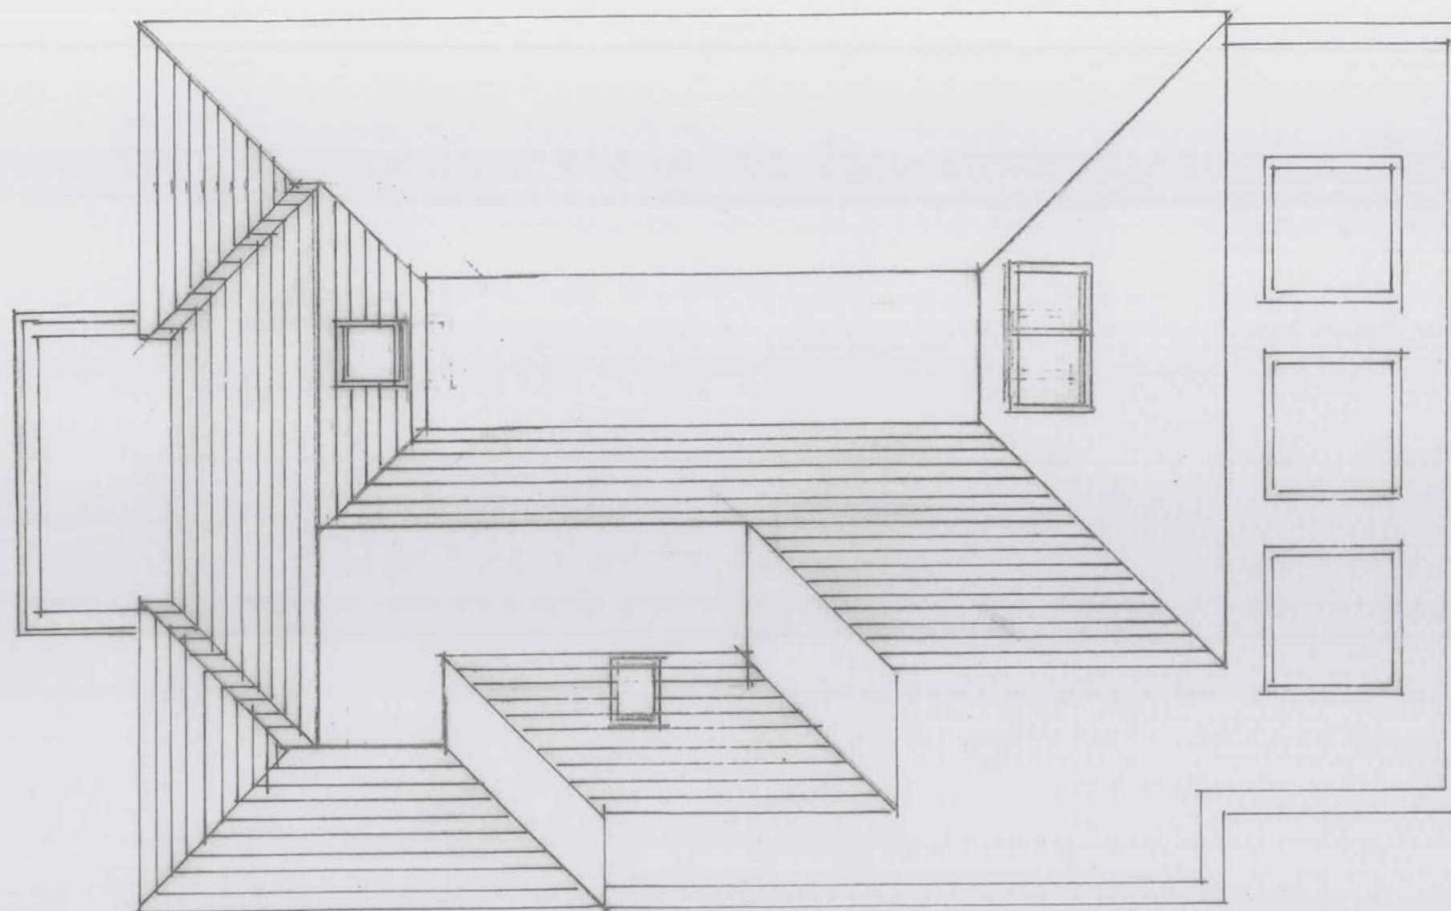

TEKTON DPW
Architects & Designers

12 STATION ROAD LONDON W7 3JE

Tel : 0208 840 7300
Email : tekton.dpw@btconnect.com

Site

1 HIGHFIELD DRIVE, ICKENHAM, UB10 8AL

Drawing Title

PROPOSED ROOF PLAN

Scale

1:100 @ A3

Drawing No.

19/461/P/04


Date

MAY 2019

Revision



STREET ELEVATION

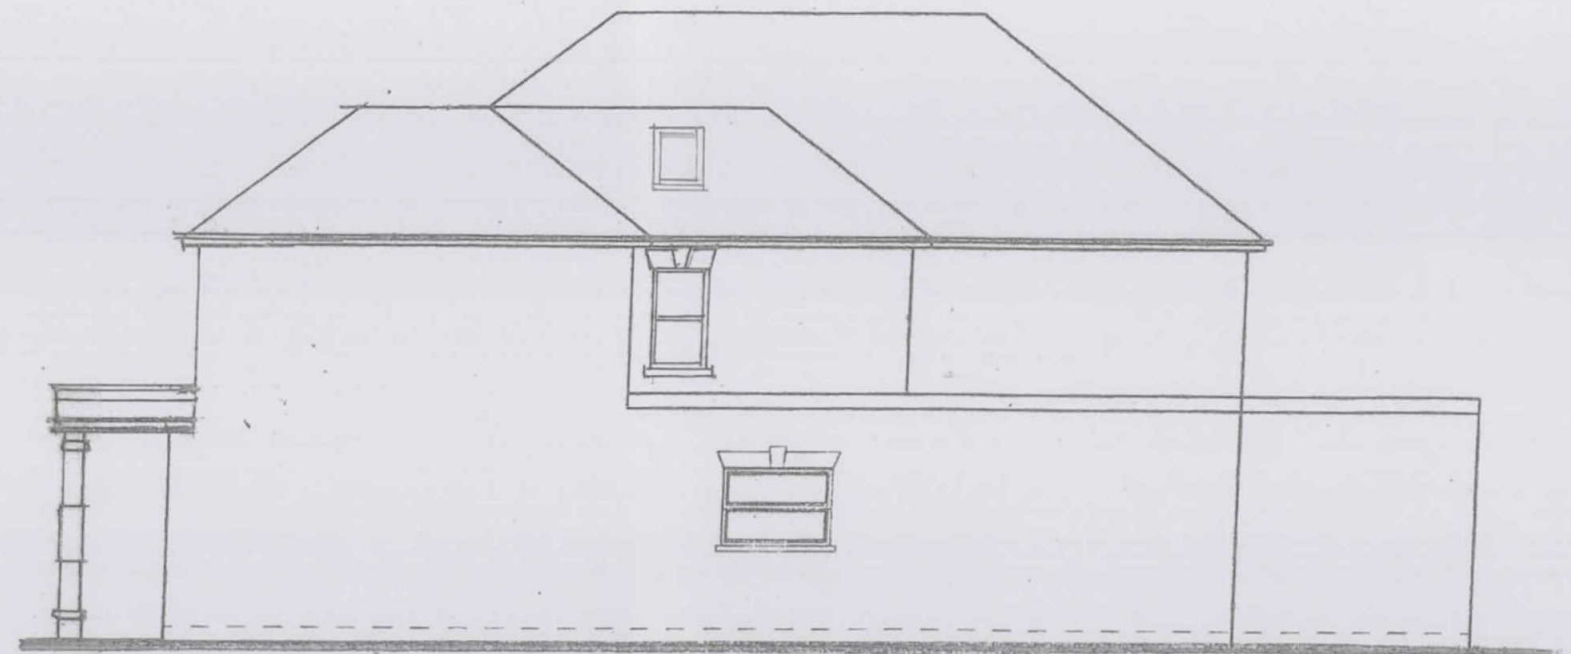

EAST ELEVATION



TEKTON DPW
Architects & Designers

12 STATION ROAD LONDON W7 3JE

Tel : 0208 840 7300
Email : tekton.dpw@btconnect.com

Site

1 HIGHFIELD DRIVE, ICKENHAM, UB10 8AL.

Drawing Title

PROPOSED STREET & EAST ELEVATIONS

Scale


1:100 @ A3

Drawing No.

Date

MAY 2019


Revision

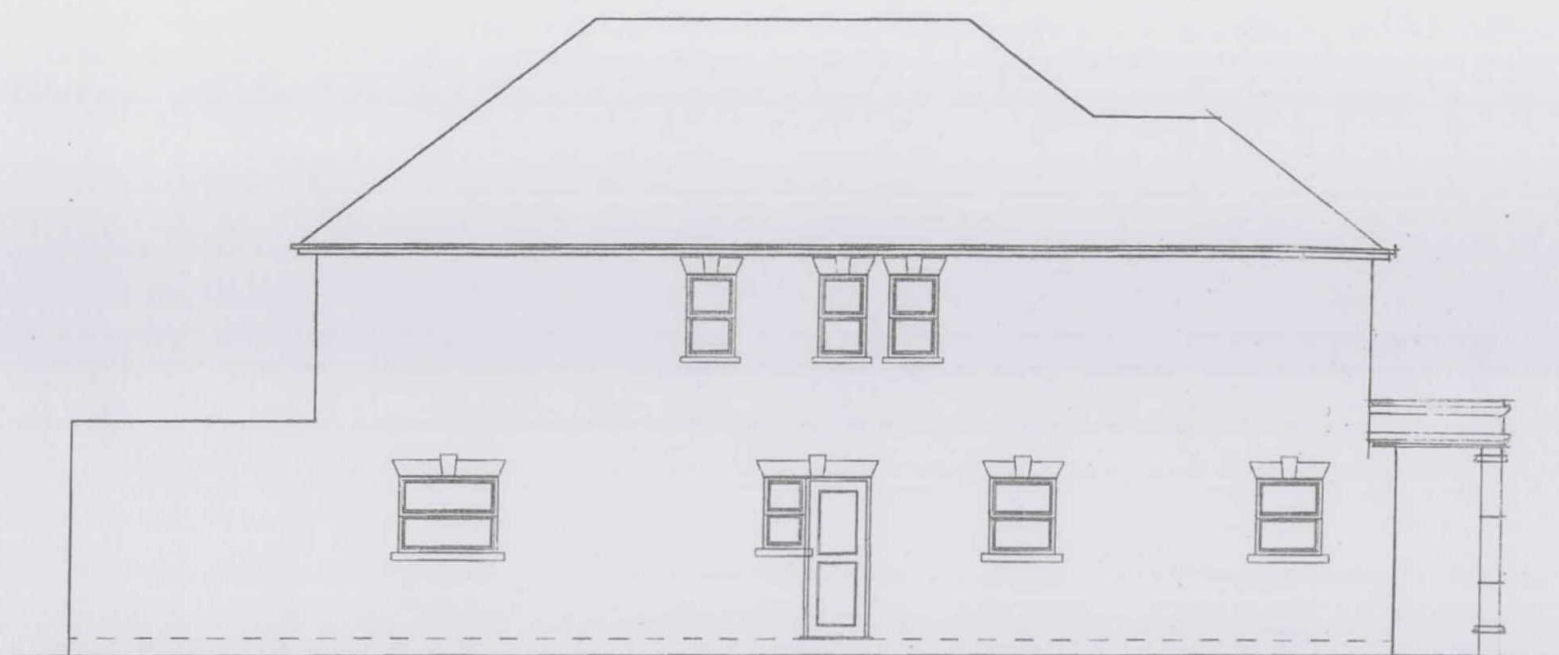

WEST ELEVATION



GARDEN ELEVATION

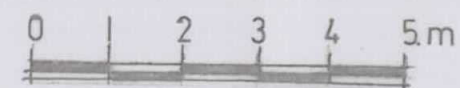

TEKTON DPW
Architects & Designers

12 STATION ROAD LONDON W7 3JE

Tel: 0208 840 7300
Email: tekton.dpw@btconnect.com

Site

1 HIGHFIELD DRIVE, ICKENHAM, UB10 8AL

Drawing Title

PROPOSED GARDEN & WEST ELEVATIONS

Scale

1:100 @ A3

Drawing No.

19/461/P/06

Date

MAY 2019

Revision