


As Built Side Elevation

New uPVC windows and doors in white with double glazed glass units

Supalite Warm Roof to extend over conservatory and Kitchen extension.

External tile finish to be Charcoal Extralite steel shingle

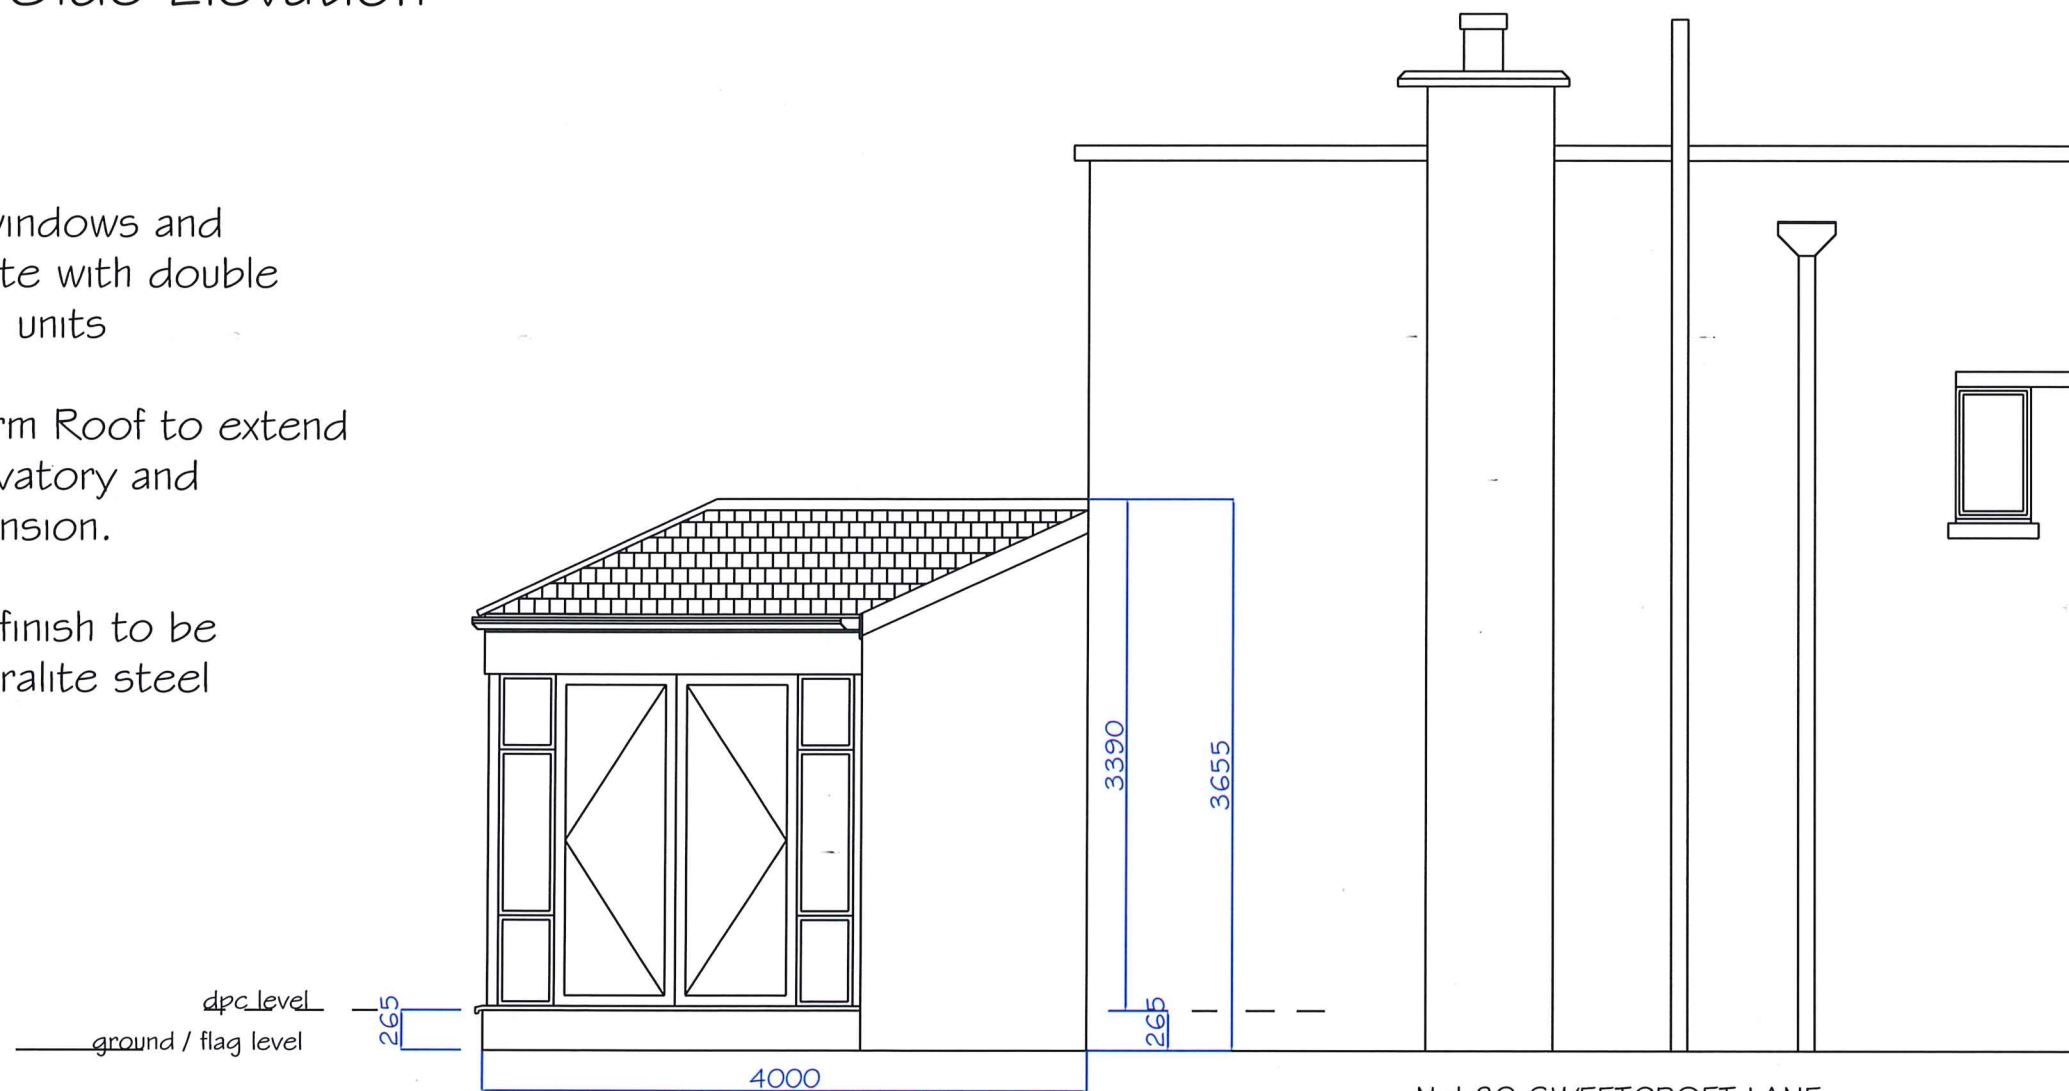


Alterations to conservatory sunroom

Client: Mr & Mrs Church

Site Address:
89 Sweetcroft Lane, Uxbridge, UB10 9LG

Drawing Number:
BP1104_PL_REV1_06

Scale 1:50 A3

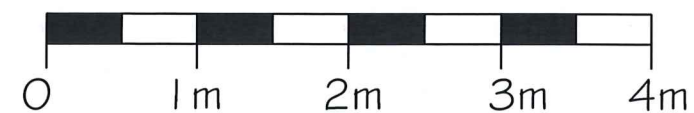

PCL Building Products Ltd
Cemetery Rd
Radcliffe
Manchester
M26 4ft
tel: 0161 300 4900
email: sales@pclbuildingproducts.co.uk