


As Built Rear Elevation

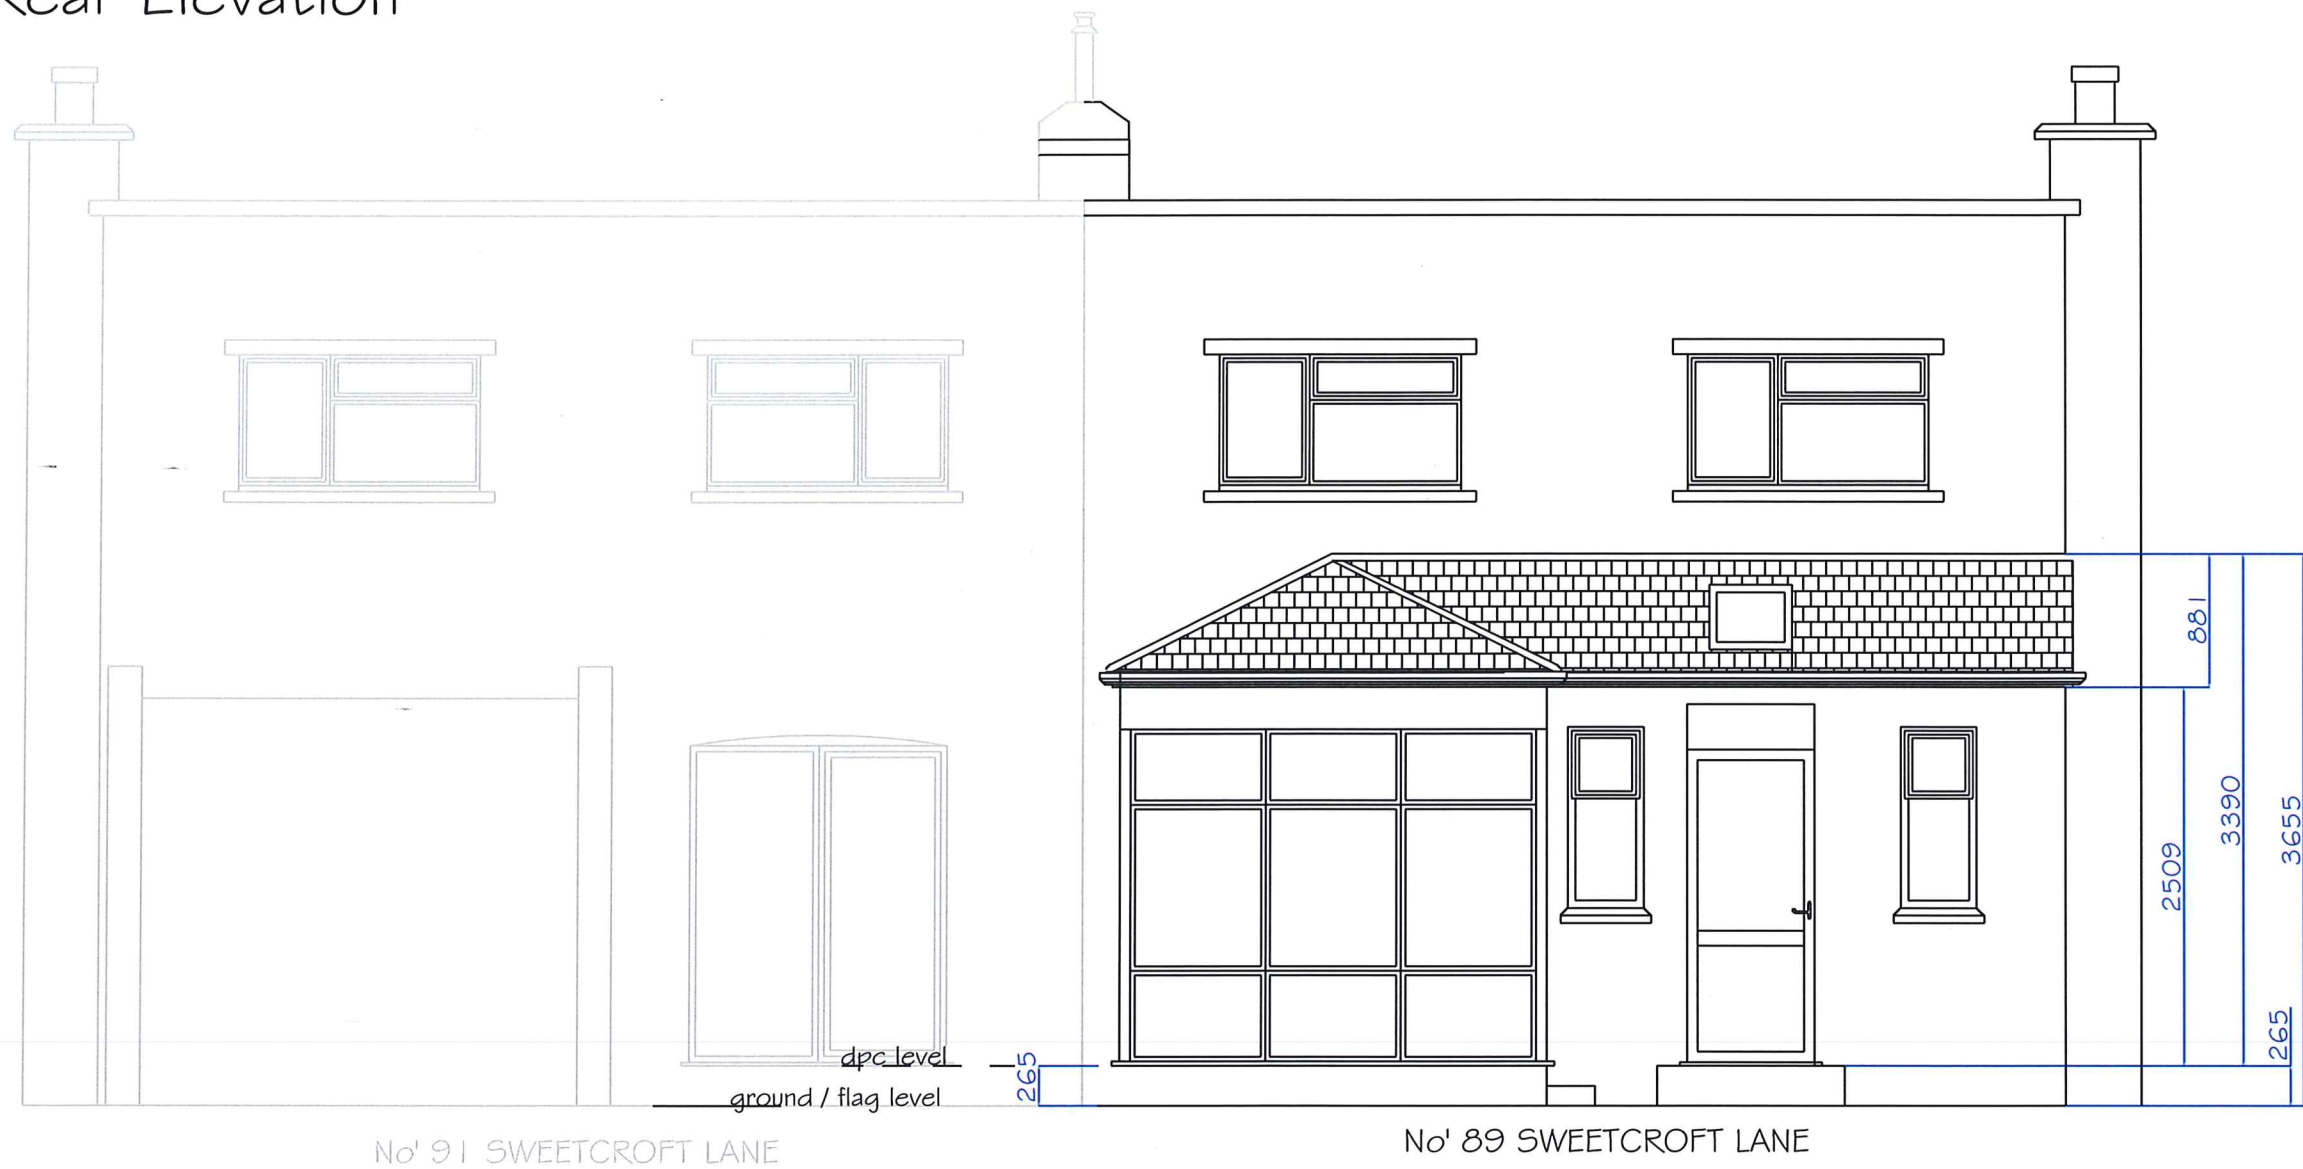


Alterations to conservatory sunroom

Client: Mr & Mrs Church

Site Address:
89 Sweetcroft Lane, Uxbridge, UB10 9LG

Drawing Number:
BP1104_PL_REV1_07

Scale 1:50 A3

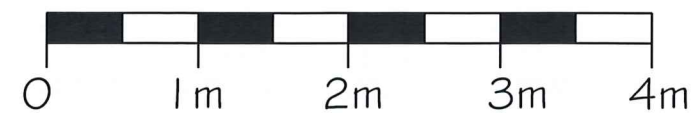

PCL Building Products Ltd
Cemetery Rd
Radcliffe
Manchester
M26 4ft
tel: 0161 300 4900
email: sales@pclbuildingproducts.co.uk