


As Built Right Side Elevation

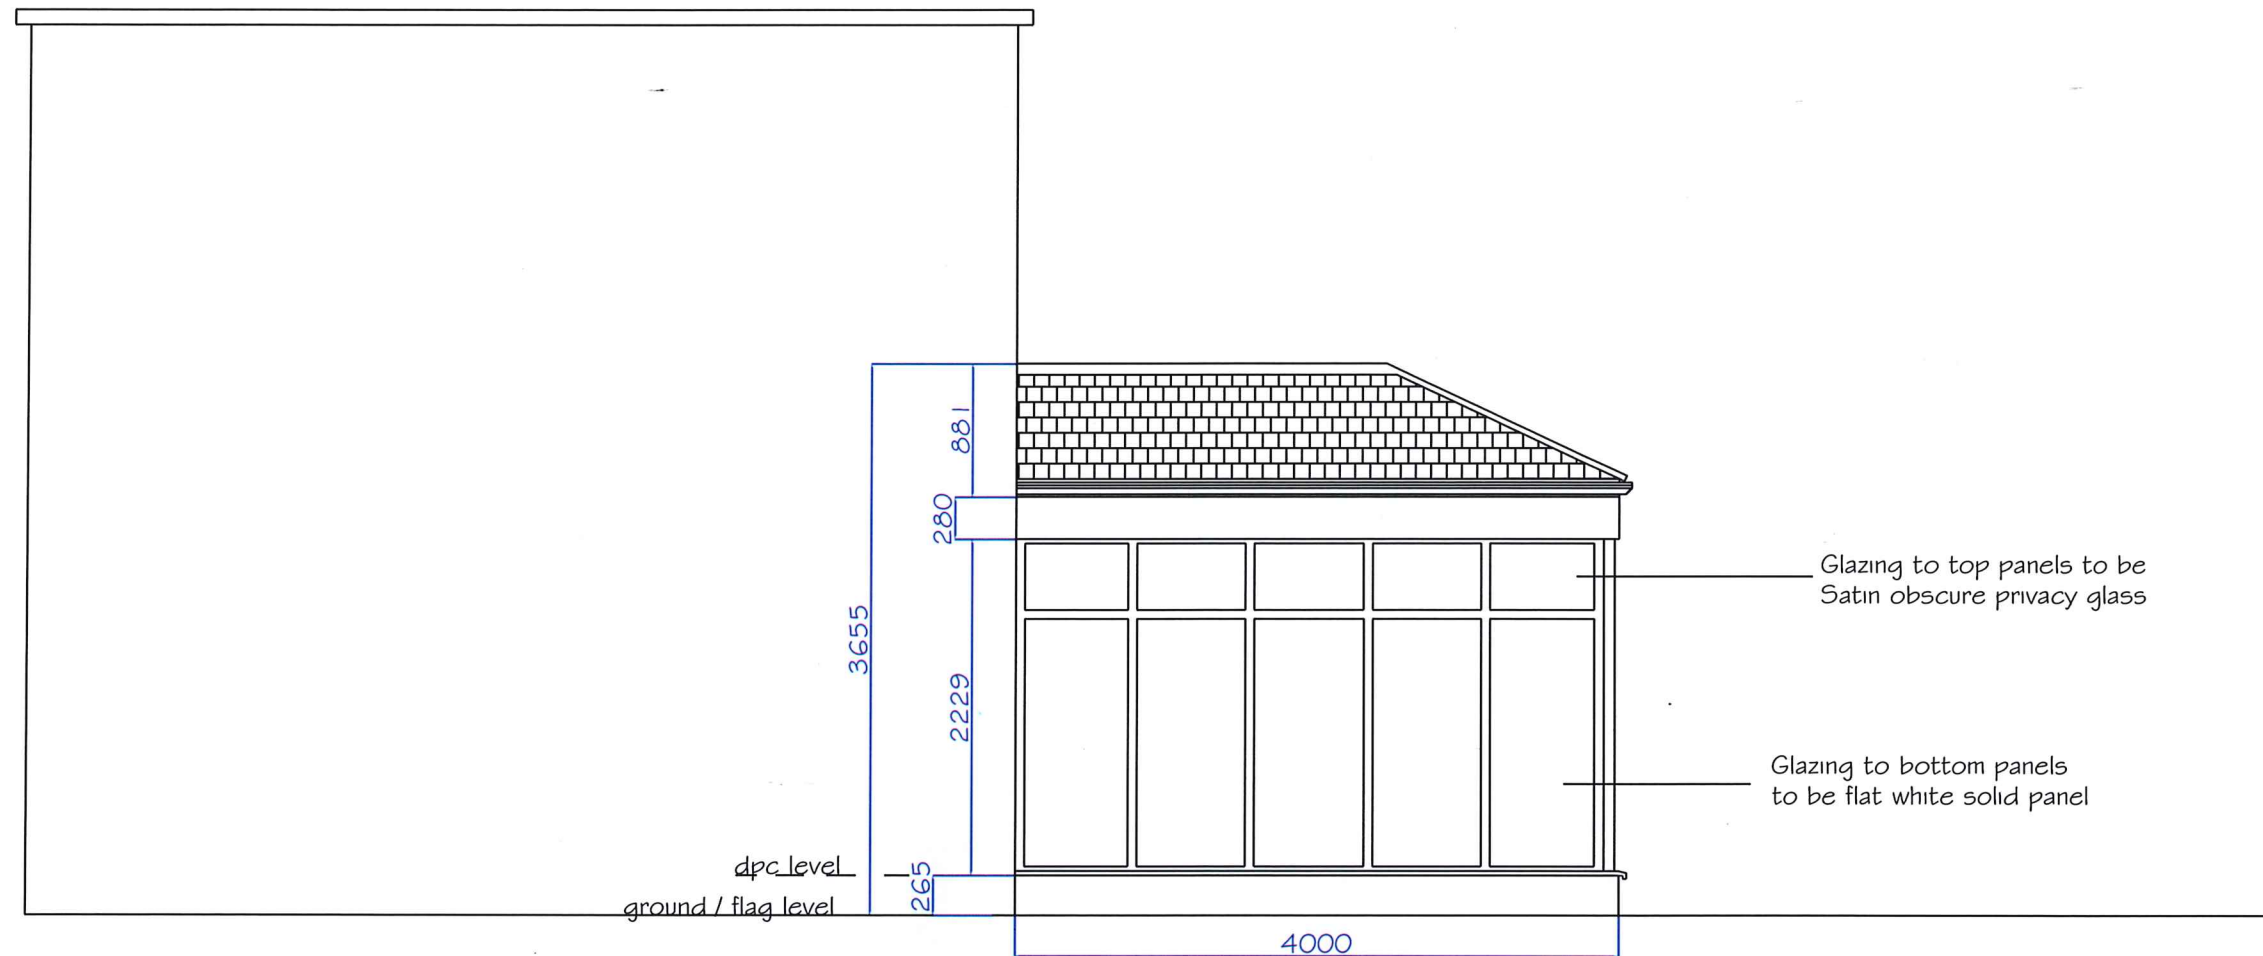

Alterations to conservatory sunroom


Client: Mr & Mrs Church

Site Address:

89 Sweetcroft Lane, Uxbridge, UB10 9LG

Drawing Number:
BP1104_PL_REV1_10

Scale 1:50 A3

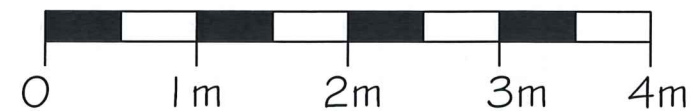

PCL Building Products Ltd
Cemetery Rd
Radcliffe
Manchester
M26 4ft

tel: 0161 300 4900

email: sales@pclbuildingproducts.co.uk