




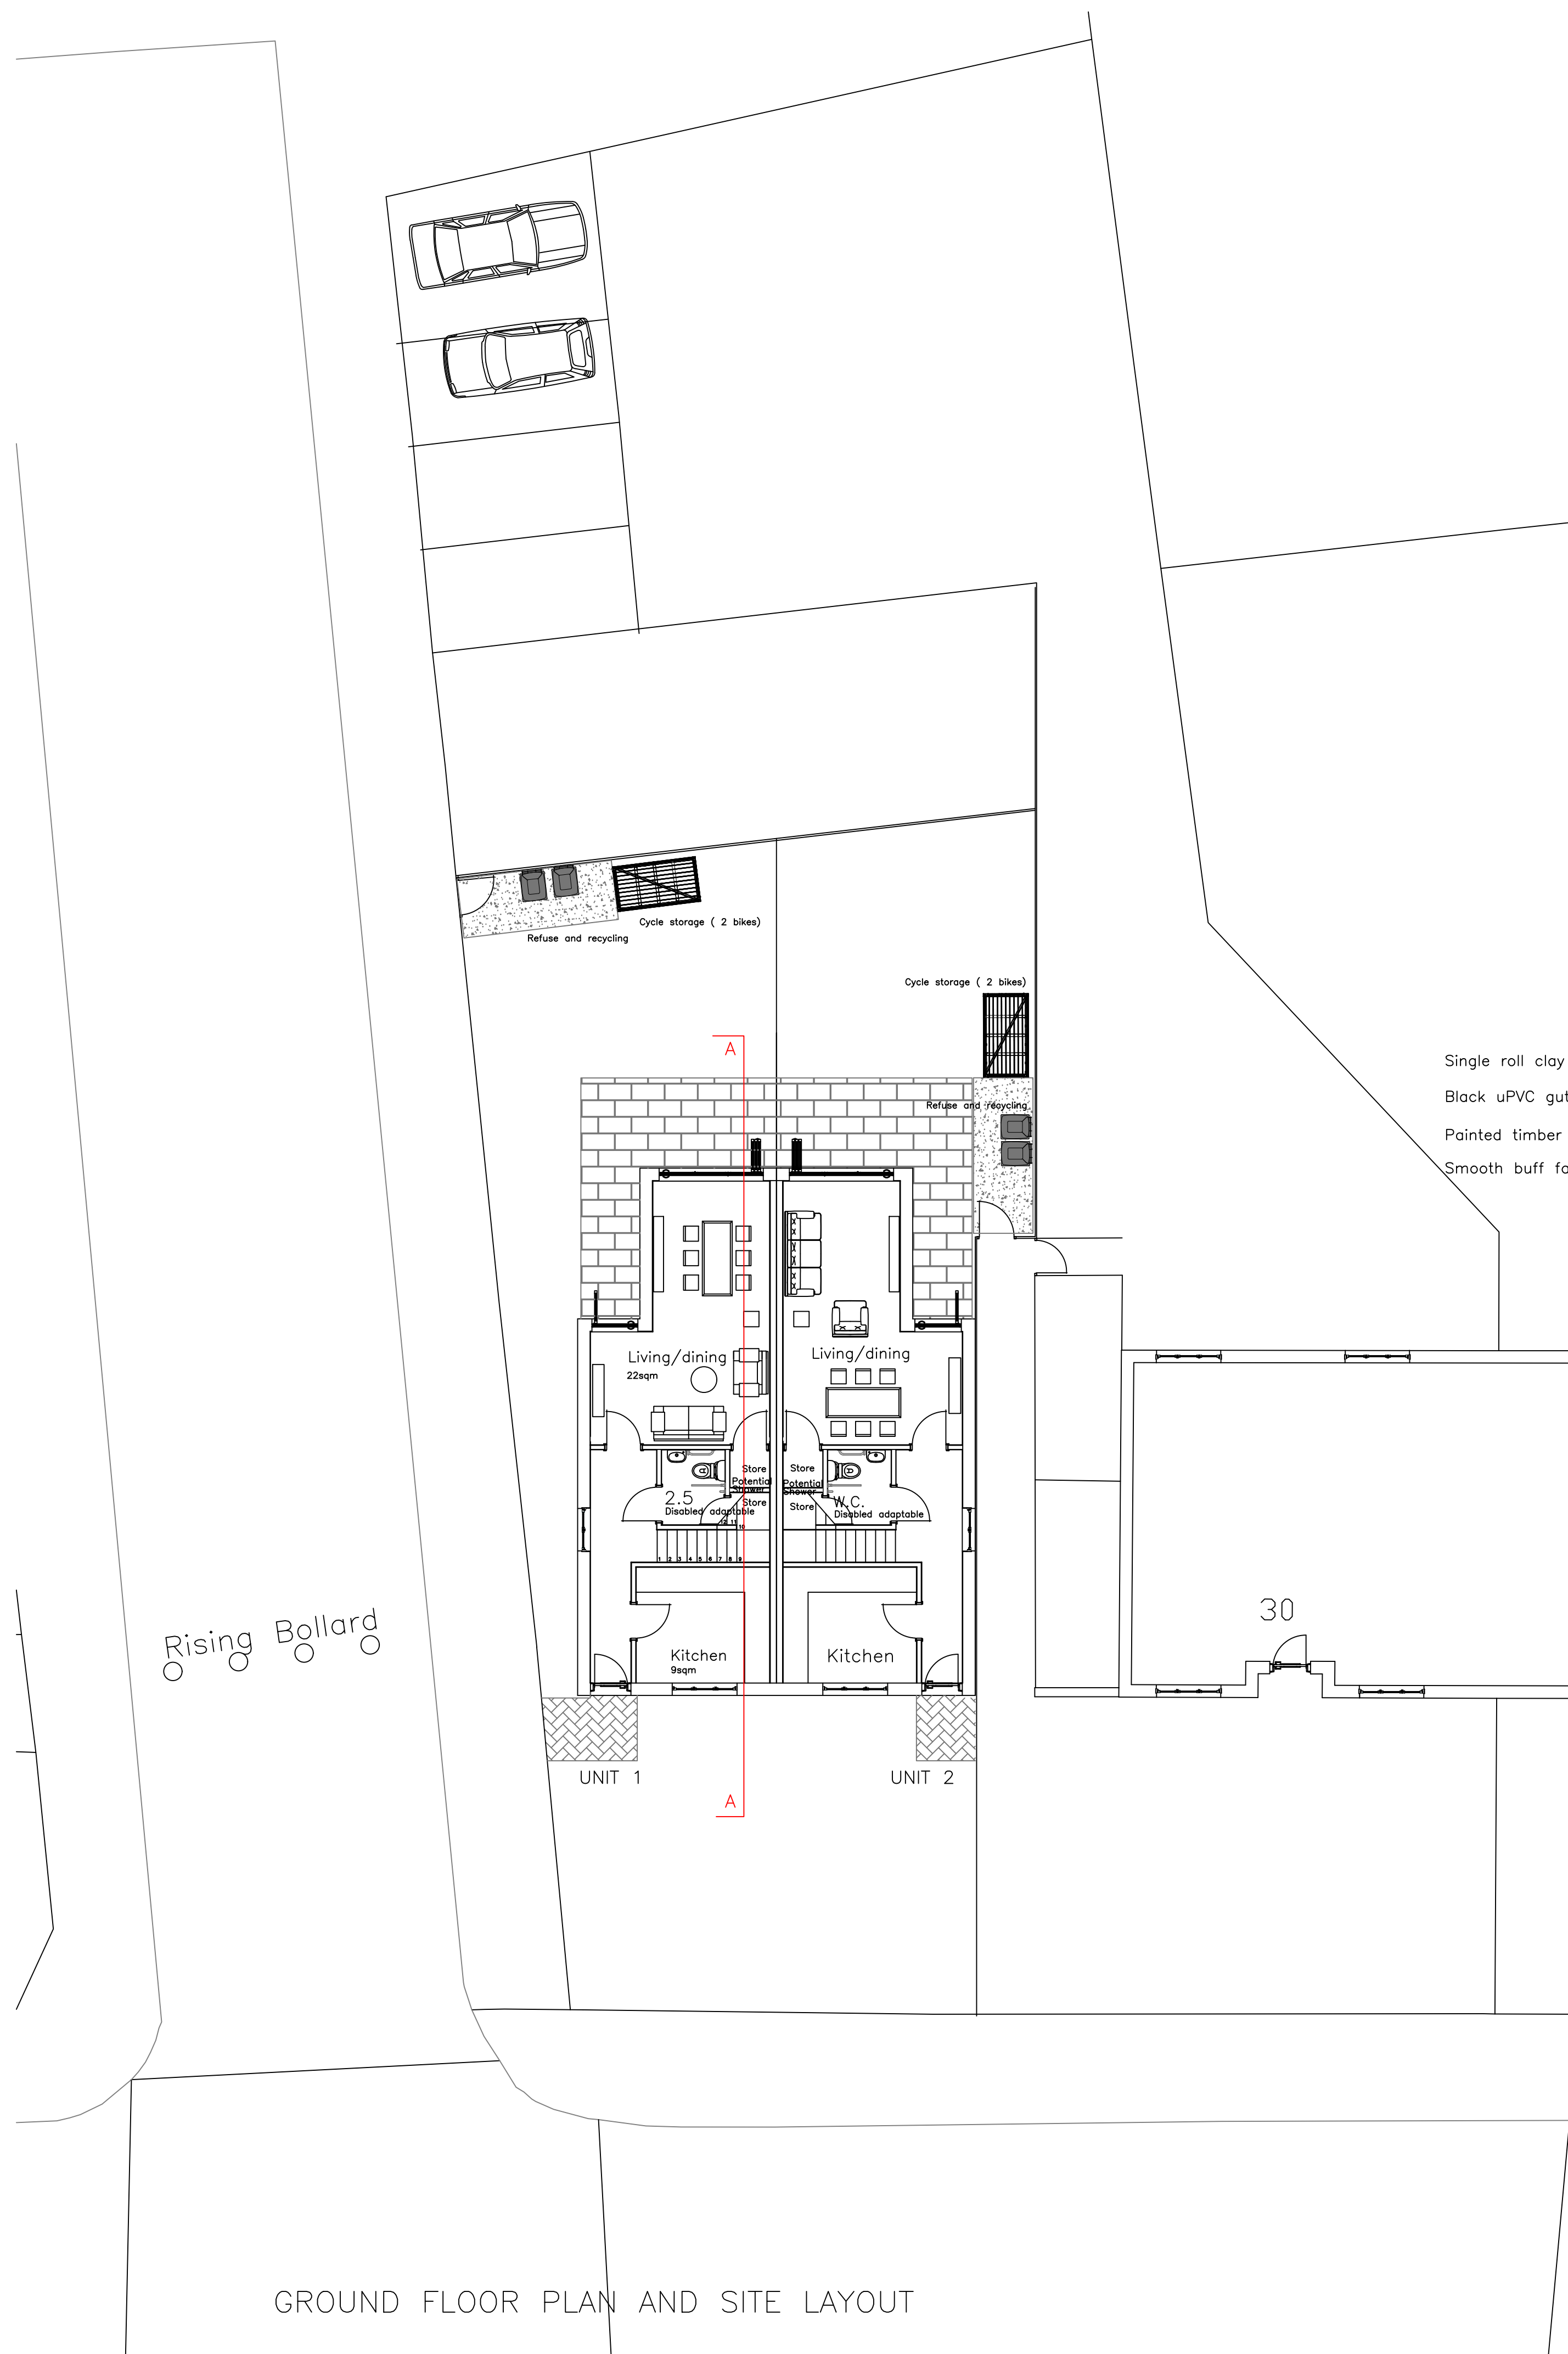

GROUND FLOOR PLAN AND SITE LAYOUT

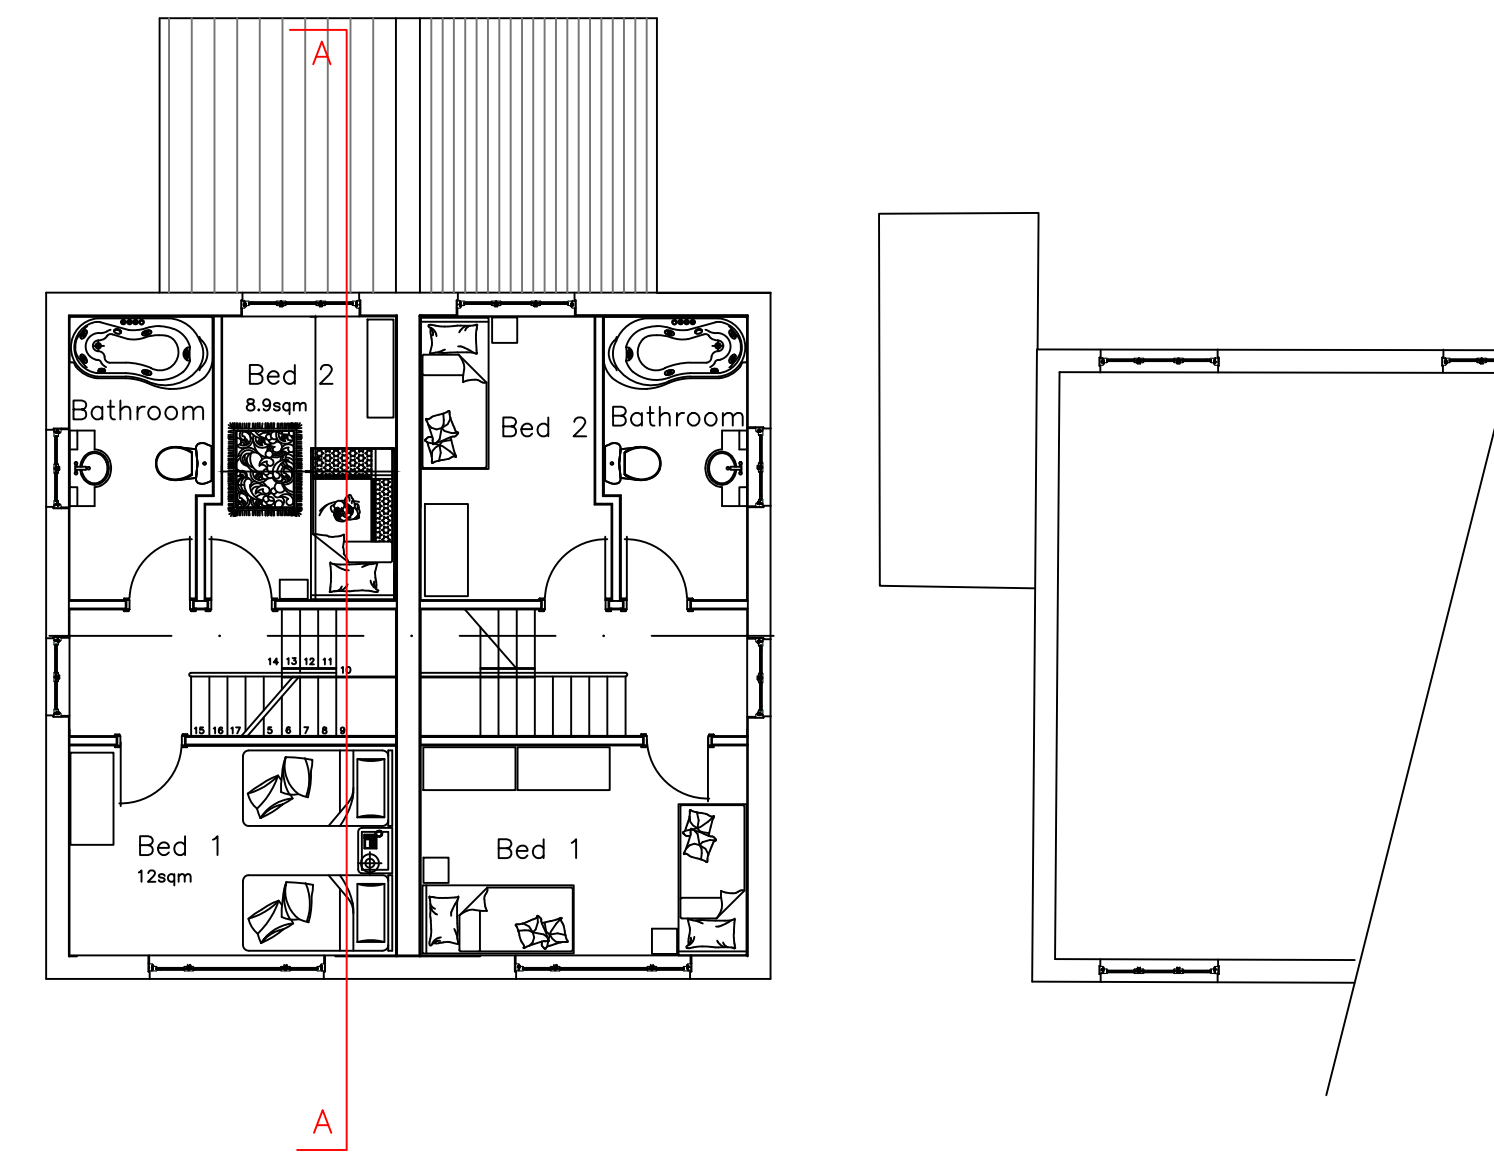


FIRST FLOOR

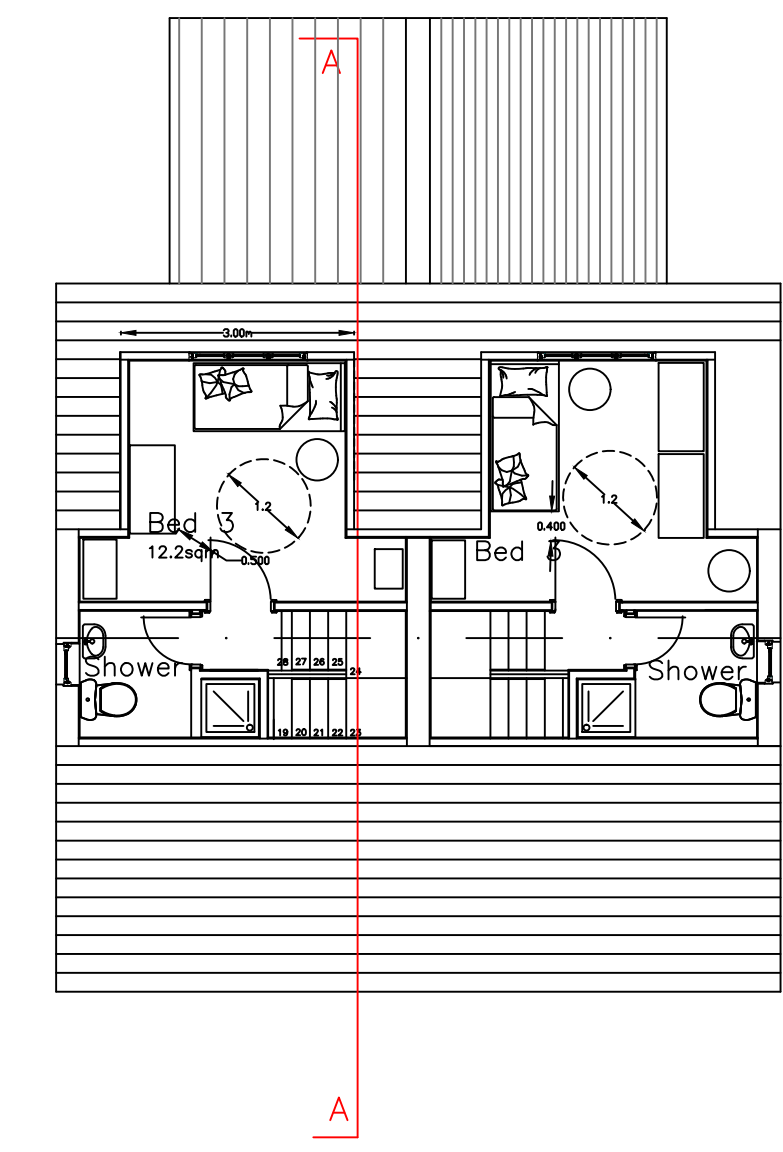

SECOND FLOOR




FRONT ELEVATION

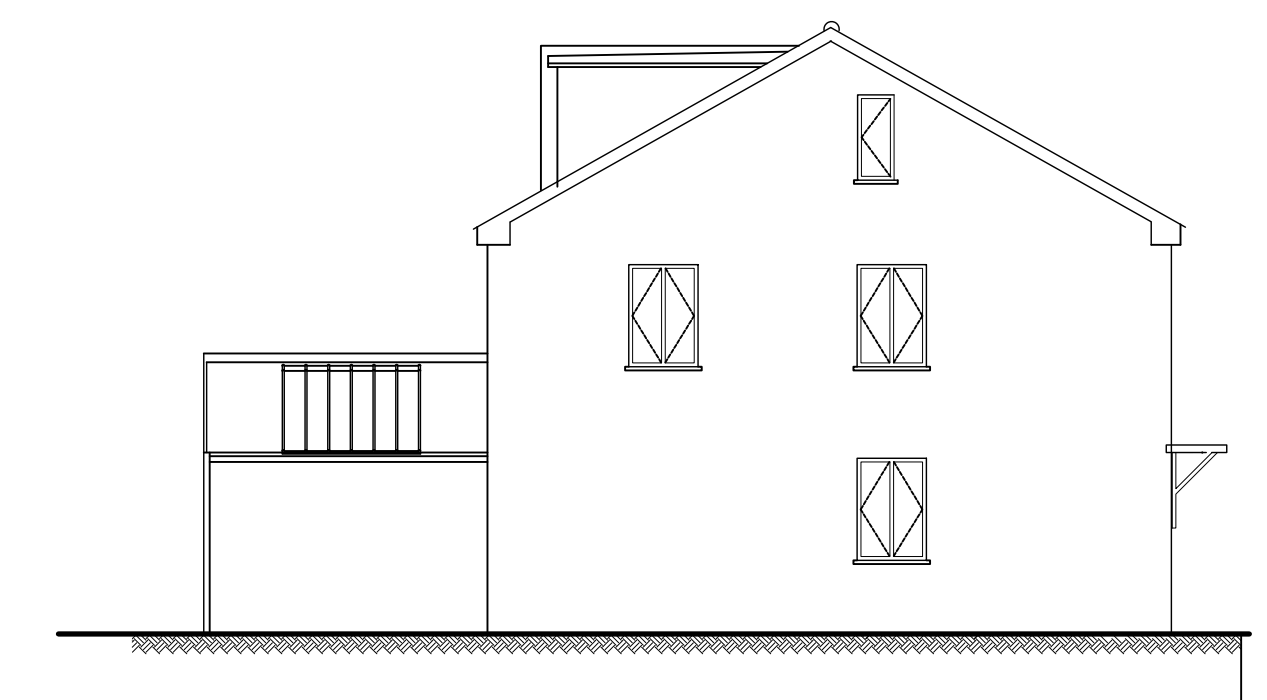


NORTH ELEVATION




REAR ELEVATION

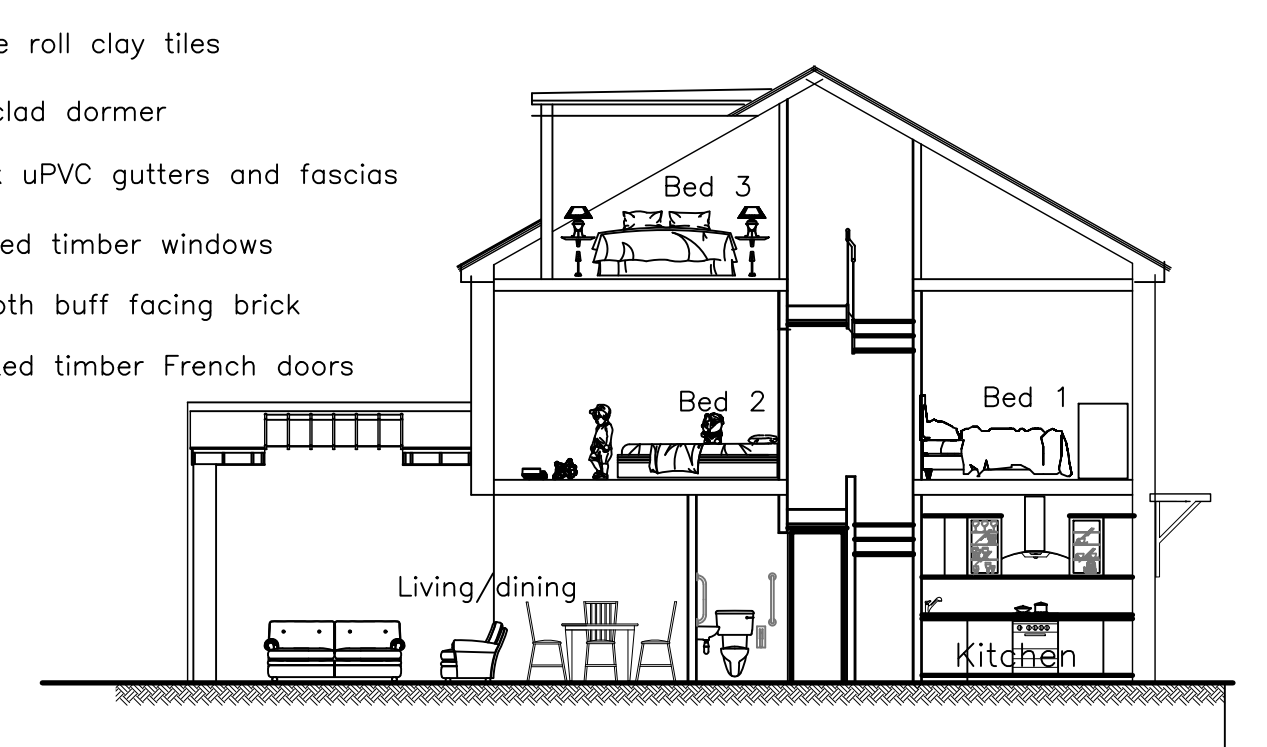

SECTION A-A

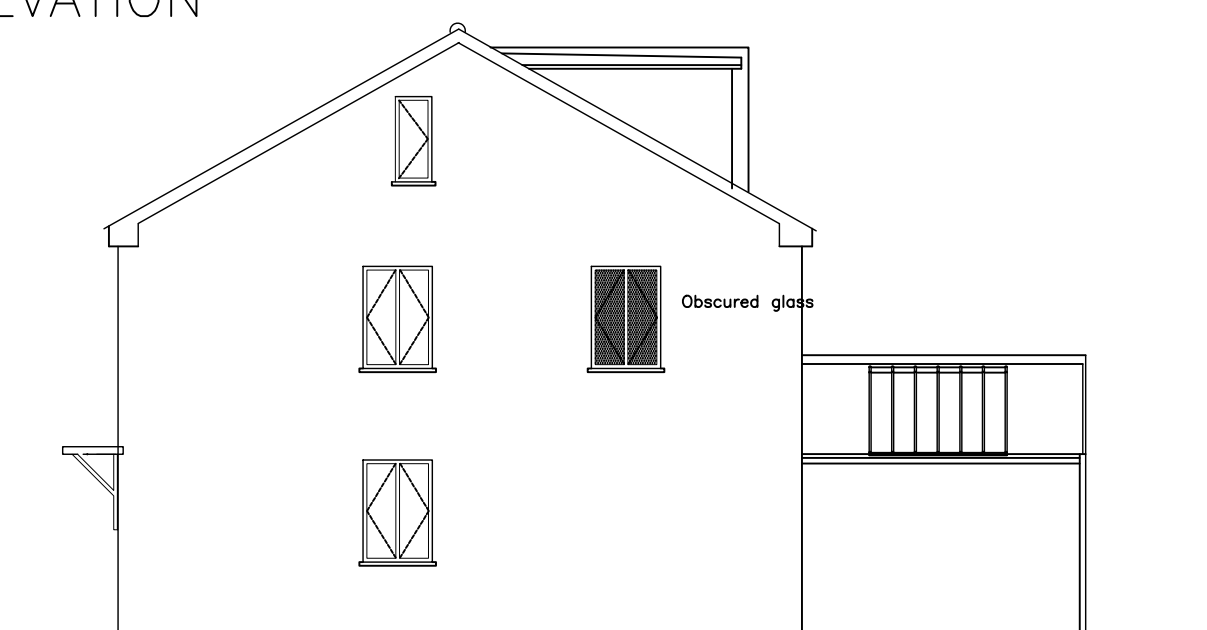

SOUTH ELEVATION

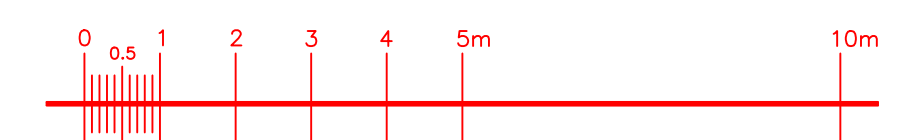

Revision					Legend P Planning Pr Prelim C Contract BC Cont.		Deborah Parker Architects 63, Oriol Road, LONDON E9 5SG Tel 020 8986 0408 Fax 020 8985 7555			
A	Planning Revn	9/18	DJP	9/18A	P	Job title Land adjacent to 30, Harvey Road Hillingdon UB5 8QT Drawing Title 2 No new dwellings proposed plans, sections and elevations	Client Mr M White Drawing No DP274[P]C marked up Scale 1:100 ☉ A1			
B	Planning Revn	10/18	DJP	9/18B	P					
C	Planning Revn	12/18	DJP	9/18B	P					
Rev	Details	Date	Name	Date	Review					