


LOCATION PLAN 1:1250

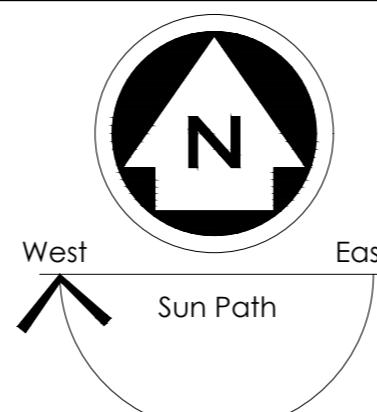


Ordnance Survey (c) Crown Copyright 2023. All rights reserved.


**NOTES**  
 ALL DIMENSIONS TO BE CHECKED ON SITE  
 ALL SUBJECT TO STRUCTURAL  
 ENGINEERS CHECKS AND  
 CALCULATIONS  
 TO BE READ IN CONJUNCTION  
 WITH CONSTRUCTION SPECIFICATION  
 DO NOT SCALE FROM THIS DRAWING  
 EXCEPT FOR THE PURPOSES OF LOCAL  
 AUTHORITY PLANNING  
 IF ANY VARIATIONS ARE MADE TO  
 SPECIFICATION/DRAWINGS WITHOUT DK  
 DESIGNS KNOWLEDGE, DK DESIGNS WILL  
 NOT BE HELD RESPONSIBLE FOR NON  
 COMPLIANCE OF PLANNING AND BUILDING  
 REGULATIONS  
 This drawing and all the information  
 shown is the property of DK Designs and  
 shall not be reproduced in whole or  
 in part or used for any other purpose without written  
 permission of the Company

**DK DESIGNS**  
**FUTURE PROJECTS TODAY**  
 7A HAYWOOD HOUSE, HYDRA BUSINESS PARK  
 NETHER LANE  
 SHEFFIELD  
 S35 1ZX  
 TEL OFFICE: 07591 206852  
 WEB: [www.DK-DESIGNS.CO.UK](http://www.DK-DESIGNS.CO.UK)  
 EMAIL: [DESIGNS@DK-DESIGNS.CO.UK](mailto:DESIGNS@DK-DESIGNS.CO.UK)

Scale: 1:1250 @ A2	Date: May 2023
Drawing Number: 2023-042-01	Revision: -
Drawn by: KLU	

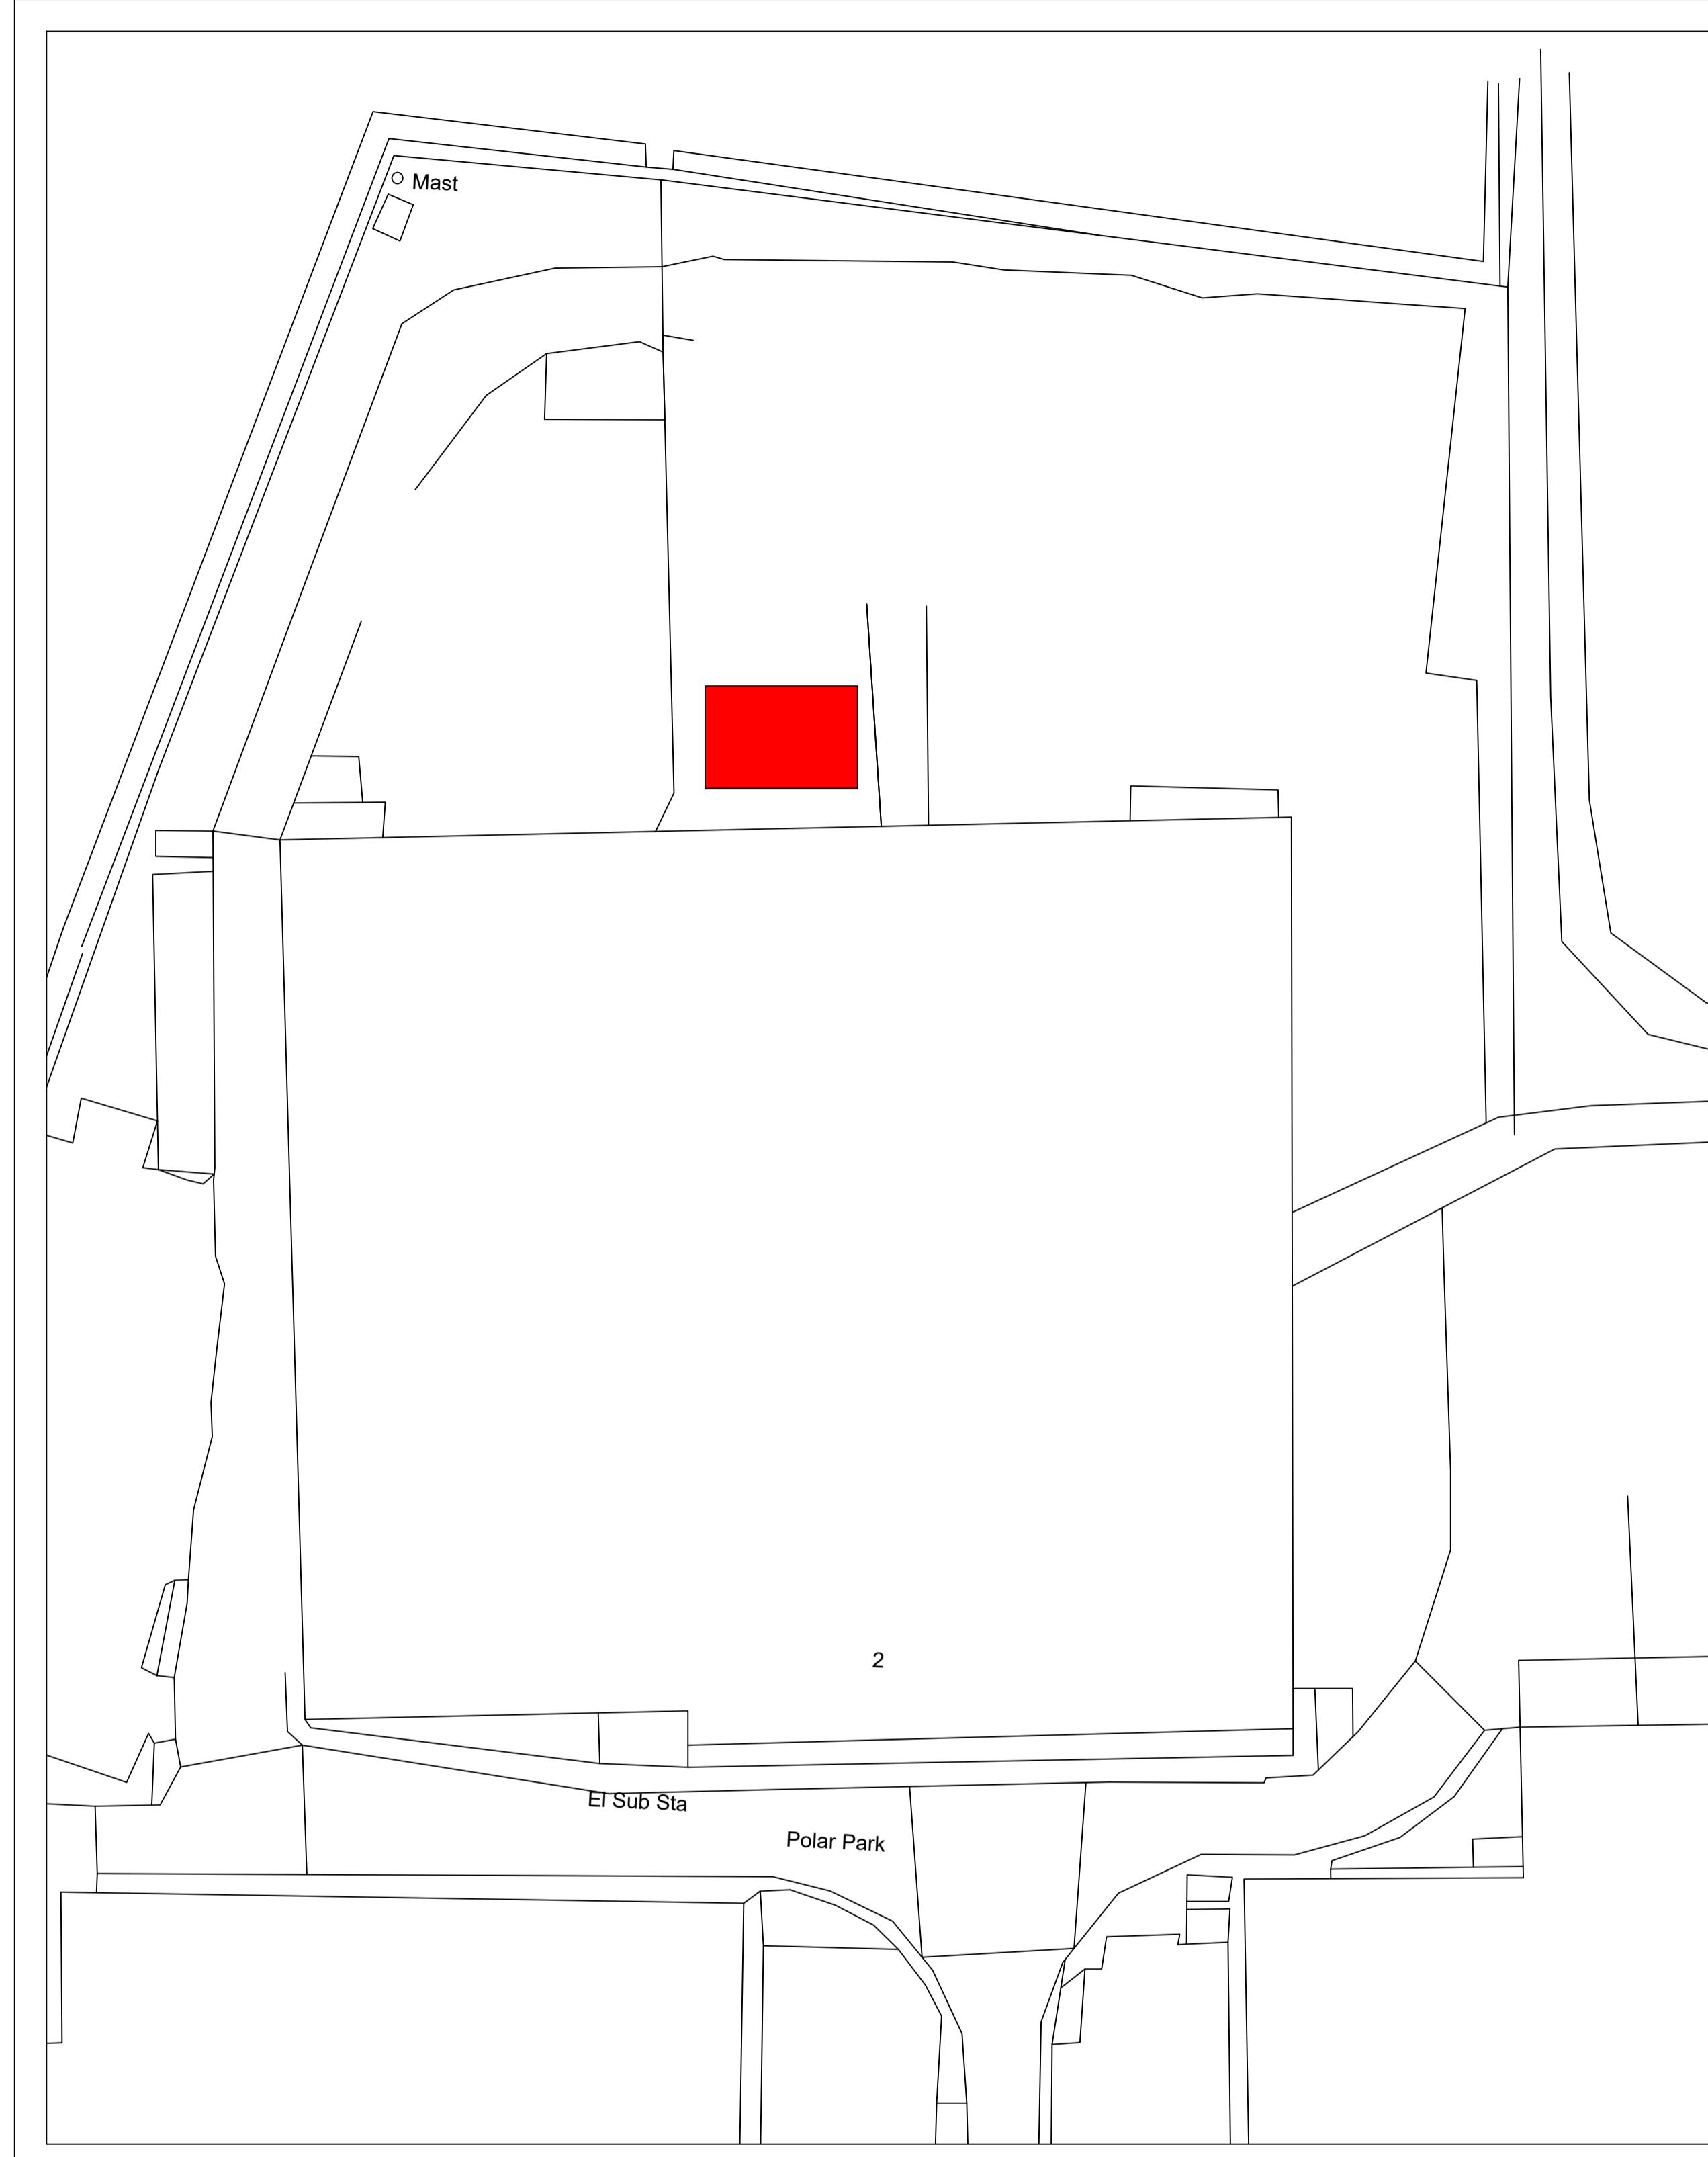

EXISTING SITE PLAN 1:500

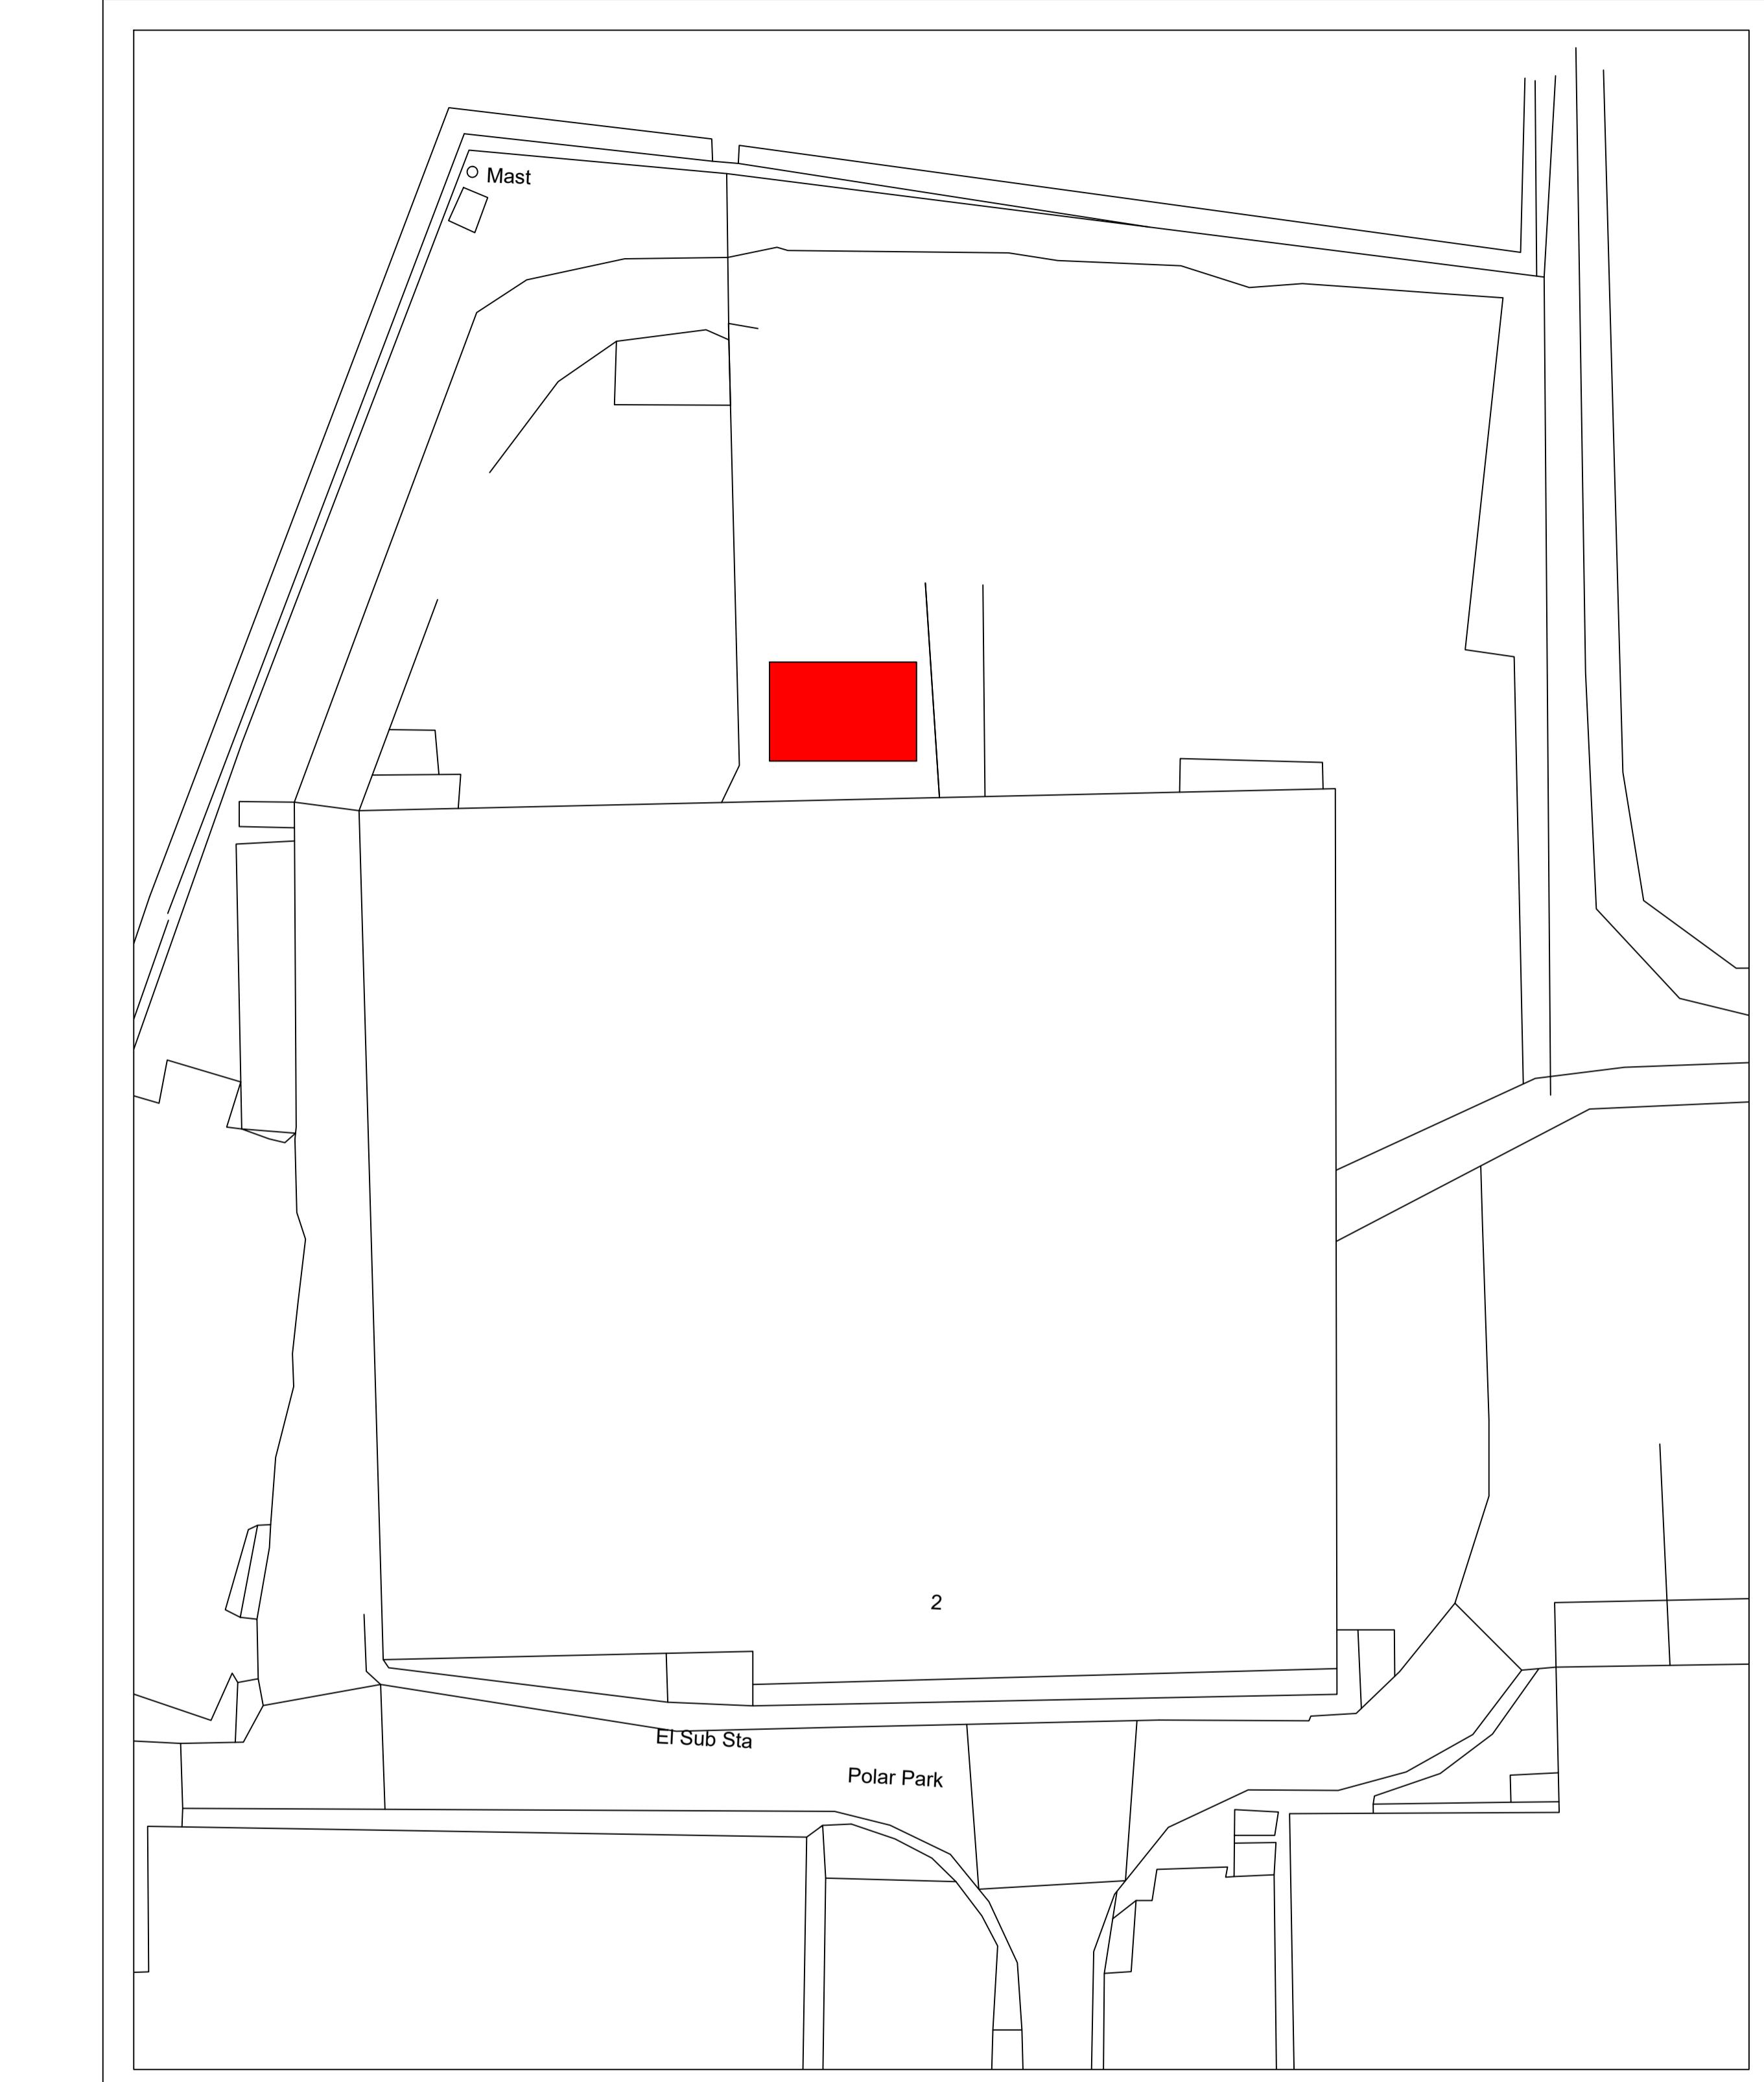

AS BUILT SITE PLAN 1:500

## DRAFT PLANS

**NOTES**

ALL DIMENSIONS TO BE CHECKED ON SITE  
ALL SUBJECT TO STRUCTURAL  
ENGINEERS CHECKS AND  
CALCULATIONS  
TO BE READ IN CONJUNCTION  
WITH CONSTRUCTION SPECIFICATION  
DO NOT SCALE FROM THIS DRAWING  
EXCEPT FOR THE PURPOSES OF LOCAL  
AUTHORITY PLANNING  
IF ANY VARIOUS ARE MADE TO  
SPECIFIC DRAWINGS WITHOUT DK  
DESIGNS KNOWLEDGE, DK DESIGNS WILL  
NOT BE HELD ACCOUNTABLE FOR NON  
COMPLIANCE OF PLANNING AND BUILDING  
REGULATIONS


This drawing and all the information  
shown is the property of DK Designs and  
shall not be copied whole, or in part, or  
used for any other purpose without written  
permission of the Company

**DK DESIGNS**  
FUTURE PROJECTS TODAY

7A HAYWOOD HOUSE, HYDRA BUSINESS PARK  
NETHER LANE  
SHEFFIELD  
S35 1ZX  
TEL OFFICE: 07591 206852  
WEB: [WWW.DK-DESIGNS.CO.UK](http://WWW.DK-DESIGNS.CO.UK)  
EMAIL: [DESIGNS@DK-DESIGNS.CO.UK](mailto:DESIGNS@DK-DESIGNS.CO.UK)


Rev.	Date.	Remarks
Client.	Air Menzies International	
Unit 2B Polar Park, Bath Rd, Heathrow SITE PLANS		
Scales.	1:500 @ A1	Date. May 2023
Drawing Number.	2023-042-02	Revision.
	-	Drawn by. KLU

AS BUILT




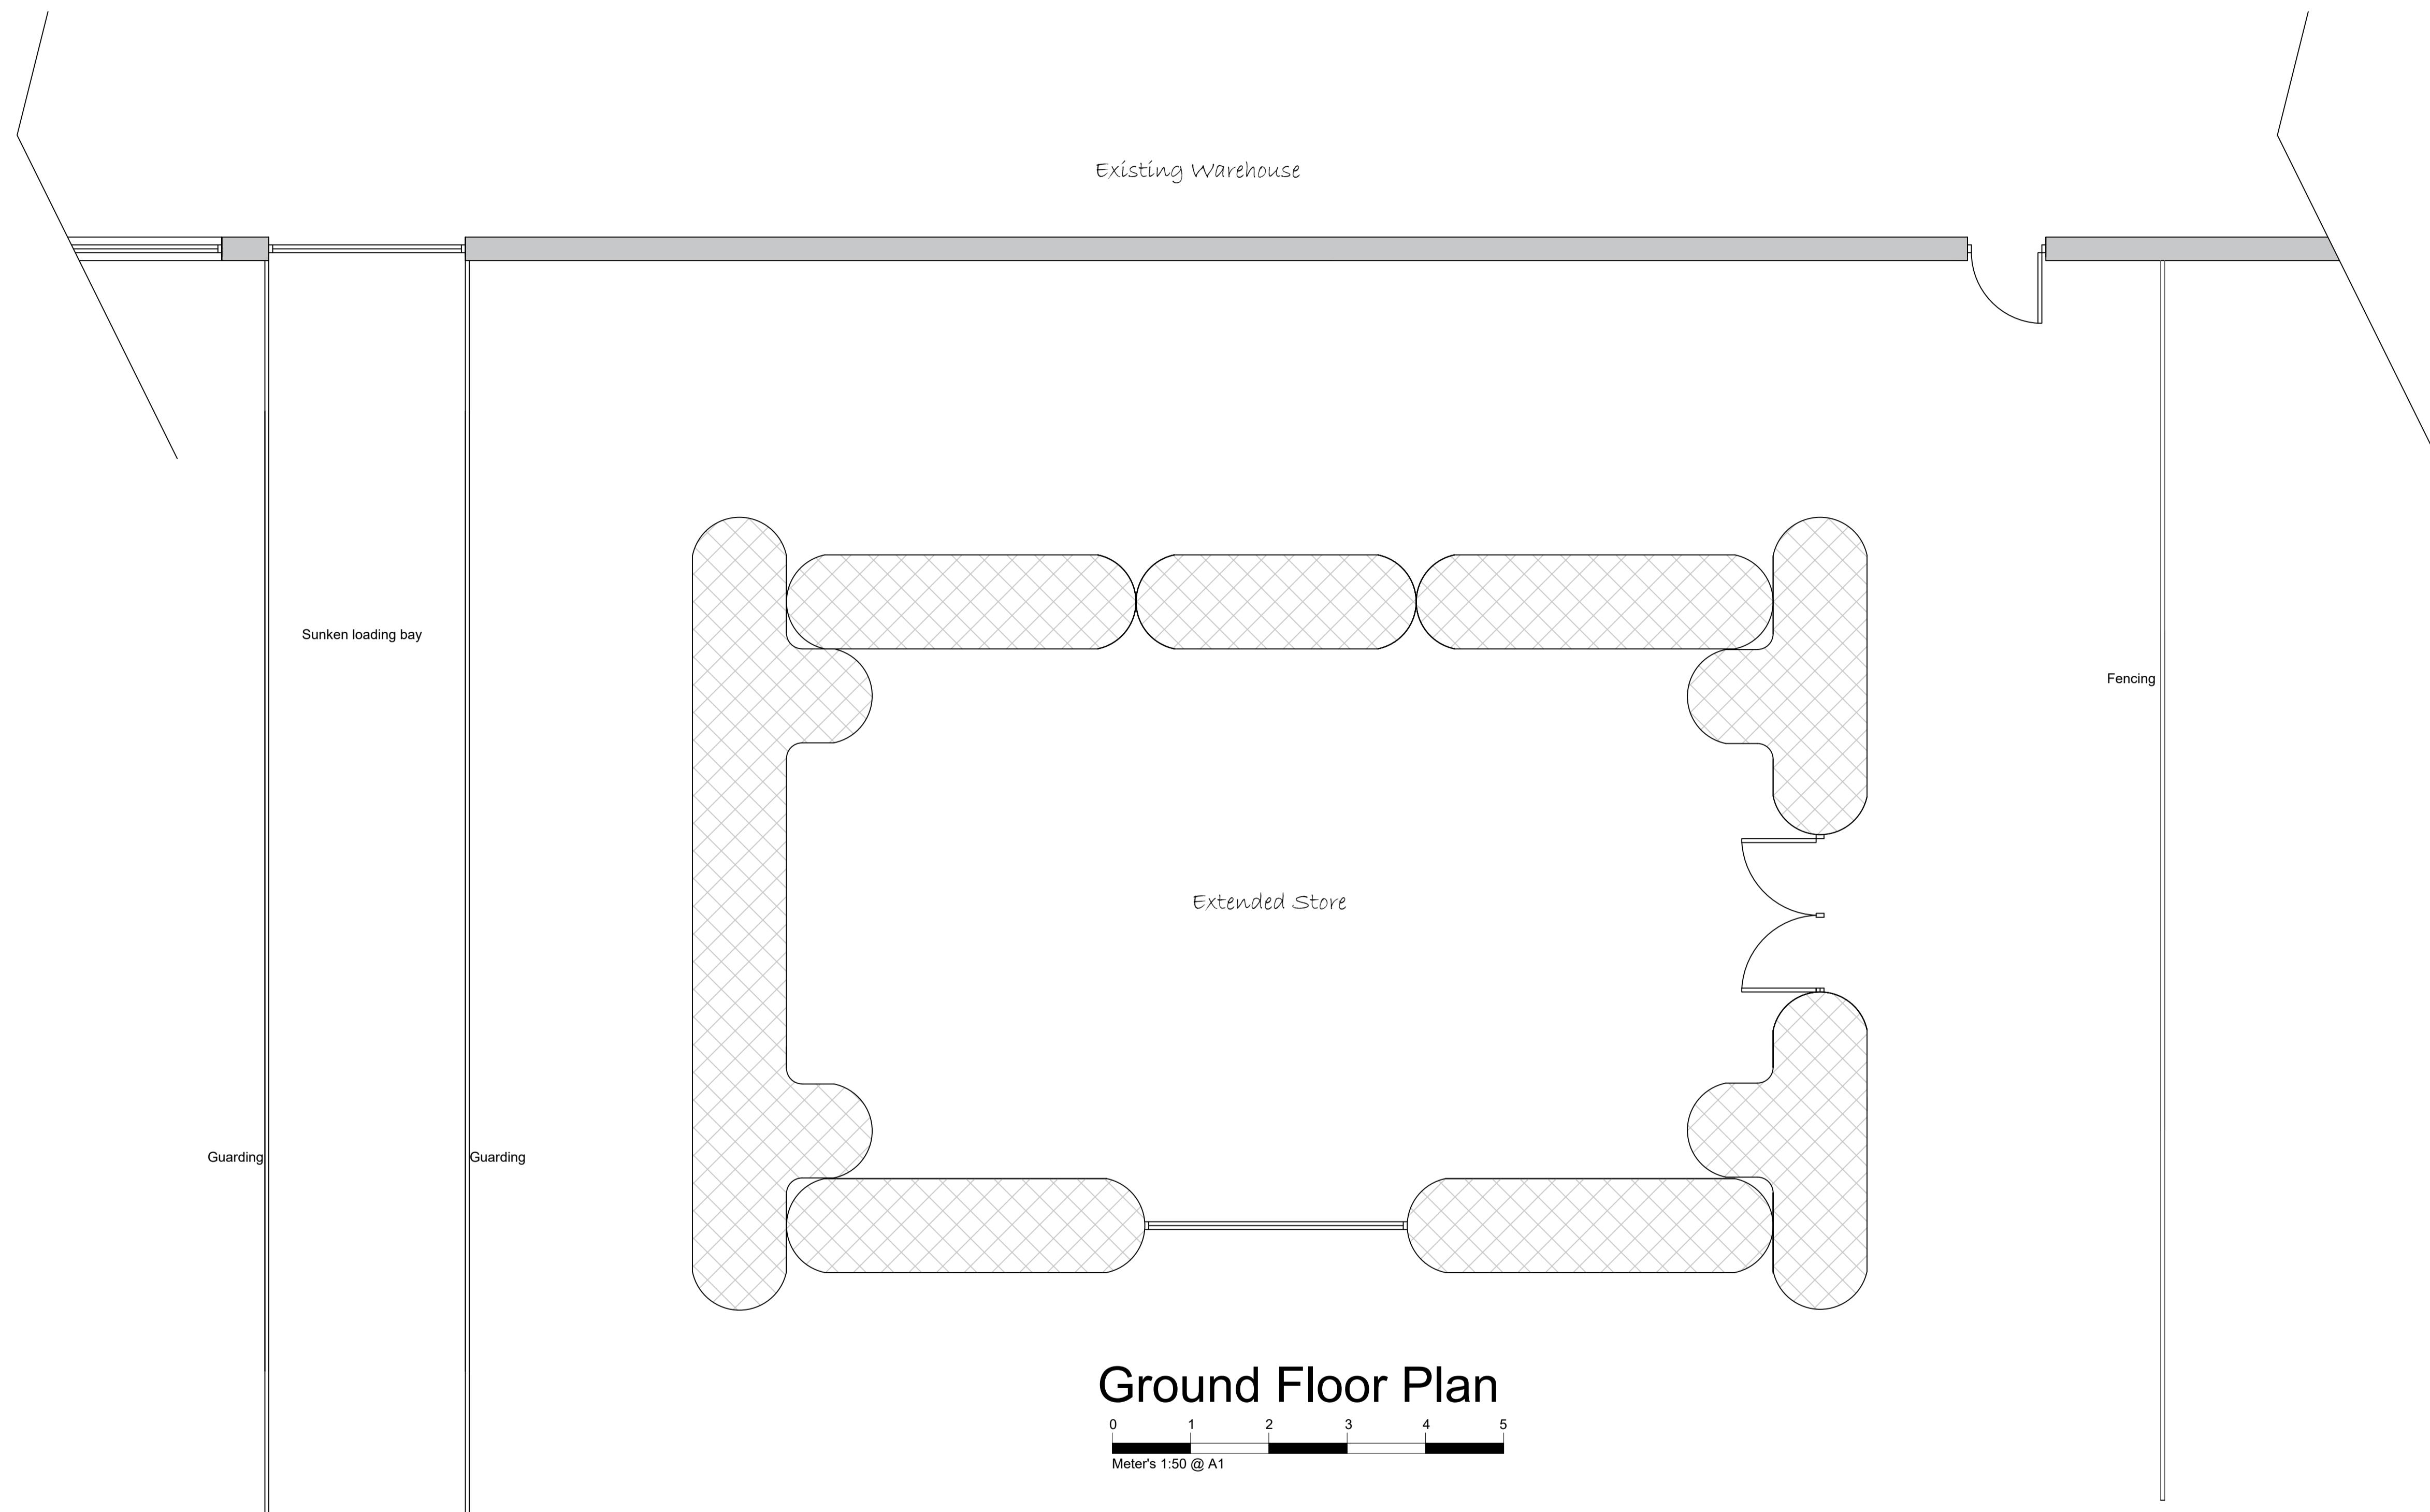


Ground Floor Plan

0 1 2 3 4 5  
Meter's 1:50 @ A1

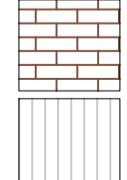Materials	Electrical and Heating	NOTES	DK DESIGNS FUTURE PROJECTS TODAY	Client:
 Brickwork  Inflatable outer	To clients spec <ul style="list-style-type: none"><li>● Pendant Light</li><li>● Spot Light</li><li>● External Light</li><li>● Switch. (All switches 1200mm above floor)</li><li>● Double 13 Amp sockets, 450mm min. above floor.</li><li>● Double 13 Amp sockets, 1050mm min. above floor.</li><li>● T.V aerial socket.(H.L denotes 1050mm high)</li></ul> <ul style="list-style-type: none"><li>SD Smoke detector wired permanently to a separately fused circuit.</li><li>CD Carbon Monoxide Detector to BS EN 50291:2001</li><li>H Heat Detector</li><li>e.f Mechanical extract fan</li><li>External Tap</li><li>External 13 Amp sockets, 450mm min. above floor.</li><li>Radiator position.</li></ul>	<p>ALL DIMENSIONS TO BE CHECKED ON SITE. ALL SUBJECT TO STRUCTURAL ENGINEERS CHECKS AND CALCULATIONS TO BE READ IN CONJUNCTION WITH CONSTRUCTION SPECIFICATION DO NOT SCALE FROM THIS DRAWING EXCEPT FOR THE PURPOSES OF LOCAL AUTHORITY PLANNING ANY VIEWS, ELEVATIONS, MATERIALS SPECIFICATIONS AND DRAWINGS OTHER THAN DK DESIGNS KNOWLEDGE, DK DESIGNS WILL NOT BE HELD ACCOUNTABLE FOR NON COMPLIANCE OF PLANNING AND BUILDING REGULATIONS.</p> <p>This drawing and all the information shown is the property of DK Designs and shall not be copied whole or in part, or used for any other purpose without written permission of the Company</p>	<p>7A HAYWOOD HOUSE, HYDRA BUSINESS PARK NETHER LANE SHEFFIELD S35 1ZX</p> <p>TEL OFFICE:- 07591 206852 WEB:- <a href="http://www.DK-DESIGNS.CO.UK">www.DK-DESIGNS.CO.UK</a> EMAIL :- <a href="mailto:DESIGNS@DK-DESIGNS.CO.UK">DESIGNS@DK-DESIGNS.CO.UK</a></p>	Air Menzies International
			Scales 1:50 @ A1	Date: May 2023
			Drawing Number 2023-042-03	Revision: -
			Drawn by: KLU	

# AS BUILT

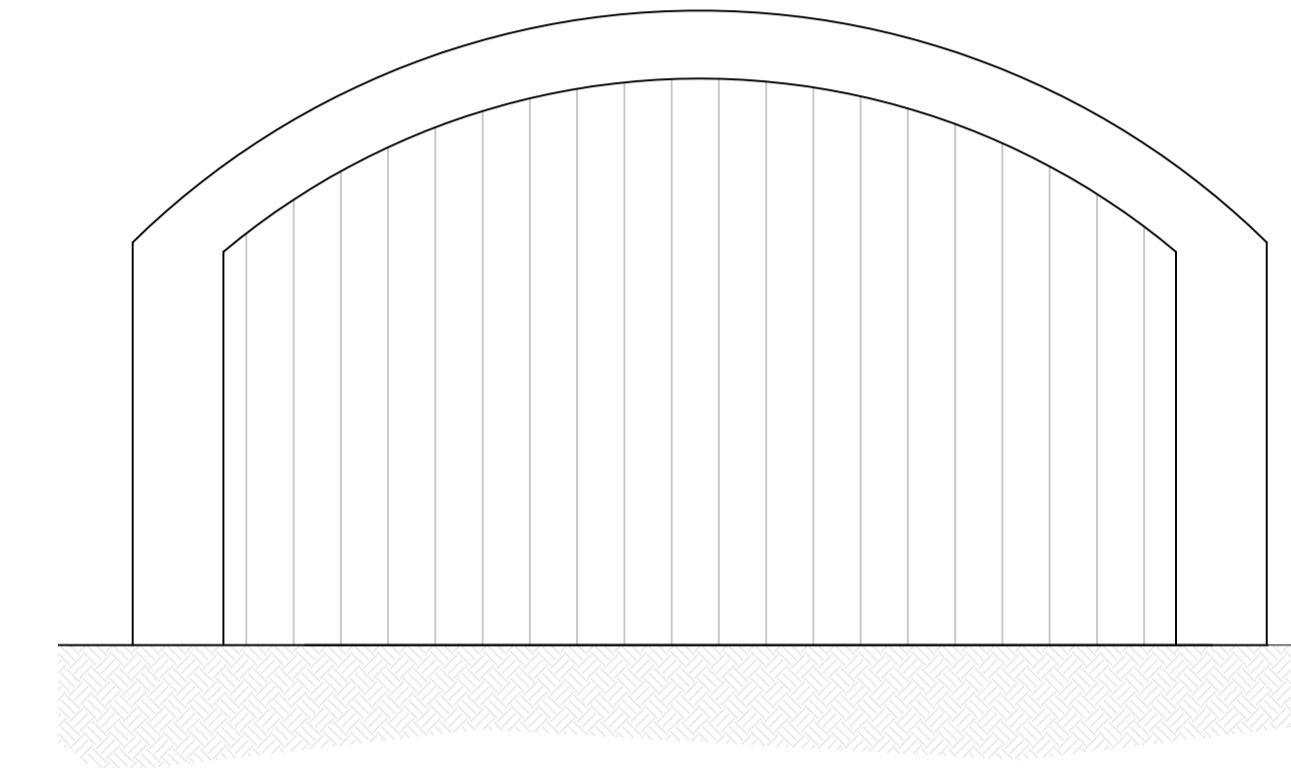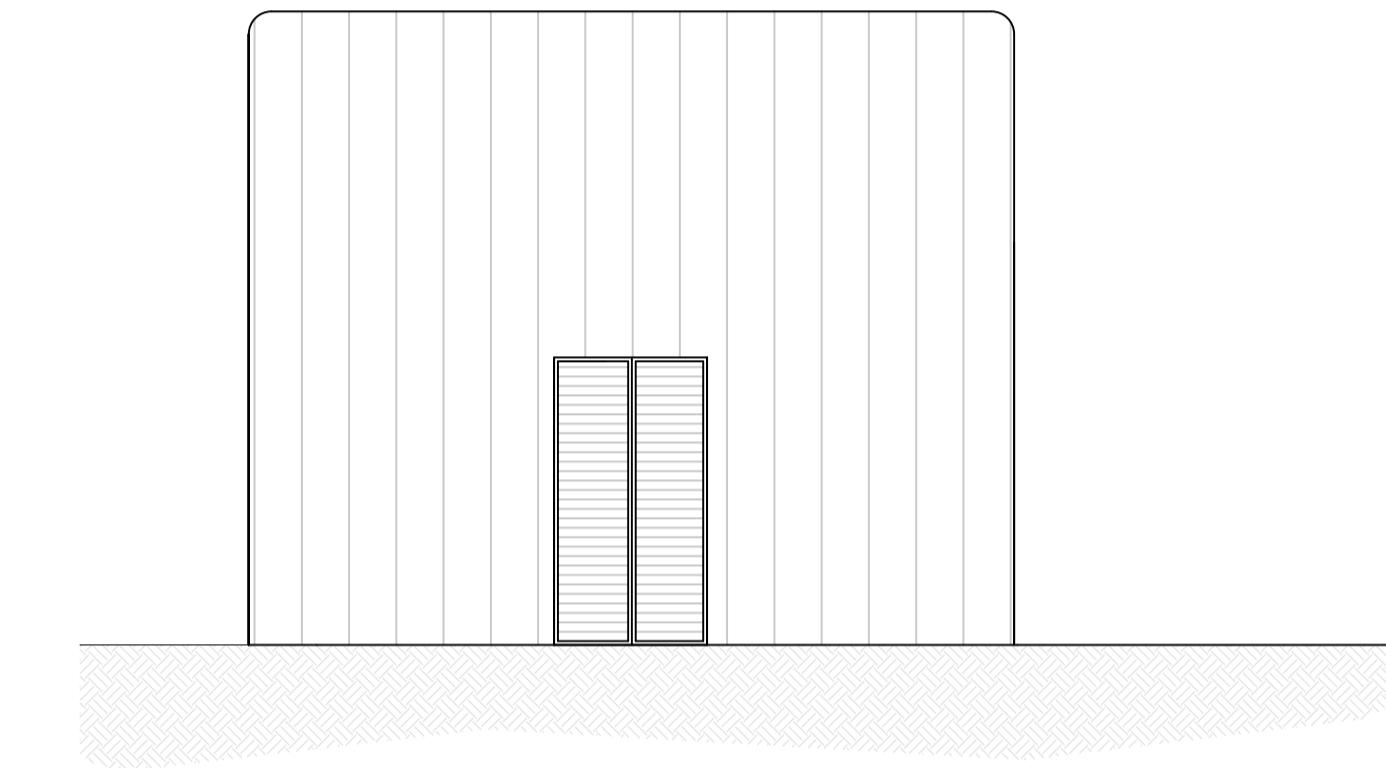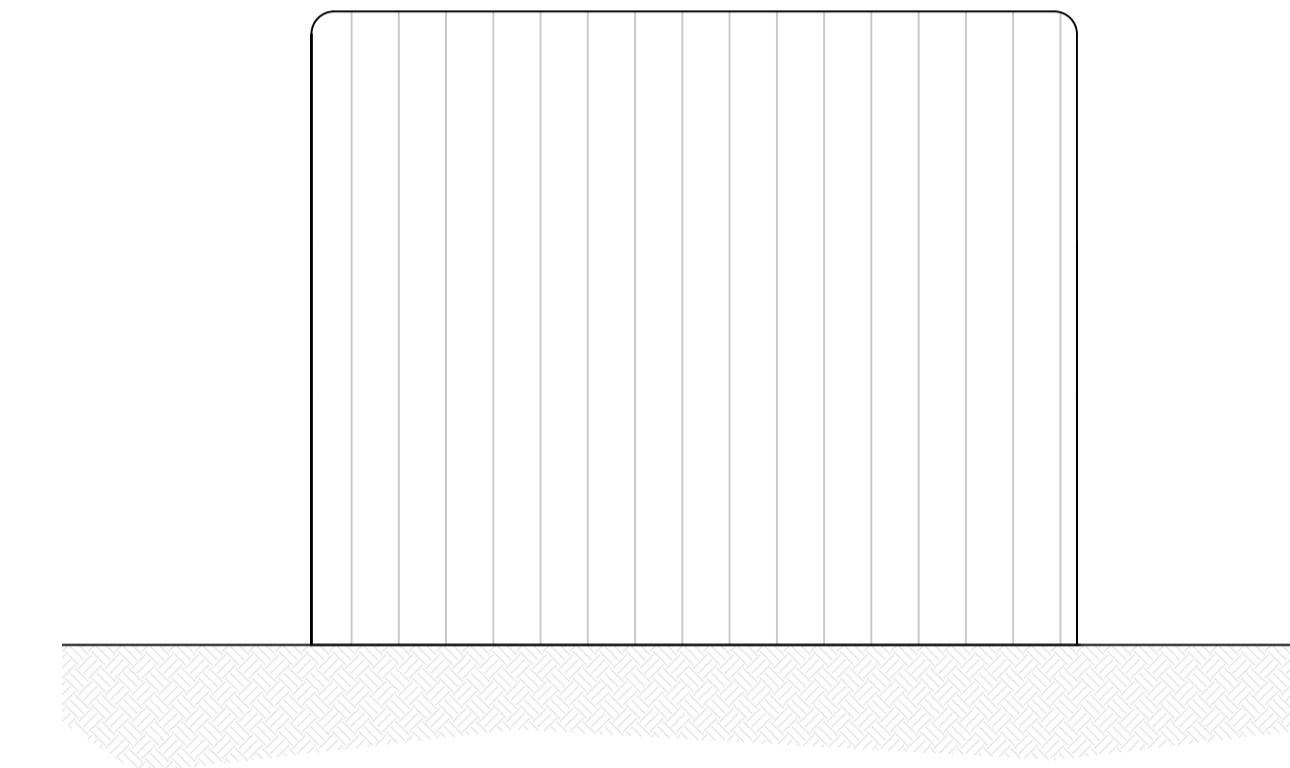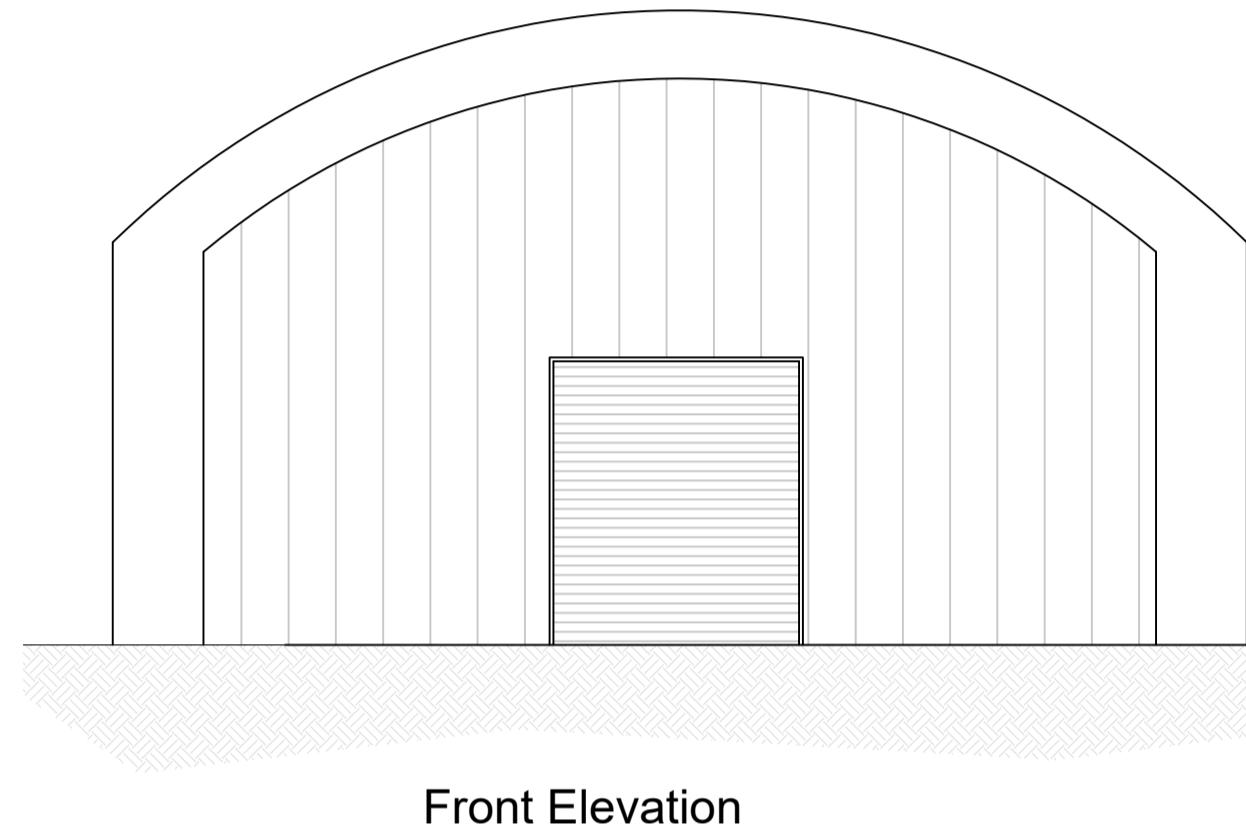

0 1 2 3 4 5


Side Elevation

Side Elevation

Rear Elevation

Meter's 1:100 @ A1

## Materials

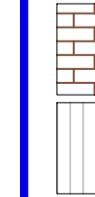

Brickwork



Inflatable outer

## Electrical and Heating

To clients spec

- ⊕ Pendant Light
- ⊖ Spot Light
- ⊖ External Light
- ✓ Switch. (All switches 1200mm above floor)
- ⊖ Double 13 Amp sockets, 450mm min. above floor.
- ⊖ Double 13 Amp sockets, 1050mm min. above floor.
- ◀ T.V aerial socket.(H.L denotes 1050mm high)

- SD Smoke detector wired permanently to a separately fused circuit.
- CD Carbon Monoxide Detector to BS EN 50291:2001
- H Heat Detector
- ⊖ Mechanical extract fan e.f
- ⊖ External Tap
- SD External 13 Amp sockets, 450mm min. above floor.
- ⊖ Radiator position.

## NOTES

ALL DIMENSIONS TO BE CHECKED ON SITE.  
ALL SUBJECT TO STRUCTURAL  
ENGINEERS CHECKS AND  
CALCULATIONS  
TO BE READ IN CONJUNCTION  
WITH CONSTRUCTION SPECIFICATION  
DO NOT SCALE FROM THIS DRAWING  
EXCEPT FOR THE PURPOSES OF LOCAL  
AUTHORITY PLANNING  
ANY VARIATIONS MADE TO  
SPECIFICATIONS OR DRAWINGS OTHER THAN DK  
DESIGNS KNOWLEDGE, DK DESIGNS WILL  
NOT BE HELD ACCOUNTABLE FOR NON  
COMPLIANCE OF PLANNING AND BUILDING  
REGULATIONS.

This drawing and all the information  
shown is the property of DK Designs and  
shall not be copied whole or in part, or  
used for any other purpose without written  
permission of the Company

**DK DESIGNS**  
FUTURE PROJECTS TODAY

7A HAYWOOD HOUSE, HYDRA BUSINESS PARK  
NETHER LANE

SHEFFIELD  
S35 1ZX

TEL OFFICE:- 07591 206852

WEB:- [www.DK-DESIGNS.CO.UK](http://www.DK-DESIGNS.CO.UK)

EMAIL :- [DESIGNS@DK-DESIGNS.CO.UK](mailto:DESIGNS@DK-DESIGNS.CO.UK)

Client:  
Air Menzies International

Unit 2B Polar Park, Bath Rd, Heathrow  
AS BUILT ELEVATIONS

Scales:  
1:50 @ A1



Date:  
May 2023



Drawing Number:  
2023-042-04

Revision:  
-

Drawn by:  
KLU

# AS BUILT

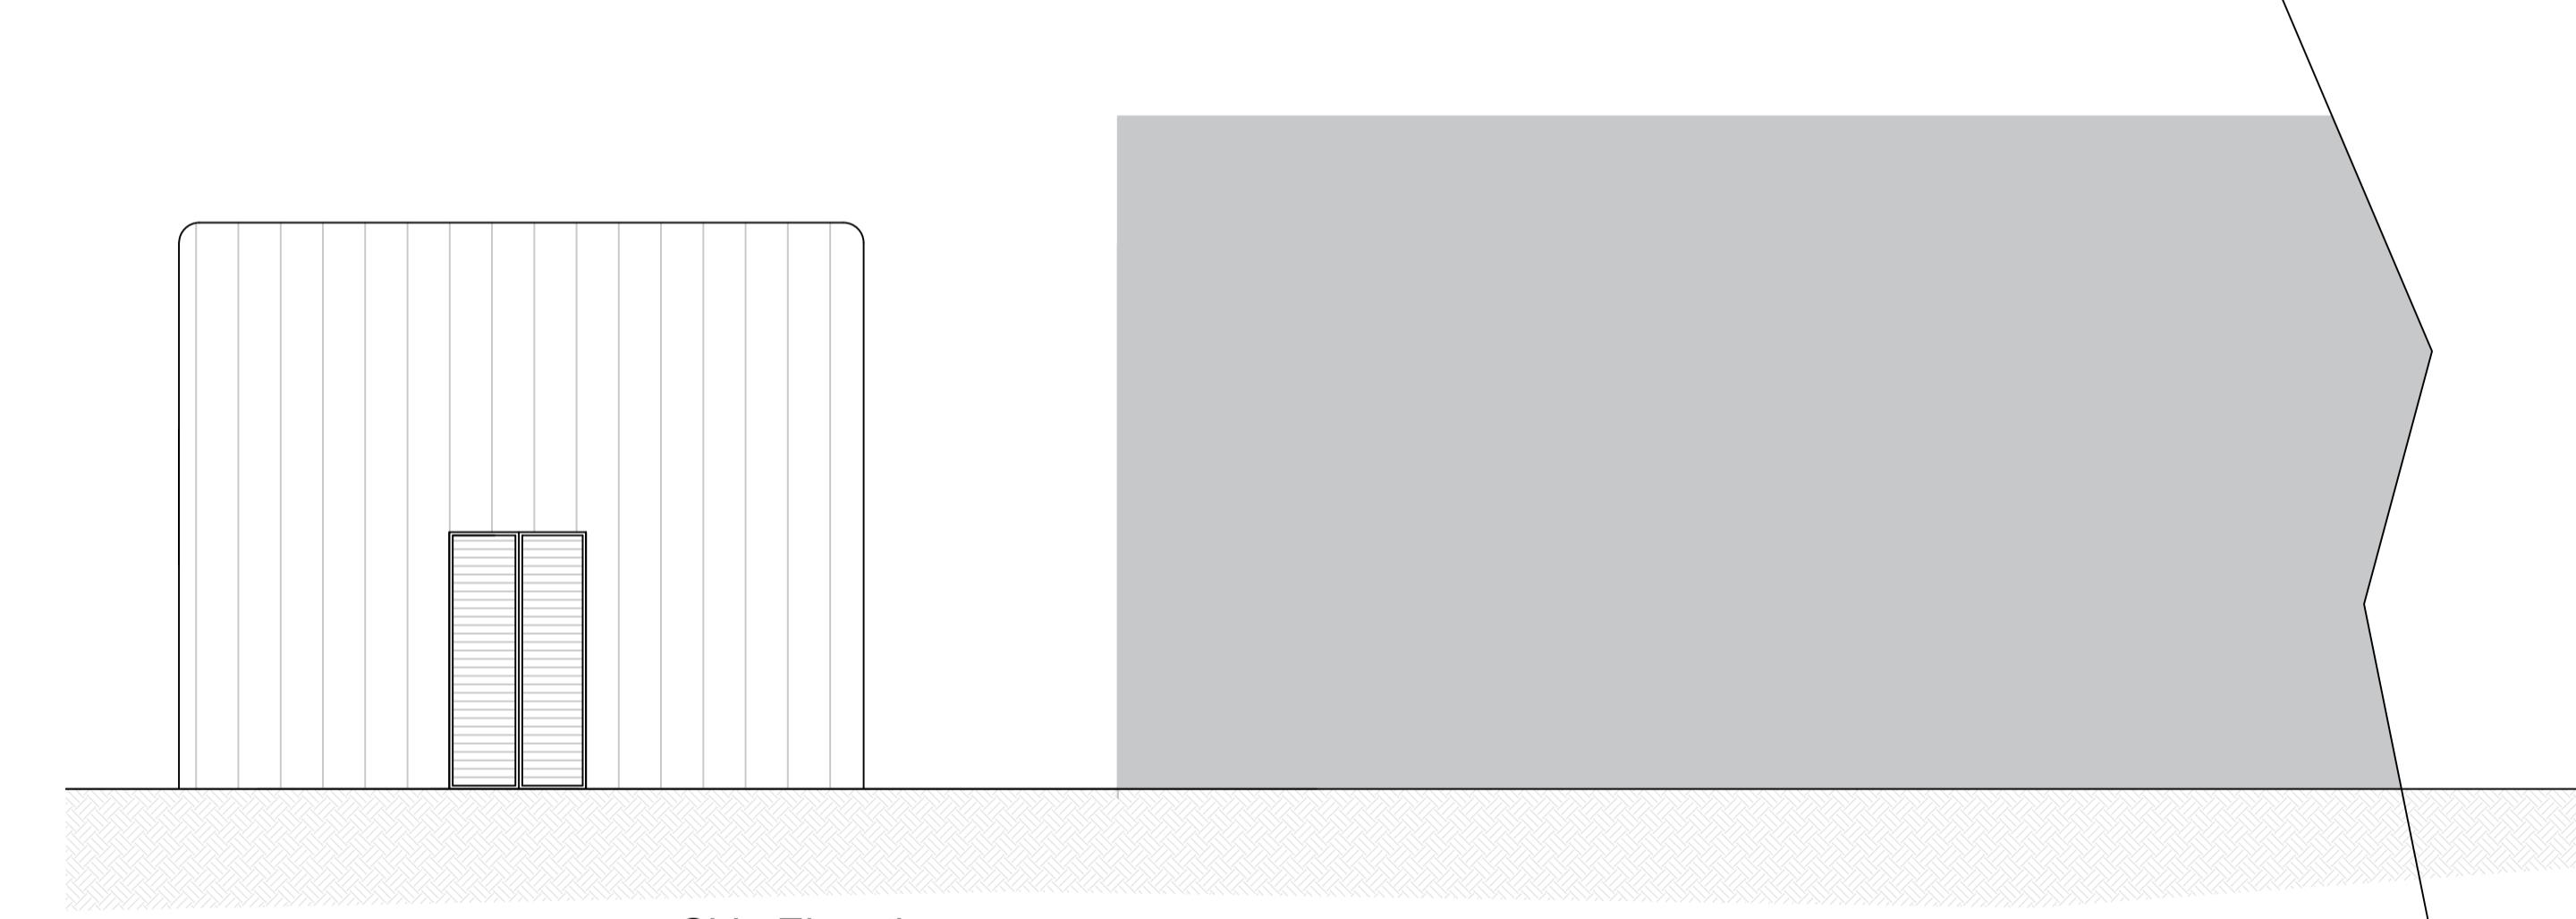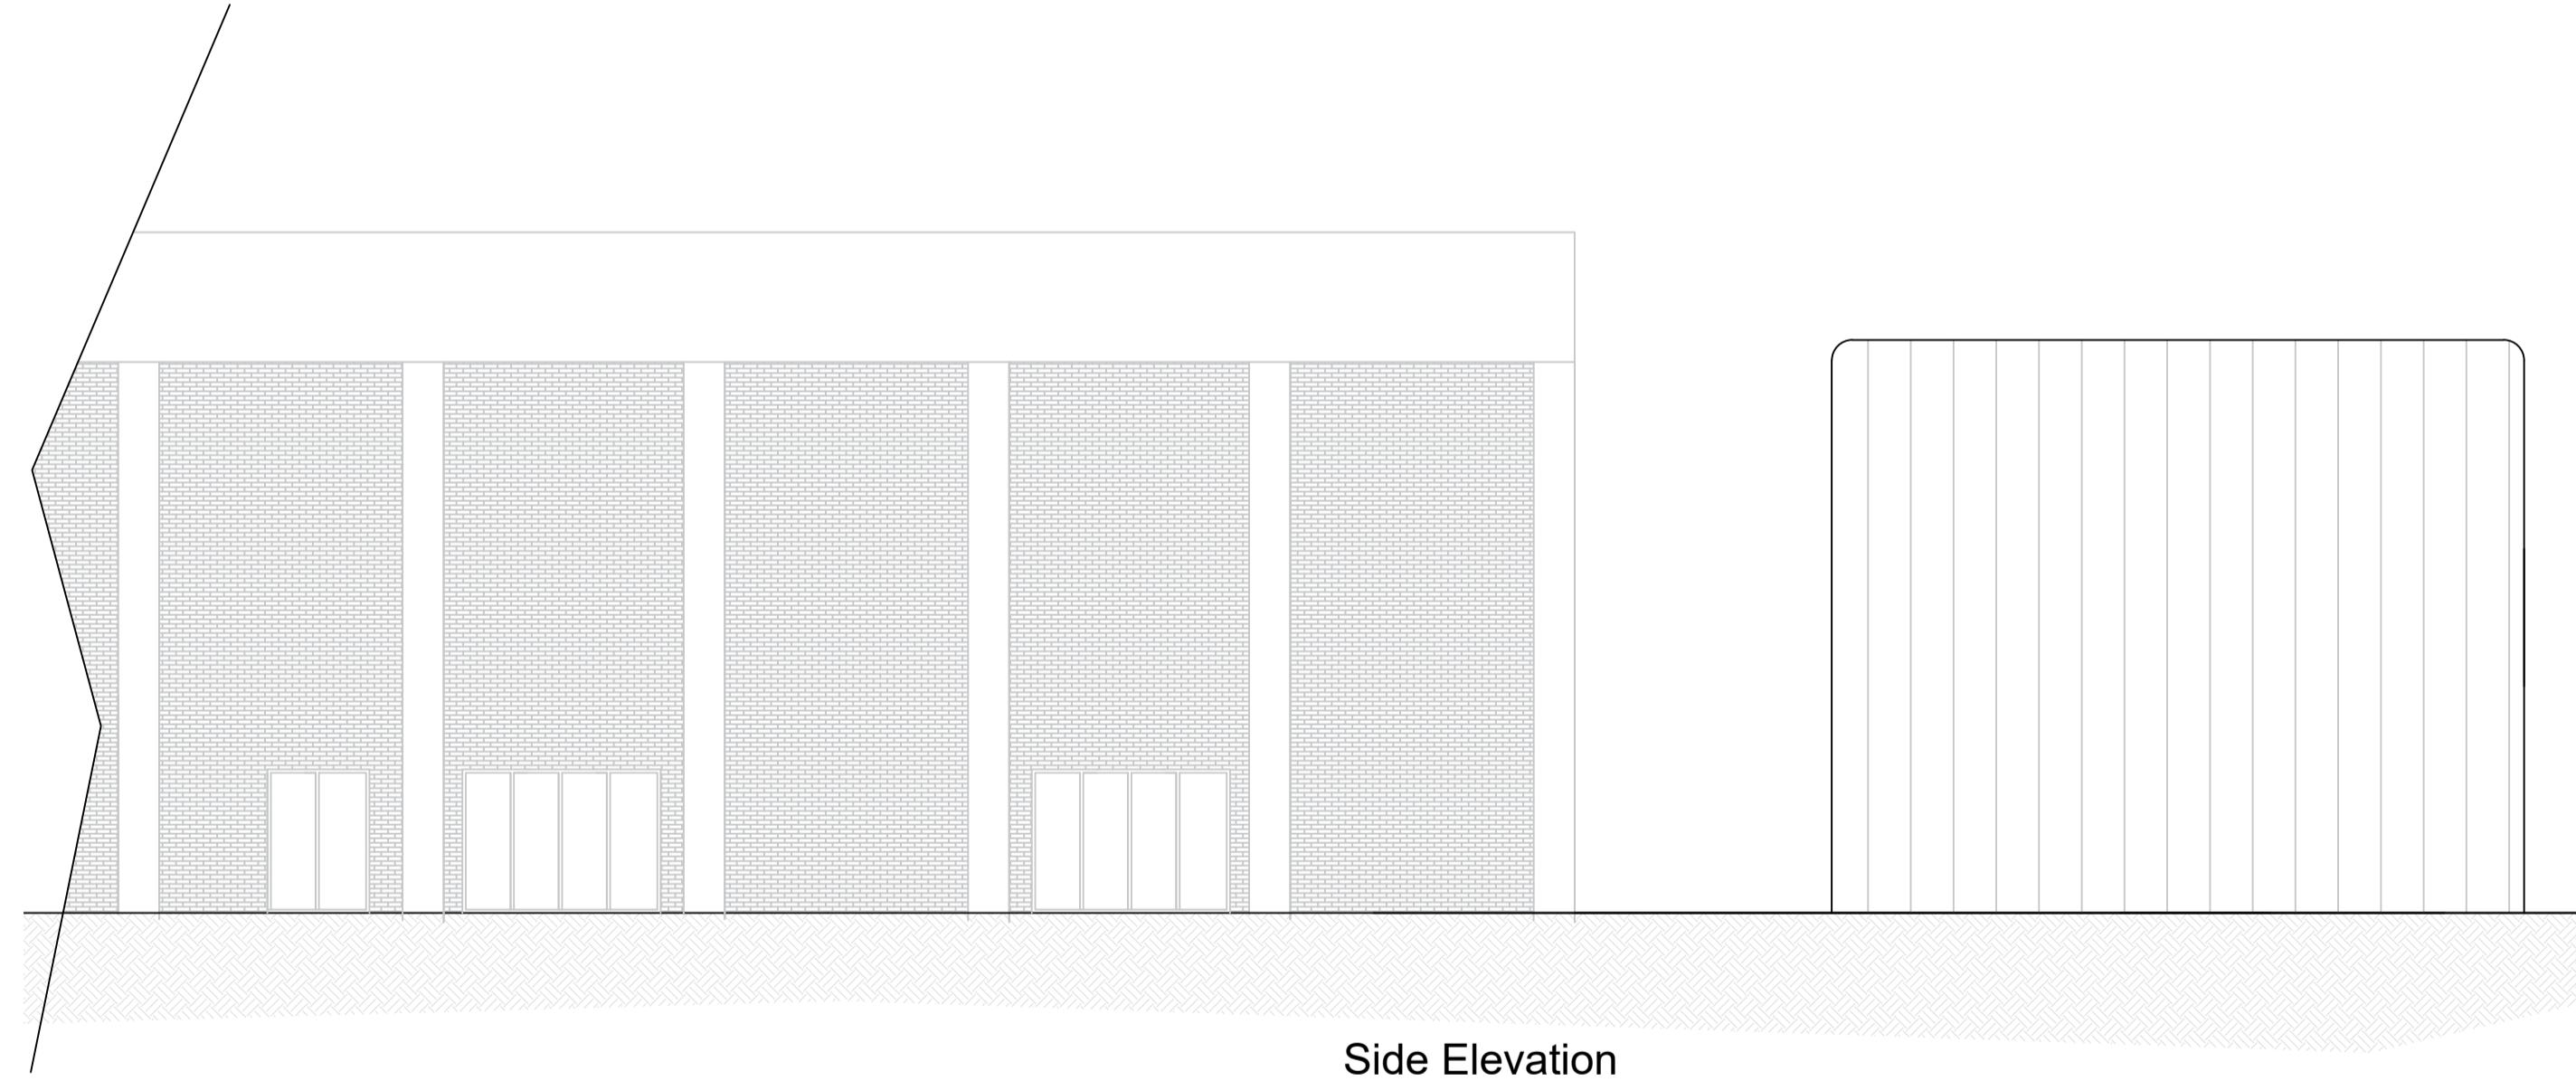

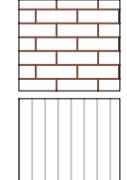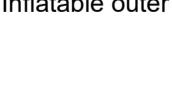Materials	Electrical and Heating	NOTES	Client
 Brickwork  Inflatable outer	To clients spec <ul style="list-style-type: none"> <li>⊕ Pendant Light</li> <li>⊕ Spot Light</li> <li>⊕ External Light</li> <li>✓ Switch. (All switches 1200mm above floor)</li> <li>✗ Double 13 Amp sockets, 450mm min. above floor.</li> <li>✗ Double 13 Amp sockets, 1050mm min. above floor.</li> <li>► T.V aerial socket. (H.L denotes 1050mm high)</li> </ul> <ul style="list-style-type: none"> <li>SD Smoke detector wired permanently to a separately fused circuit.</li> <li>CD Carbon Monoxide Detector to BS EN 50291:2001</li> <li>H Heat Detector</li> <li>ME Mechanical extract fan e.f</li> <li>ET External Tap</li> <li>ES External 13 Amp sockets, 450mm min. above floor.</li> <li>Radiator position.</li> </ul>	ALL DIMENSIONS TO BE CHECKED ON SITE. ALL SUBJECT TO STRUCTURAL ENGINEERS CHECKS AND CALCULATIONS TO BE READ IN CONJUNCTION WITH CONSTRUCTION SPECIFICATION DO NOT SCALE FROM THIS DRAWING EXCEPT FOR THE PURPOSES OF LOCAL AUTHORITY PLANNING ANY VARIATIONS MADE TO SPECIFICATIONS MUST BE MADE SPECIFICATIONS OTHER THAN DK DESIGNS KNOWLEDGE, DK DESIGNS WILL NOT BE HELD ACCOUNTABLE FOR NON COMPLIANCE OF PLANNING AND BUILDING REGULATIONS This drawing and all the information shown is the property of DK Designs and shall not be copied whole or in part, or used for any other purpose without written permission of the Company	Air Menzies International Unit 2B Polar Park, Bath Rd, Heathrow AS BUILT ELEVATIONS