




Front Elevation



Side Elevation from No 27



Rear Elevation

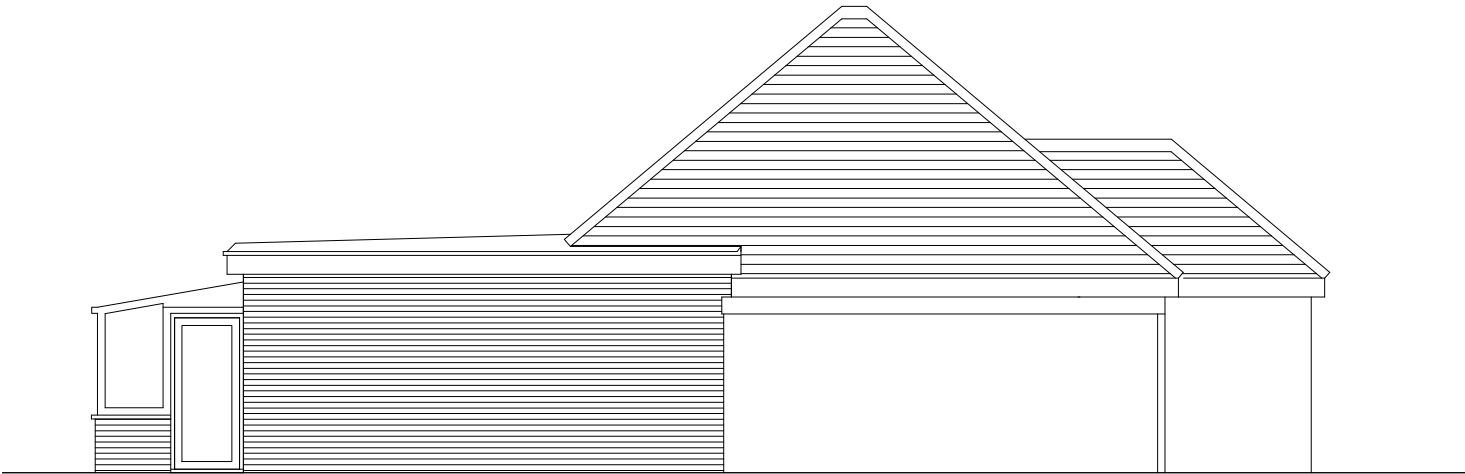

Side Elevation from No 23




Front View to Plot 23




Rear View to Plot 27



Rear View to Plot 23

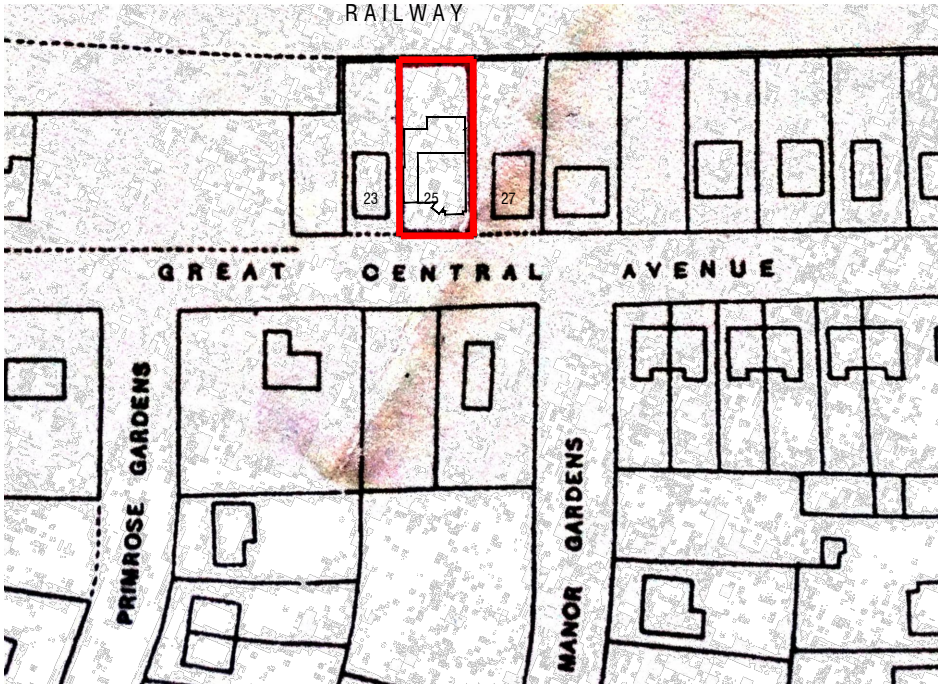

1:1250 Location Plan

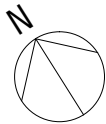

date	rev	revision	drawn	MA	project	purpose of issue
25-02-13	A	Side elevations roof lights amended	checked	MK	25 Great Central Avenue, Ruislip HA4 6TT	Planning
			scale	1:100 @ A3	drawing	drawing no
			date	Feb 2013	Elevations, As Built - Side/Rear & Loft Conversion	A8054-P02
			ASSI & ASSI Limited Architectural Services 41 Woodlands Grove Isleworth Middlesex TW7 6NS M 07964 213 230 E aassi@btinternet.com			
						rev A

