

2019 © Sapphire Balconies Ltd
Do not scale from this drawing.
All dimensions in millimetres
unless stated otherwise.
We reserve the right to alter
detail to suit production.
All tolerances to be +/- 3mm
unless otherwise specified.
Drawings to be read in conjunction
with specification and detail sheets.

Balcony Type	Quantity
Type 1	1
Type 2-L	3
Type 2-R	3
Type 3	1
Total	8

Key

Stack Ref.
Balcony Type
Template Type
Bracket Type
Arm Type

Rev	Date	Description
F	08.07.20	For Construction
E	05.11.19	For Construction
D	11.10.19	As per markup
C	21.09.19	Issue for construction
B	19.09.19	Type 3 balcony updated
A	19.08.19	Issued for Approval

Project
Blyth Road

Location
Block-B Level-5



Drawing Title
GA Plan



www.sapphire.eu.com
call 0844 88 00 553

Drawn by ARD Checked by SL Scale @ A3 1:150

Project Ref. 530919 Drawing No. - GA-04 - F Revision

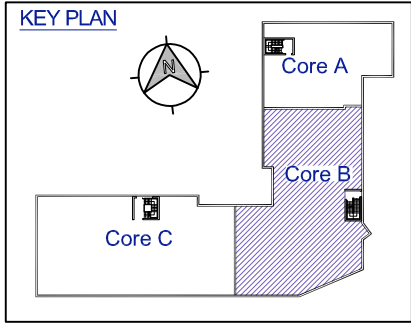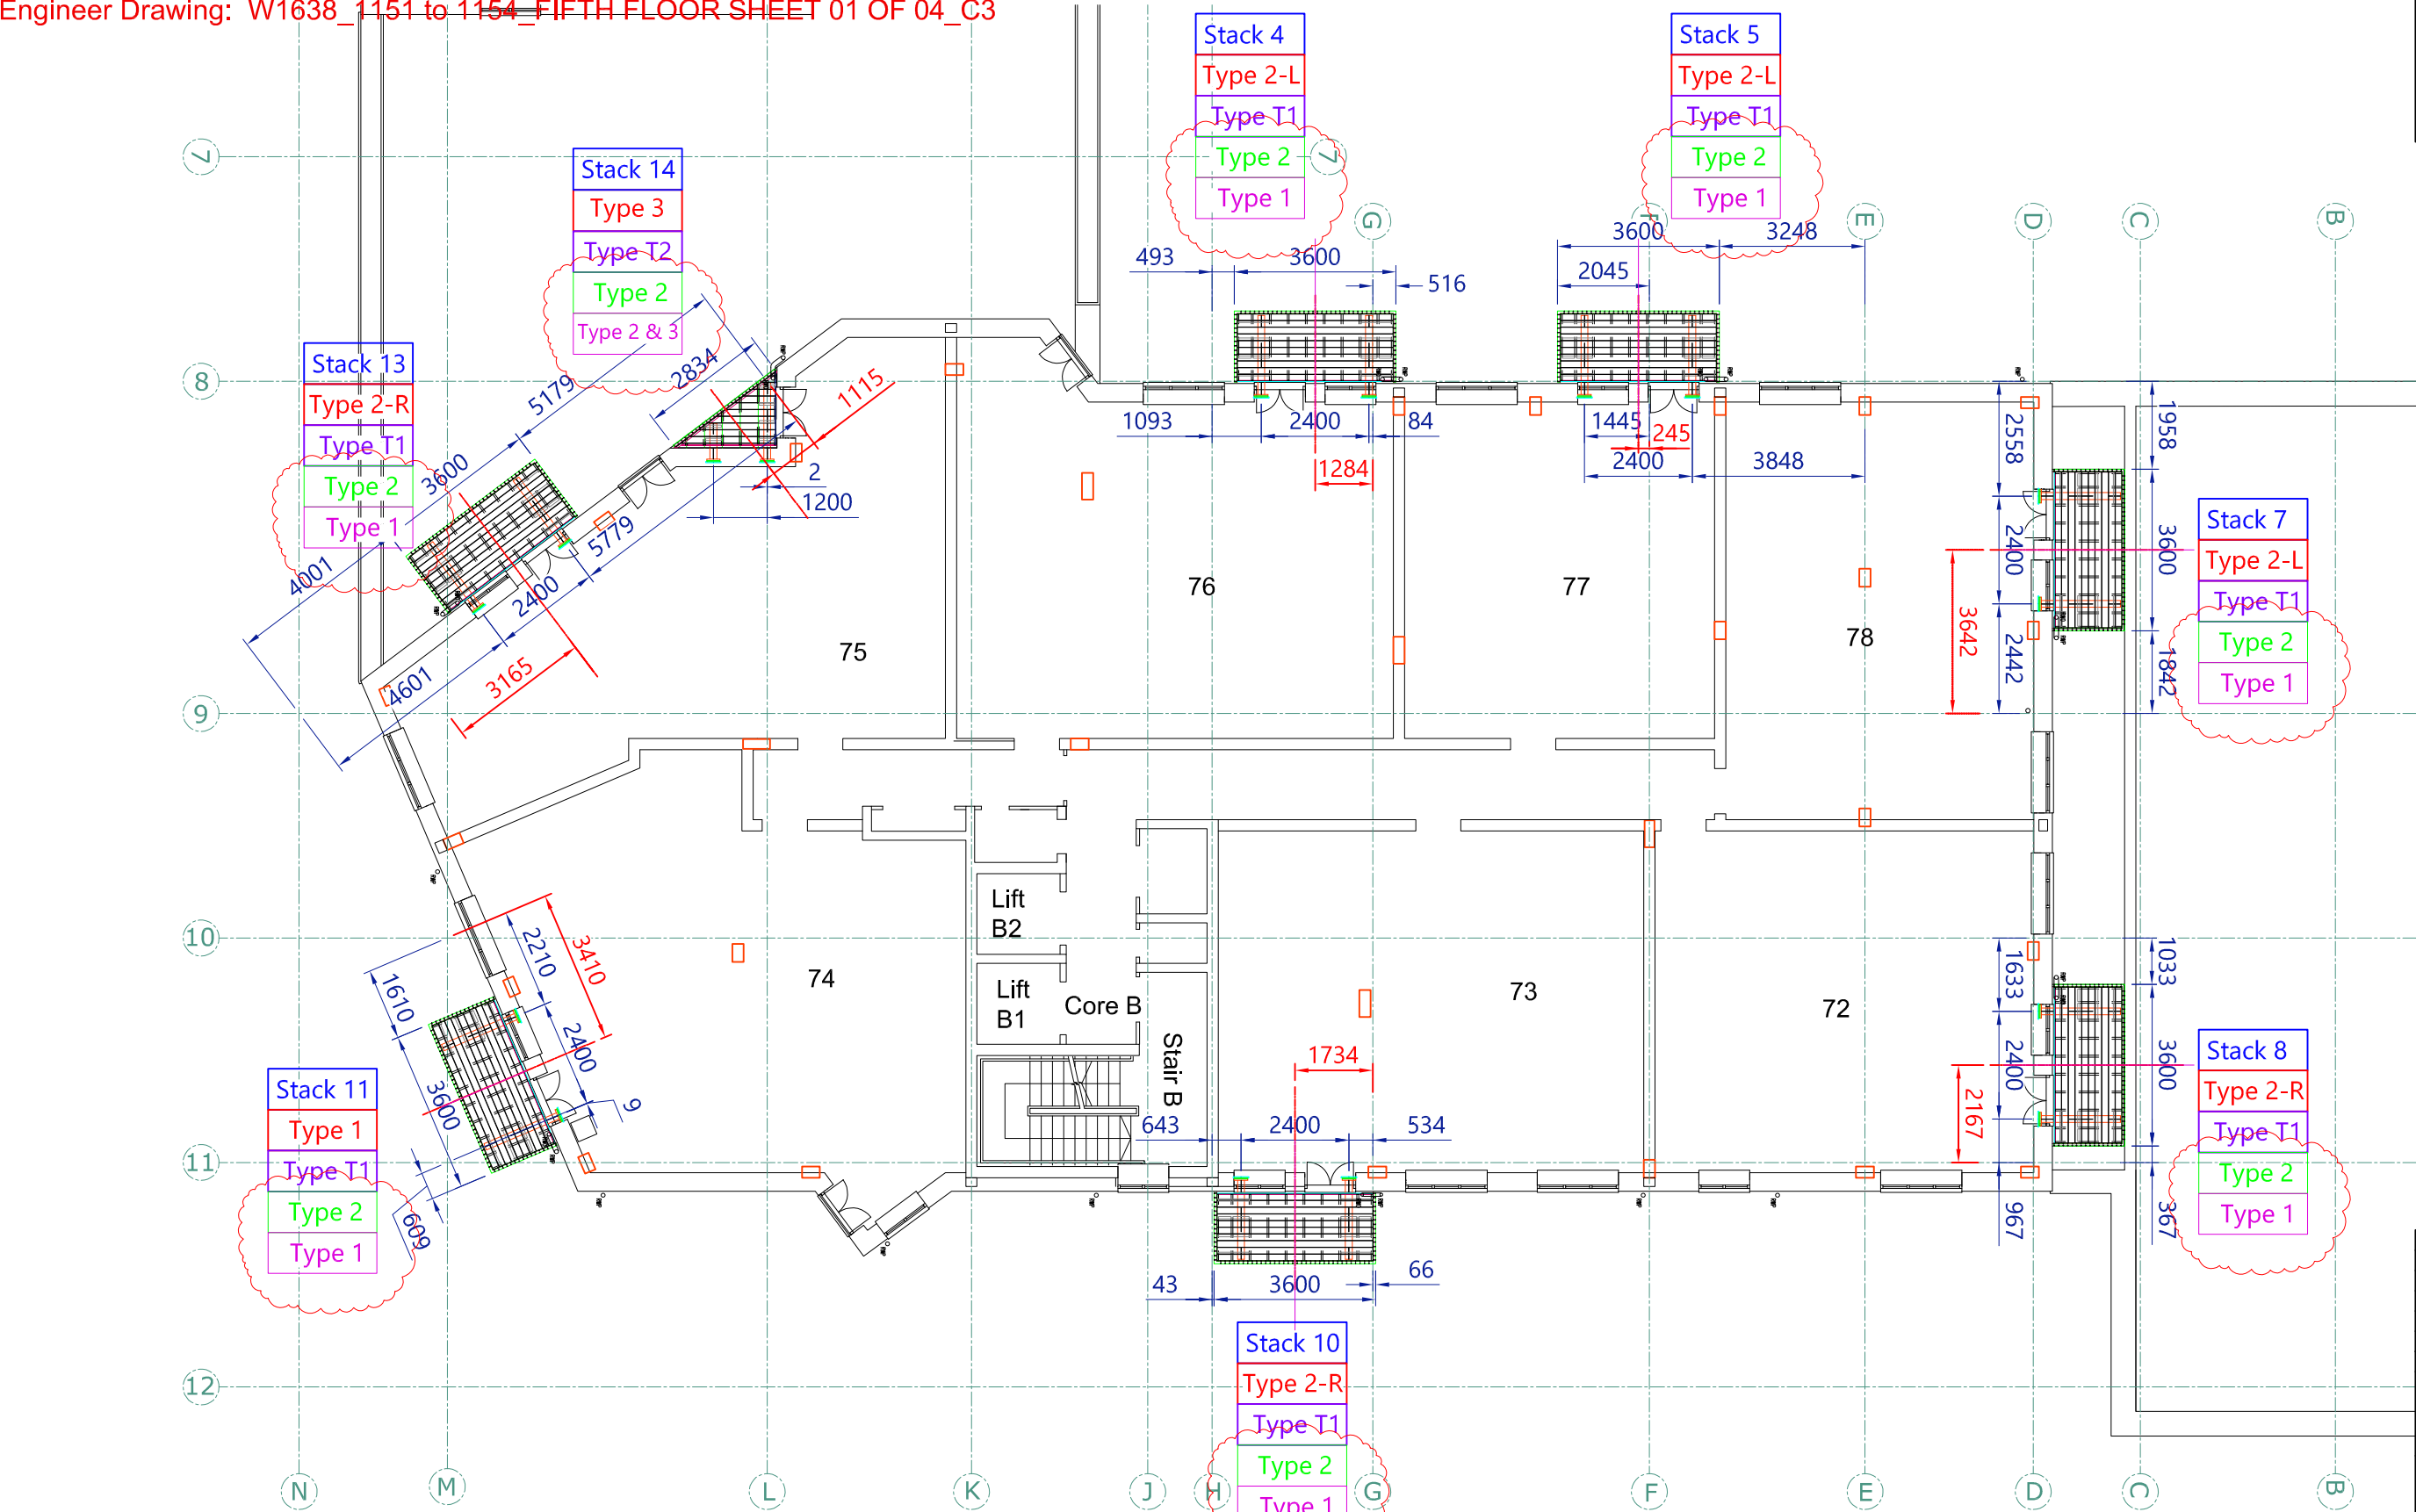

LEVEL 5