



2019 © Sapphire Balconies Ltd
Do not scale from this drawing.
All dimensions in millimetres
unless stated otherwise.
We reserve the right to alter
detail to suit production.
All tolerances to be +/- 3mm
unless otherwise specified.
Drawings to be read in conjunction
with specification and detail sheets.

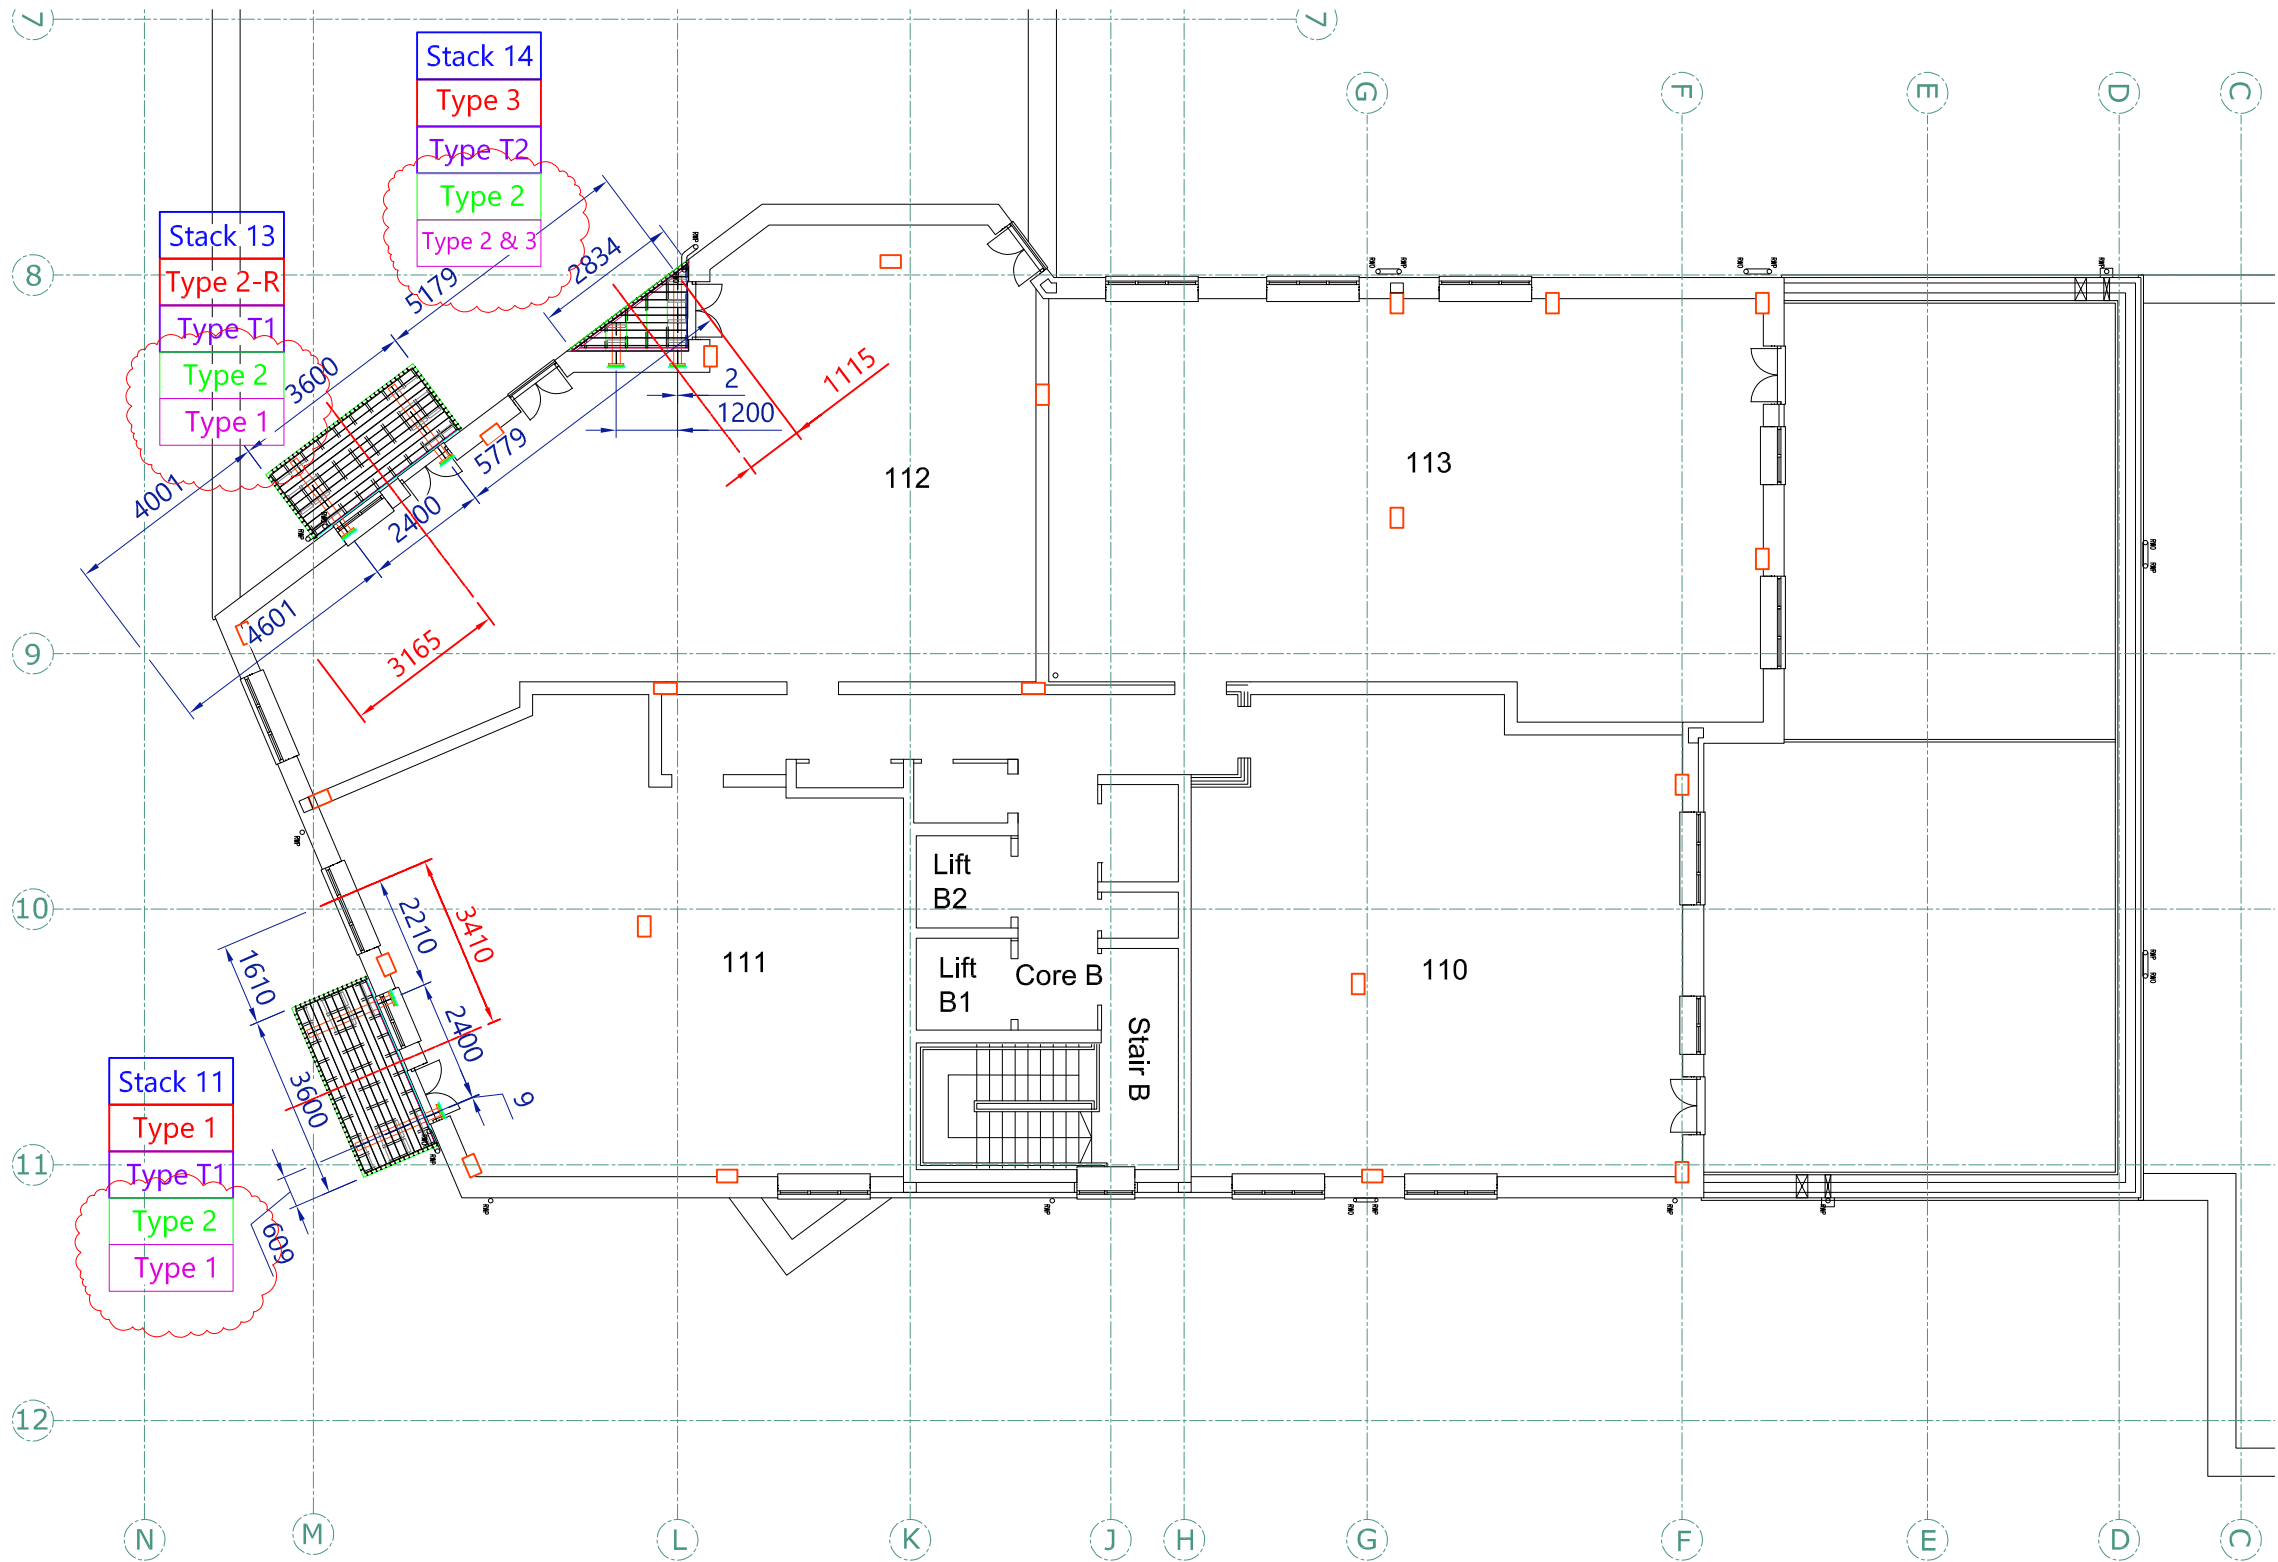

Balcony Type	Quantity
Type 1	1
Type 2-R	1
Type 3	1
Total	3

Stack Ref.
Balcony Type
Template Type
Bracket Type
Arm Type

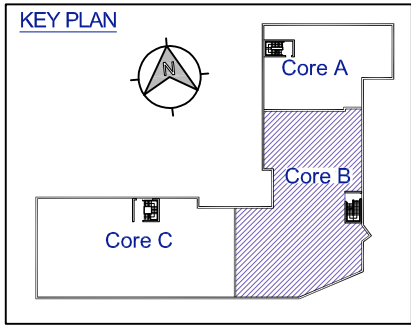

LEVEL 8

G	08.07.20	For Construction
F	25.01.20	Re-issue for construction for clouded chnages
E	05.11.19	For Construction
D	11.10.19	As per markup
C	21.09.19	Issue for construction
B	19.09.19	Type 3 balcony updated
A	19.08.19	Issued for Approval
Rev	Date	Description

Project
Blyth Road

Location
Block-B Level-8

Drawing Title
GA Plan



www.sapphire.eu.com
call 0844 88 00 553

Drawn by ARD Checked by SL Scale @ A3
1:150

Project Ref. 530919 Drawing No. - GA-07 - G Revision